





PLOTTED BY: nazad

PRINTED: 8/9/2017 @ 3:09PM

FILE NAME: G:\3827-Lobellville\Working Drawings\Record Drawings\3827.dwg C:\0-05\3827.dwg

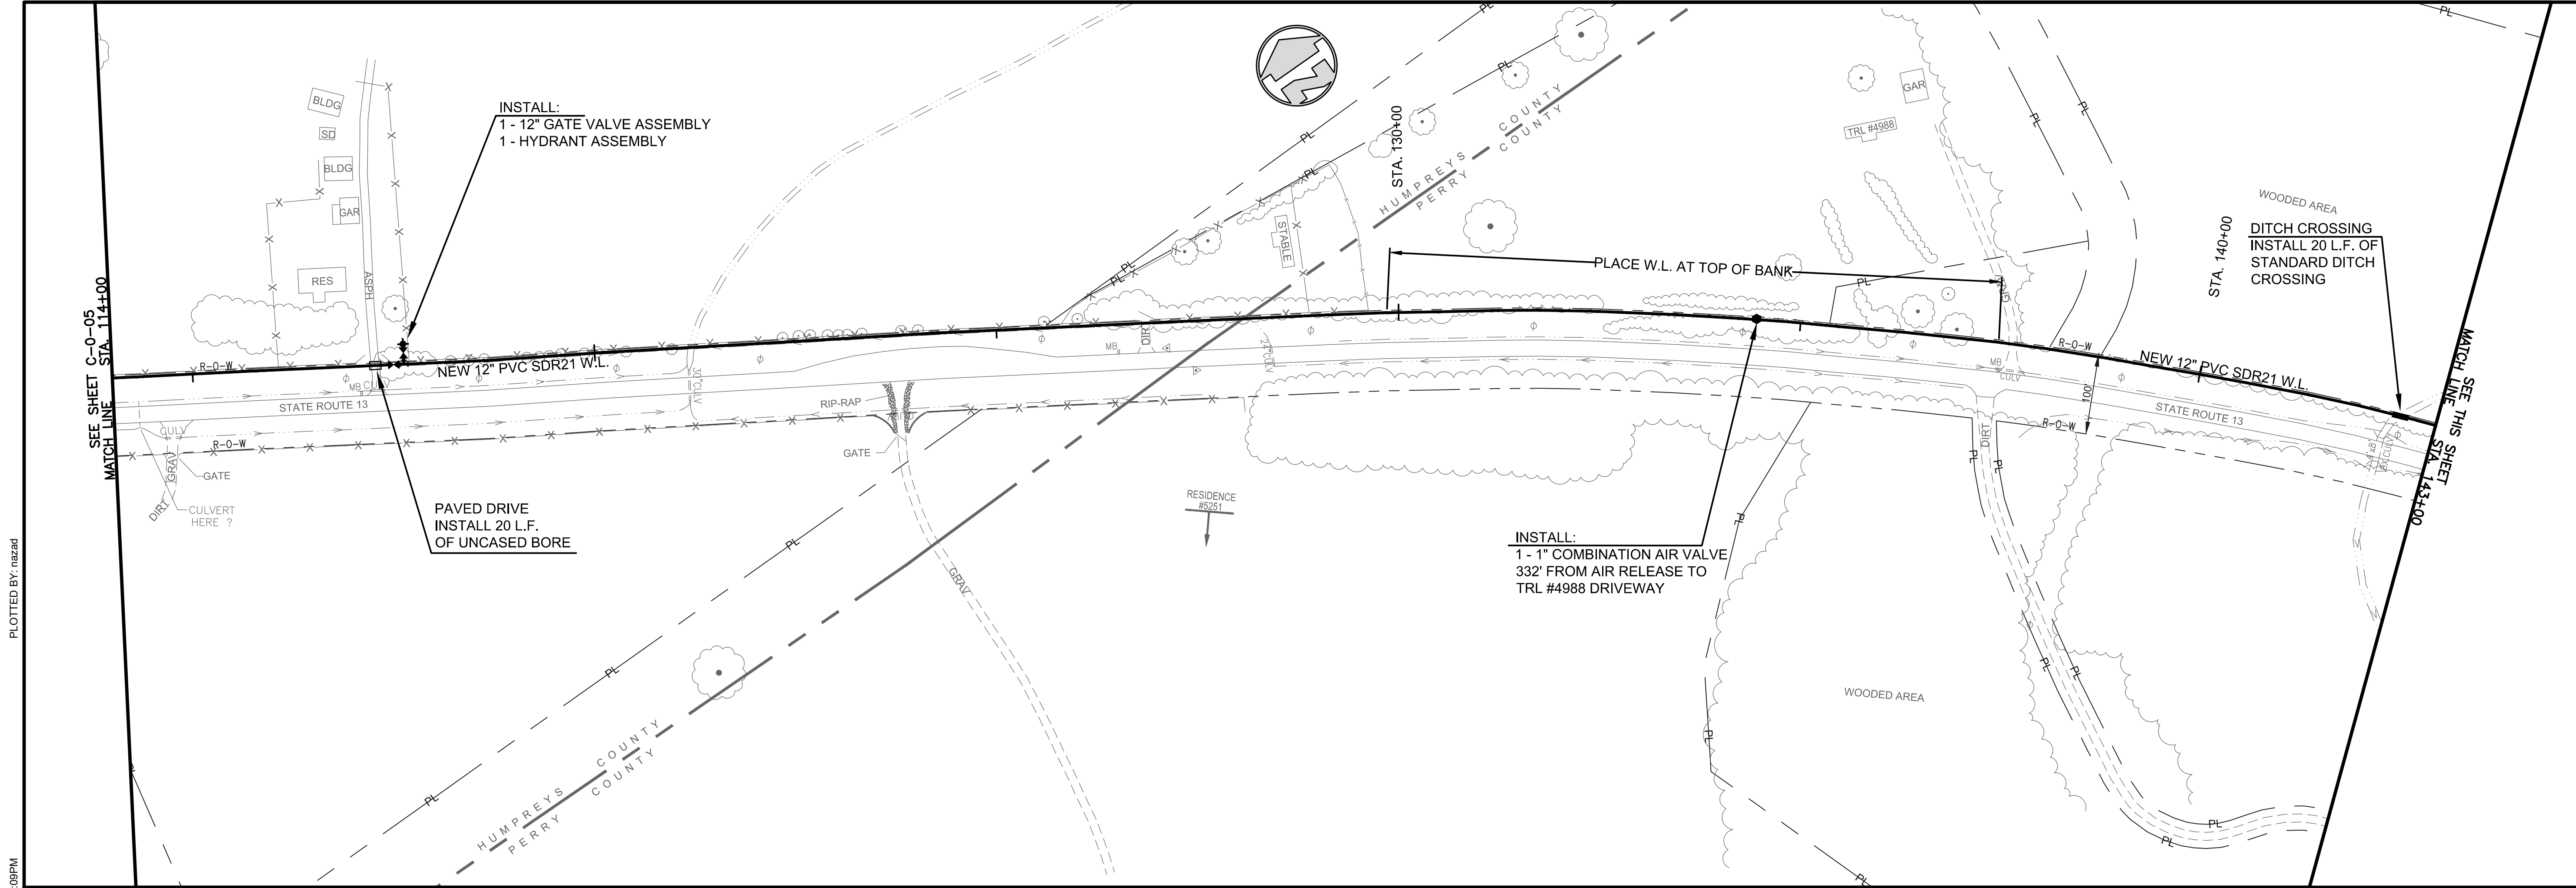

CONTRACTOR NOTE:  
UNLESS OTHERWISE INDICATED ON THE  
PLANS THE 12" WATER LINE SHALL BE PLACED  
3 FEET INSIDE HIGHWAY RIGHT-OF-WAY

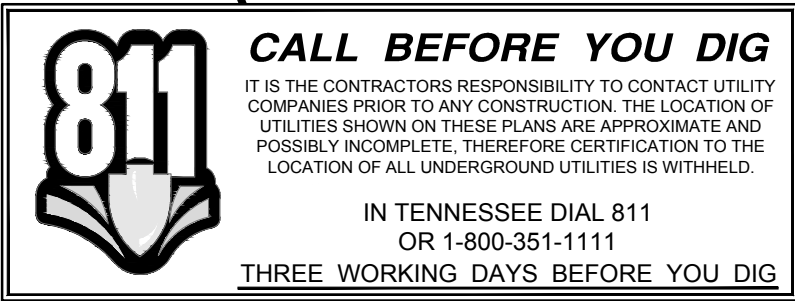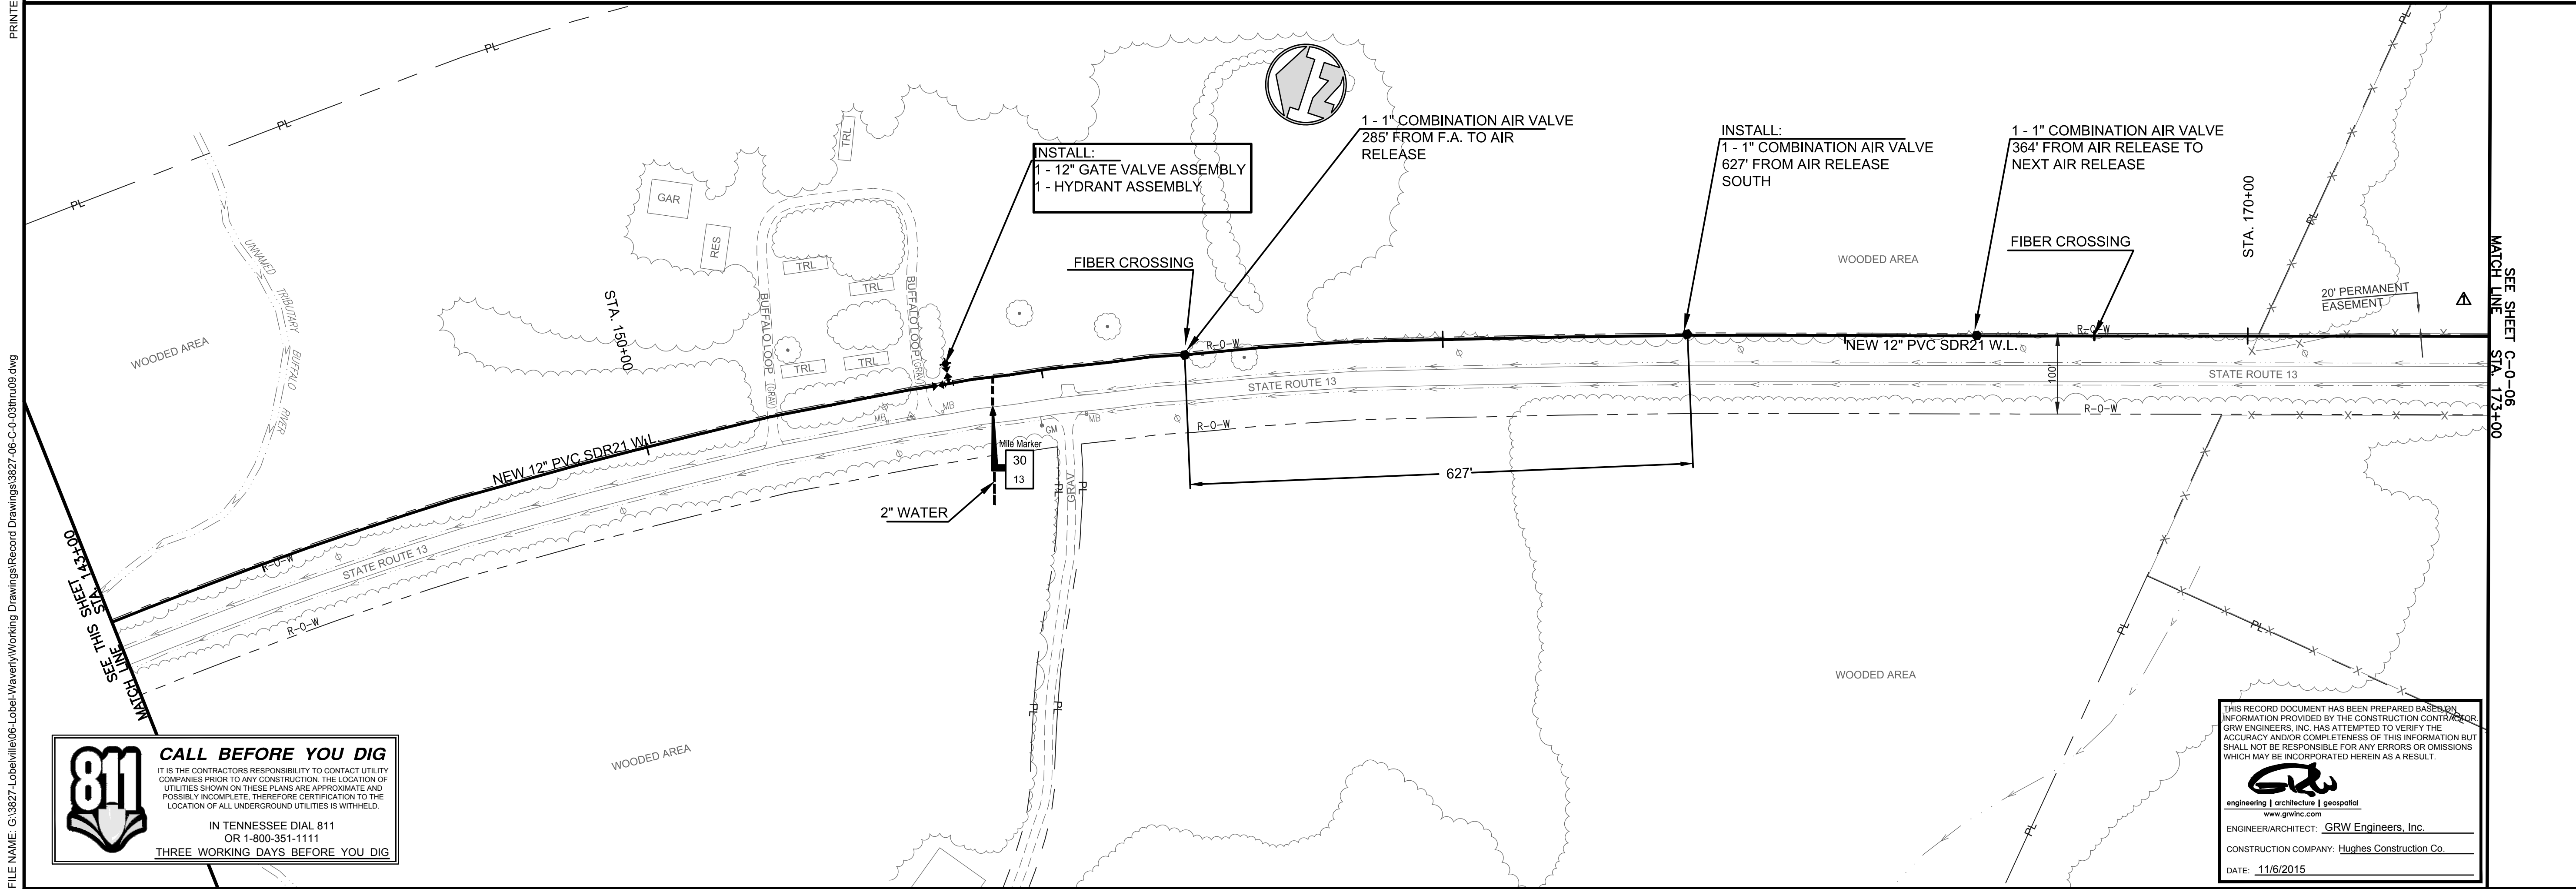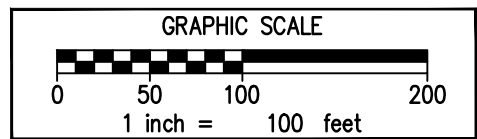

THIS RECORD DOCUMENT HAS BEEN PREPARED BASED ON INFORMATION PROVIDED BY THE CONSTRUCTION CONTRACTOR. GRW ENGINEERS, INC. HAS ATTEMPTED TO VERIFY THE ACCURACY AND/OR COMPLETENESS OF THIS INFORMATION BUT SHALL NOT BE RESPONSIBLE FOR ANY ERRORS OR OMISSIONS WHICH MAY BE INCORPORATED HEREIN AS A RESULT.

**GRW**  
engineering | architecture | geospatial  
www.grwinc.com  
ENGINEER/ARCHITECT: GRW Engineers, Inc.  
CONSTRUCTION COMPANY: Hughes Construction Co.  
DATE: 11/6/2015

This document, originally issued, sealed, and signed by Barry L. Cloyd, Tennessee Professional Engineer, No. 100893, on JULY 2013, shall not be used in lieu of a certified document.

GRW PROJECT NO. 3827-06

ALL RIGHTS RESERVED  
NO PART OF THIS DOCUMENT IS TO BE REPRODUCED OR TRANSMITTED IN ANY FORM OR BY ANY MEANS, ELECTRONIC OR MECHANICAL, WITHOUT THE WRITTEN PERMISSION OF GRW ENGINEERS, INC.



ENGINEERS - ARCHITECTS - PLANNERS  
www.grwinc.com

12" WATER LINE - STA. 114+00 TO STA. 173+00  
2012-D DISASTER RECOVERY EMERGENCY  
WATER CONNECTION IMPROVEMENTS - CONTRACT 34821  
CITY OF LOBELVILLE, TENNESSEE

| DESIGNED |          | BY  |    | DATE    |      | DESCRIPTION                                             |  |
|----------|----------|-----|----|---------|------|---------------------------------------------------------|--|
| BLC      | DESIGNED | BLC | BY | 11/4/13 | D.M. | MOVED W.L. TO REFLECT PROP. R.O.W CHANGES BY HWY. DEPT. |  |
| DM       | DESIGNED | DM  | BY |         |      |                                                         |  |
| BLC      | DESIGNED | BLC | BY |         |      |                                                         |  |
| BLC      | DESIGNED | BLC | BY |         |      |                                                         |  |

DATE: JULY 2013  
SCALE: 1" = 100'  
SHEET NO. C-0-05

DESIGN DRAWINGS