





PLOTTED BY: nazad

PRINTED: 8/8/2017 @ 3:09PM

FILE NAME: G:\3827-Lobellville\Working Drawings\Record Drawings\3827-06 C-0-03.mxd.dwg

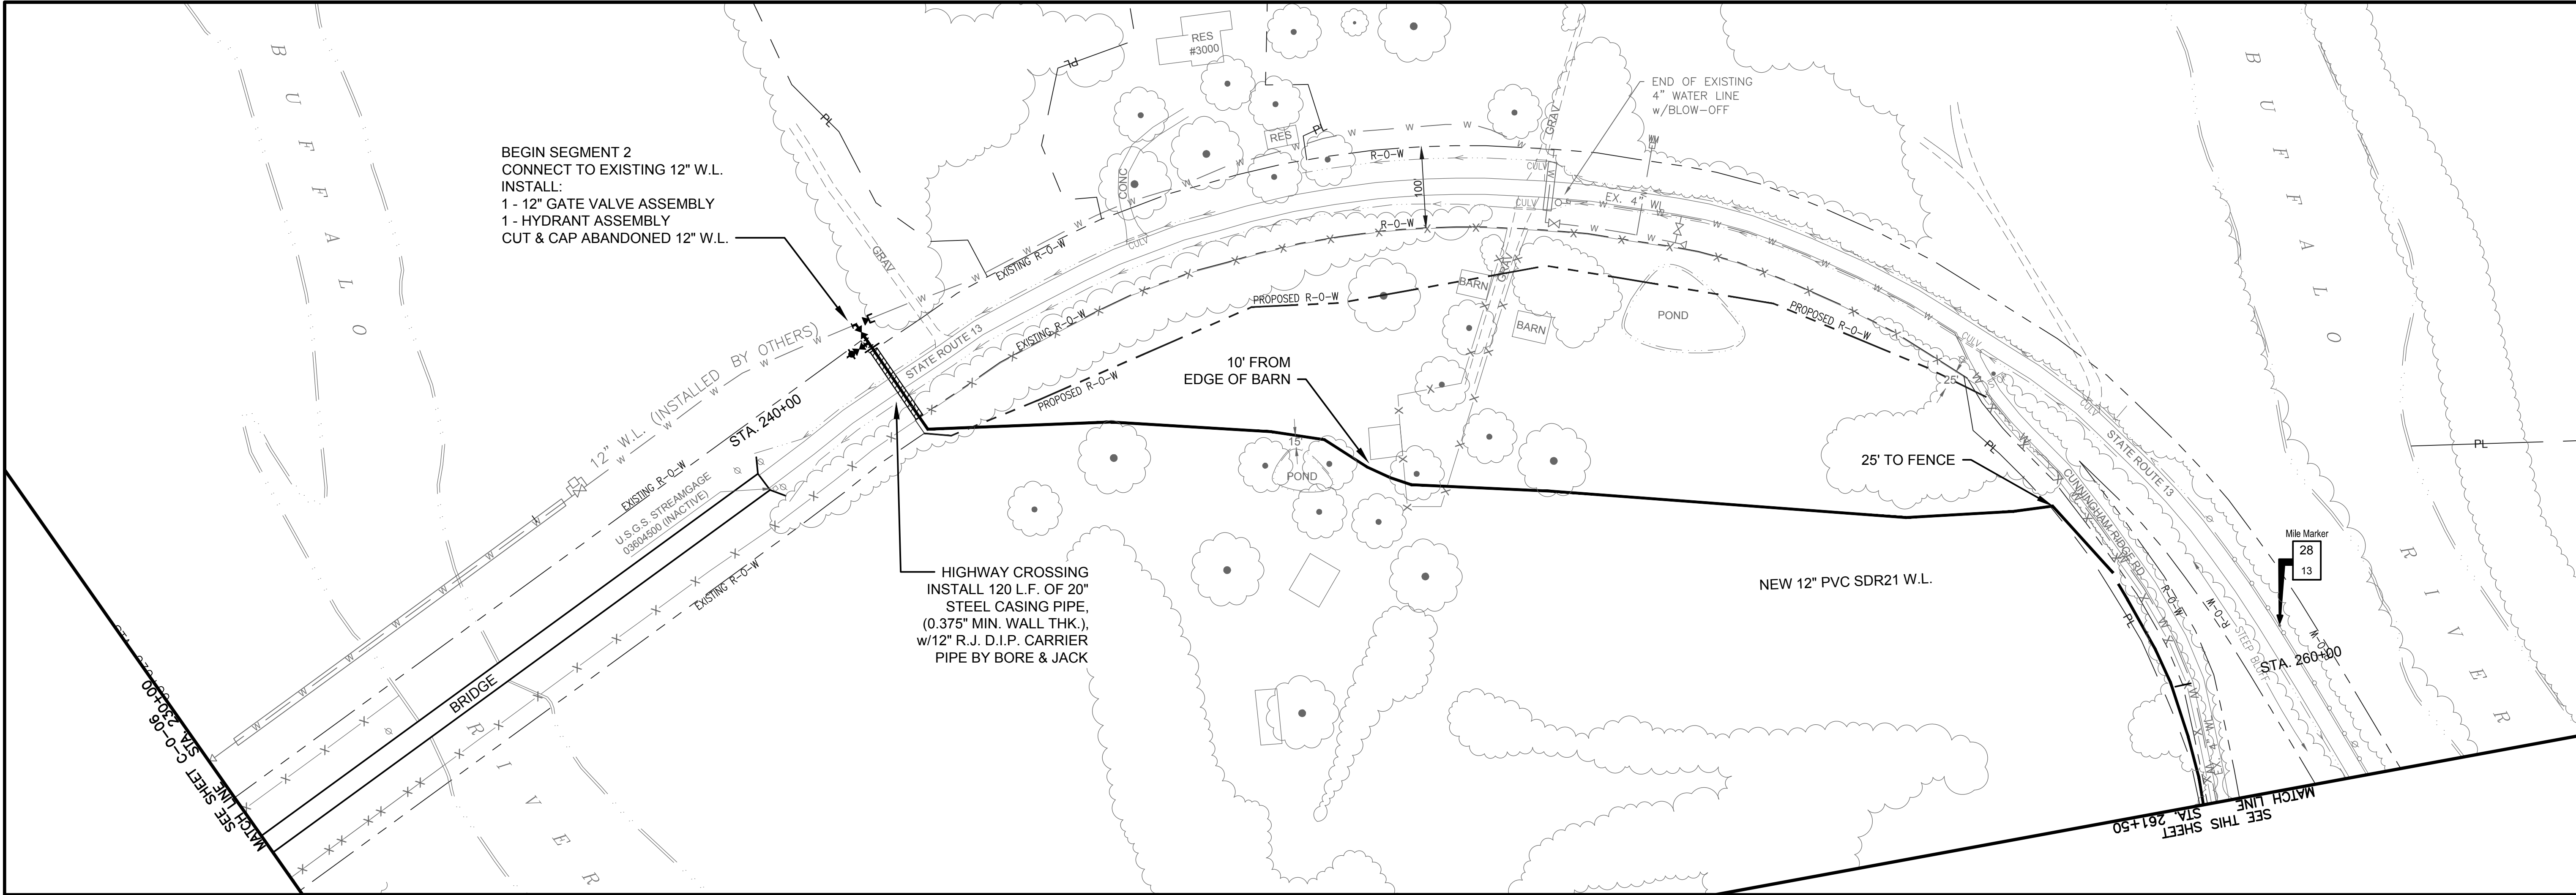

CONTRACTOR NOTE:
UNLESS OTHERWISE INDICATED ON THE
PLANS THE 12" WATER LINE SHALL BE PLACED
3 FEET INSIDE HIGHWAY RIGHT-OF-WAY

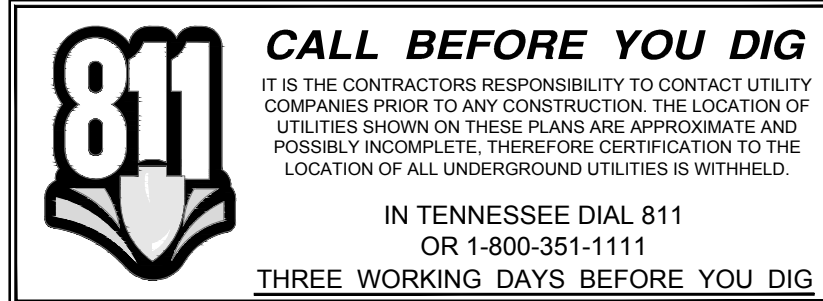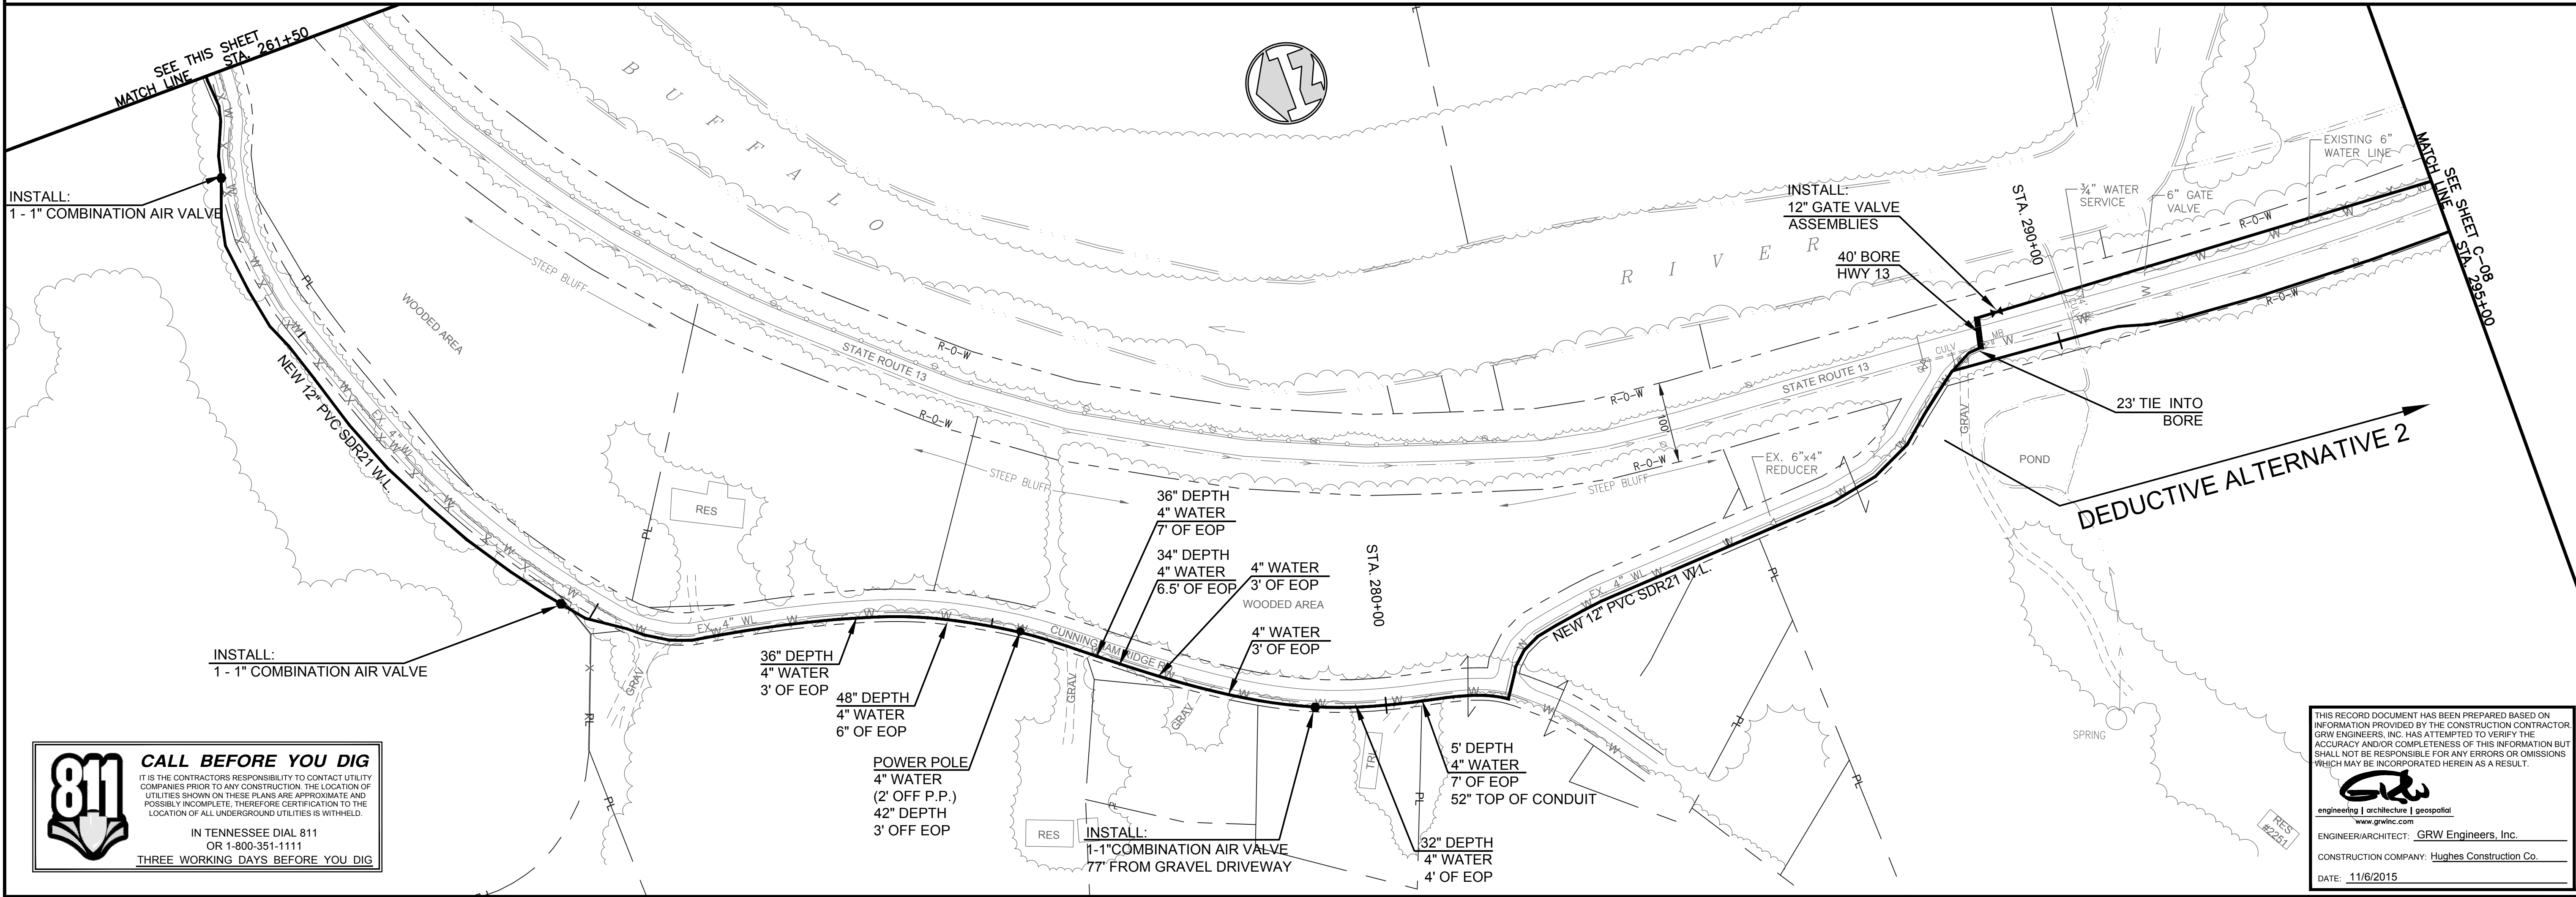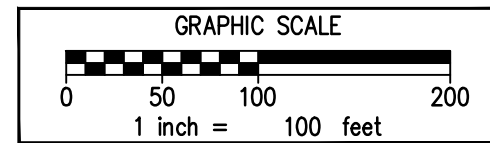

THIS RECORD DOCUMENT HAS BEEN PREPARED BASED ON INFORMATION PROVIDED BY THE CONSTRUCTION CONTRACTOR. GRW ENGINEERS, INC. HAS ATTEMPTED TO VERIFY THE ACCURACY AND/OR COMPLETENESS OF THIS INFORMATION BUT SHALL NOT BE RESPONSIBLE FOR ANY ERRORS OR OMISSIONS WHICH MAY BE INCORPORATED HEREIN AS A RESULT.

GRW
engineering | architecture | geospatial
www.grwinc.com
ENGINEER/ARCHITECT: GRW Engineers, Inc.
CONSTRUCTION COMPANY: Hughes Construction Co.
DATE: 11/6/2015

This document, originally issued, sealed, and signed by Barry L. Cloyd, Tennessee Professional Engineer, No. 100893, on JULY 2013, shall not be used in lieu of a certified document.

GRW PROJECT NO. 3827-06

ALL RIGHTS RESERVED. NO PART OF THIS DOCUMENT MAY BE REPRODUCED IN WHOLE OR IN PART WITHOUT THE WRITTEN PERMISSION OF GRW ENGINEERS, INC. AND SHALL NOT BE USED FOR ANY OTHER PROJECT OTHER THAN THIS SPECIFIC PROJECT WITHOUT THE WRITTEN PERMISSION.

GRW
ENGINEERS - ARCHITECTS - PLANNERS
www.grwinc.com

12" WATER LINE - STA. 230+00 TO STA. 295+00

2012-D DISASTER RECOVERY EMERGENCY
WATER CONNECTION IMPROVEMENTS - CONTRACT 34821
CITY OF LOBELVILLE, TENNESSEE

REVISIONS	DESIGNED	BLC	DATE	BY
NO.				

REVISIONS	DESIGNED	BLC	DATE	BY
NO.				

DATE: JULY 2013

SCALE: 1" = 100'

SHEET NO.

C-0-07