


FILE NAME: G:\3827-Lobellville\07-WTP Expansion\Working Drawings\AutoCAD - Record Drawing\009_3827-07_C-0-102.dwg

PRINTED: 10/15/2018 @ 11:51 AM

PLOTTED BY: rnzad

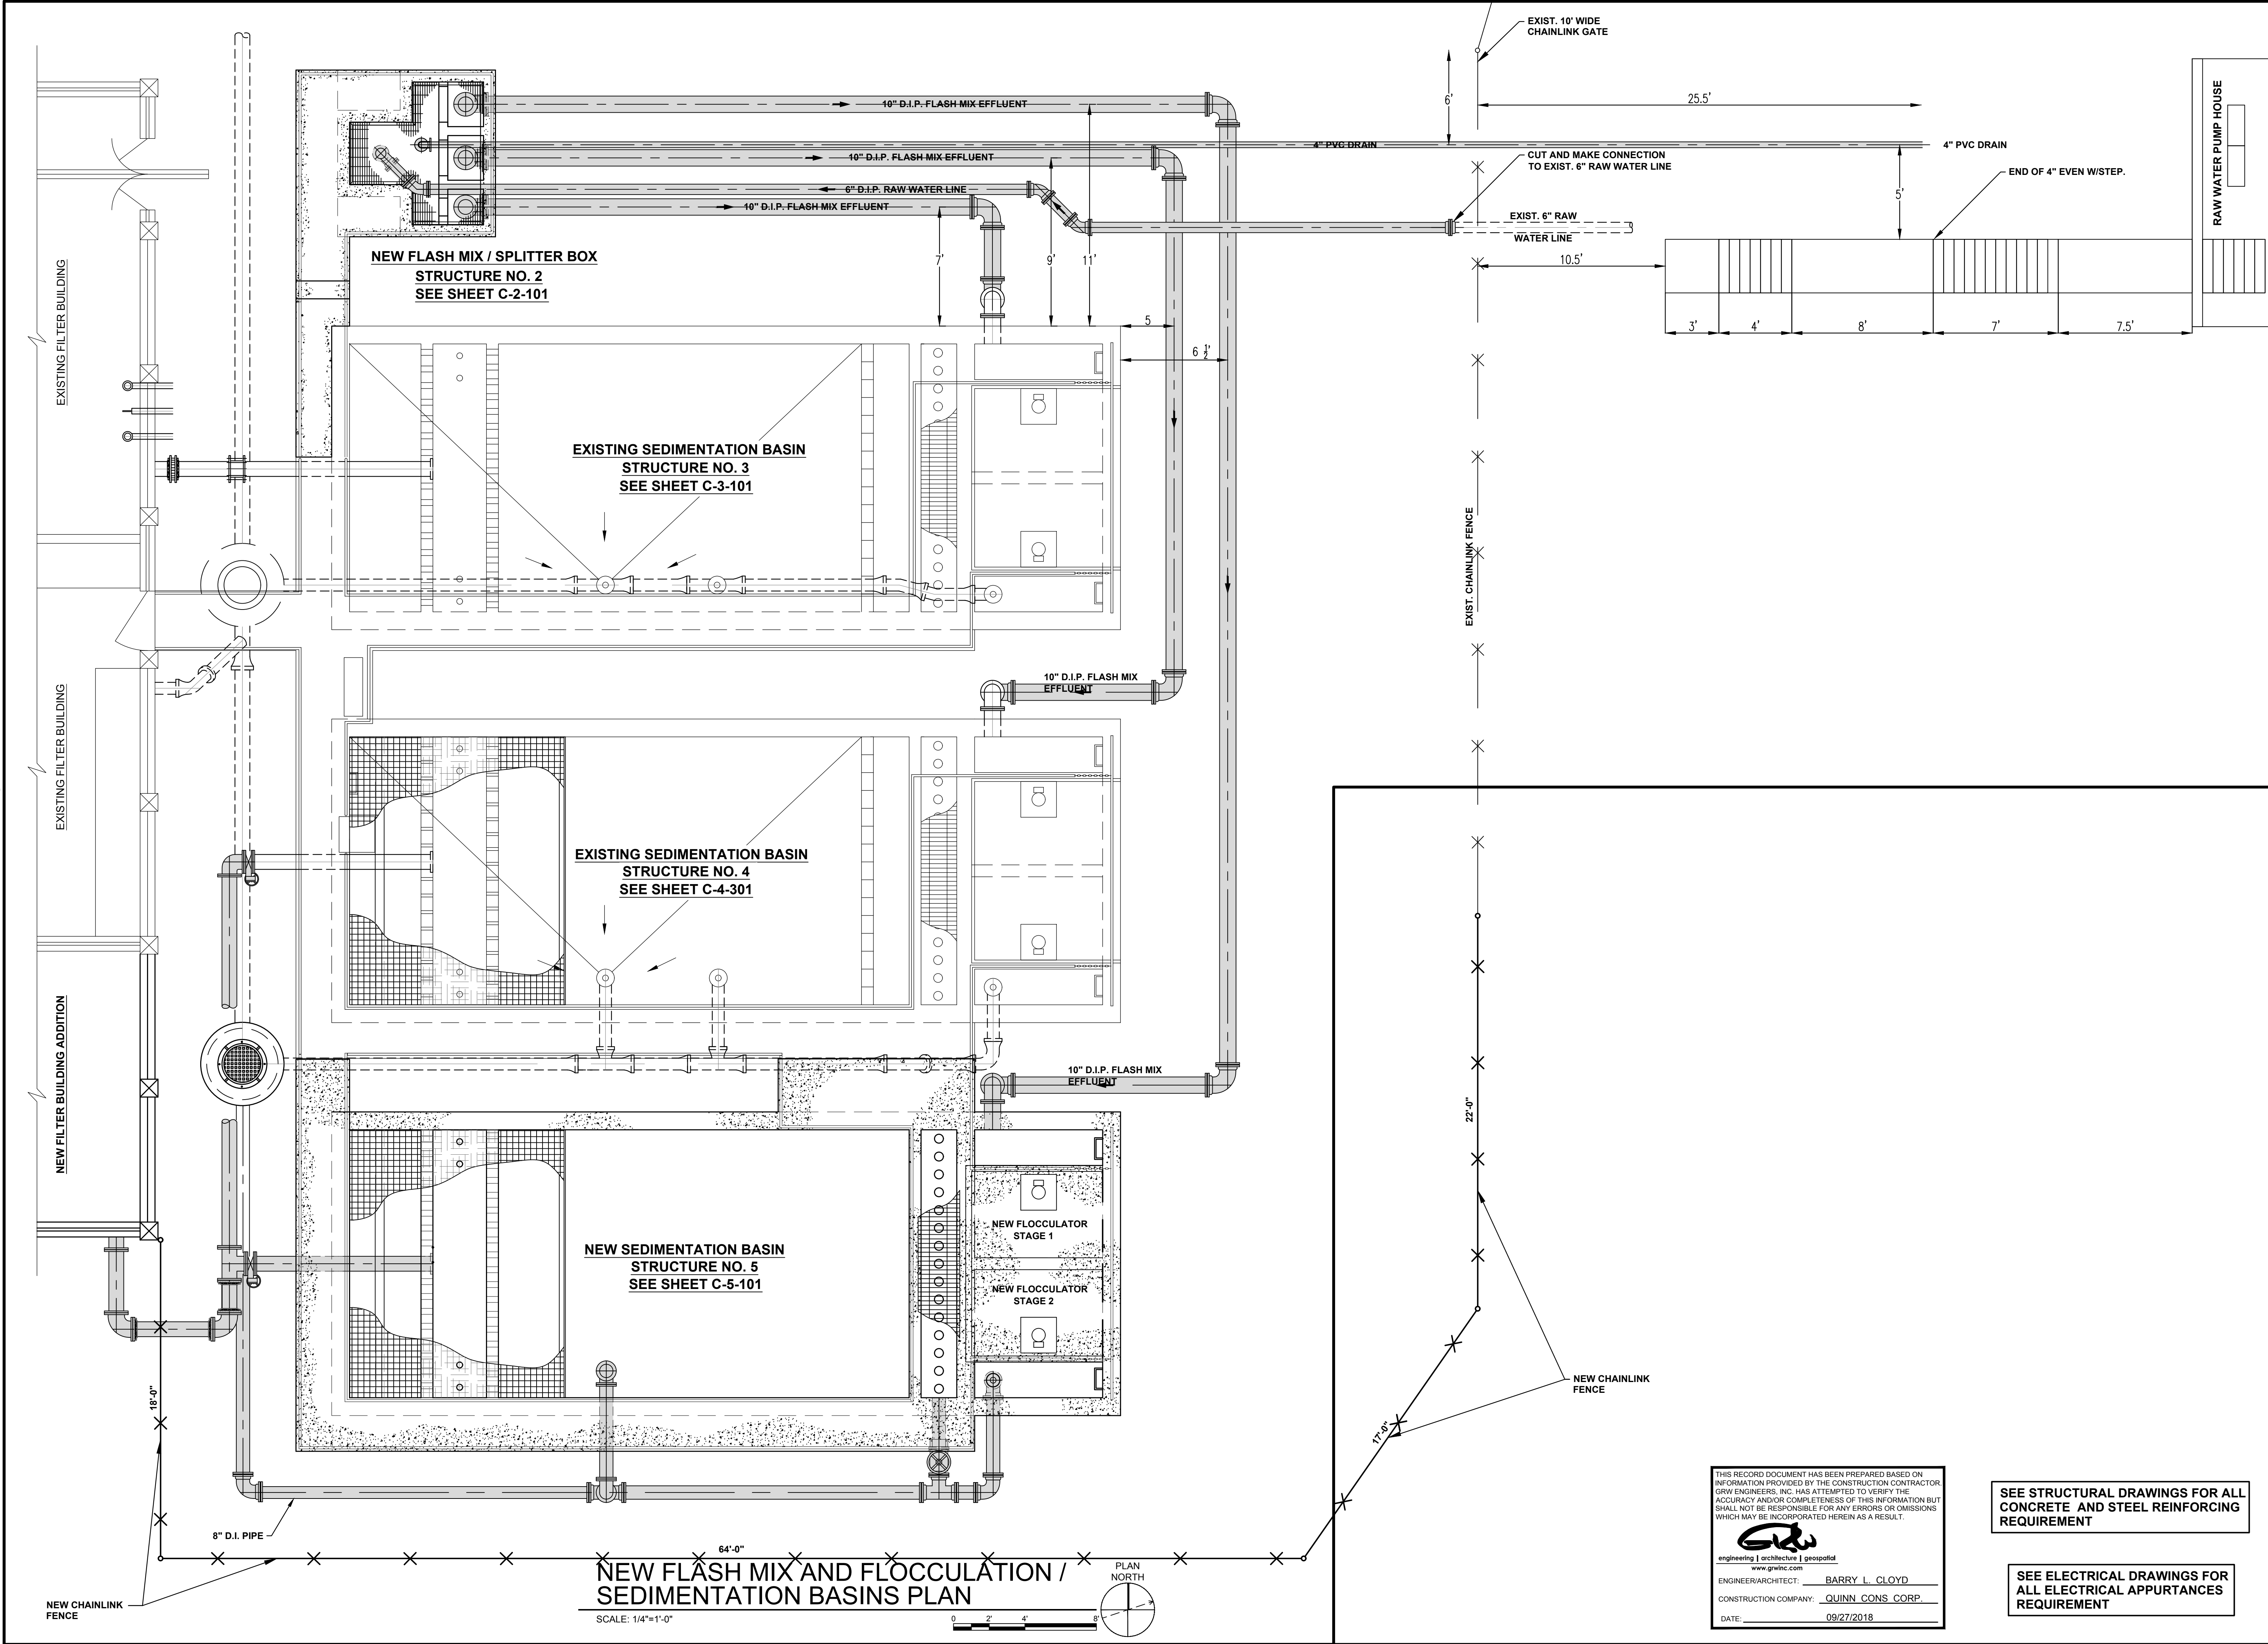

THIS RECORD DOCUMENT HAS BEEN PREPARED BASED ON INFORMATION PROVIDED BY THE CONSTRUCTION CONTRACTOR GRW ENGINEERS, INC. HAS ATTEMPTED TO VERIFY THE ACCURACY AND/OR COMPLETENESS OF THIS INFORMATION BUT SHALL NOT BE RESPONSIBLE FOR ANY ERRORS OR OMISSIONS WHICH MAY BE INCORPORATED HEREIN AS A RESULT.

GRW
engineering | architecture | geospatial
www.grwinc.com

ENGINEER/ARCHITECT: BARRY L. CLOYD
CONSTRUCTION COMPANY: QUINN CONS. CORP.
DATE: 09/27/2018

SEE STRUCTURAL DRAWINGS FOR ALL
CONCRETE AND STEEL REINFORCING
REQUIREMENT

SEE ELECTRICAL DRAWINGS FOR
ALL ELECTRICAL APPURTANCES
REQUIREMENT

NEW FLASH MIX AND FLOCCULATION /
SEDIMENTATION BASIN PLAN
WATER TREATMENT PLANT EXPANSION
CITY OF LOBELVILLE, TENNESSEE

DESIGNED		BY		DATE		DESCRIPTION	
BLC	SH	JWH	BLC				
NO.							
SCALE CHECK: _____ THIS MARK SHOULD MEASURE EXACTLY 1" WHEN PLOTTED							
DATE: <u>JUNE 2015</u>							
SCALE: <u>NOTED</u>							
SHEET NO. <u>C-0-102</u>							

GRW PROJECT NO. 3827-07

CLIENT PROJECT NO.

ALL RIGHTS RESERVED. NO PART OF THIS DOCUMENT MAY BE REPRODUCED IN WHOLE OR IN PART WITHOUT THE WRITTEN PERMISSION OF GRW ENGINEERS, INC. AND SHALL NOT BE USED FOR ANY OTHER PROJECT OTHER THAN THIS SPECIFIC PROJECT WITHOUT THE WRITTEN PERMISSION OF GRW ENGINEERS, INC.

engineering | architecture | geospatial
www.grwinc.com

This document, originally issued, sealed, and signed by BARRY L. CLOYD, Tennessee Professional Engineer, No. 100893, on JUNE 2015, shall not be used in lieu of a certified document.