

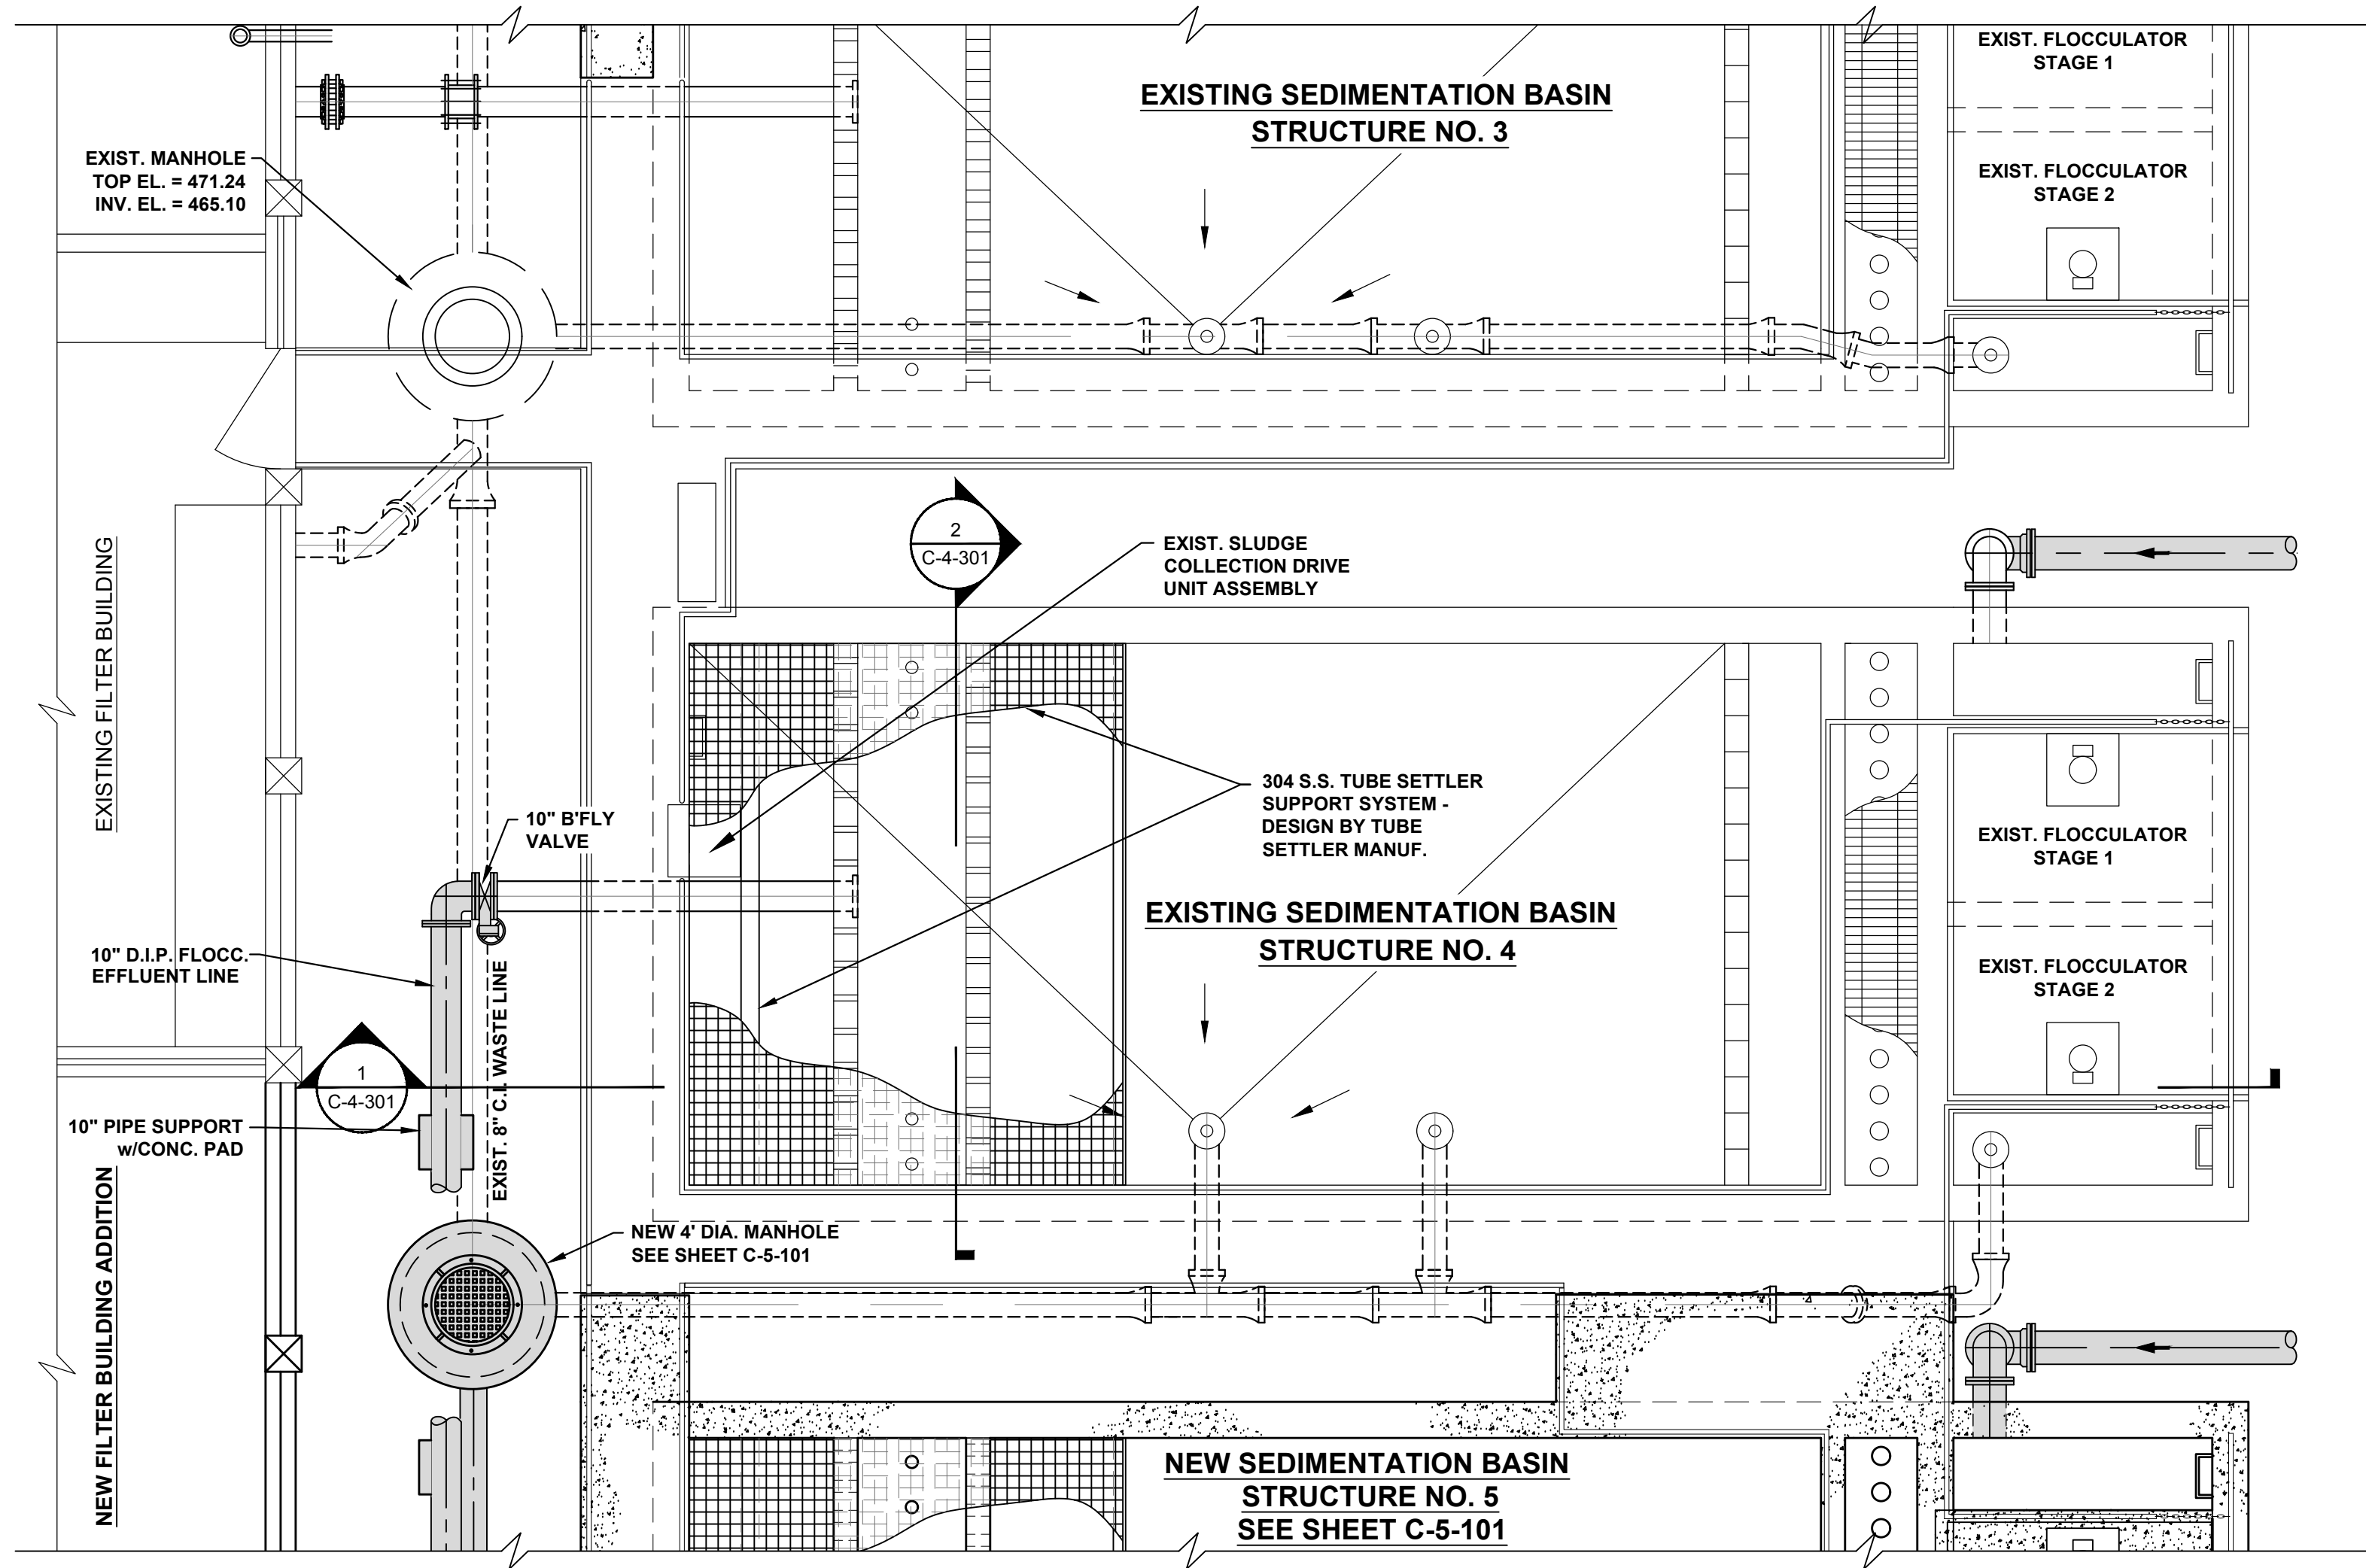


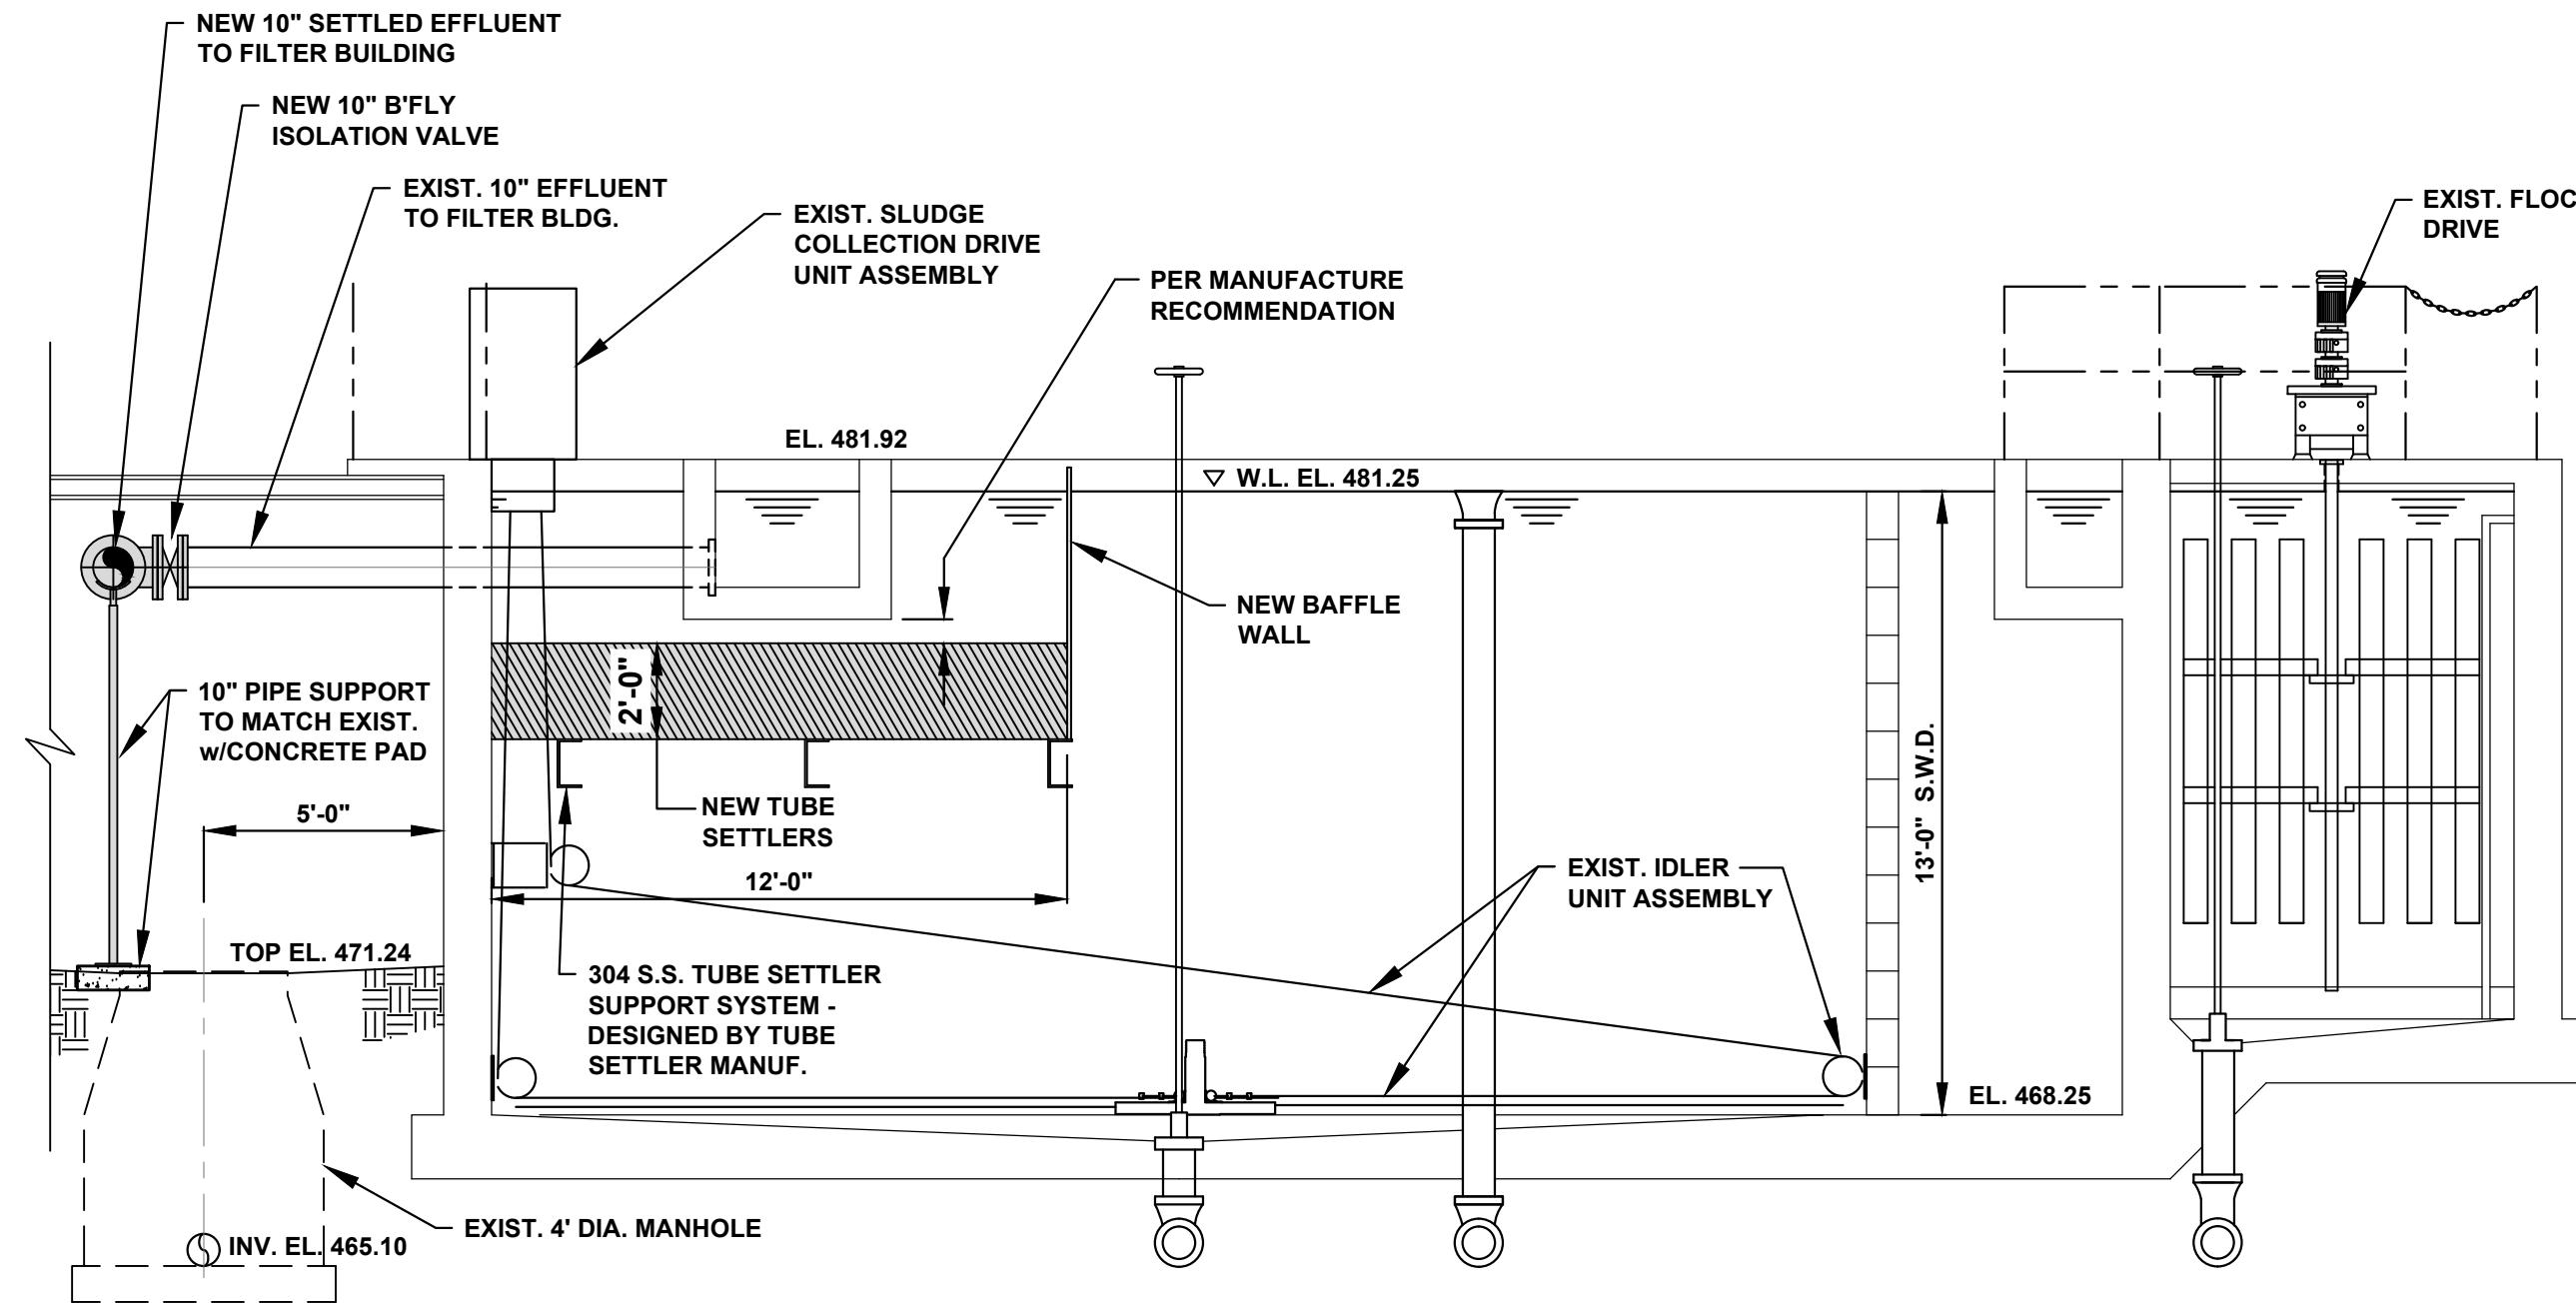

EXISTING SEDIMENTATION BASIN - PLAN


SCALE: 1/4"=1'-0"

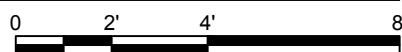

SECTION 1

SCALE: 1/4"=1'-0"

NOTE: CONTRACTOR TO COORDINATE REPAIR OF EXISTING SLUDGE COLLECTION SYSTEM

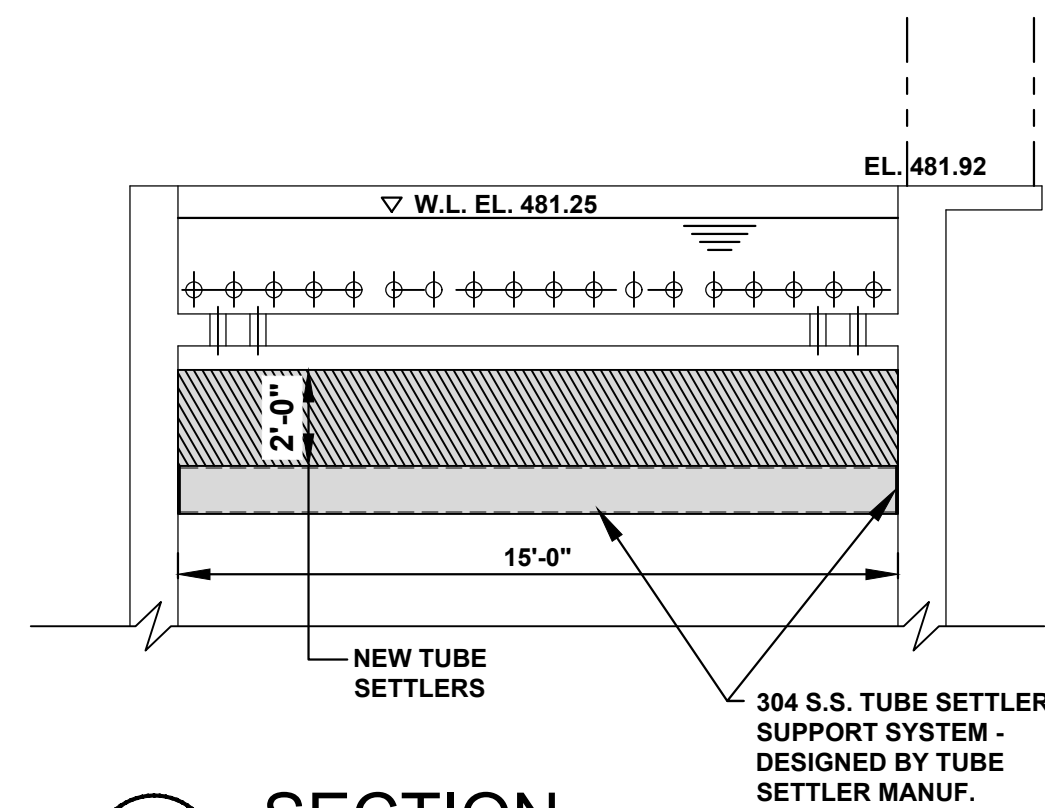

SECTION 2

SCALE: 1/4"=1'-0"

THIS RECORD DOCUMENT HAS BEEN PREPARED BASED ON INFORMATION PROVIDED BY THE CONSTRUCTION CONTRACTOR. GRW ENGINEERS, INC. HAS ATTEMPTED TO VERIFY THE ACCURACY AND/OR COMPLETENESS OF THIS INFORMATION BUT SHALL NOT BE RESPONSIBLE FOR ANY ERRORS OR OMISSIONS WHICH MAY BE INCORPORATED HEREIN AS A RESULT.

GRW
 engineering | architecture | geospatial
 www.grwinc.com

ENGINEER/ARCHITECT: BARRY L. CLOYD
 CONSTRUCTION COMPANY: QUINN CONS. CORP.
 DATE: 09/27/2018

SEE STRUCTURAL DRAWINGS FOR ALL CONCRETE AND STEEL REINFORCING REQUIREMENT

SEE ELECTRICAL DRAWINGS FOR ALL ELECTRICAL APPURTANCES REQUIREMENT

EXISTING SEDIMENTATION / FLOCCULATION BASIN - MODIFICATION, SECTION AND DETAILS
 WATER TREATMENT PLANT EXPANSION
 CITY OF LOBEVILLE, TENNESSEE

DESIGNED	BLC
DRAWN	SH
REVIEWED	JWH
APPROVED	BLC

NO.	DATE	DESCRIPTION

DATE:	JUNE 2015
SCALE:	NOTED
SHEET NO.	

C-4-301

GRW PROJECT NO. 3827-07
CLIENT PROJECT NO.

GRW
 engineering | architecture | geospatial
 www.grwinc.com

This document, originally issued, sealed, and signed by BARRY L. CLOYD, Tennessee Professional Engineer, No. 100893, on JUNE 2015, shall not be used in lieu of a certified document.