



FILE NAME: G:\3827-Lobville\07-WTP Expn\Working Drawings\AutoCAD - Record\Drawing\014_3827-07_C-5-101.dwg
PLOTED BY: rasad
PRINTED: 10/15/2018 @ 11:52AM

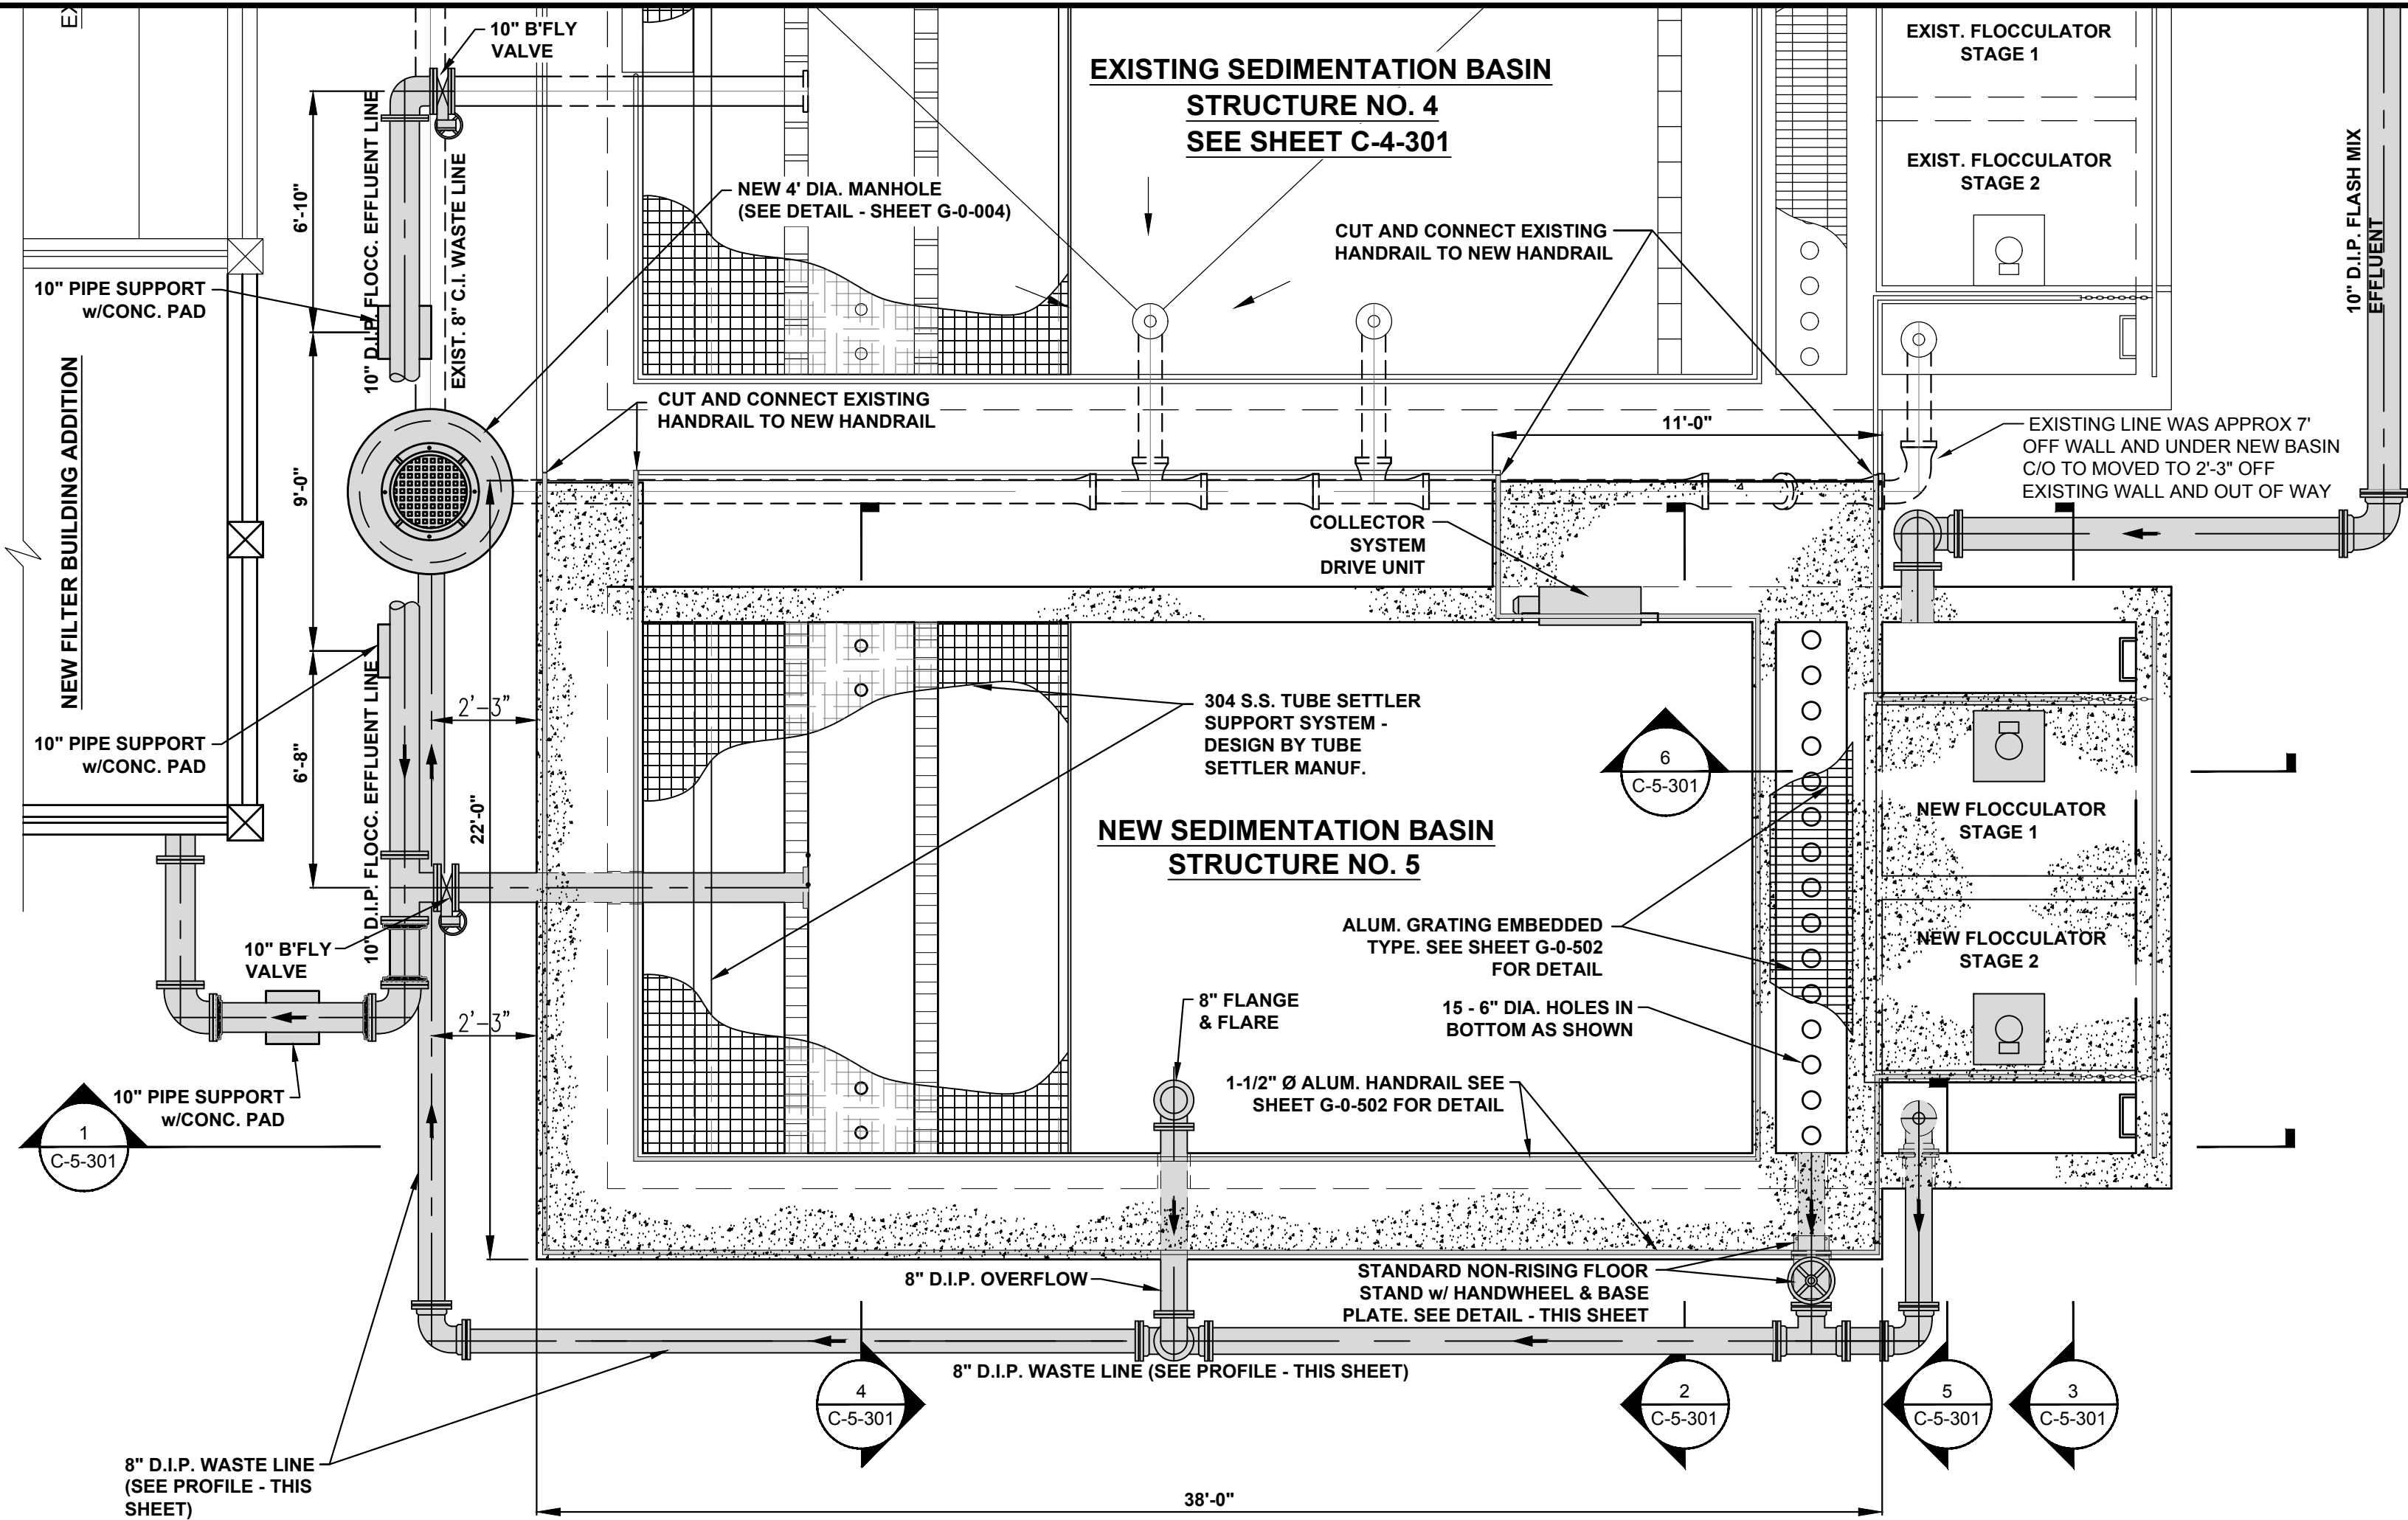


NEW SEDIMENTATION / FLOCCULATION
BASIN - TOP PLAN

SCALE: 1/4"=1'-0"


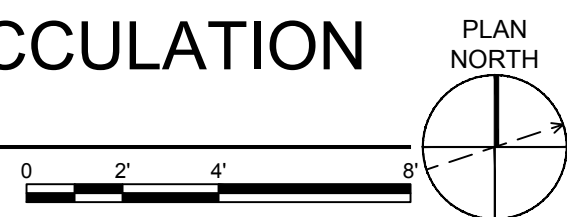


NOTE:
CONTRACTOR TO CONSTRUCT NEW 4' DIA. MANHOLE OVER
EXISTING 8" C.I. WASTE LINE @ EXISTING 8" 90° BEND SHOWN ON
PLANS. INVERT OF NEW MANHOLE TO MATCH EXISTING PIPE
INVERT @ APPROX. ELEV. 465.20'. RECONNECT EXISTING 8" C.I.
WASTE LINES TO NEW MANHOLE AND CONNECT NEW 8" D.I.P.
WASTE LINE FROM NEW SEDIMENTATION BASIN.

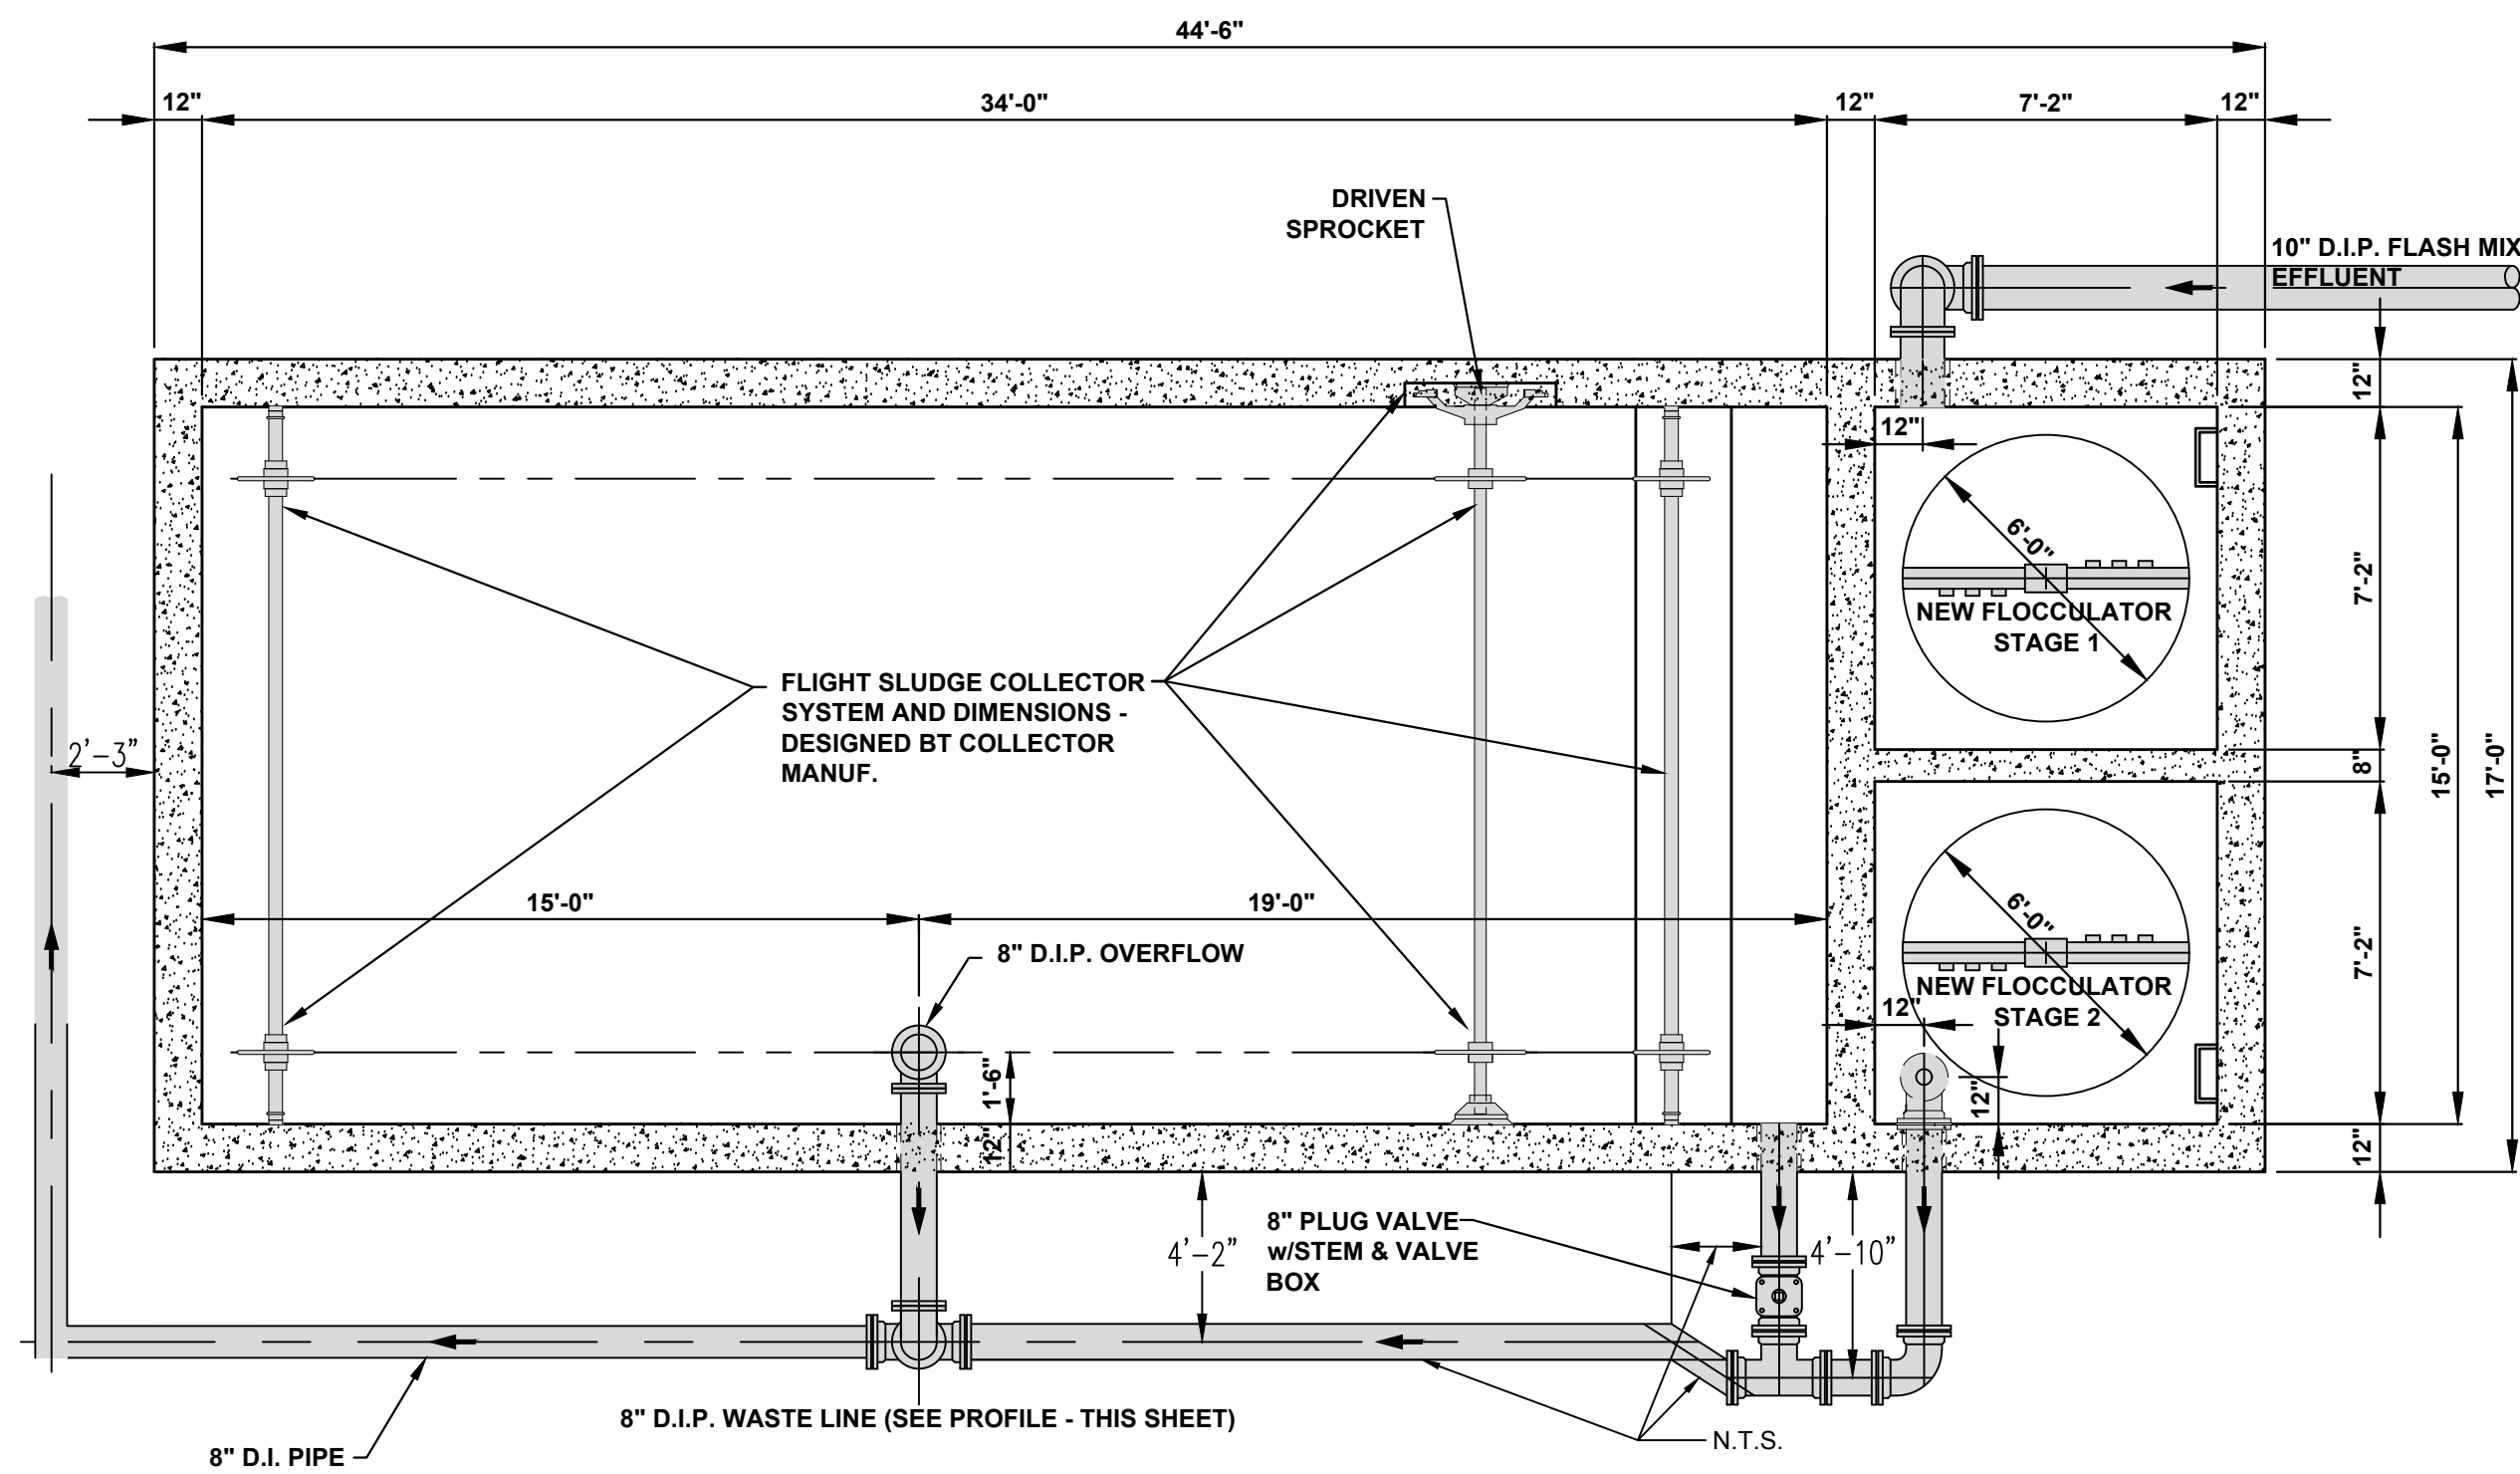



NEW SEDIMENTATION / FLOCCULATION
BASIN - INTERMEDIATE PLAN

SCALE: 1/4"=1'-0"

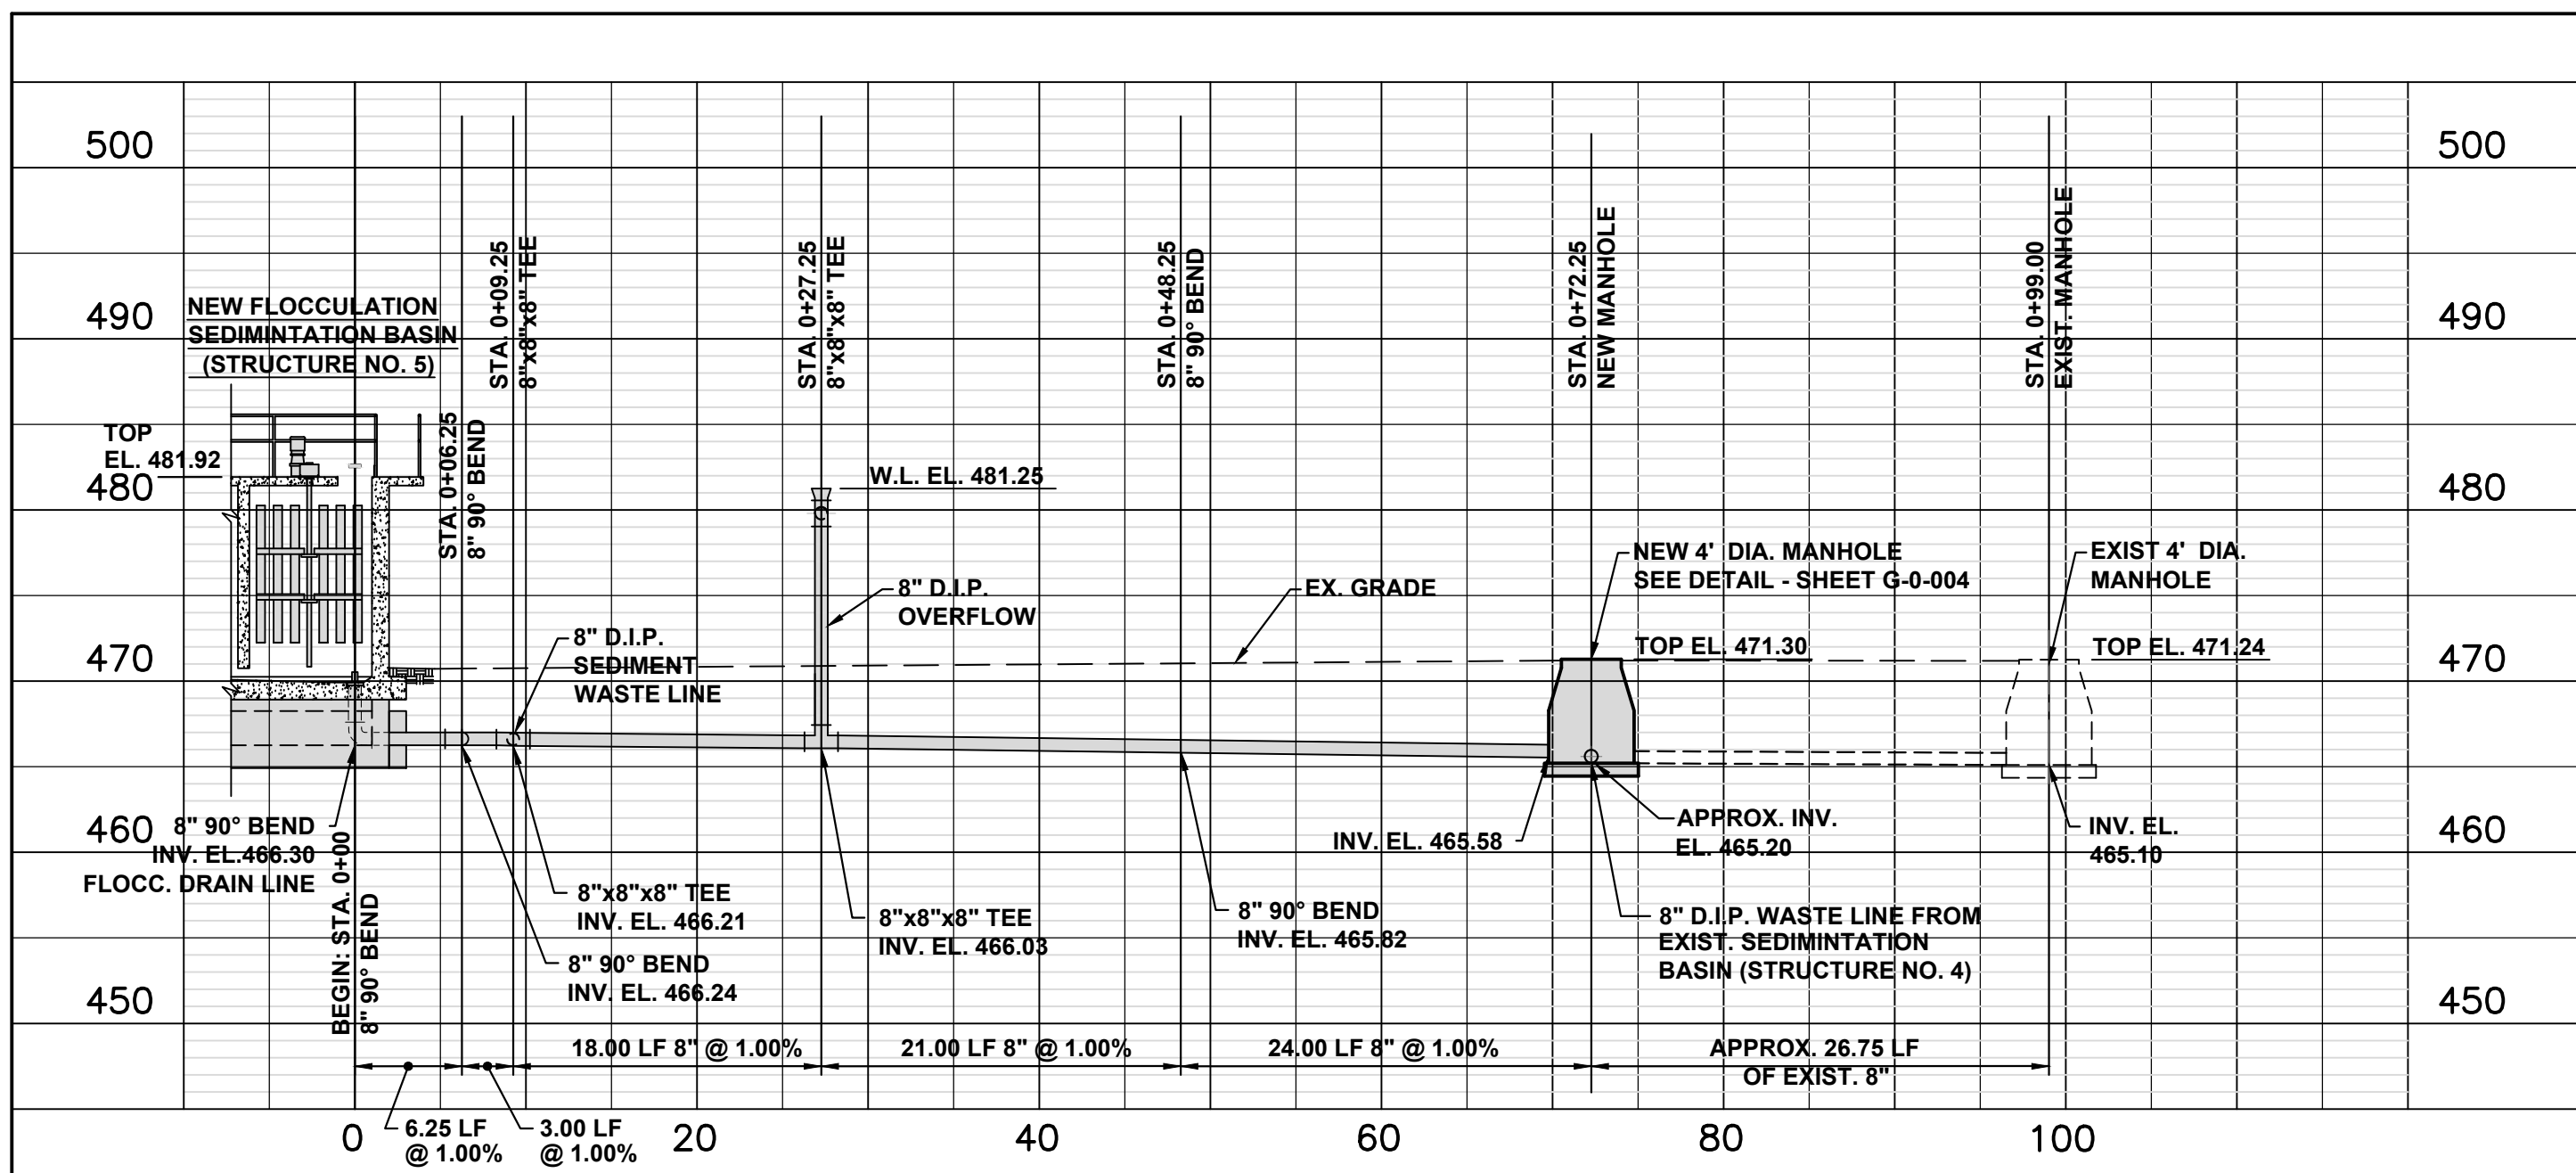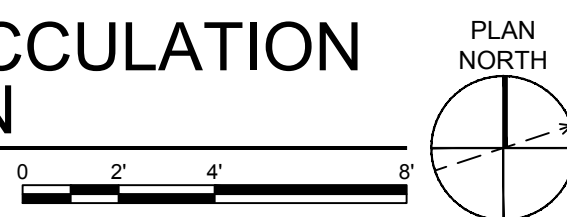

PROFILE - NEW 8" WASTE LINE

NOT TO SCALE

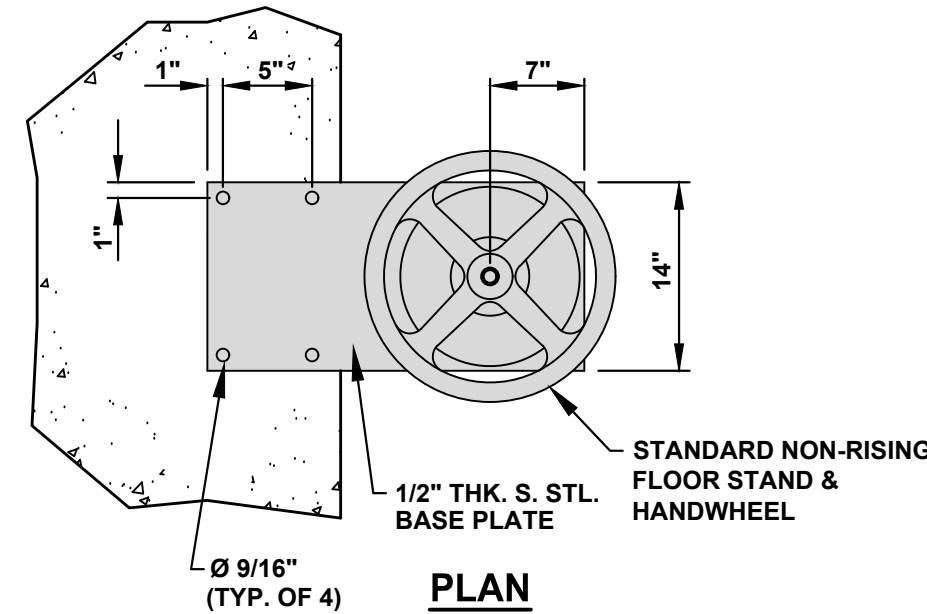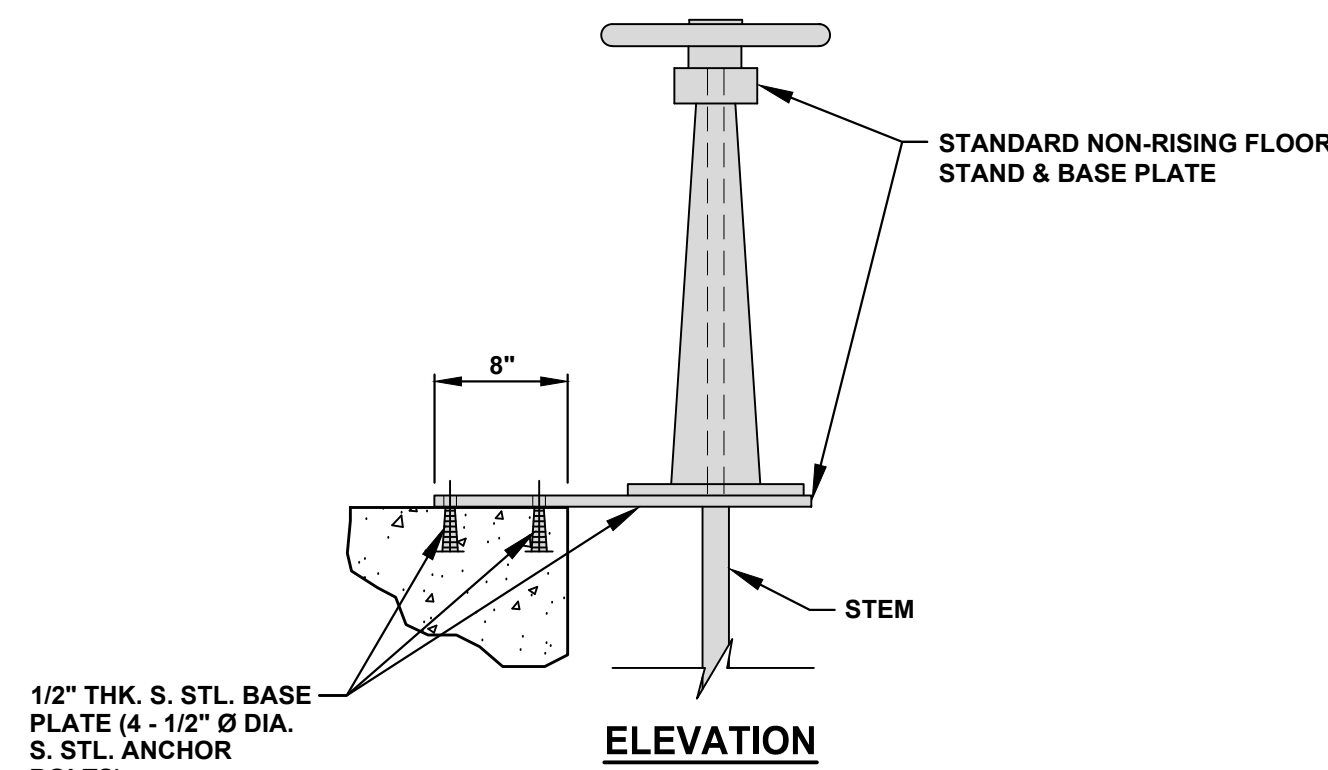

SLUDGE DRAIN VALVE -
FLOOR STAND BASE PLATE

NOT TO SCALE

THIS RECORD DOCUMENT HAS BEEN PREPARED BASED ON INFORMATION PROVIDED BY THE CONSTRUCTION CONTRACTOR. GRW ENGINEERS, INC. HAS ATTEMPTED TO VERIFY THE ACCURACY AND/OR COMPLETENESS OF THIS INFORMATION BUT SHALL NOT BE RESPONSIBLE FOR ANY ERRORS OR OMISSIONS WHICH MAY BE INCORPORATED HEREIN AS A RESULT.	
	
ENGINEER/ARCHITECT: BARRY L. CLOYD	
CONSTRUCTION COMPANY: QUINN CONS. CORP.	
DATE: 09/27/2018	

SEE STRUCTURAL DRAWINGS FOR ALL
CONCRETE AND STEEL REINFORCING
REQUIREMENT

SEE ELECTRICAL DRAWINGS FOR
ALL ELECTRICAL APPURTANCES
REQUIREMENT

NEW FLOCCULATION / SEDIMENTATION
BASIN PLAN, PROFILE AND DETAILS
WATER TREATMENT PLANT EXPANSION
CITY OF LOBELVILLE, TENNESSEE

REVISIONS				DESIGNED:
NO.	DESCRIPTION	DATE	BY	BLC
				DRAWN
				SH
				REVIEWED
				JWH
				APPROVED
				BLC

DATE:
JUNE 2015

SCALE:


NOTED

SHEET NO.

C-5-101

GRW PROJECT NO. 3827-07

CLIENT PROJECT NO.

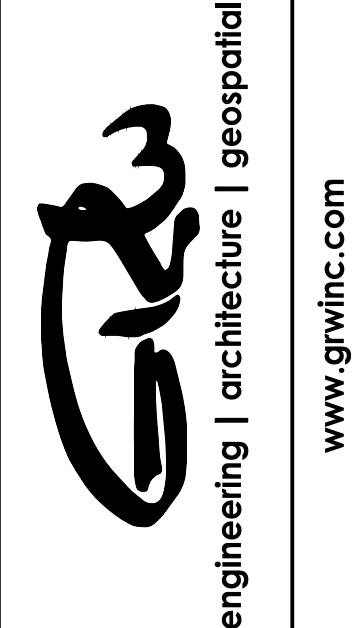

This document, originally issued, sealed, and signed by BARRY L. CLOYD, Tennessee Professional Engineer, No. 100893, on JUNE 2015, shall not be used in lieu of a certified document.

RECORD DRAWINGS