
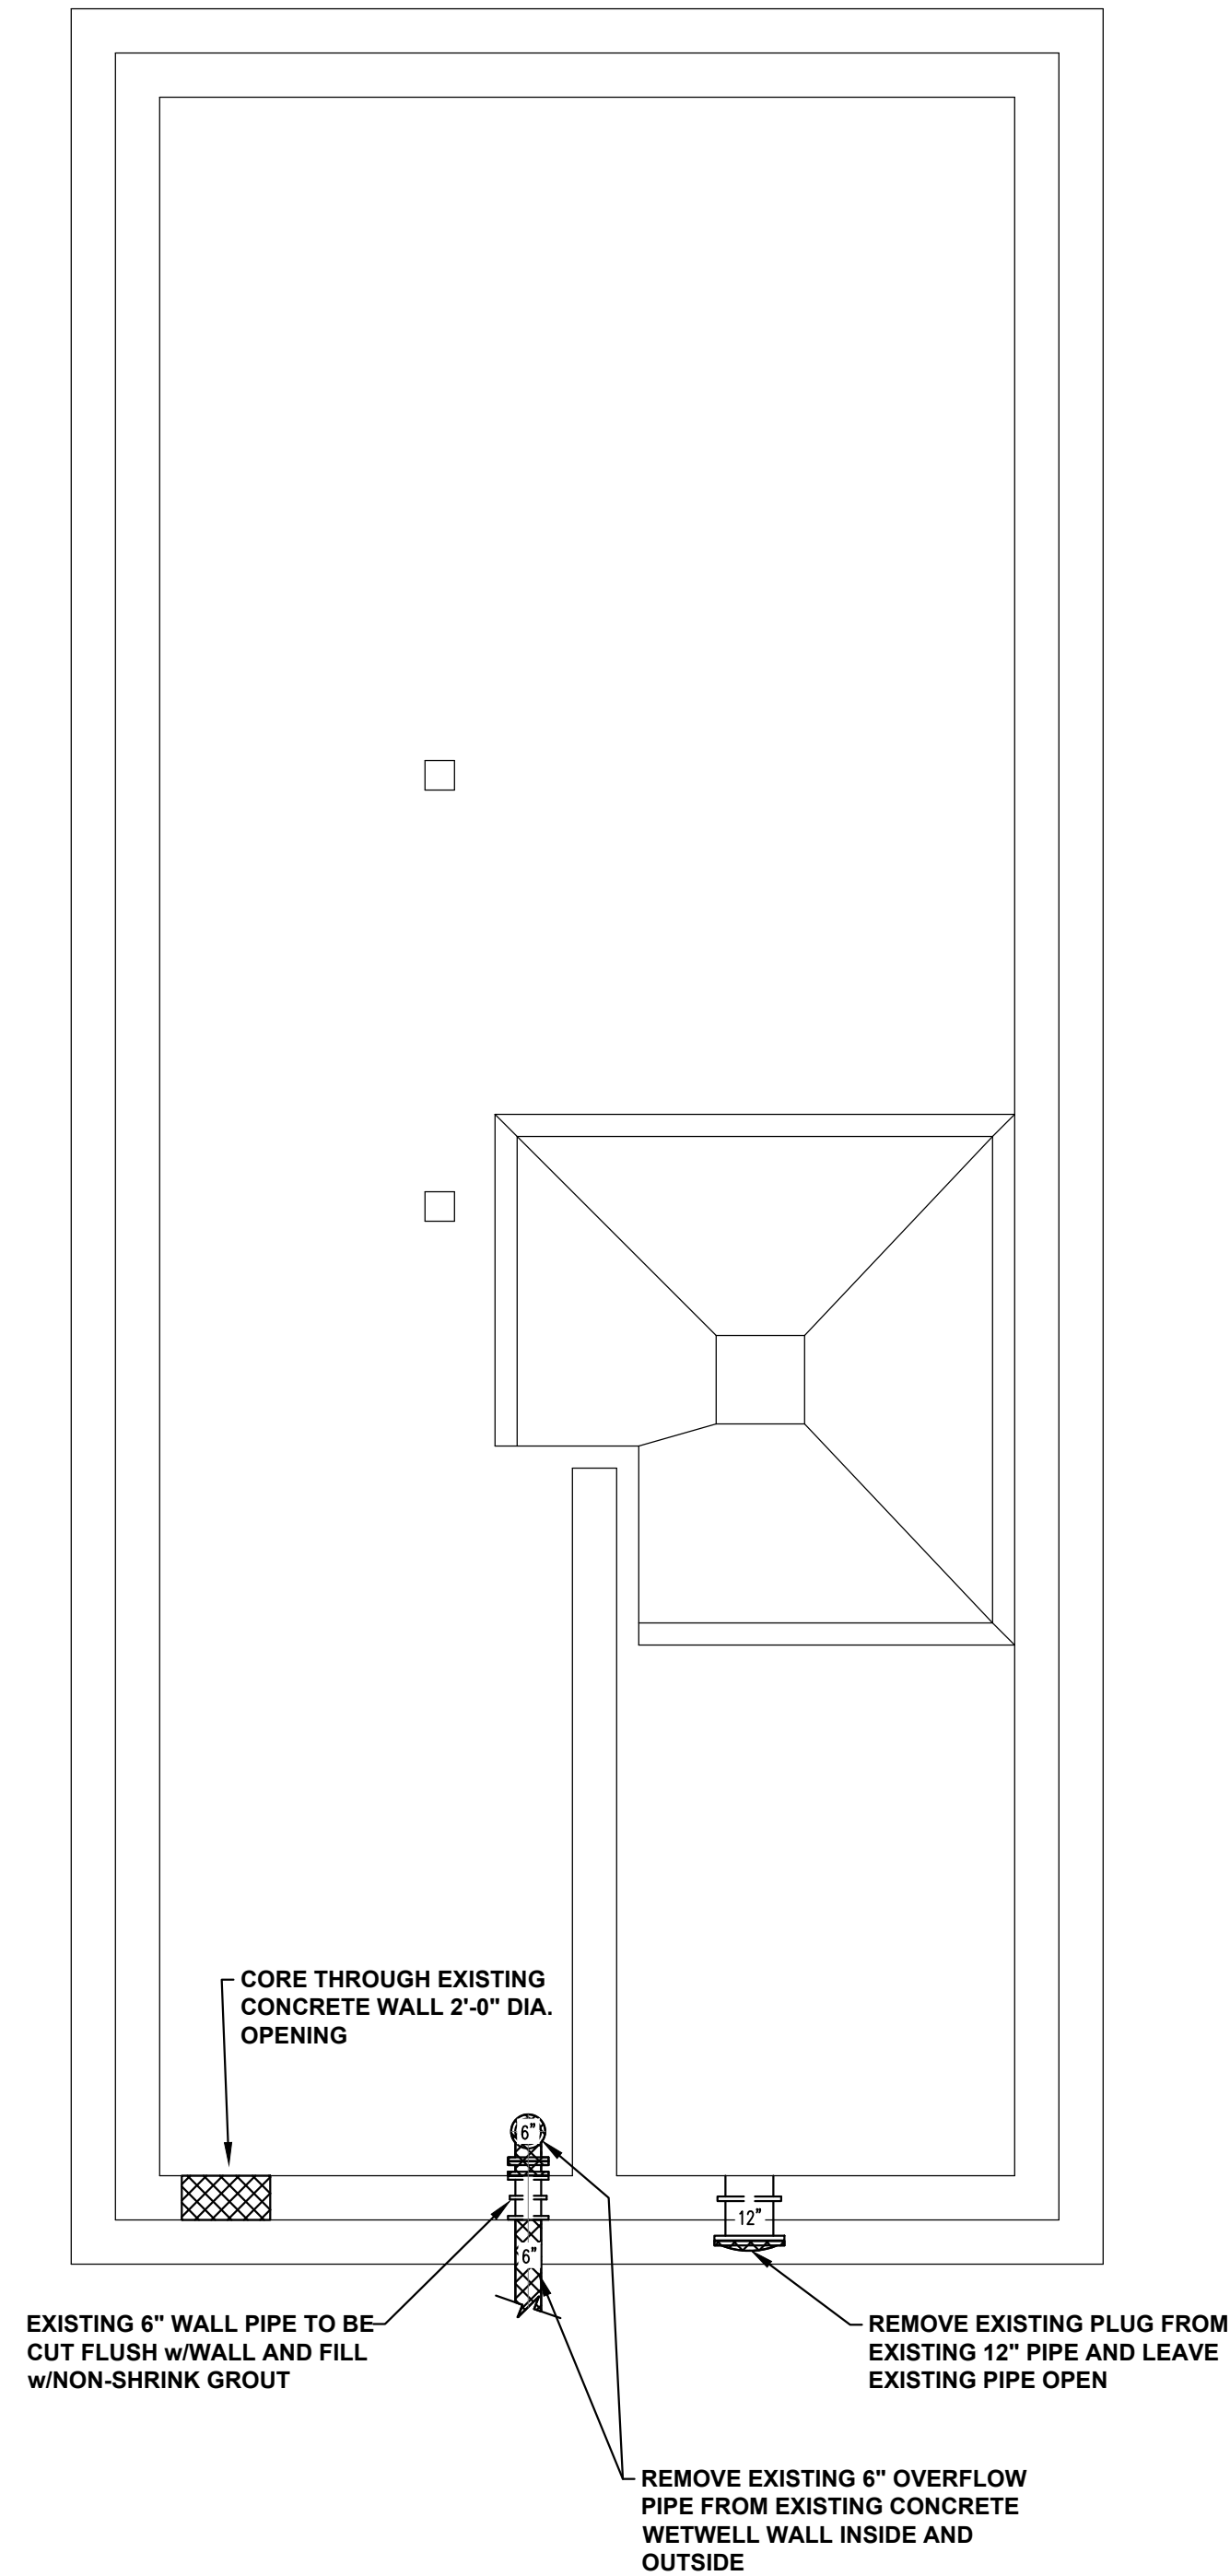
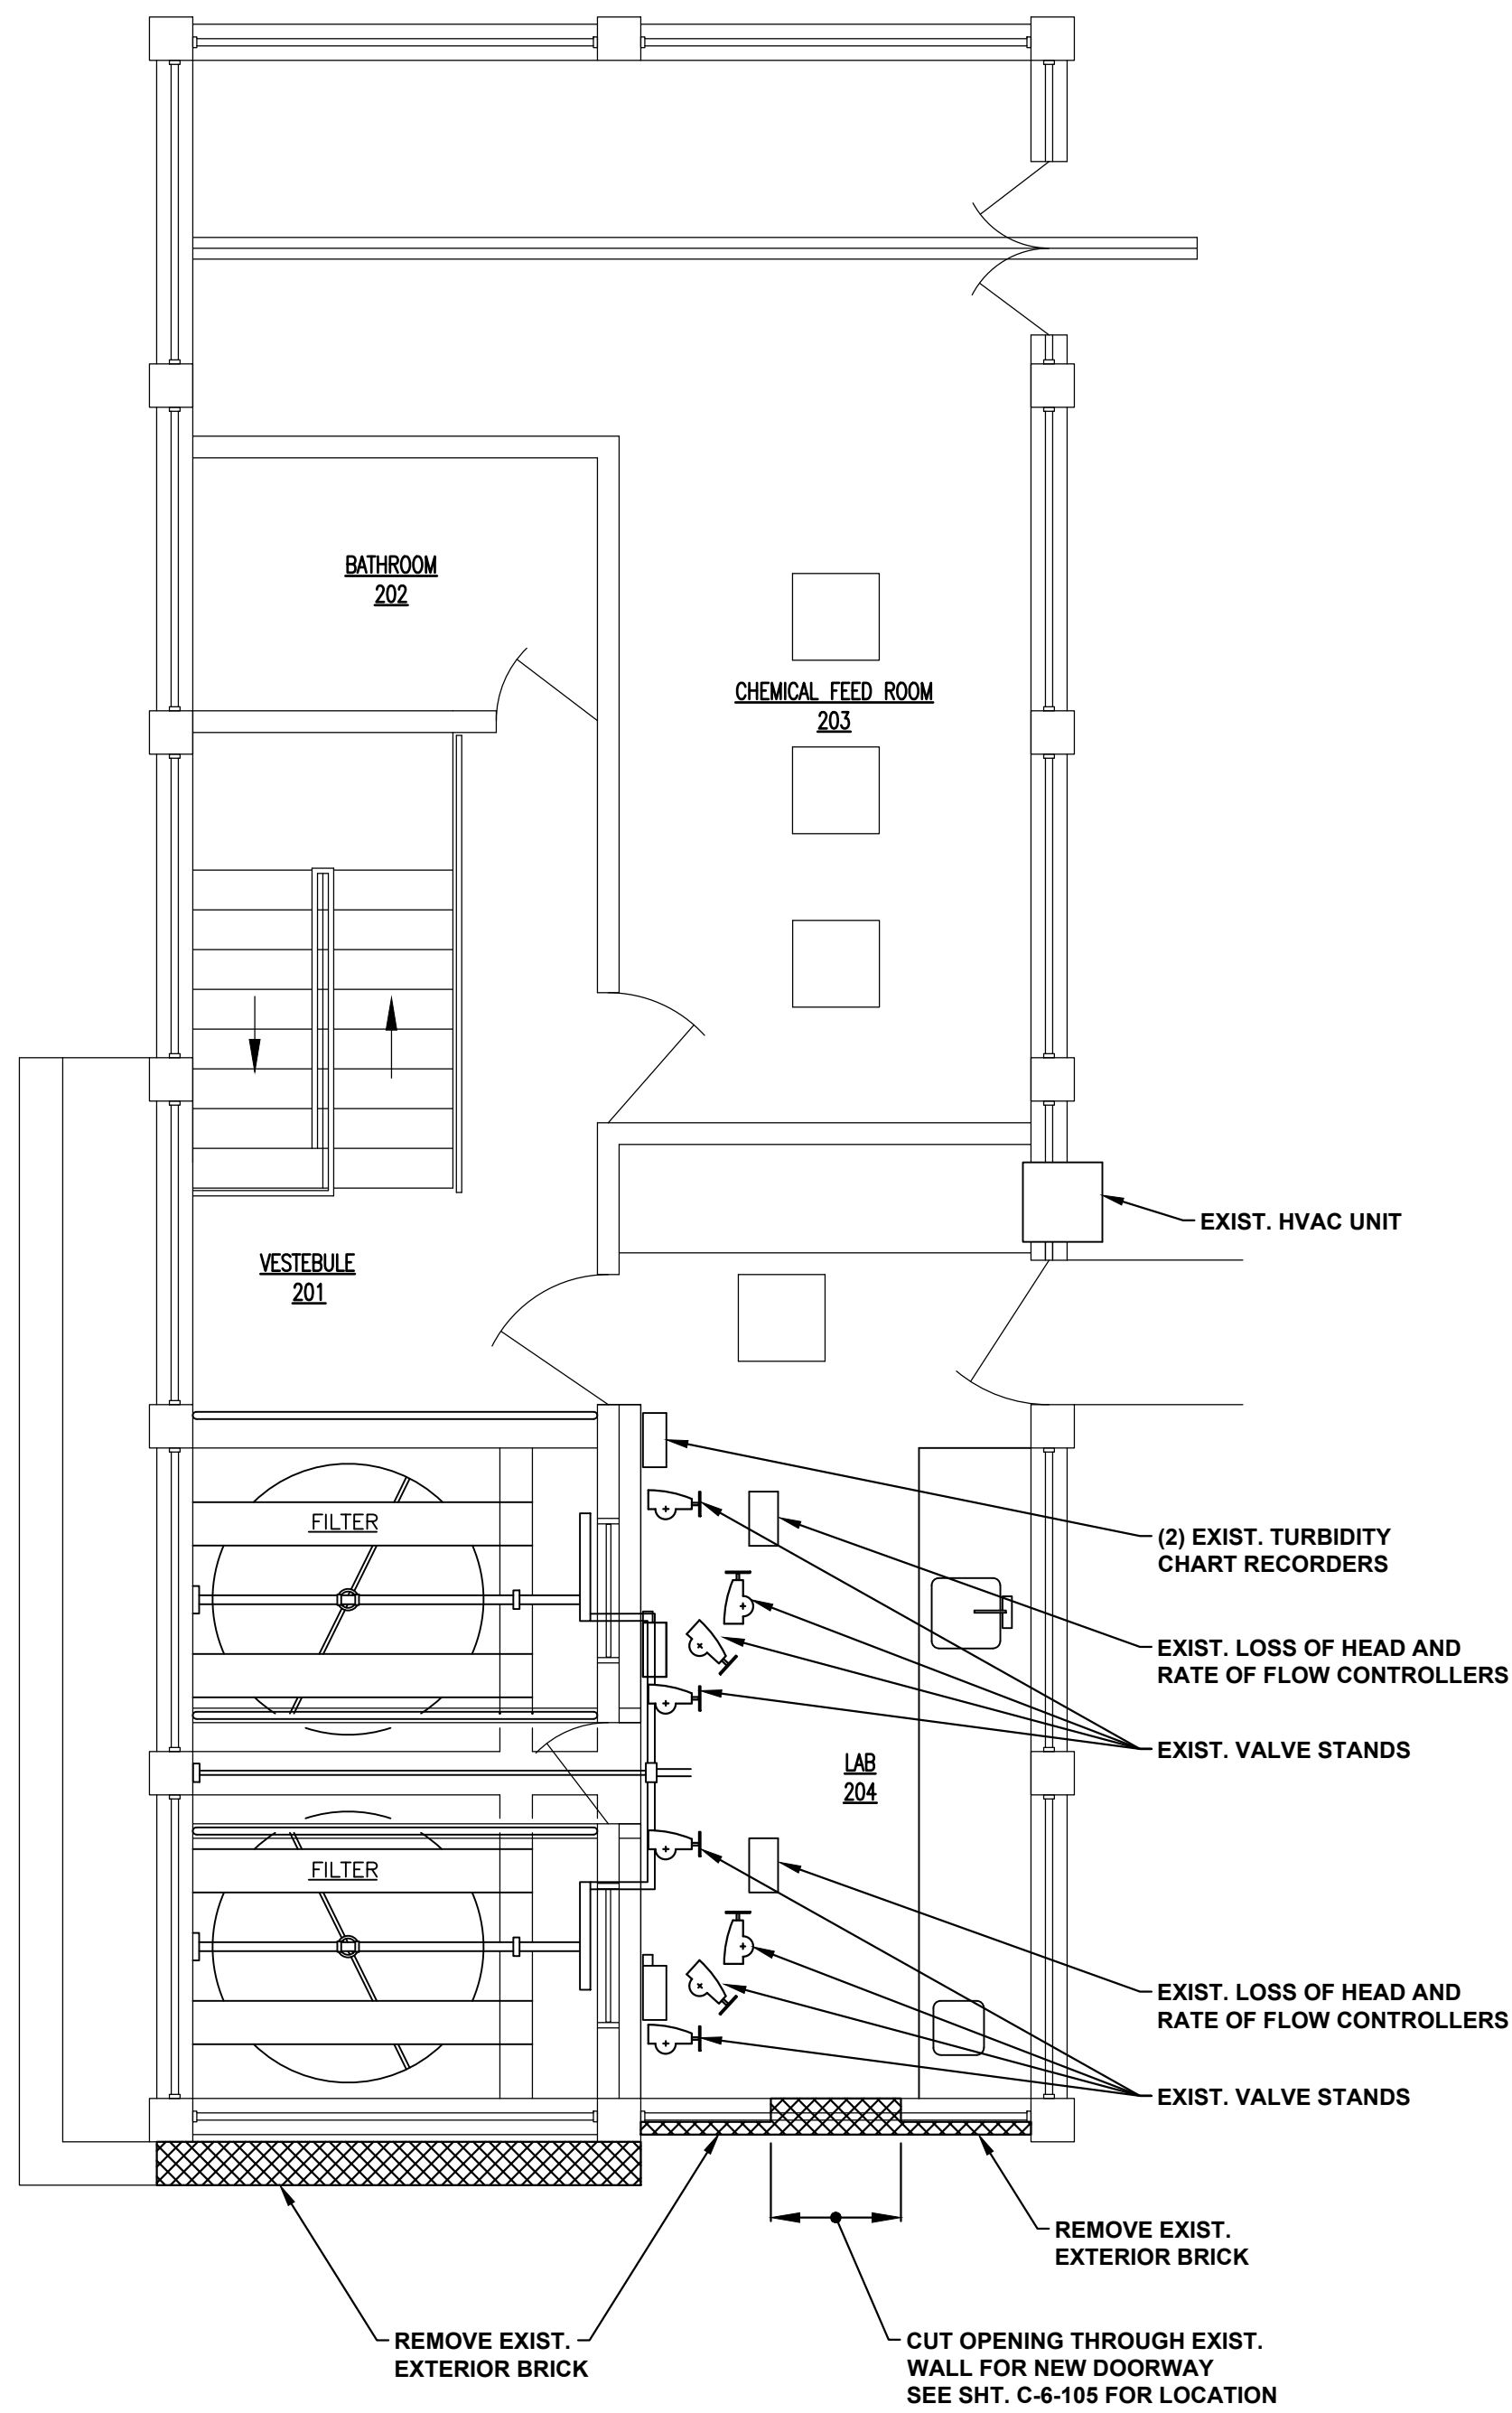


FILE NAME: G:\3827-Lobeville\07-WTP Expansion\Working Drawings\AutoCAD - Record Drawing\06_3827-07_C-6-101.dwg
PRINTED: 10/15/2018 @ 11:52AM
PLOTTED BY: rnzad

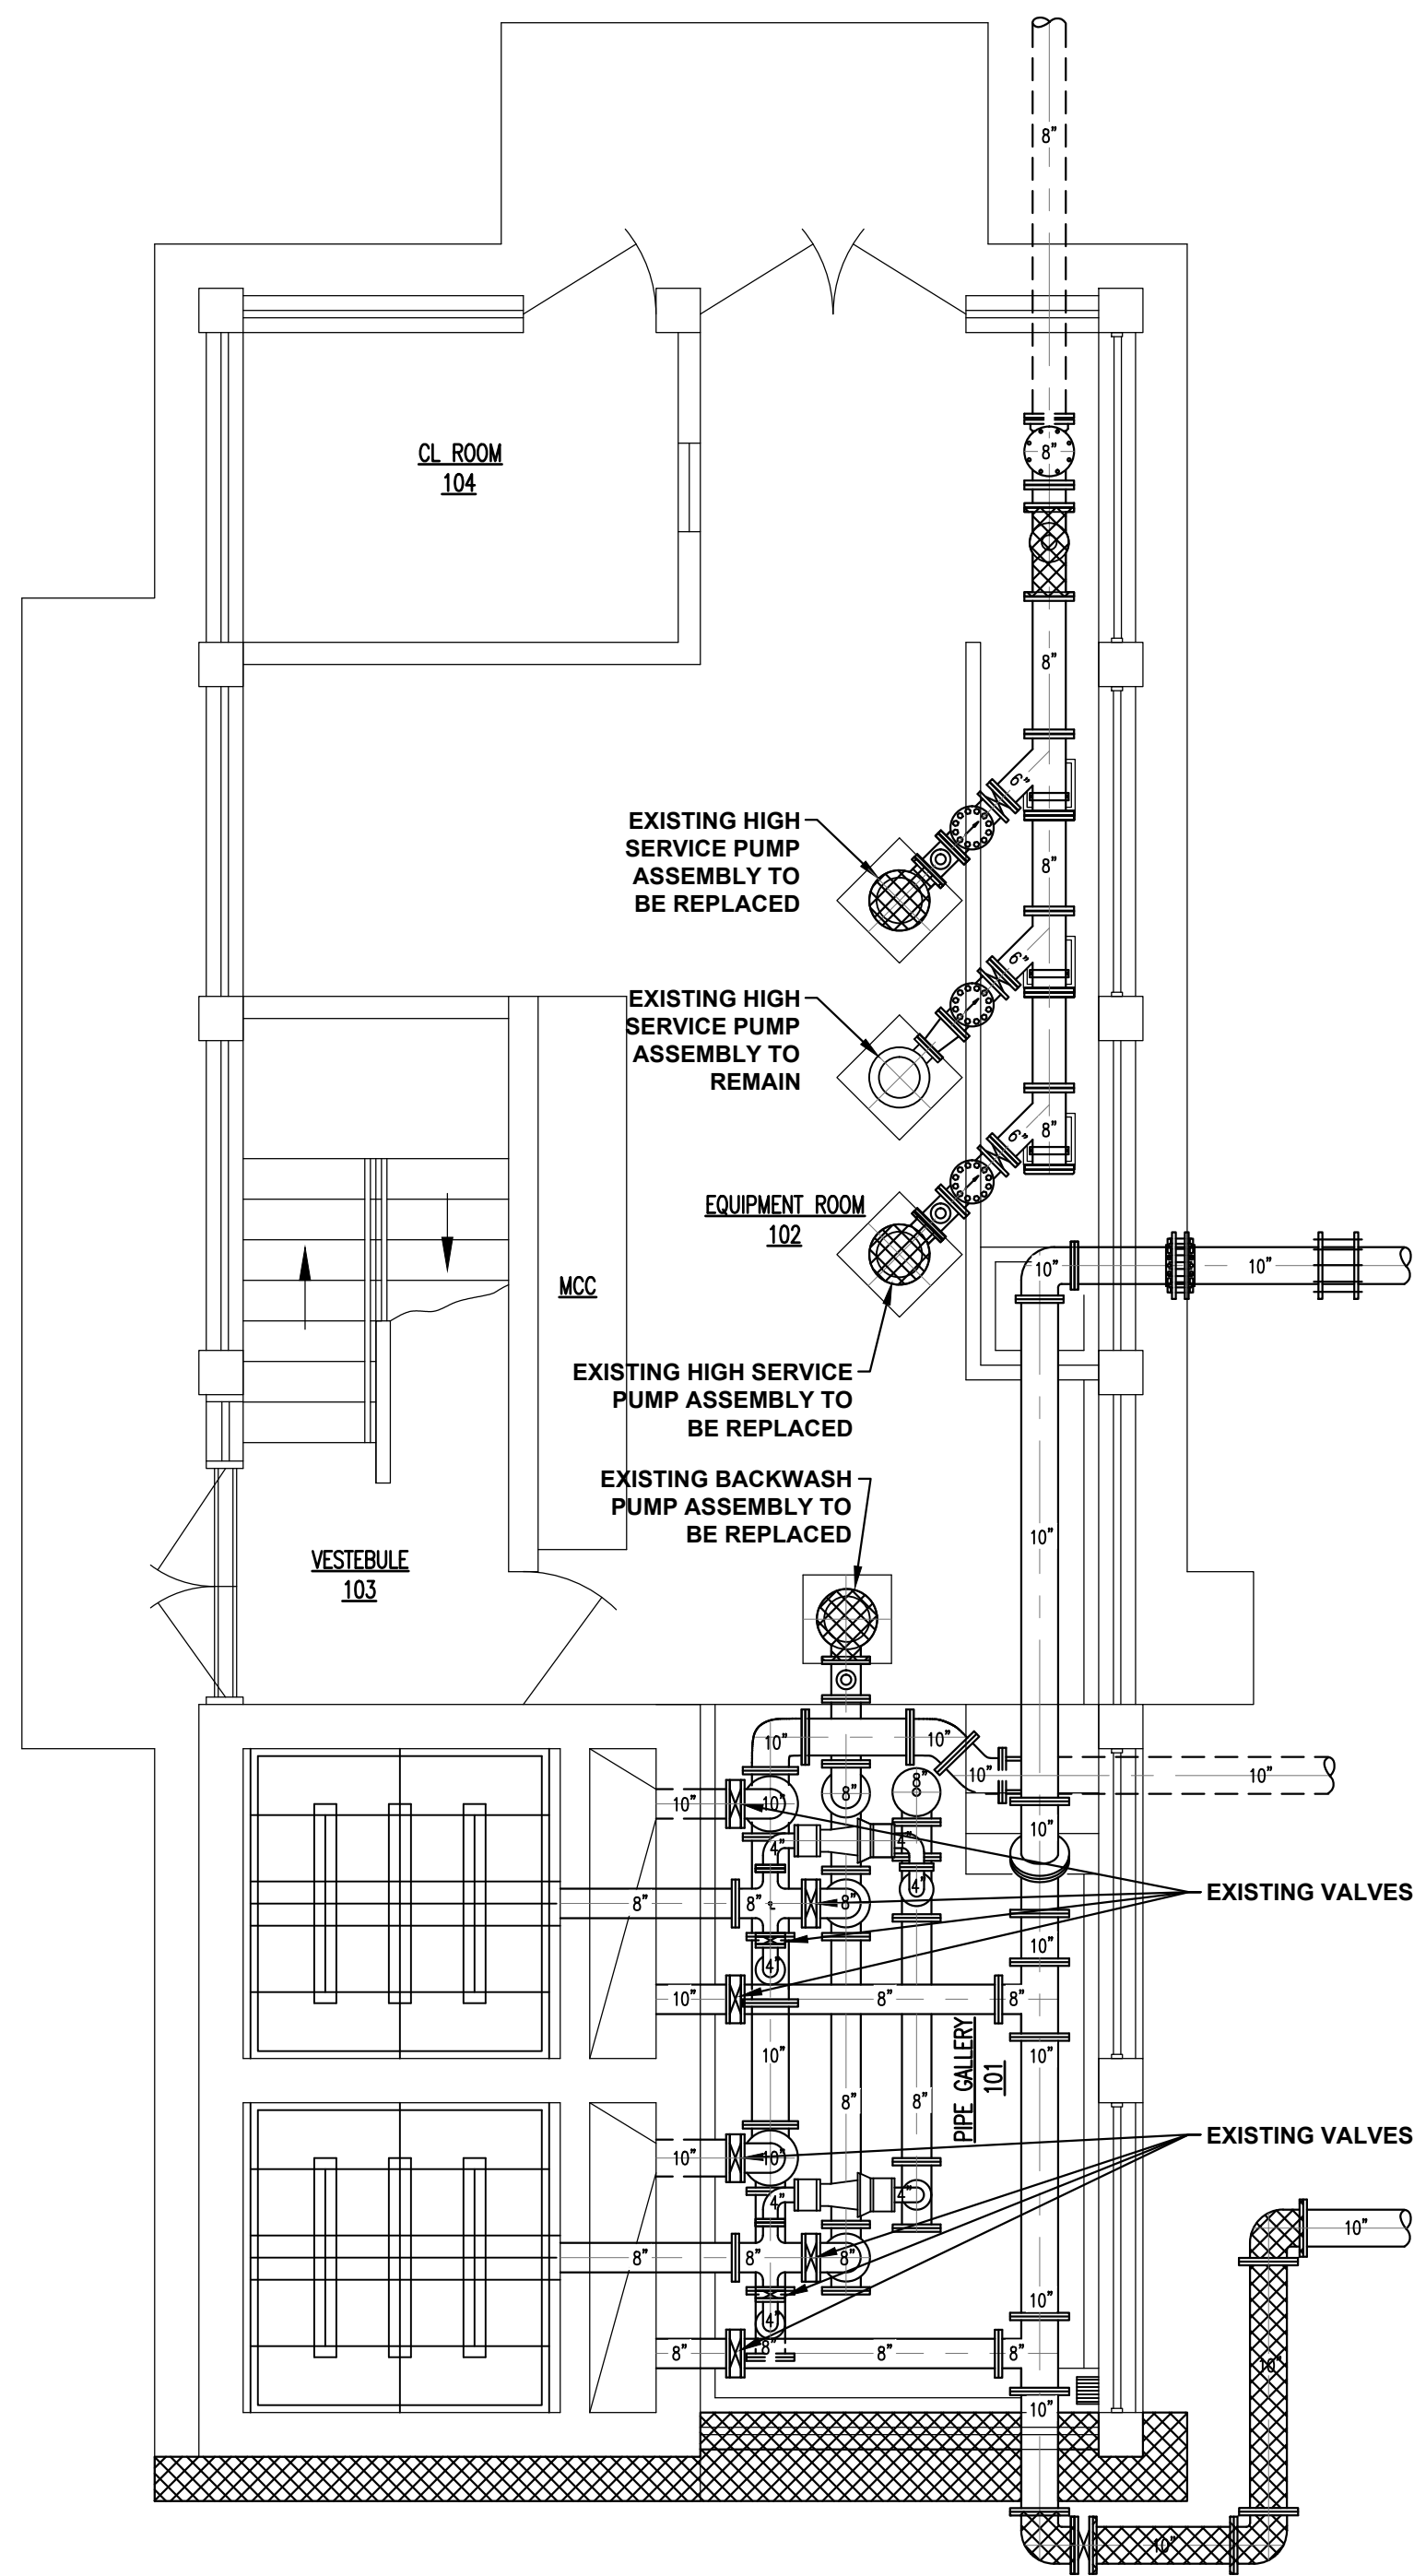

LEGEND

- EXISTING STRUCTURE AND EQUIPMENT TO BE DEMOLISHED
- EXISTING TO REMAIN

THIS RECORD DOCUMENT HAS BEEN PREPARED BASED ON INFORMATION PROVIDED BY THE CONSTRUCTION CONTRACTOR. GRW ENGINEERS, INC. HAS ATTEMPTED TO VERIFY THE ACCURACY AND/OR COMPLETENESS OF THIS INFORMATION BUT SHALL NOT BE RESPONSIBLE FOR ANY ERRORS OR OMISSIONS WHICH MAY BE INCORPORATED HEREIN AS A RESULT.

GRW
engineering | architecture | geospatial
www.grwinc.com

ENGINEER/ARCHITECT: BARRY L. CLOYD
CONSTRUCTION COMPANY: QUINN CONS. CORP.
DATE: 09/27/2018

EXISTING FILTER BUILDING DEMOLITION PLAN WATER TREATMENT PLANT EXPANSION CITY OF LOBEVILLE, TENNESSEE

NO.	DATE	BY	DESIGNED	DRAWN	REVIEWED	APPROVED	SCALE CHECK
			BLC	SH	JWH	BLC	

DATE: JUNE 2015
SCALE: 1" = 100'
SHEET NO. C-6-101

C-6-101

This document, originally issued, sealed, and signed by BARRY L. CLOYD, Tennessee Professional Engineer, No. 100893, on JUNE 2015, shall not be used in lieu of a certified document.

GRW PROJECT NO. 3827-07
CLIENT PROJECT NO.
ALL RIGHTS RESERVED. NO PART OF THIS DOCUMENT SHALL BE REPRODUCED IN WHOLE OR IN PART WITHOUT THE WRITTEN PERMISSION OF GRW ENGINEERS, INC. AND SHALL NOT BE USED FOR ANY OTHER PROJECT OTHER THAN THIS SPECIFIC PROJECT WITHOUT THE WRITTEN PERMISSION.

GRW
engineering | architecture | geospatial
www.grwinc.com