


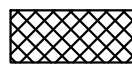

LEGEND

-  EXISTING STRUCTURE AND EQUIPMENT TO BE DEMOLISHED
-  EXISTING TO REMAIN

DEMOLITION NOTES:

- 1.) CONTRACTOR SHALL COORDINATE DEMOLITION SO AS TO KEEP EXISTING FILTER BUILDING IN OPERATION BY KEEPING ALL EXISTING AND NEW EQUIPMENT PROTECTED UNTIL COMPLETION OF THE FILTER BUILDING MODIFICATION / UPGRADE.
- 2.) EXISTING ROOFING MATERIALS, HATCHES AND EQUIPMENT TO BE REMOVED AS SHOWN AND ALL RESULTING DEBRIS REMOVED OFFSITE.

THIS RECORD DOCUMENT HAS BEEN PREPARED BASED ON INFORMATION PROVIDED BY THE CONSTRUCTION CONTRACTOR. GRW ENGINEERS, INC. HAS ATTEMPTED TO VERIFY THE ACCURACY AND/OR COMPLETENESS OF THIS INFORMATION BUT SHALL NOT BE RESPONSIBLE FOR ANY ERRORS OR OMISSIONS WHICH MAY BE INCORPORATED HEREIN AS A RESULT.



engineering | architecture | geospatial
www.grwinc.com

ENGINEER/ARCHITECT: BARRY L. CLOYD

CONSTRUCTION COMPANY: QUINN CONS. CORP.

DATE: 09/27/2018

GRW PROJECT NO. 3827-07		CLIENT PROJECT NO.		ALL RIGHTS RESERVED. THIS DRAWING IS THE PROPERTY OF GRW ENGINEERS, INC. AND SHALL NOT BE REPRODUCED IN WHOLE OR IN PART WITHOUT WRITTEN PERMISSION.	
		engineering architecture geospatial		www.grwinc.com	
EXISTING FILTER BUILDING DEMOLITION PLAN AND DETAILS WATER TREATMENT PLANT EXPANSION CITY OF LOBELVILLE, TENNESSEE					
DESIGNED: BLC		DRAWN: SH		REVIEWED: JWH	
DATE: _____		DATE: _____		DATE: _____	
NO. _____		NO. _____		NO. _____	
DESCRIPTION: _____		DESCRIPTION: _____		DESCRIPTION: _____	
SCALE CHECK: _____		SCALE CHECK: _____		SCALE CHECK: _____	
DATE: JUNE 2015					
SCALE: 1" = 100'					
SHEET NO. C-6-102					

RECORD DRAWINGS

This document, originally issued, sealed, and signed by BARRY L. CLOYD, Tennessee Professional Engineer, No. 100893, on JUNE 2015, shall not be used in lieu of a certified document.