


BAFFLE ANCHORING DETAIL "A"  
 NOT TO SCALE




INTERMEDIATE SUPPORT DETAIL "C"  
 NOT TO SCALE

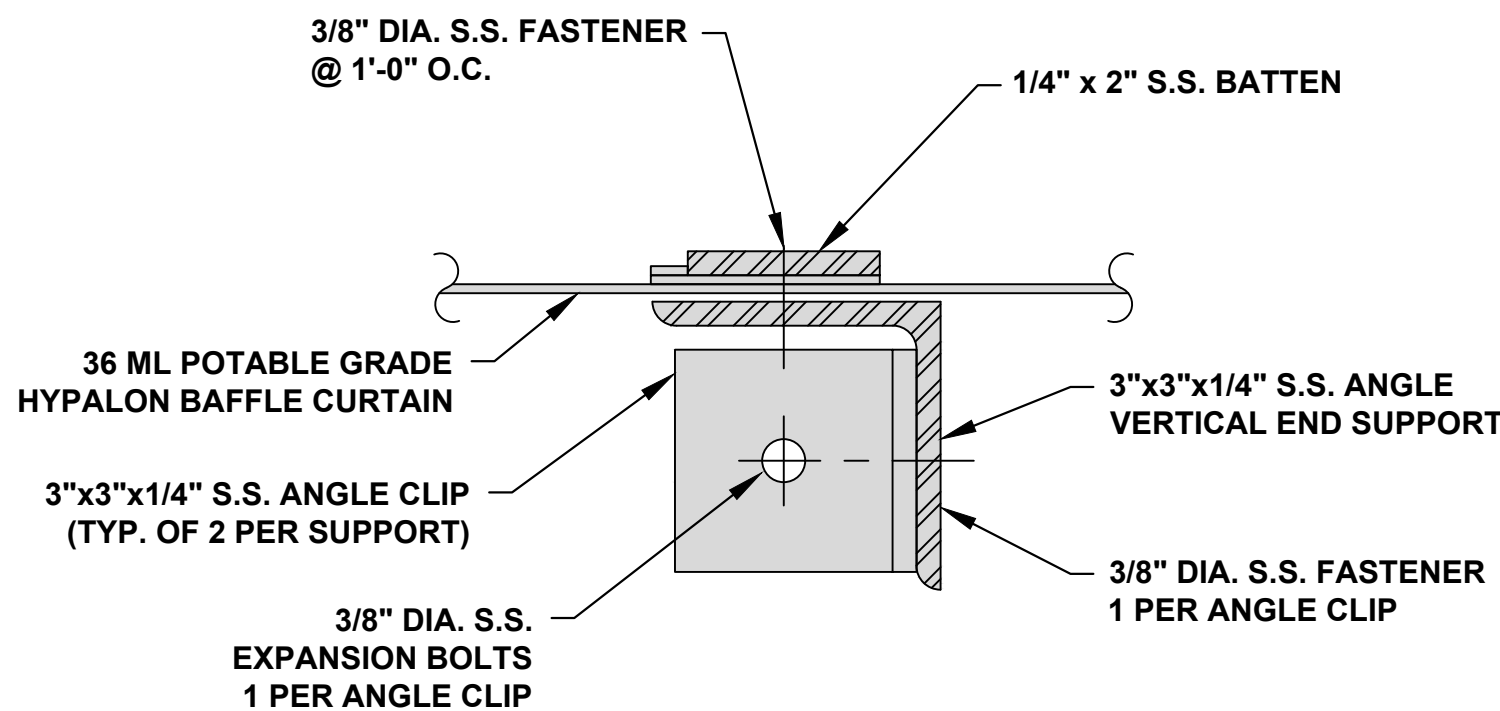


LEGEND


- PROPOSED / NEW
- EXISTING TO REMAIN

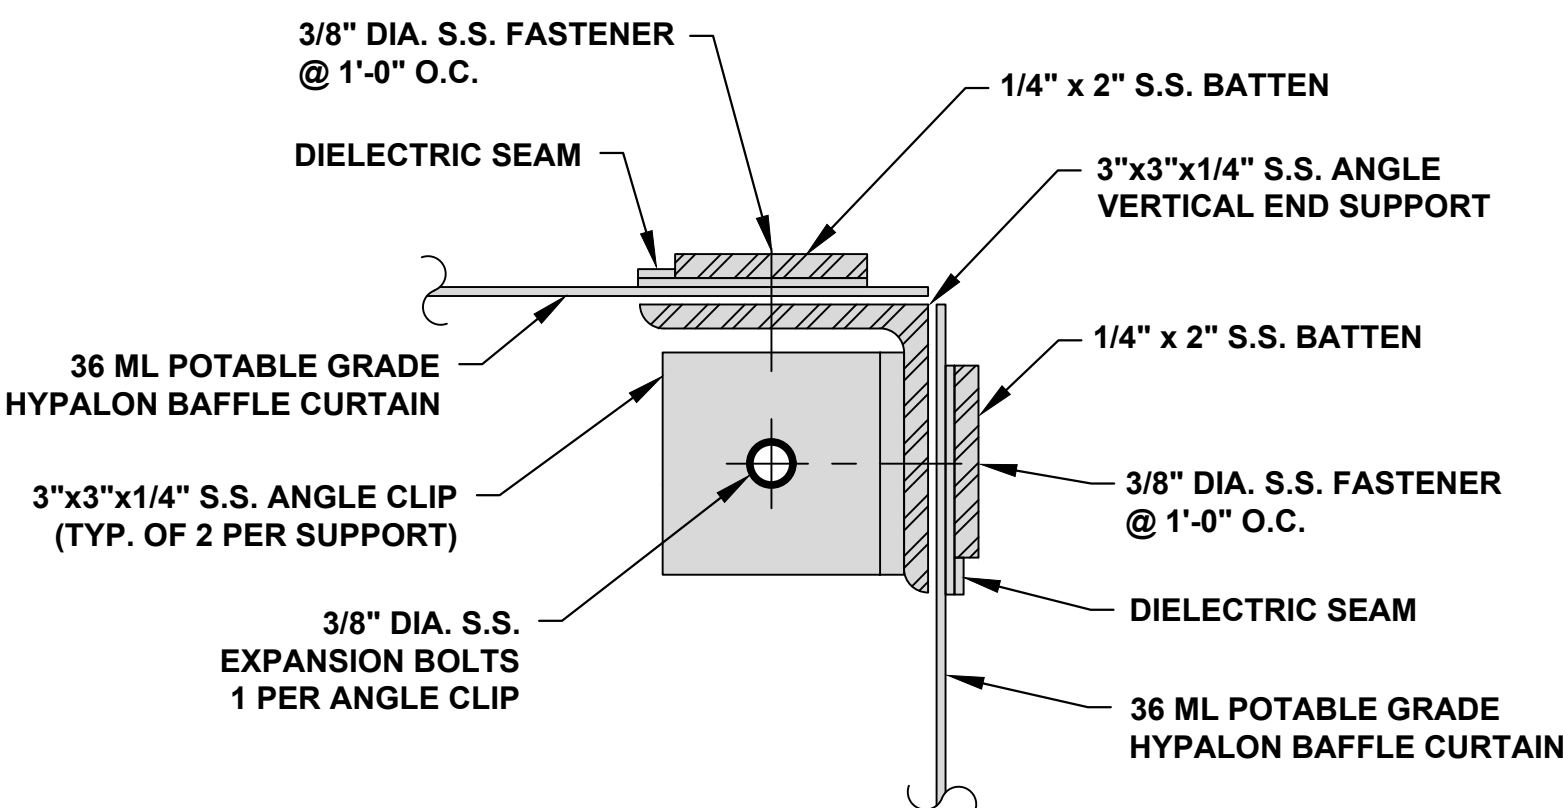

CORNER SUPPORT DETAIL "D"  
 NOT TO SCALE

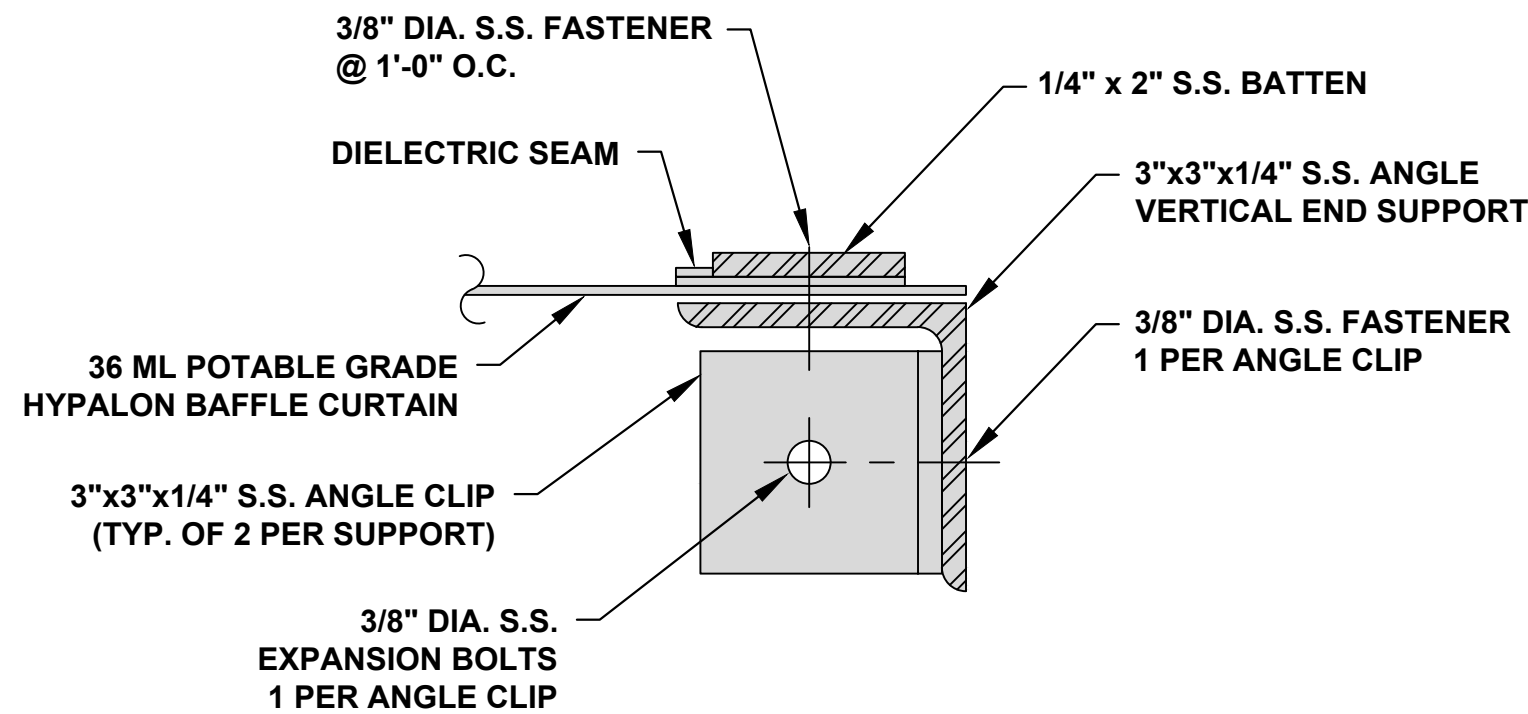

END SUPPORT DETAIL "B"  
 NOT TO SCALE

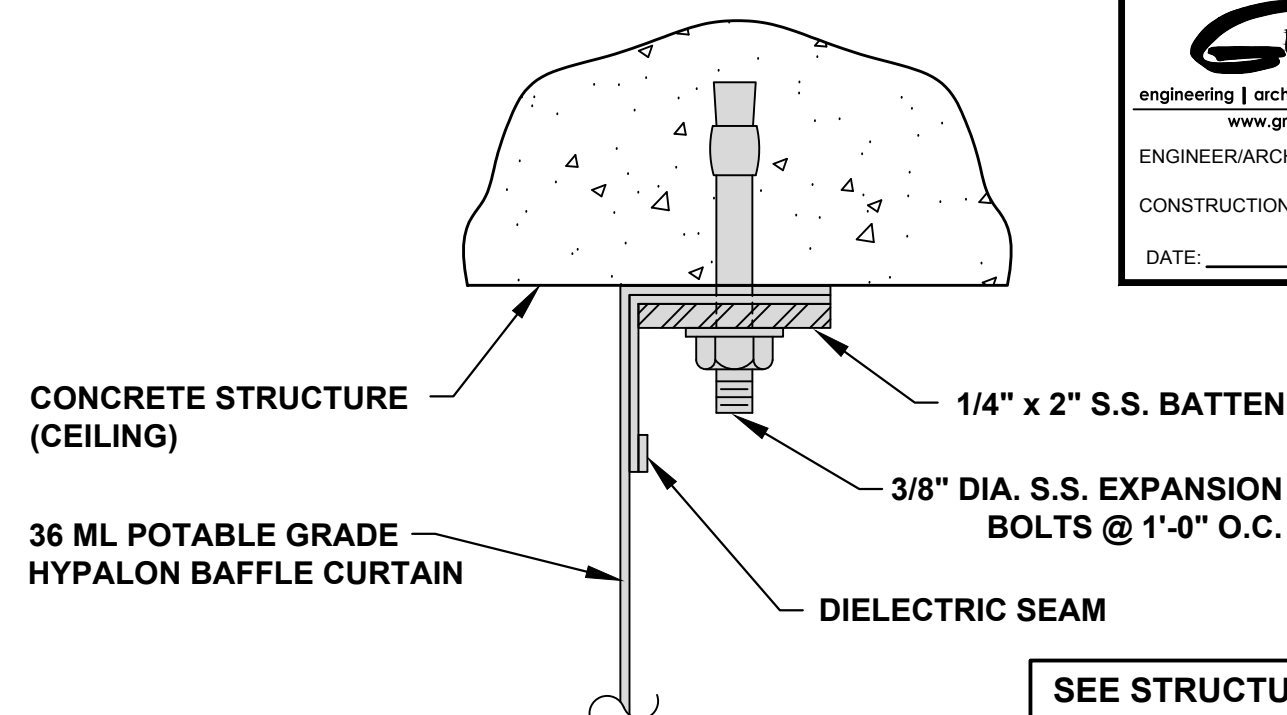

SECTION E-E  
 NOT TO SCALE

THIS RECORD DOCUMENT HAS BEEN PREPARED BASED ON INFORMATION PROVIDED BY THE CONSTRUCTION CONTRACTOR. GRW ENGINEERS, INC. HAS ATTEMPTED TO VERIFY THE ACCURACY AND/OR COMPLETENESS OF THIS INFORMATION BUT SHALL NOT BE RESPONSIBLE FOR ANY ERRORS OR OMISSIONS WHICH MAY BE INCORPORATED HEREIN AS A RESULT.

engineering | architecture | geospatial  
 ENGINEER/ARCHITECT: BARRY L. CLOYD  
 CONSTRUCTION COMPANY: QUINN CONS. CORP.  
 DATE: 09/27/2018

SEE STRUCTURAL DRAWINGS FOR ALL CONCRETE AND STEEL REINFORCING REQUIREMENT

SEE ELECTRICAL DRAWINGS FOR ALL ELECTRICAL APPURTANCES REQUIREMENT

This document, originally issued, sealed, and signed by BARRY L. CLOYD, Tennessee Professional Engineer, No. 100893, on JUNE 2015, shall not be used in lieu of a certified document.

GRW PROJECT NO. 3827-07  
 CLIENT PROJECT NO.  
 ALL RIGHTS RESERVED. NO PART OF THIS DOCUMENT SHALL BE REPRODUCED IN WHOLE OR IN PART WITHOUT THE WRITTEN PERMISSION OF GRW ENGINEERS, INC.

engineering | architecture | geospatial  
 www.grwinc.com

CLEARWELL PLAN AND DETAILS  
 WATER TREATMENT PLANT EXPANSION  
 CITY OF LOBELVILLE, TENNESSEE

DESIGNED: BLC  
 DRAWN: SH  
 REVIEWED: JWH  
 APPROVED: BLC

NO.	DATE	DESCRIPTION

DATE: JUNE 2015  
 SCALE: NOTED  
 SHEET NO.

C-6-103