


FILE NAME: G:\3827-Lobeville\07-WTP Expans\Working Drawings\AutoCAD - Record Drawing\019_3827-07_C-6-104.dwg

PRINTED: 10/15/2018 @ 11:52AM

PLOTTED BY: rnzad

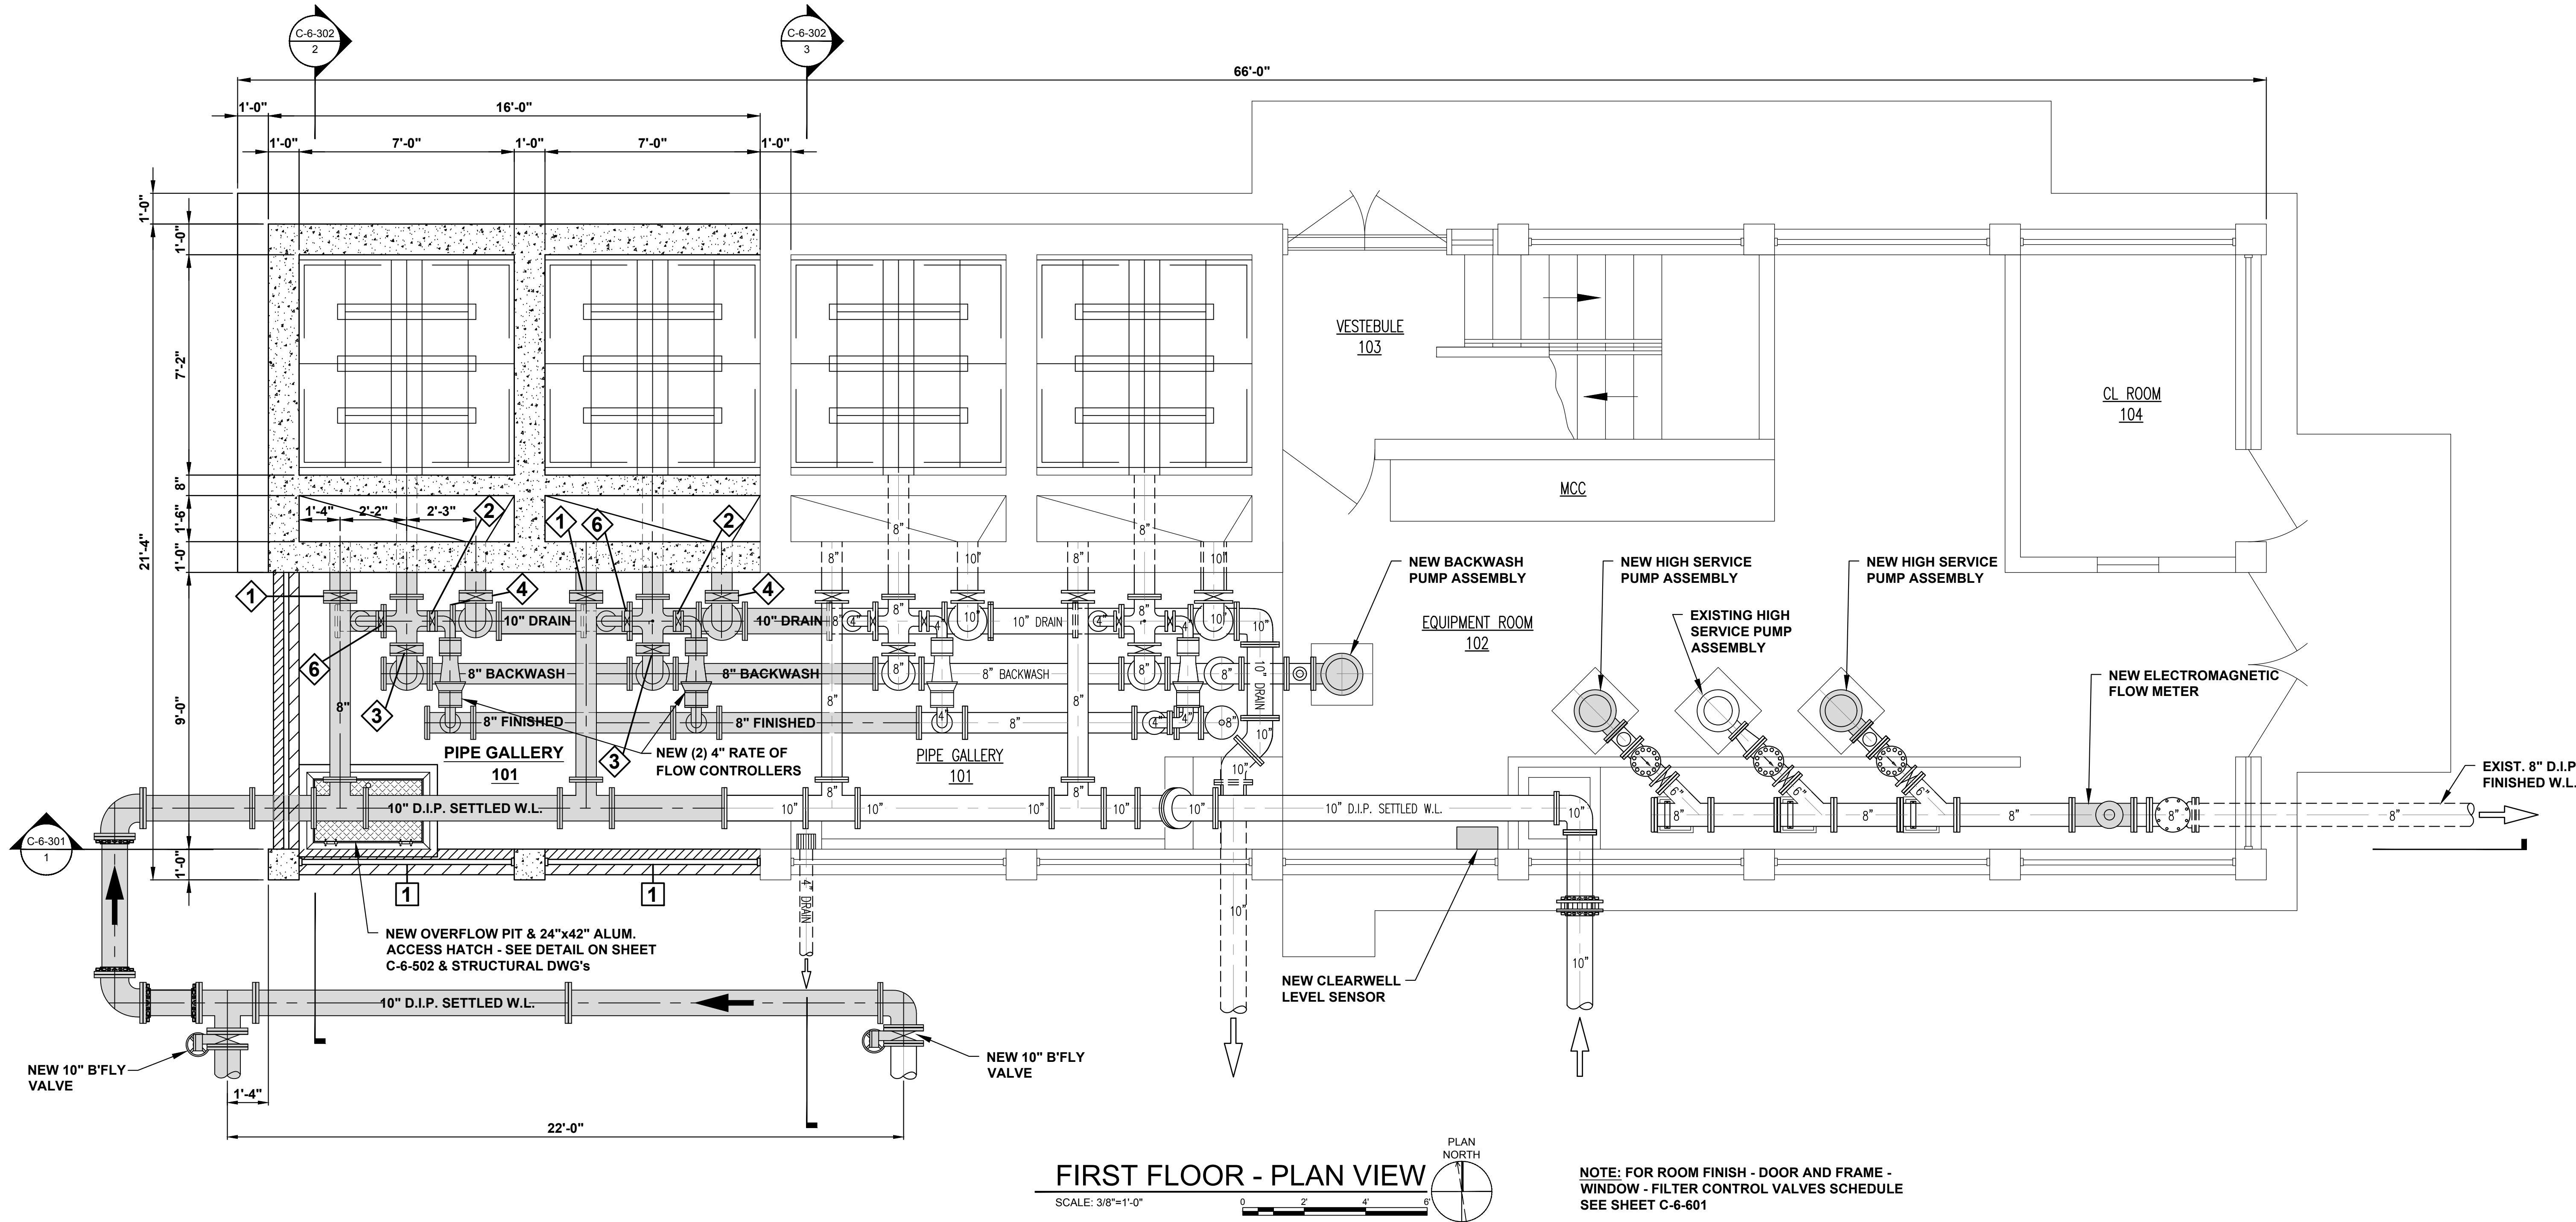

FIRST FLOOR - PLAN VIEW

SCALE: 3/8"=1'-0"

SEE STRUCTURAL DRAWINGS FOR ALL
CONCRETE AND STEEL REINFORCING
REQUIREMENT

SEE ELECTRICAL DRAWINGS FOR
ALL ELECTRICAL APPURTANCES
REQUIREMENT

THIS RECORD DOCUMENT HAS BEEN PREPARED BASED ON INFORMATION PROVIDED BY THE CONSTRUCTION CONTRACTOR, GRW ENGINEERS, INC. HAS ATTEMPTED TO VERIFY THE ACCURACY AND/OR COMPLETENESS OF THIS INFORMATION BUT SHALL NOT BE RESPONSIBLE FOR ANY ERRORS OR OMISSIONS WHICH MAY BE INCORPORATED HEREIN AS A RESULT.

GRW
engineering | architecture | geospatial
www.grwinc.com

ENGINEER/ARCHITECT: BARRY L. CLOYD
CONSTRUCTION COMPANY: QUINN CONS. CORP.
DATE: 09/27/2018

FIRST FLOOR PLAN

WATER TREATMENT PLANT EXPANSION
CITY OF LOBEVILLE, TENNESSEE

NO.	DATE	DESCRIPTION	DESIGNED BY	DRAWN BY	REVIEWED BY	APPROVED BY

DATE:
JUNE 2015

SCALE:

NOTED

SHEET NO.

C-6-104

GRW PROJECT NO. 3827-07

CLIENT PROJECT NO.

ALL RIGHTS RESERVED. NO PART OF THIS DOCUMENT SHALL BE REPRODUCED IN WHOLE OR IN PART WITHOUT THE WRITTEN PERMISSION OF GRW ENGINEERS, INC. AND SHALL NOT BE USED FOR ANY OTHER PROJECT OTHER THAN THIS SPECIFIC PROJECT WITHOUT THE WRITTEN PERMISSION OF GRW ENGINEERS, INC.

GRW
engineering | architecture | geospatial
www.grwinc.com

RECORD DRAWINGS