



FILE NAME: G:\3827-Lobellville\07-WTP\Expand\Working Drawings\AutoCAD - Record Drawing\022_3827-07_C-6-201.dwg
PRINTED: 10/15/2018 @ 11:52AM
PLOTTED BY: rnzad

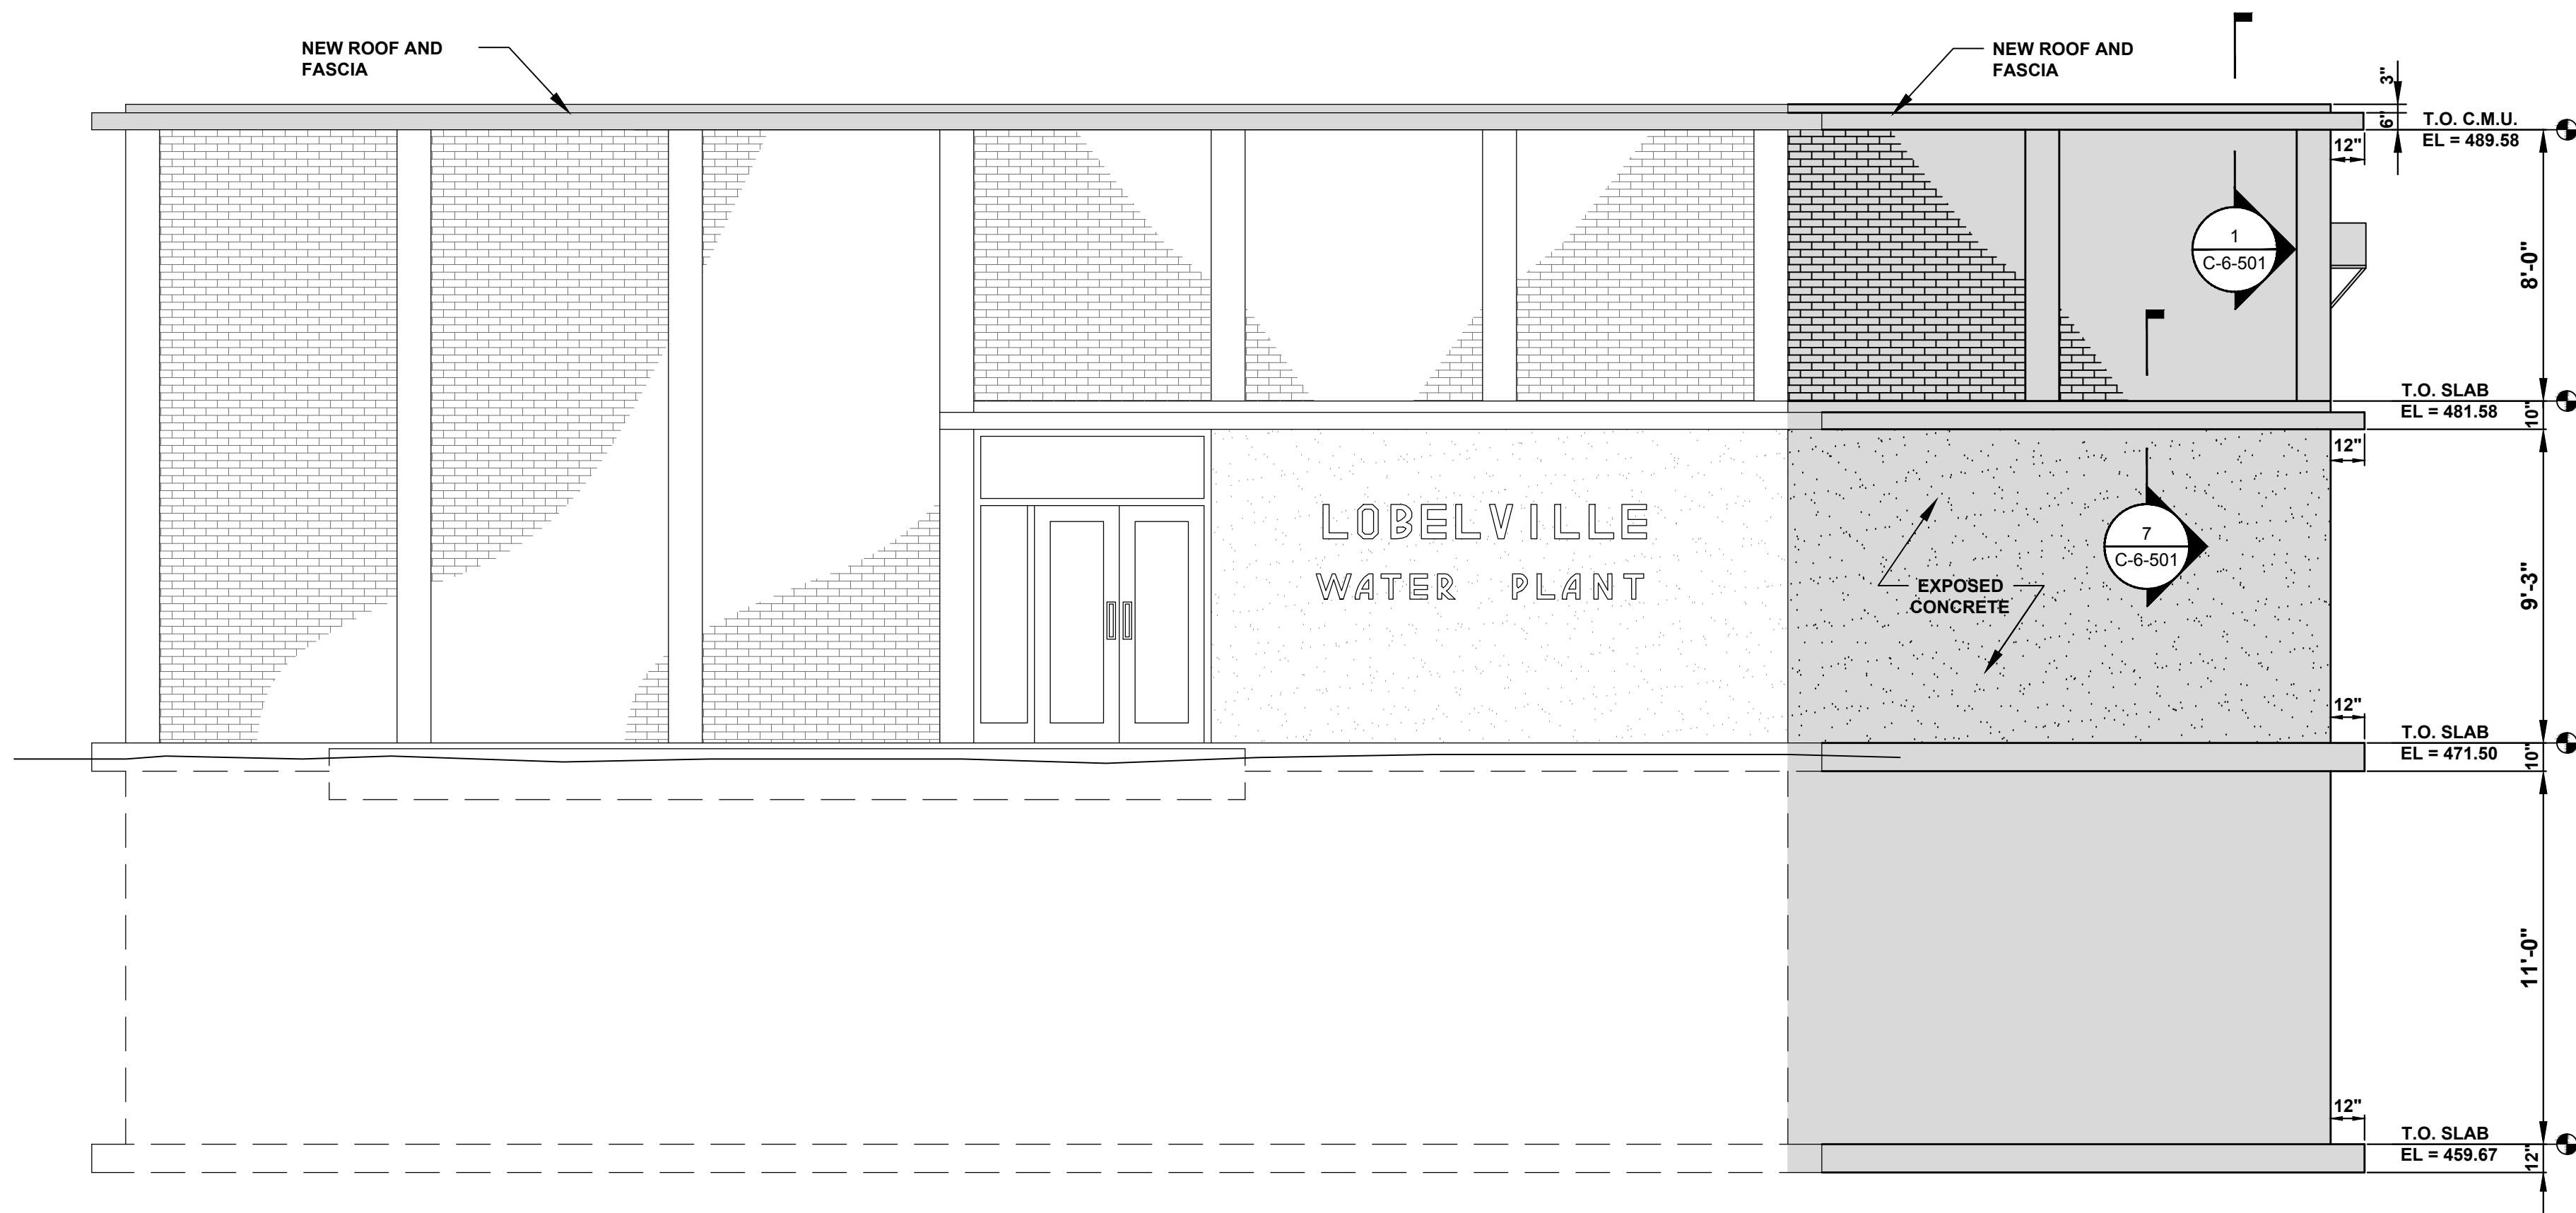

NORTH ELEVATION


SCALE: 1/4"=1'-0"

SEE STRUCTURAL DRAWINGS FOR ALL
CONCRETE AND STEEL REINFORCING
REQUIREMENT

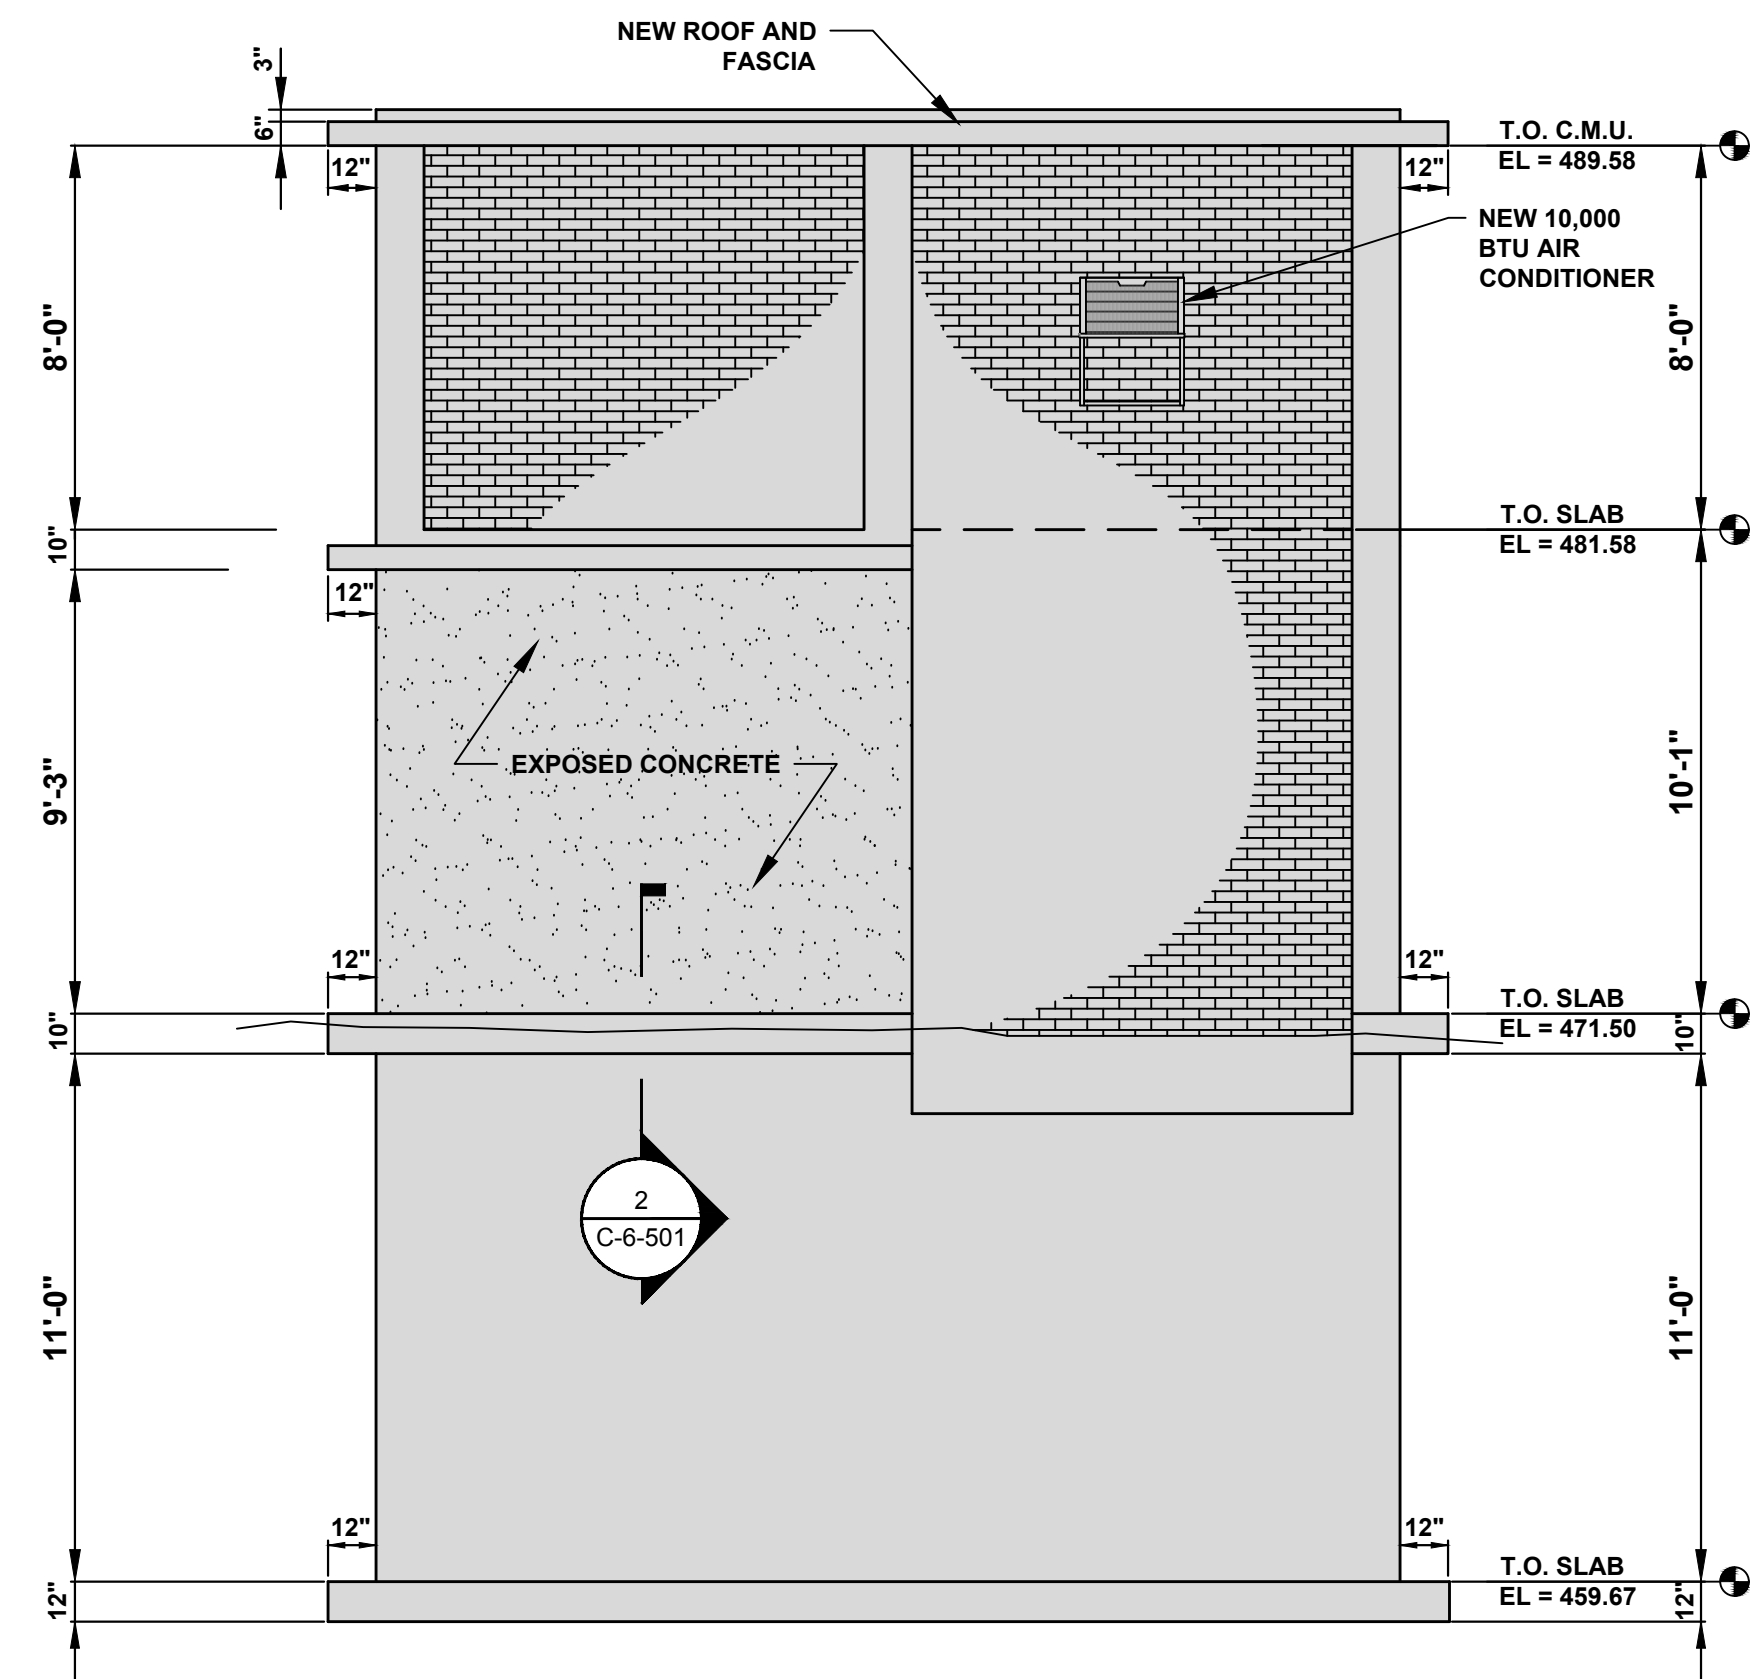


WEST ELEVATION

SCALE: 1/4"=1'-0"

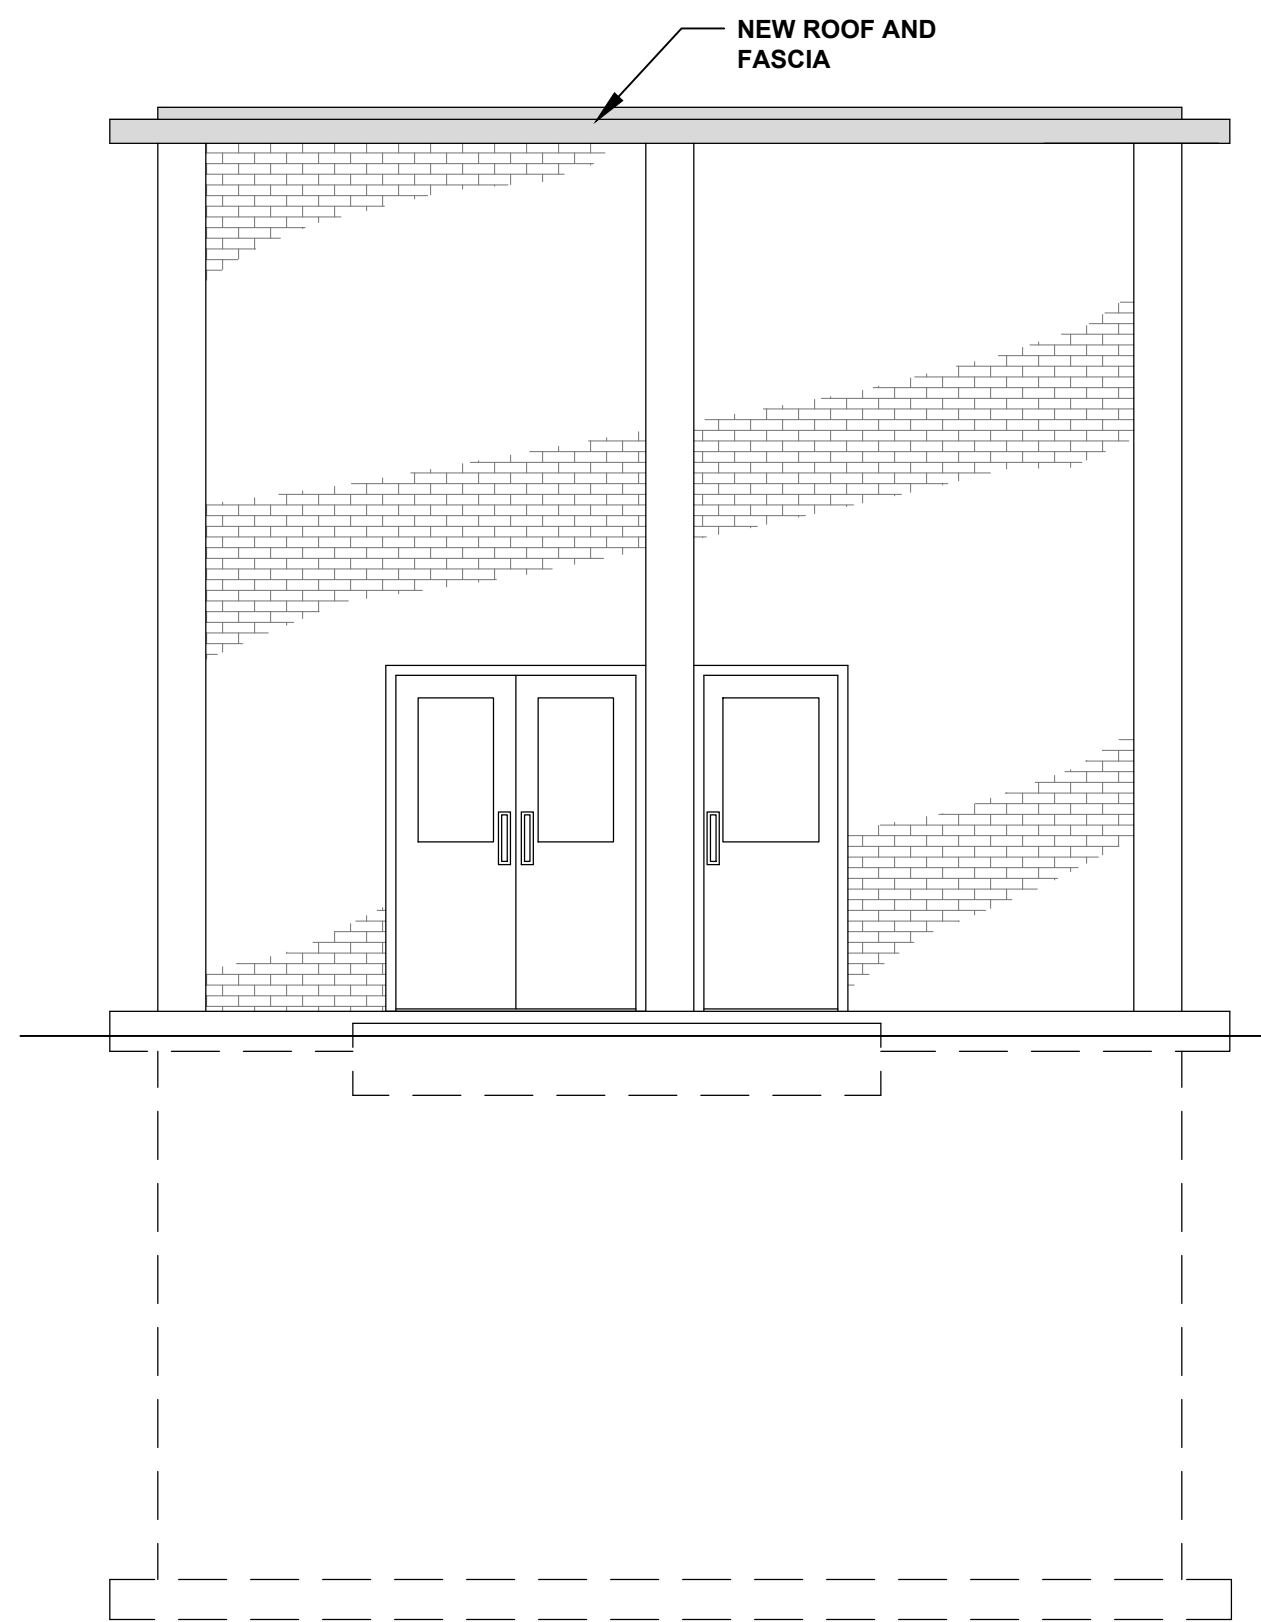

EAST ELEVATION

SCALE: 1/4"=1'-0"

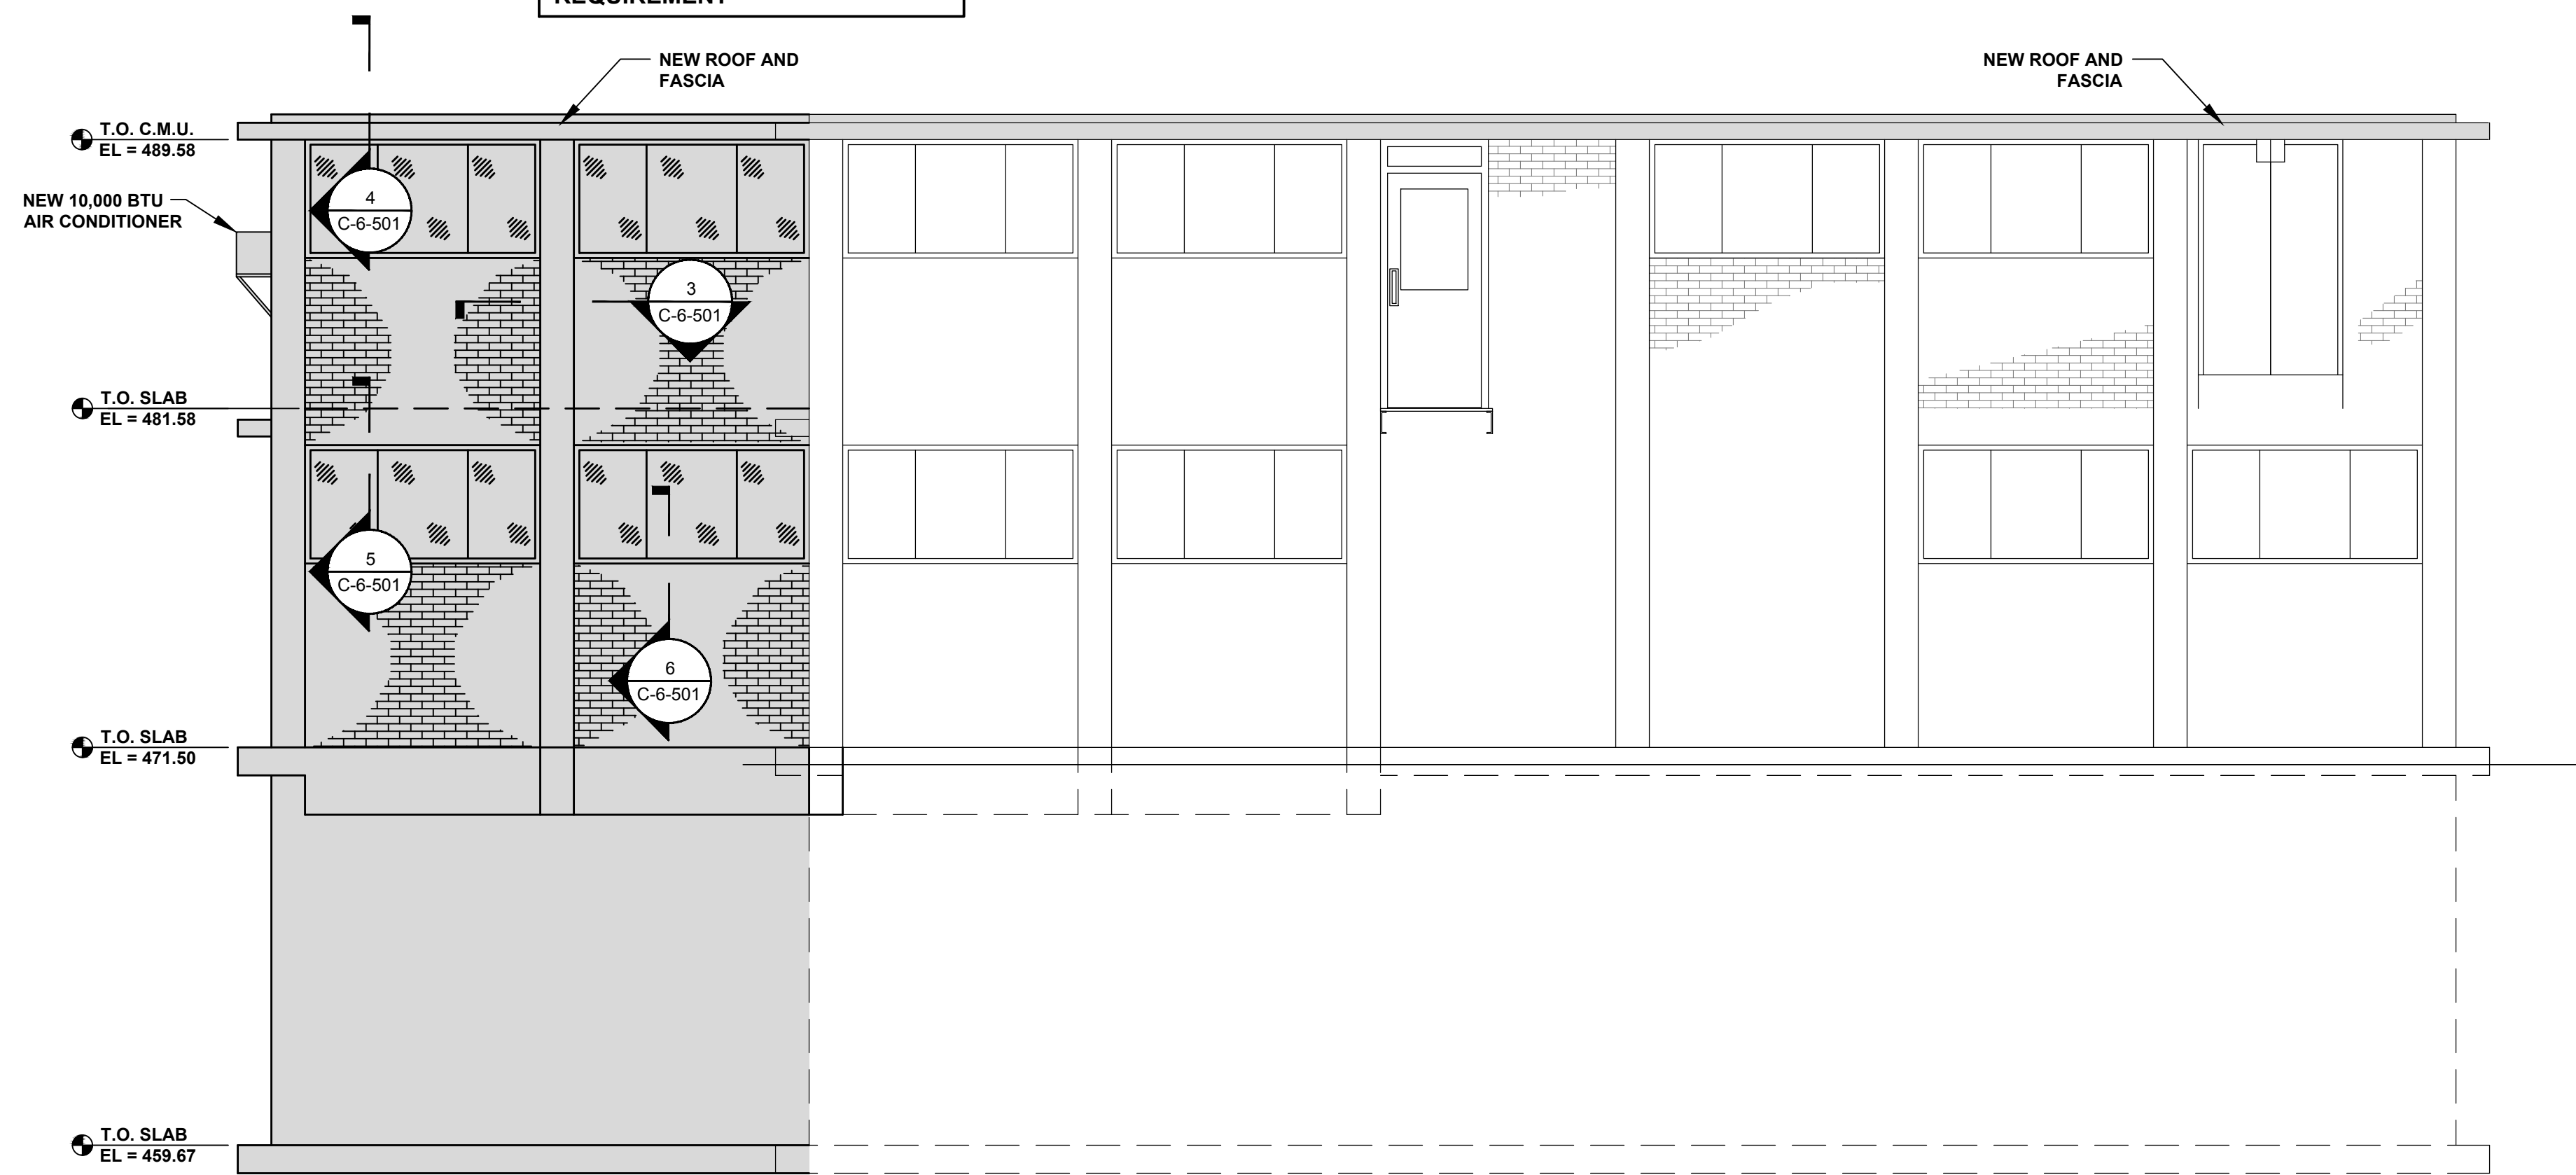

SOUTH ELEVATION

SCALE: 1/4"=1'-0"

SEE ELECTRICAL DRAWINGS FOR
ALL ELECTRICAL APPURTANCES
REQUIREMENT

THIS RECORD DOCUMENT HAS BEEN PREPARED BASED ON INFORMATION PROVIDED BY THE CONSTRUCTION CONTRACTOR. GRW ENGINEERS, INC. HAS ATTEMPTED TO VERIFY THE ACCURACY AND/OR COMPLETENESS OF THIS INFORMATION BUT SHALL NOT BE RESPONSIBLE FOR ANY ERRORS OR OMISSIONS WHICH MAY BE INCORPORATED HEREIN AS A RESULT.

GRW
engineering | architecture | geospatial
www.grwinc.com

ENGINEER/ARCHITECT: BARRY L. CLOYD
CONSTRUCTION COMPANY: QUINN CONS. CORP.
09/27/2018

FILTER BUILDING EXTERIOR ELEVATIONS
WATER TREATMENT PLANT EXPANSION
CITY OF LOBELVILLE, TENNESSEE

DESIGNED	BLC
DRAWN	SH
REVIEWED	JWH
APPROVED	BLC

REVISIONS	NO.	DATE	DESCRIPTION

DATE:	JUNE 2015
SCALE:	NOTED
SHEET NO.	C-6-201

GRW PROJECT NO. 3827-07

CLIENT PROJECT NO.

ALL RIGHTS RESERVED. NO PART OF THIS DOCUMENT SHALL BE REPRODUCED IN WHOLE OR IN PART WITHOUT THE WRITTEN PERMISSION OF GRW ENGINEERS, INC. AND SHALL NOT BE USED IN LIEU OF A CERTIFIED DOCUMENT.

engineering | architecture | geospatial
www.grwinc.com