


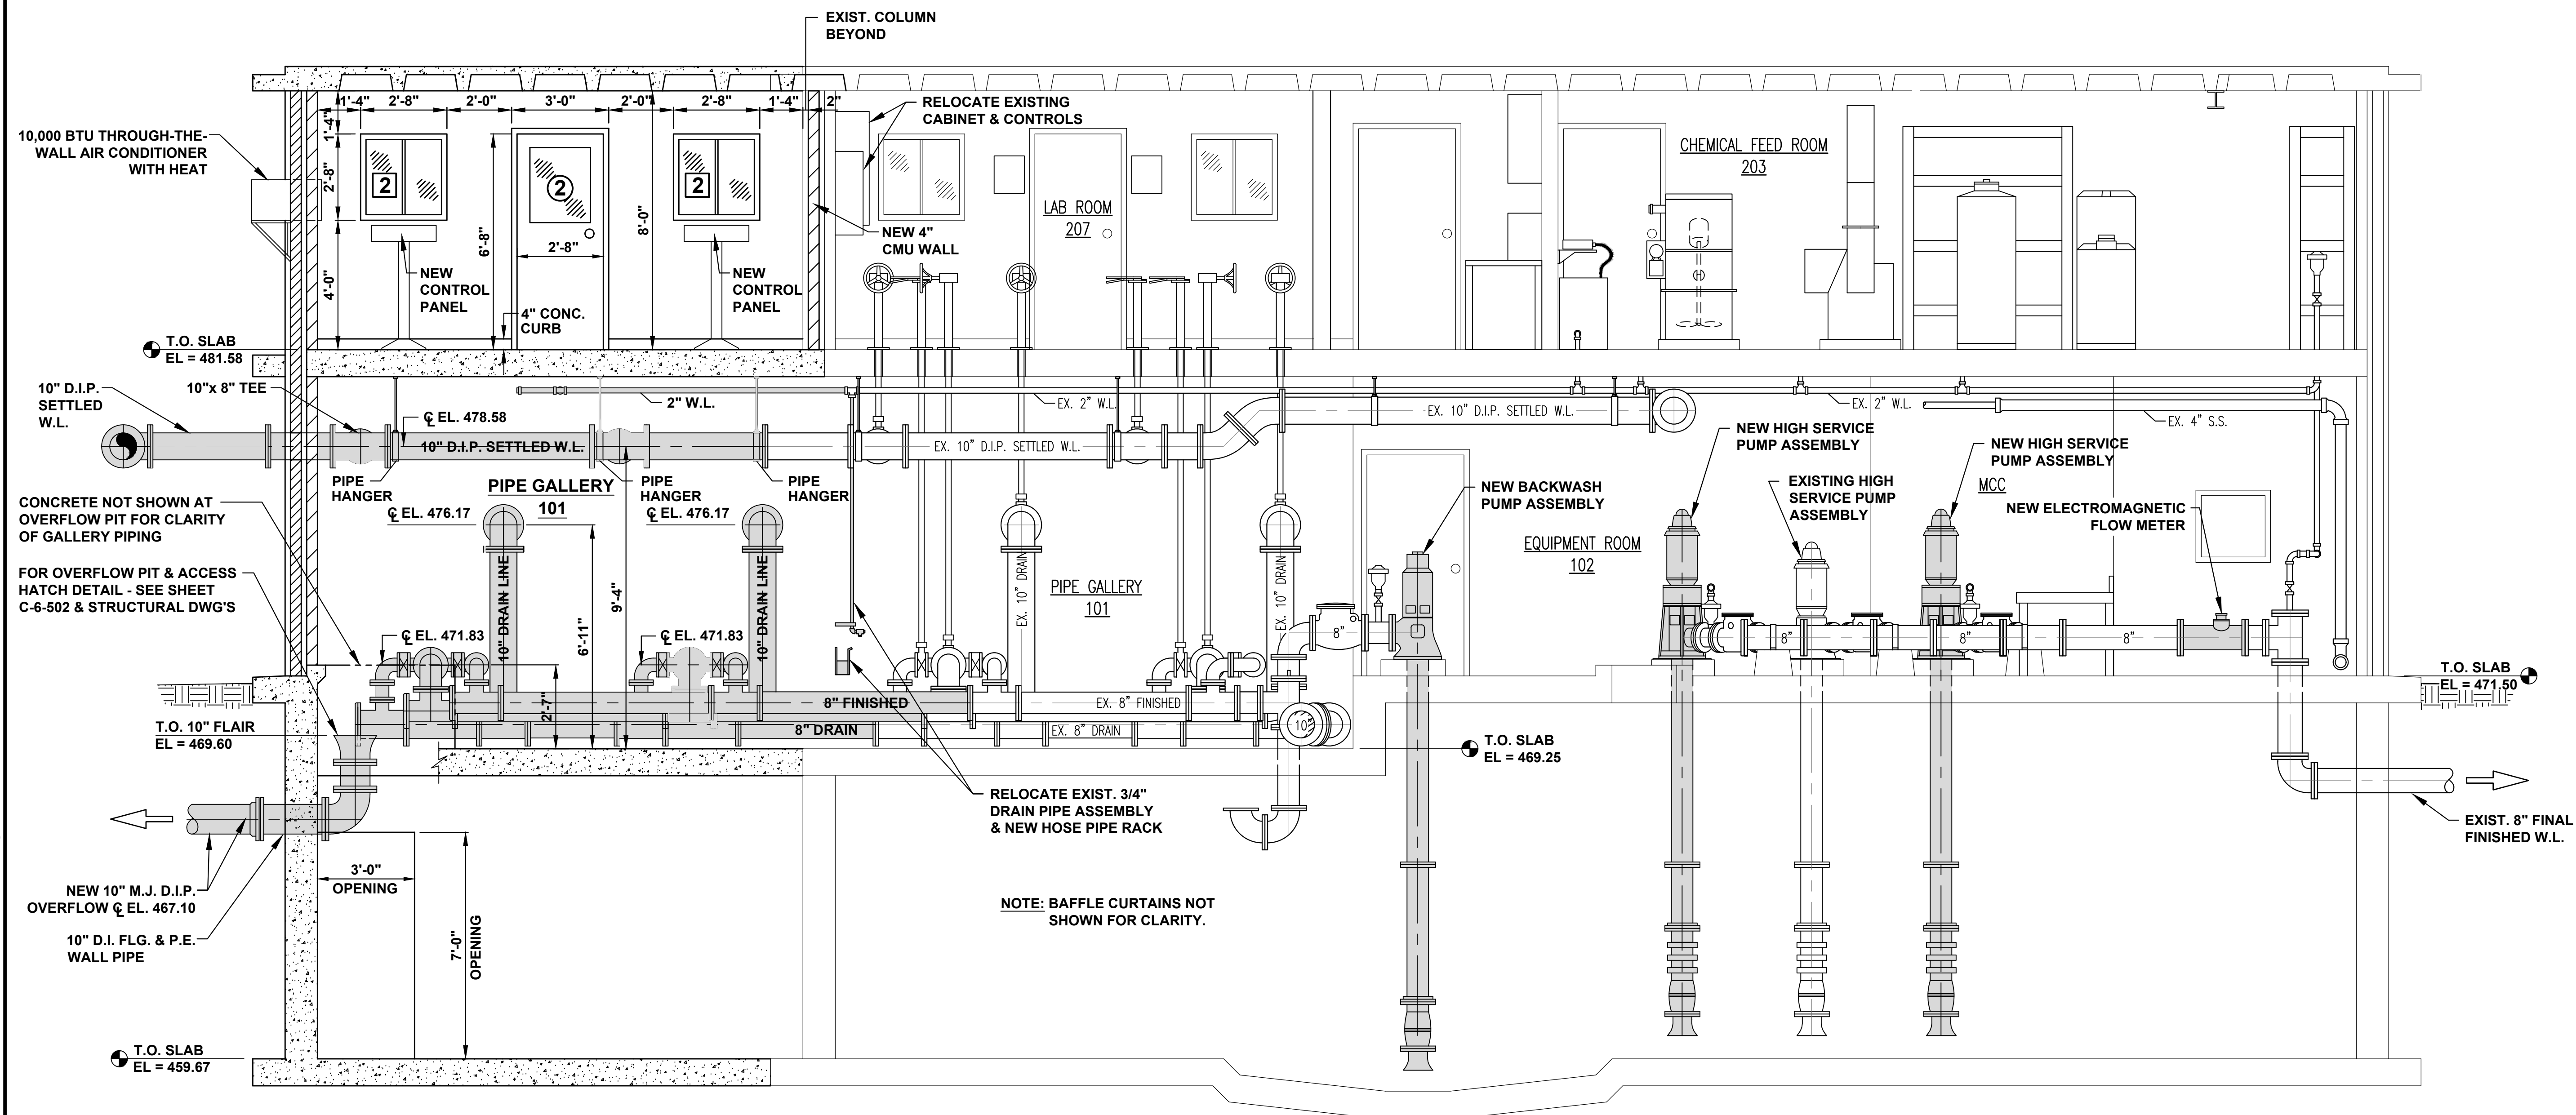

NOTES TO CONTRACTOR:

- 1.) CONTRACTOR SHALL FIELD VERIFY AND LOCATE NEW PIPES VERTICALLY TO MATCH EXISTING PIPING ELEVATIONS IN PIPE GALLERY.**

1 SECTION VIEW

SCALE: 3/8"=1'-0" 0 2' 4' 6'

**NOTE: FOR ROOM FINISH - DOOR AND FRAME -
WINDOW - FILTER CONTROL VALVES SCHEDULE
SEE SHEET C-6-601**

THIS RECORD DOCUMENT HAS BEEN PREPARED BASED ON INFORMATION PROVIDED BY THE CONSTRUCTION CONTRACTOR GRW ENGINEERS, INC. HAS ATTEMPTED TO VERIFY THE ACCURACY AND/OR COMPLETENESS OF THIS INFORMATION BUT SHALL NOT BE RESPONSIBLE FOR ANY ERRORS OR OMISSIONS WHICH MAY BE INCORPORATED HEREIN AS A RESULT.



engineering | architecture | geospatial
www.grwinc.com

ENGINEER/ARCHITECT: BARRY L. CLOYD

CONSTRUCTION COMPANY: QUINN COS. CORP.

09/27/2018

**SEE STRUCTURAL DRAWINGS FOR ALL
CONCRETE AND STEEL REINFORCING
REQUIREMENT**

**SEE ELECTRICAL DRAWINGS FOR
ALL ELECTRICAL APPURTANCES
REQUIREMENT**

This document, originally issued, sealed, and signed by BARRY L. CLOYD, Tennessee Professional Engineer, No. 100893, on JUNE 2015, shall not be used in lieu of a certified document.

GRW PROJECT NO. 3827-07

CLIENT PROJECT NO.

ALL RIGHTS RESERVED:
THIS DOCUMENT IS THE PROPERTY OF
GRW ENGINEERS, INC. AND SHALL NOT
BE REPRODUCED IN WHOLE OR IN PART
OR USED FOR CONSTRUCTION OF
OTHER THAN THIS SPECIFIC PROJECT
WITHOUT WRITTEN PERMISSION



engineering | architecture | geospatial

www.grwinc.com

FILTER BUILDING SECTIONS AND DETAILS

WATER TREATMENT PLANT EXPANSION
CITY OF LOBELVILLE, TENNESSEE

NO.	DESCRIPTION	DATE	BY	BLC
				DRAWN: SH
				REVIEWED: JWH
				APPROVED: BLC

SCALE CHECK: _____ THIS MARK SHOULD MEASURE EXACTLY 1" WHEN PLOTTED

DATE: JUNE 2015

NOTED

SHEET NO.

C-6-301