


2 SECTION VIEW
SCALE: 3/8"=1'-0" 0 2' 4'



THIS RECORD DOCUMENT HAS BEEN PREPARED BASED ON INFORMATION PROVIDED BY THE CONSTRUCTION CONTRACTOR OR GEW ENGINEERS, INC. HAS ATTEMPTED TO VERIFY THE ACCURACY AND/OR COMPLETENESS OF THIS INFORMATION BUT SHALL NOT BE RESPONSIBLE FOR ANY ERRORS OR OMISSIONS WHICH MAY BE INCORPORATED HEREIN AS A RESULT.

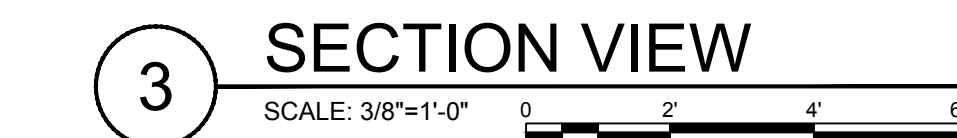

engineering | architecture | geospatial
www.gewinc.com

ENGINEER/ARCHITECT: BARRY L. CLOYD

CONSTRUCTION COMPANY: QUINN CONS CORP.

09/27/2018

**SEE STRUCTURAL DRAWINGS FOR ALL
CONCRETE AND STEEL REINFORCING
REQUIREMENT**

**SEE ELECTRICAL DRAWINGS FOR
ALL ELECTRICAL APPURTANCES
REQUIREMENT**

REVISIONS					
NO.	DESCRIPTION	DATE	BY	DRAWN:	DESIGNED:
				BLC	BLC
				SH	SH
				JWH	JWH
				APPROVED:	APPROVED:
				BLC	BLC

SCALE CHECK _____ THIS MARK SHOULD MEASURE EXACTLY 1" WHEN PLOTTED

DATE: JUNE 2015
SCALE:
NOTED
SHEET NO.
C-6-302

FILTER BUILDING SECTIONS AND DETAILS

WATER TREATMENT PLANT EXPANSION
CITY OF LOBELVILLE, TENNESSEE

	engineering architecture geospatial	GRW PROJECT NO. 3827-07
		CLIENT PROJECT NO.
		ALL RIGHTS RESERVED. PROPERTY OF GRW ENGINEERING, INC. AND SHALL NOT BE REPRODUCED OR TRANSMITTED IN ANY FORM OR BY ANY MEANS, ELECTRONIC OR MECHANICAL, INCLUDING PHOTOCOPYING, RECORDING, OR BY ANY INFORMATION STORAGE AND RETRIEVAL SYSTEM, WITHOUT WRITTEN PERMISSION.
www.grwinc.com		

This document, originally issued, sealed, and signed by BARRY L. CLOYD, Tennessee Professional Engineer, No. 100893, on JUNE 2015, shall not be used in lieu of a certified document.