
								ROOM FINISH S	CHEDULE									This document, original
	ROC	DM							W	ALLS					CEILING			issued, sealed, and sign by BARRY L. CLOYD, Tennessee Professiona
ROOM	ROOM NAME	AREA		FLOOR	1	NORT		SOU		EAS	T	WES		MATERIAL	FINISH	HEIGHT	NOTES	Engineer, No. 100893, o JUNE 2015, shall not be
NO.	A FLOOD DIDE ON LEDV	SQ. FT.	MATERIAL EXPOSED	FINISH	BASE	MATERIAL	FINISH	MATERIAL	FINISH	MATERIAL	FINISH	MATERIAL	FINISH	EXPOSED	NONE			used in lieu of a certifie document.
101 1st	st FLOOR PIPE GALLERY		STRUCTURE	NONE	NONE	CONCRETE	NONE	CMU	PAINT	CMU	PAINT	N/A	N/A	STRUCTURE	NONE	VARIES		
205 2n	nd FLOOR NEW FILTER ROOM		EXPOSED STRUCTURE	NONE	NONE	CMU	PAINT	CMU	PAINT	CMU	PAINT	EXPOSED STRUCTURE	N/A	EXPOSED STRUCTURE	PAINT	VARIES		27-07
206 2n	nd FLOOR NEW EQUIPMENT ROOM		EXPOSED STRUCTURE	NONE	NONE	СМИ	PAINT	СМИ	PAINT	СМИ	PAINT	EXPOSED STRUCTURE	N/A	EXPOSED STRUCTURE	PAINT	VARIES		ECT NO. 3827-0 SLECT NO. BRAIL NOT INC. AND SHALL NOT INCREMENTATION OF INSTRUCTION OF
102 1st	st FLOOR EQUIPMENT		EXPOSED STRUCTURE	NONE	NONE	СМИ	PAINT	CMU	PAINT	CONCRETE	NONE	CMU	PAINT	EXPOSED STRUCTURE	NONE	VARIES		GRW PROJEC  CLIENT PROJ  ALL RIGHTS RESERY THIS DOCUMENT IS GRW ENGINEERS, IN BE REPROJUCED IN OR USED FOR CONS
104 CH	HLORINE		EXPOSED STRUCTURE	NONE	NONE	СМИ	PAINT	CMU	PAINT	СМИ	PAINT	СМИ	PAINT	EXPOSED STRUCTURE	PAINT	VARIES		
207 2n	nd FLOOR LAB		CONCRETE	VCT	4" Cove Base	СМИ	PAINT	CMU	PAINT	СМИ	PAINT	СМИ	PAINT	EXPOSED STRUCTURE	PAINT	VARIES		leosbo
204 2n	nd FLOOR EXISTING FILTER AREA		EXPOSED STRUCTURE	NONE	NONE	СМИ	PAINT	CMU	PAINT	СМИ	PAINT	N/A	N/A	EXPOSED STRUCTURE	PAINT	VARIES		
03 & 201 VE	ESTIBULE/STAIRWELL		EXPOSED STRUCTURE	NONE	NONE	СМИ	PAINT	CMU	PAINT	CONCRETE	PAINT	СМИ	PAINT	EXPOSED STRUCTURE	PAINT	VARIES		thilectr
202 BA	ATHROOM		N/A	NONE	NONE	СМИ	PAINT	CMU	PAINT	СМИ	PAINT	СМИ	PAINT	EXPOSED STRUCTURE	PAINT	VARIES		
203 CH	HEMICAL FEED ROOM		EXPOSED STRUCTURE	NONE	NONE	CMU	PAINT	CMU	PAINT	СМИ	PAINT	CMU	PAINT	EXPOSED STRUCTURE	PAINT	VARIES		ineerin
																		——————————————————————————————————————
																		RAME - WINDC S SCHEDULE
																		SCHEL
																		<b> </b>   <b> </b>

								DOOR AND F	RAME SCHEDULI	 E					
	DOOR														
NAADI	NAA DIZ		SIZE			ELEVATION	FINICLI	NAATEDIAI	ELEVATION.	HEAD	JAMB	CILL DETAIL	FINISH	HARDWARE	COMMENTS
MARK	`	WIDTH	HEIGHT	THICKNESS	MATERIAL	ELEVATION	FINISH	MATERIAL	ELEVATION	DETAIL	DETAIL	SILL DETAIL	ГПИІЗП		
Lab-Equipment	t 1)	3'-0"	6'-8"	1-3/4"	HOLLOW METAL		PAINT	HOLLOW METAL					PAINT	Half Glass	5
Filter	2	2'-8"	6'-8"	1-3/4"	HOLLOW METAL		PAINT	HOLLOW METAL					PAINT	Half Glass	5
Flash Mix	3	3'-0"	??	1-3/4"	HOLLOW METAL		PAINT	HOLLOW METAL					PAINT		

						WINDOW S	CHEDULE				
MARK		SIZE		TYPE	MATERIAL	FIN	IISH	HEAD	JAMB	SILL	COMMENTS
		WIDTH	HEIGHT	IIFL	INTE		INTERIOR	DETAIL	DETAIL	DETAIL	COMMENTS
exterior	1	7'-0"	3'-6"		VINYL	PAINT	PAINT				SLIDING w/SCREENS
Filters	2										SLIDING

FILTER CONTROL VALVE SCHEDULE												
MARK	DESCRIPTION	TYPE	SIZE	QUANTITY	OPERATOR							
1>	FILTER INFLUENT	BUTTERFLY	8"	2	ELECTRIC MOTOR OPERATOR							
2>	FILTER EFFLUENT	BUTTERFLY	4"	2	ELECTRIC MOTOR OPERATOR - POSITIONER CONTROL							
3>	FILTER BACKWASH	BUTTERFLY	8"	2	ELECTRIC MOTOR OPERATOR							
4>	FILTER DRAIN	BUTTERFLY	8"	2	ELECTRIC MOTOR OPERATOR							
\$	FILTER SURFACE WASH	BUTTERFLY	2"	2	ELECTRIC MOTOR OPERATOR							
6	FILTER REWASH	BUTTERFLY	4"	2	ELECTRIC MOTOR OPERATOR							

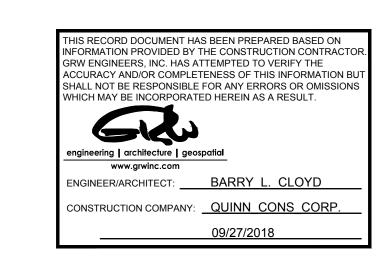

ROOM FINISH - DOOR & FRAME - WINDOW FILTER CONTROL VALVES SCHEDULE WATER TREATMENT PLANT EXPANSION CITY OF LOBELVILLE, TENNESSEE

NOTED SHEET NO. C-6-601

JUNE 2015