



NOTE: (1) PROVIDE CIRCUIT BREAKER LOCKING MECHANISMS AS REQUIRED.
(2) PROVIDE SWITCHING DUTY CIRCUIT BREAKERS AS REQUIRED.
(3) PROVIDE H.I.D. RATED CIRCUIT BREAKERS AS REQUIRED.
(4) PROVIDE GFCI PROTECTED CIRCUIT BREAKERS AS REQUIRED.
(5) PROVIDE HACR RATED CIRCUIT BREAKERS AS REQUIRED.
(6) PROVIDE SHUNT TRIP CIRCUIT BREAKERS AS REQUIRED.

NOTE: (1) PROVIDE CIRCUIT BREAKER LOCKING MECHANISMS AS REQUIRED.
(2) PROVIDE SWITCHING DUTY CIRCUIT BREAKERS AS REQUIRED.
(3) PROVIDE H.I.D. RATED CIRCUIT BREAKERS AS REQUIRED.
(4) PROVIDE GFCI PROTECTED CIRCUIT BREAKERS AS REQUIRED.
(5) PROVIDE HACR RATED CIRCUIT BREAKERS AS REQUIRED.
(6) PROVIDE SHUNT TRIP CIRCUIT BREAKERS AS REQUIRED.

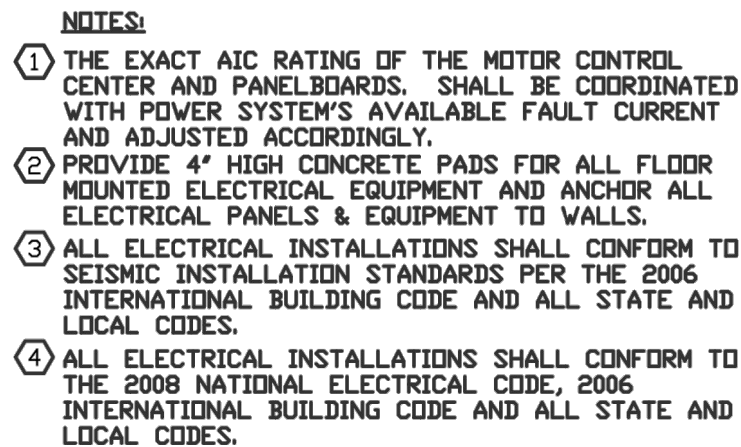


engineering | architecture | geospatial
www.gwinc.com

ENGINEER/ARCHITECT: JAMES D. PHILLIPS

CONSTRUCTION COMPANY: QUINN CONS CORP.

09/27/2018

PHILLIPS
ENGINEERING, INC.

Phone: (731) 885-9532
Fax: (731) 885-2106
Email: pei@phillipsengr.com

P.O. Box 585 - 617 S. First Street - Union City, TN 38261