
 

 








	---DISCONNECT SWITCH (FUSIBLE)
	---DISCONNECT SWITCH (NON-FUSIBLE)
	---AC MOTOR W/HP
	---SURGE PROTECTION DEVICE
	---ALTERNATOR CONTROL
	---START/STOP PUSHBUTTONS
	---PART WINDING START
	---FULL VOLTAGE REVERSING
	---FULL VOLTAGE NON-REVERSING
	---SOLID STATE REDUCED VOLTAGE
	---CONTROL CIRCUITRY
	---PHASE FAILURE, PHASE REVERSAL, PHASE UNBALANCE RELAY
	---CONTROL AND STATUS MODULE

PHILLIPS
ENGINEERING, INC.

Phone: (731) 885-9532
Fax: (731) 885-2106
Email: pei@phillipsengr.com

P.O. Box 585 - 617 S. First Street - Union City, TN 38261

This document, originally issued, sealed, and signed by JAMES D. PHILLIPS, Tennessee Professional Engineer, No. 016308, on JUNE 2015, shall not be used in lieu of a certified document.

engineering | architecture | geospatial

www.grwinc.com

MOTOR CONTROL CENTER "MCC"
ONE-LINE DIAGRAM & LAYOUT
WATER TREATMENT PLANT EXPANSION
CITY OF LOBELVILLE, TENNESSEE

DESIGNED:	MLK
DRAWN:	JRJ
REVIEWED:	JDP
APPROVED:	JDP

[illegible]

SCALE:
AS SHOWN
SHEET NO.

E-6-602