




FILE NAME: G:\3827-Lobeville\07-WTP Expansion\Working Drawings\AutoCAD - Record Drawing\3827-07 E-6-603.dwg
PRINTED: 10/15/2018 @ 11:27AM
PLOTTED BY: razard

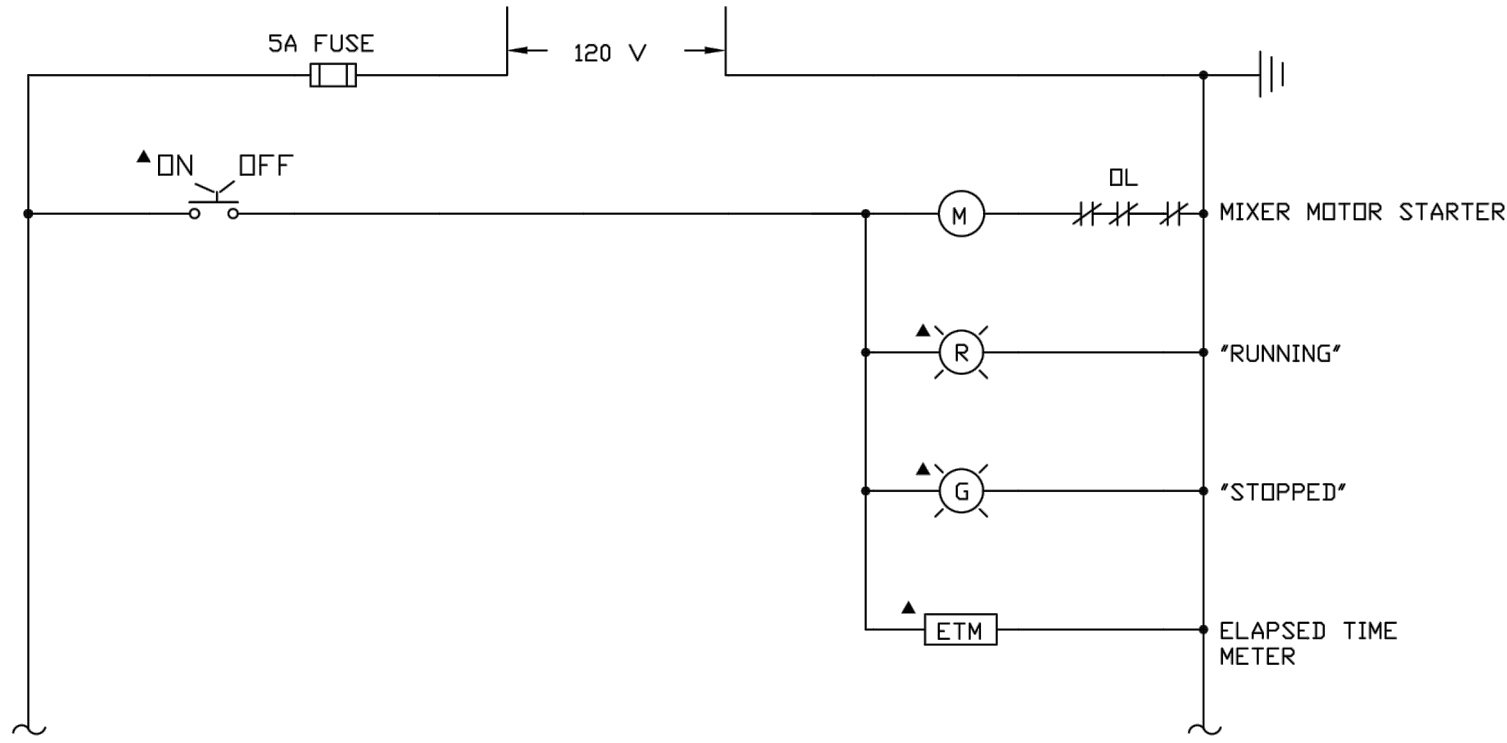


MIXER
1 AT 5 HP (208 V., 3 PH.)

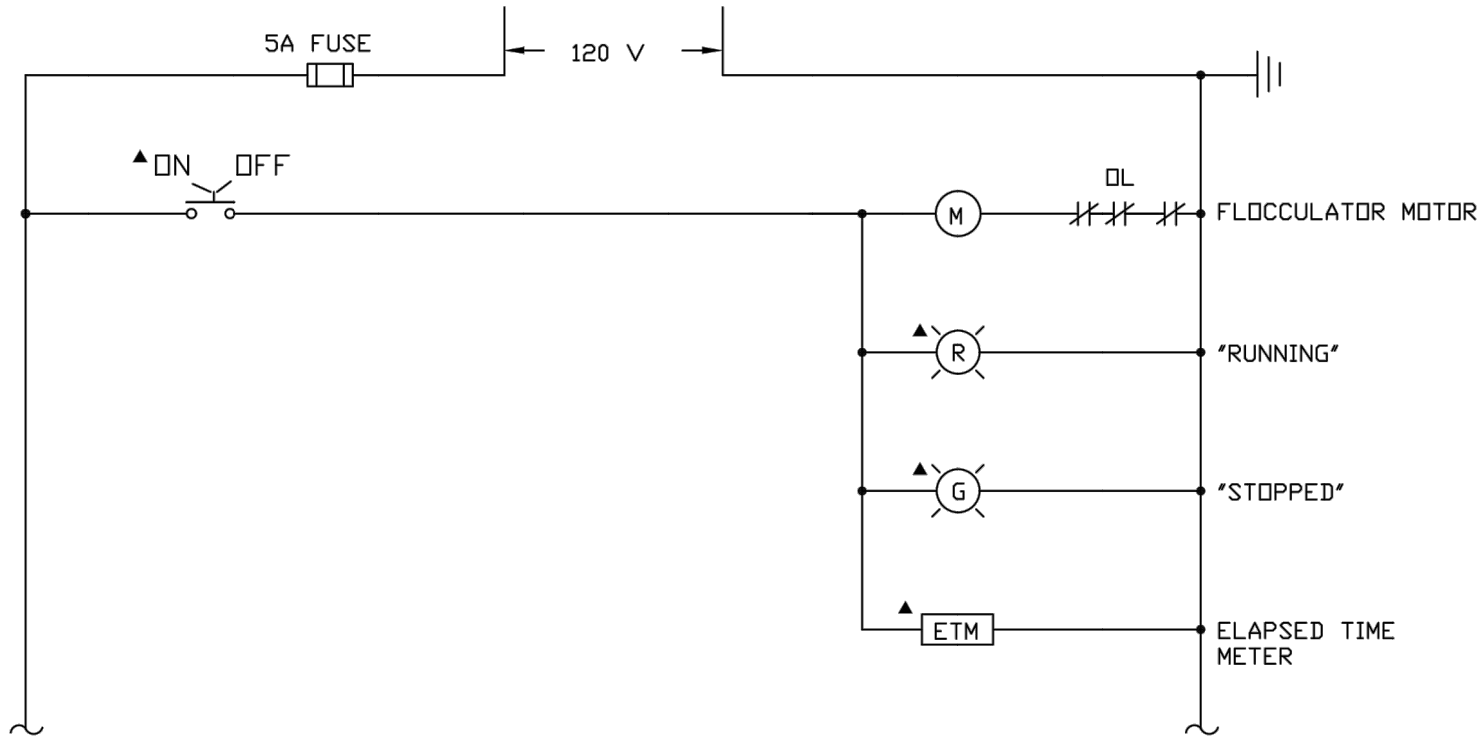


FLOCCULATORS NOS. A1 AND A2
2 AT 3/4 HP (208 V., 3 PH.)

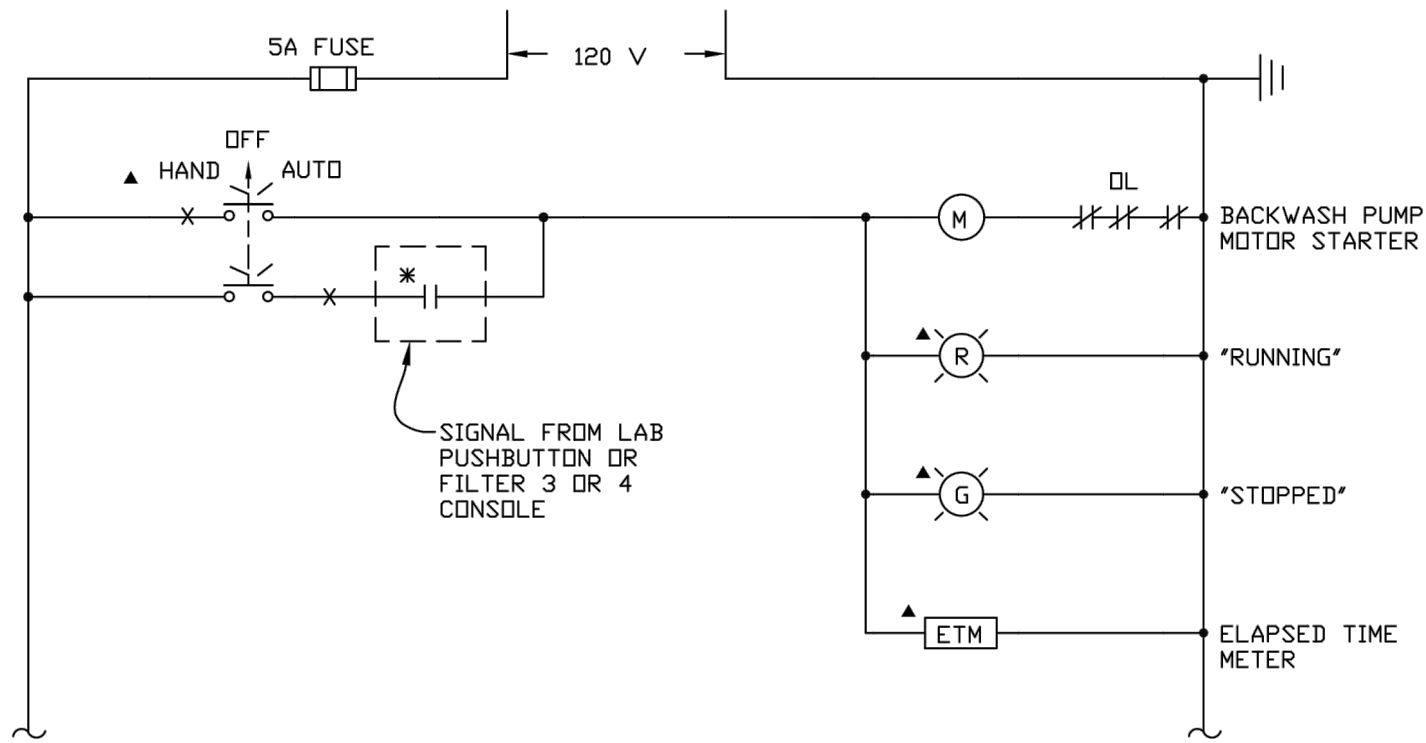

BACKWASH PUMP
1 AT 7 1/2 HP (208 V., 3 PH.)

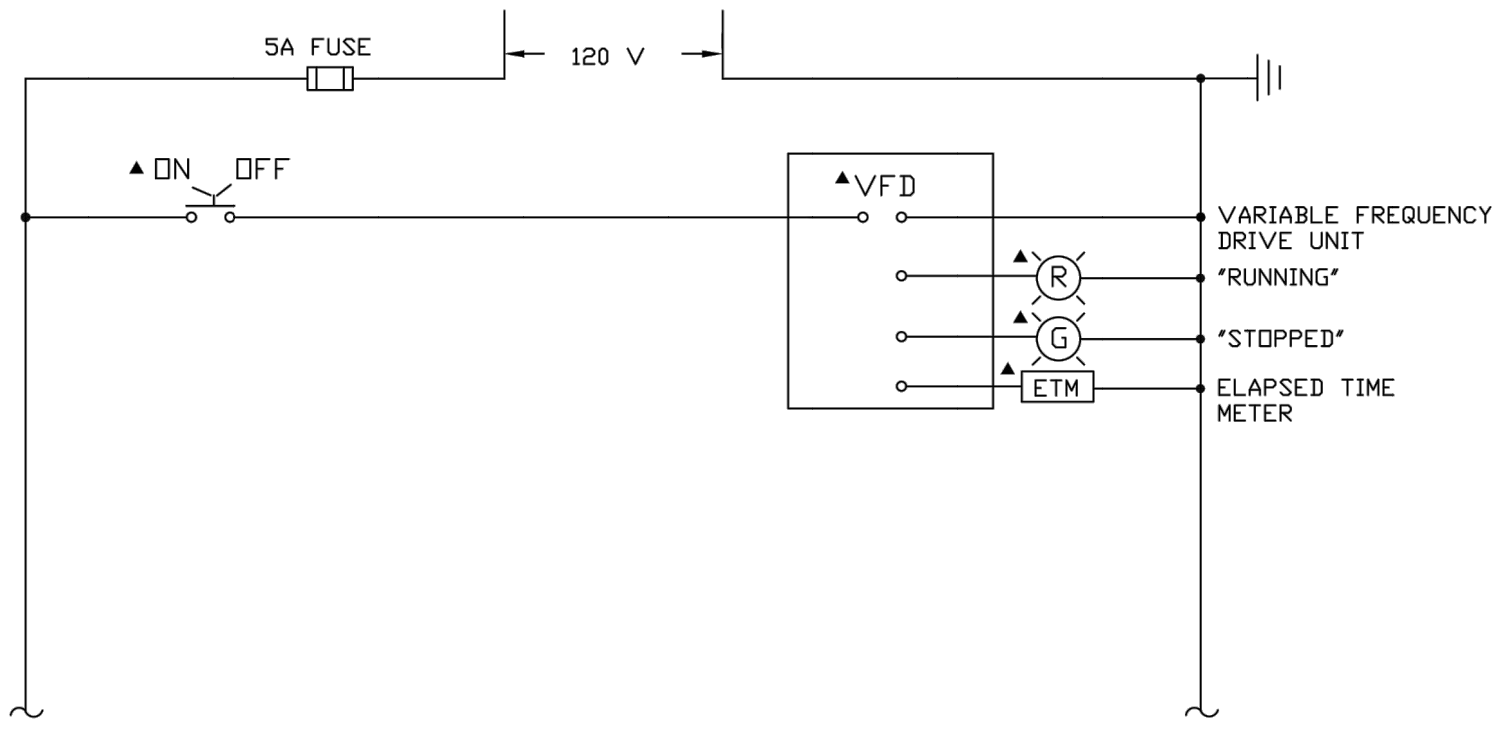

FLOCCULATORS NOS. C1 AND C2
2 AT 3/4 HP (208 V., 3 PH.)

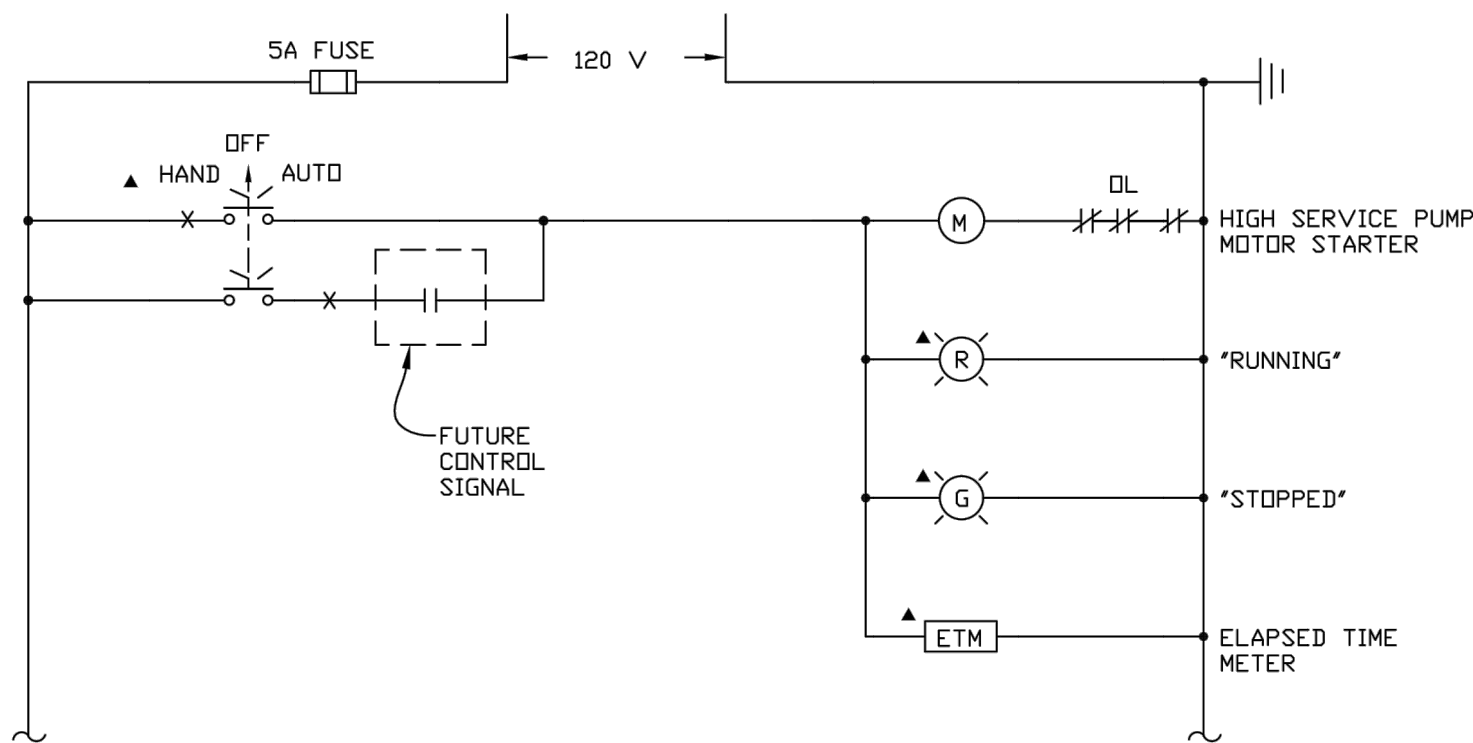

HIGH SERVICE PUMP NO. 2
1 AT 20 HP (208 V., 3 PH.)

THIS RECORD DOCUMENT HAS BEEN PREPARED BASED ON INFORMATION PROVIDED BY THE CONSTRUCTION CONTRACTOR. GRW ENGINEERS, INC. HAS ATTEMPTED TO VERIFY THE ACCURACY AND/OR COMPLETENESS OF THIS INFORMATION BUT SHALL NOT BE RESPONSIBLE FOR ANY ERRORS OR OMISSIONS WHICH MAY BE INCORPORATED HEREIN AS A RESULT.

GRW
engineering | architecture | geospatial
www.grwinc.com
ENGINEER/ARCHITECT: JAMES D. PHILLIPS
CONSTRUCTION COMPANY: QUINN CONS. CORP.
09/27/2018

- LEGEND:**
- ▲ - DEVICE MOUNTED IN MOTOR STARTER COVER
 - ✱ - DEVICE AT REMOTE LOCATION
 - - DEVICE LOCATED IN MOTOR STARTER
 - H/A - HAND-OFF-AUTO SELECTOR SWITCH
 - FS - FLOAT SWITCH
 - ETM - ELAPSED TIME METER
 - Ⓜ - DEVICE LOCATED IN CONTROL PANEL
 - - DEVICE LOCATED IN VFD UNIT

PHILLIPS
ENGINEERING, INC.
P.O. Box 585 - 617 S. First Street - Union City, TN 38261
Phone: (731) 885-9532
Fax: (731) 885-2106
Email: pci@phillipsengr.com

This document, originally issued, sealed, and signed by JAMES D. PHILLIPS, Tennessee Professional Engineer, No. 016308, on JUNE 2015, shall not be used in lieu of a certified document.

GRW PROJECT NO. 3827-07

CLIENT PROJECT NO.

ALL RIGHTS RESERVED. THIS DOCUMENT IS THE PROPERTY OF GRW ENGINEERS, INC. AND SHALL NOT BE REPRODUCED IN WHOLE OR IN PART WITHOUT THE WRITTEN PERMISSION OF GRW ENGINEERS, INC.

engineering | architecture | geospatial
www.grwinc.com

ELECTRICAL SCHEMATICS

WATER TREATMENT PLANT EXPANSION
CITY OF LOBELVILLE, TENNESSEE

DESIGNED	MLK	DRAWN	JRJ	REVIEWED	JDP	APPROVED	JDP
DATE							
NO.							

DATE: JUNE 2015

SCALE: AS SHOWN

SHEET NO.

REVISIONS

NO.	DESCRIPTION

THIS MARK SHOULD MEASURE EXACTLY 1" WHEN PLOTTED

14047E-6-603

E-6-603