





NOTE:
 ① SEE SPECIFICATIONS FOR DEPTH REQUIREMENT OF PIPE.
 ② LOCATOR WIRE, IF REQUIRED. SEE "DETECTABLE WIRE DETAIL" FOR CORRECT PLACEMENT.

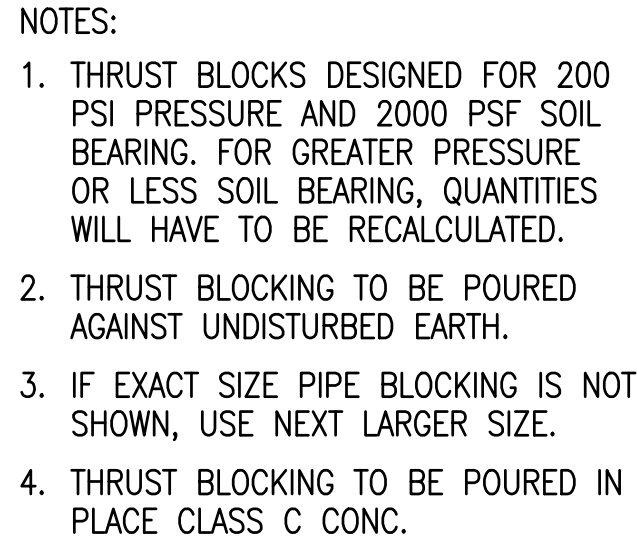


DIMENSIONS ARE IN INCHES

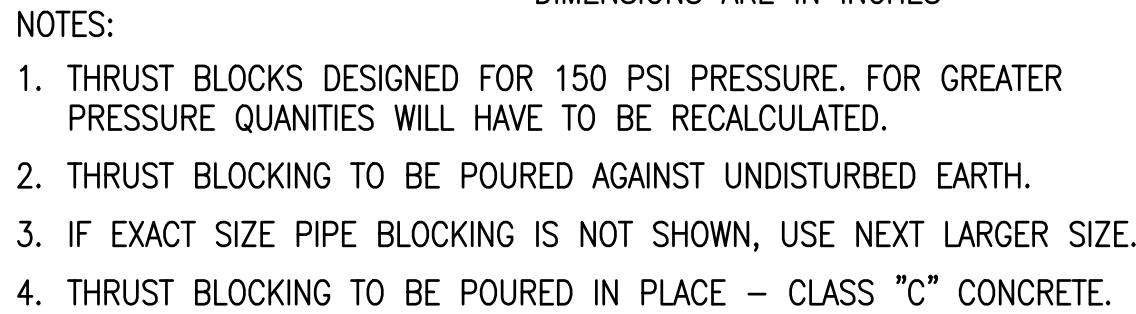

NOT TO SCALE

DIMENSIONS ARE IN INCHES

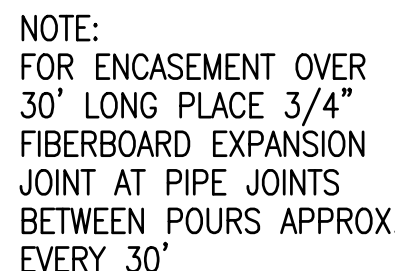

NOT TO SCALE

