



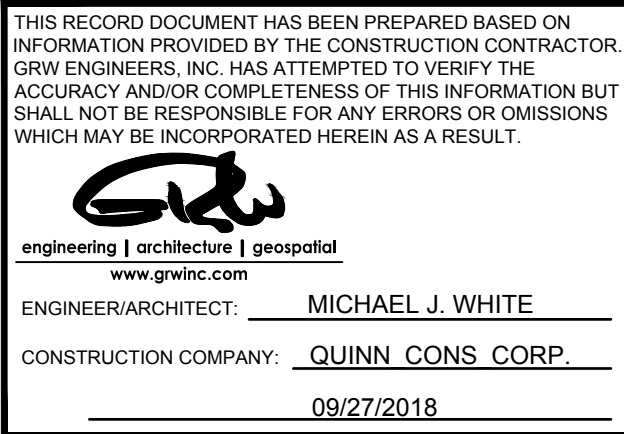

This document, originally issued, sealed, and signed by MICHAEL J. WHITE, Tennessee Professional Engineer, No. 117300, on JUNE 2015, shall not be used in lieu of a certified document.

THIS DOCUMENT IS THE PROPERTY OF
GRW ENGINEERS, INC. AND SHALL NOT
BE REPRODUCED IN WHOLE OR IN PART
OR USED FOR CONSTRUCTION OF
OTHER THAN THIS SPECIFIC PROJECT
WITHOUT WRITTEN PERMISSION

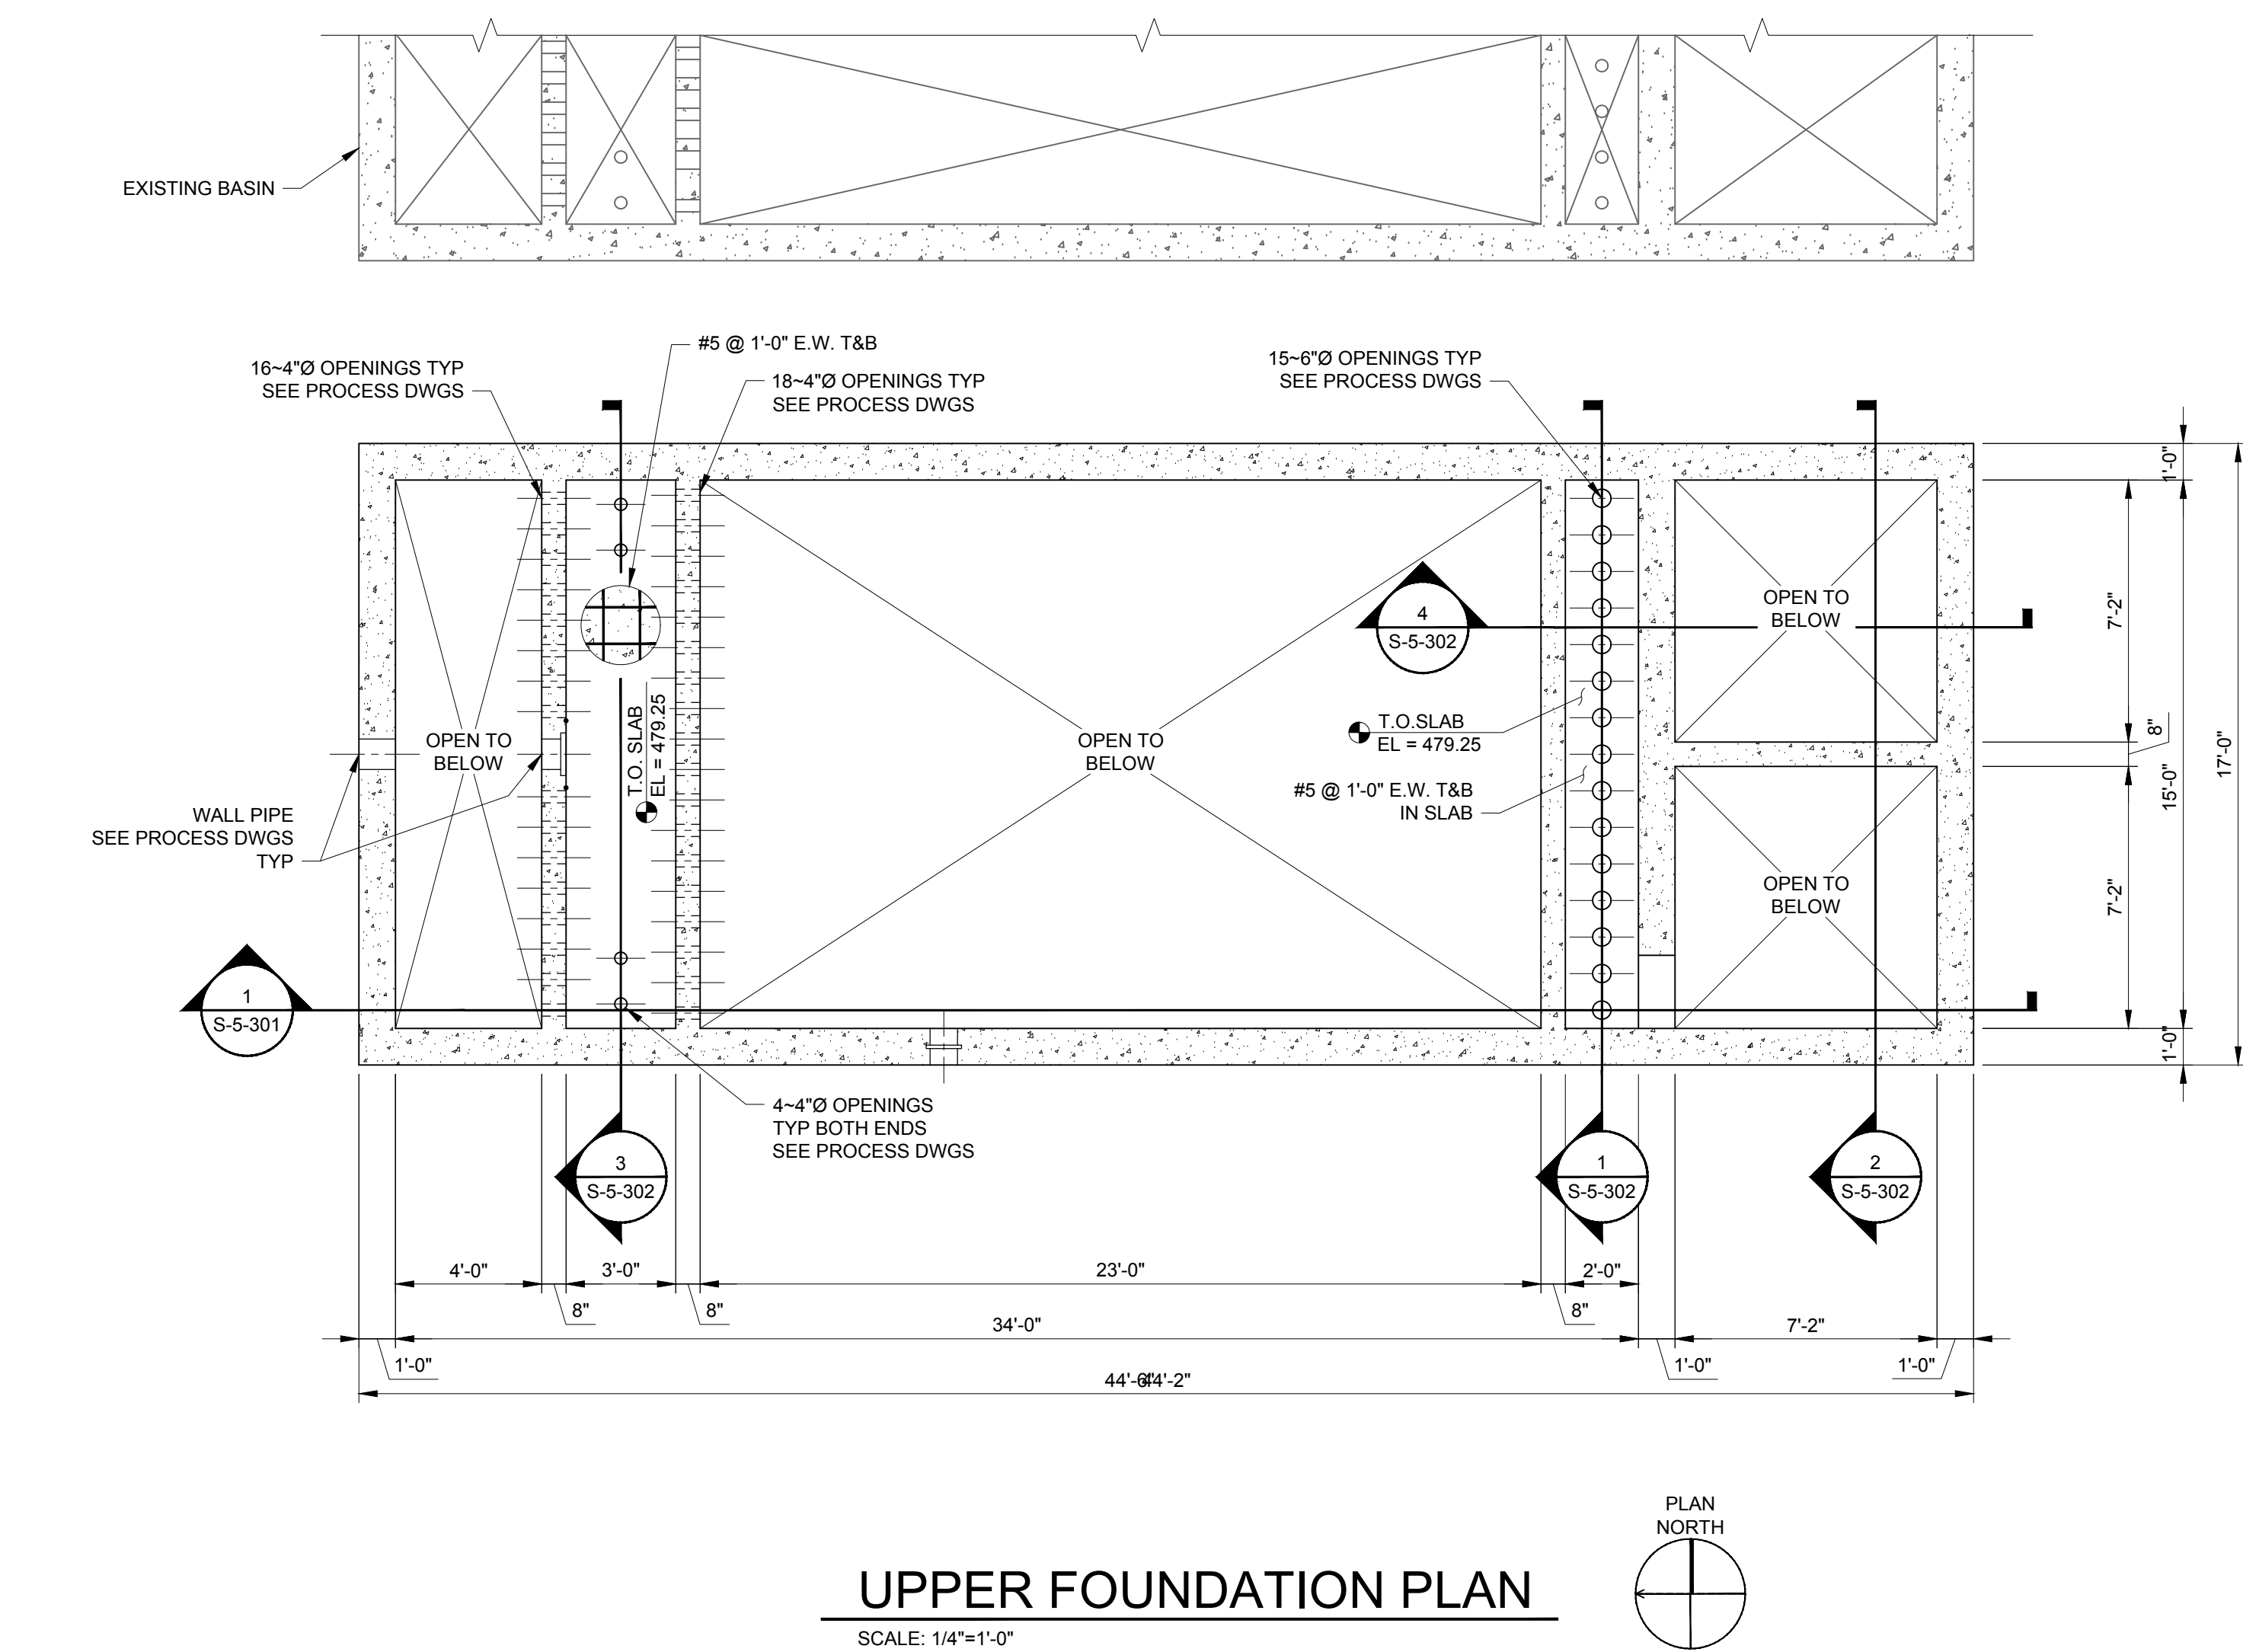

engineering | architecture | geospatial

www.givwillc.com

NEW FLOCCULATION / SEDIMENTATION BASIN
FOUNDATION PLANS

WATER TREATMENT PLANT EXPANSION
CITY OF LOBELVILLE, TENNESSEE

REVISIONS			BY	MJW
NO	DESCRIPTION	DATE		
				DRAWN
				LN
				REVIEWED
				MJW
				APPROVED
SCALE CHECK			THIS MARK SHOULD MEASURE EXACTLY 1" WHEN PLOTTED	

JUNE 2015

SCALE:

AS SHOWN

SHEET NO.

S-5-101

RECORD DRAWINGS

PLOTTED BY: nazad

PRINTED: 10/12/2018 @ 10:18AM

FILE NAME: G:\3827-Lobelville\07-WTP Expan\Working Drawings\AutoCAD - Record Drawing\3827-07_S-5-101.dwg