
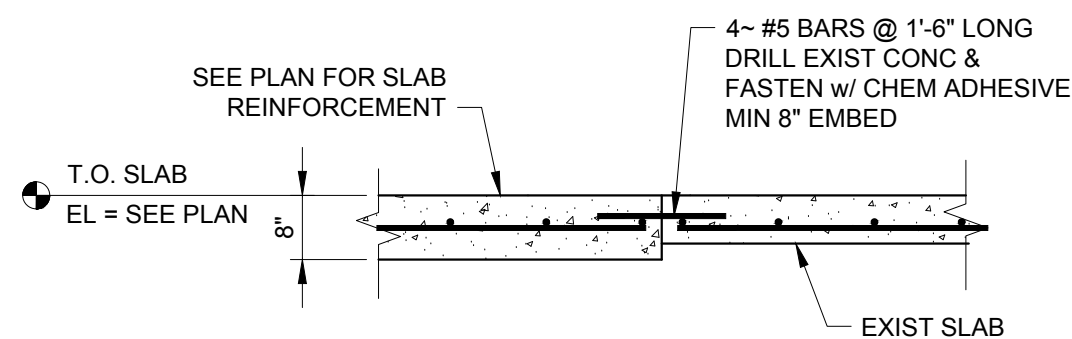


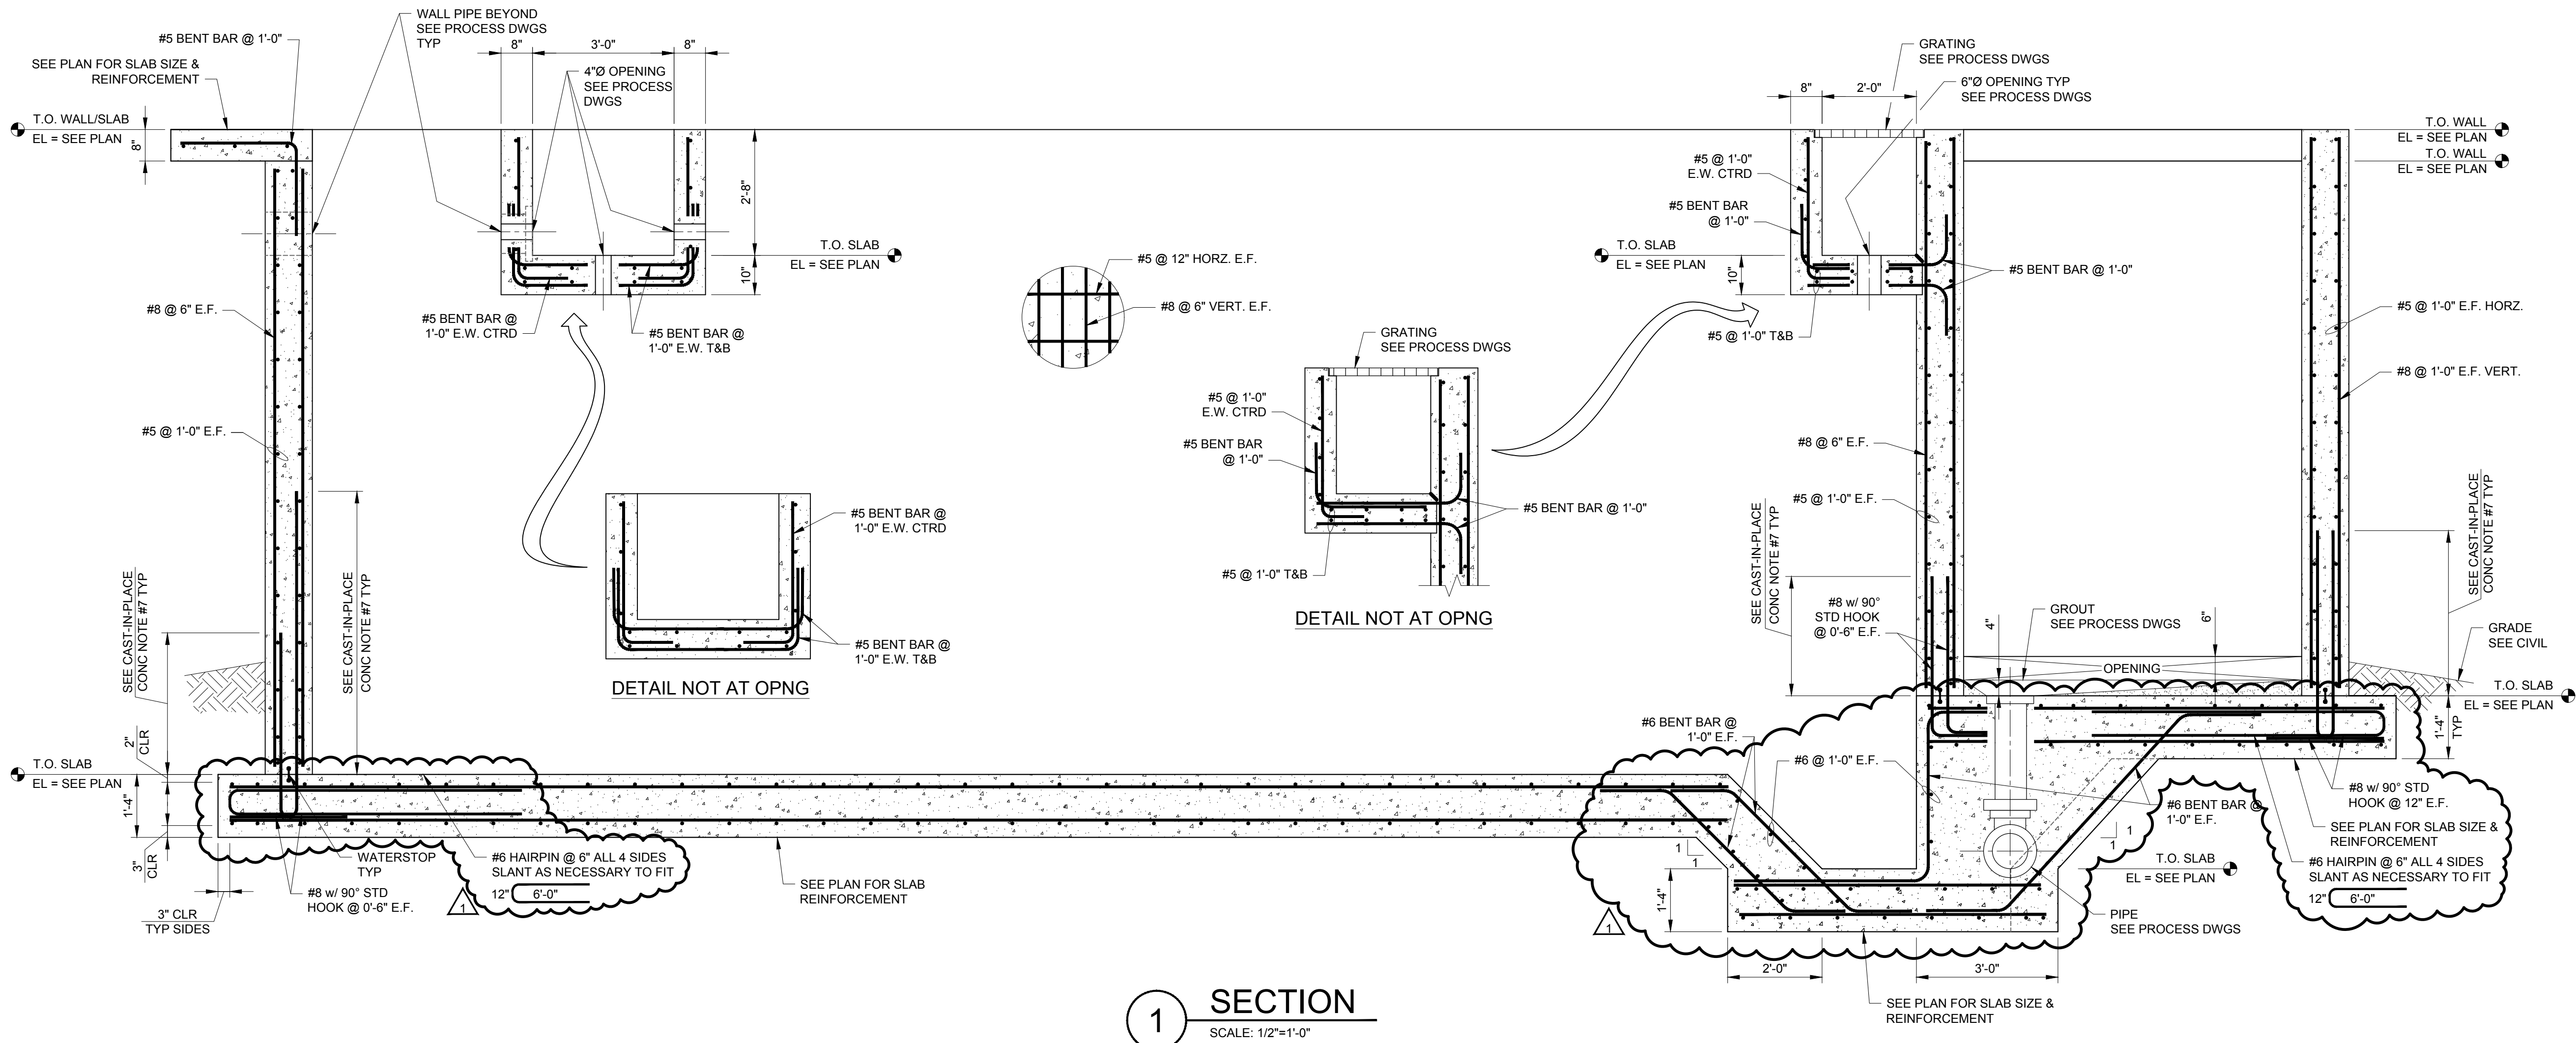

THIS RECORD DOCUMENT HAS BEEN PREPARED BASED ON INFORMATION PROVIDED BY THE CONSTRUCTION CONTRACTOR. GRW ENGINEERS, INC. HAS ATTEMPTED TO VERIFY THE ACCURACY AND/OR COMPLETENESS OF THIS INFORMATION BUT SHALL NOT BE RESPONSIBLE FOR ANY ERRORS OR OMISSIONS WHICH MAY BE INCORPORATED HEREIN AS A RESULT.

This document, originally issued, sealed, and signed by **MICHAEL J. WHITE**, Tennessee Professional Engineer, No. 117300, on JUNE 2015, shall not be used in lieu of a certified document.

GRW PROJECT NO. 3827-07

CLIENT PROJECT NO.

ALL RIGHTS RESERVED. NO PART OF THIS DOCUMENT SHALL BE REPRODUCED IN WHOLE OR IN PART WITHOUT THE WRITTEN PERMISSION OF GRW ENGINEERS, INC.

engineering | architecture | geospatial
www.grwinc.com

NEW FLOCCULATION / SEDIMENTATION BASIN
STRUCTURAL SECTION
WATER TREATMENT PLANT EXPANSION
CITY OF LOBEVILLE, TENNESSEE

DESIGNED: MJW
DRAWN: LN
REVIEWED: MJW
APPROVED: MJW

REVISIONS
NO. 1
FIELD ORDER

DATE: 10/12/18
MVC

THIS MARK SHOULD MEASURE EXACTLY 1" WHEN PLOTTED

DATE: JUNE 2015
SCALE: AS SHOWN
SHEET NO.

ENGINEER/ARCHITECT: MICHAEL J. WHITE
CONSTRUCTION COMPANY: QUINN CONS. CORP.
09/27/2018

S-5-301

RECORD DRAWINGS