
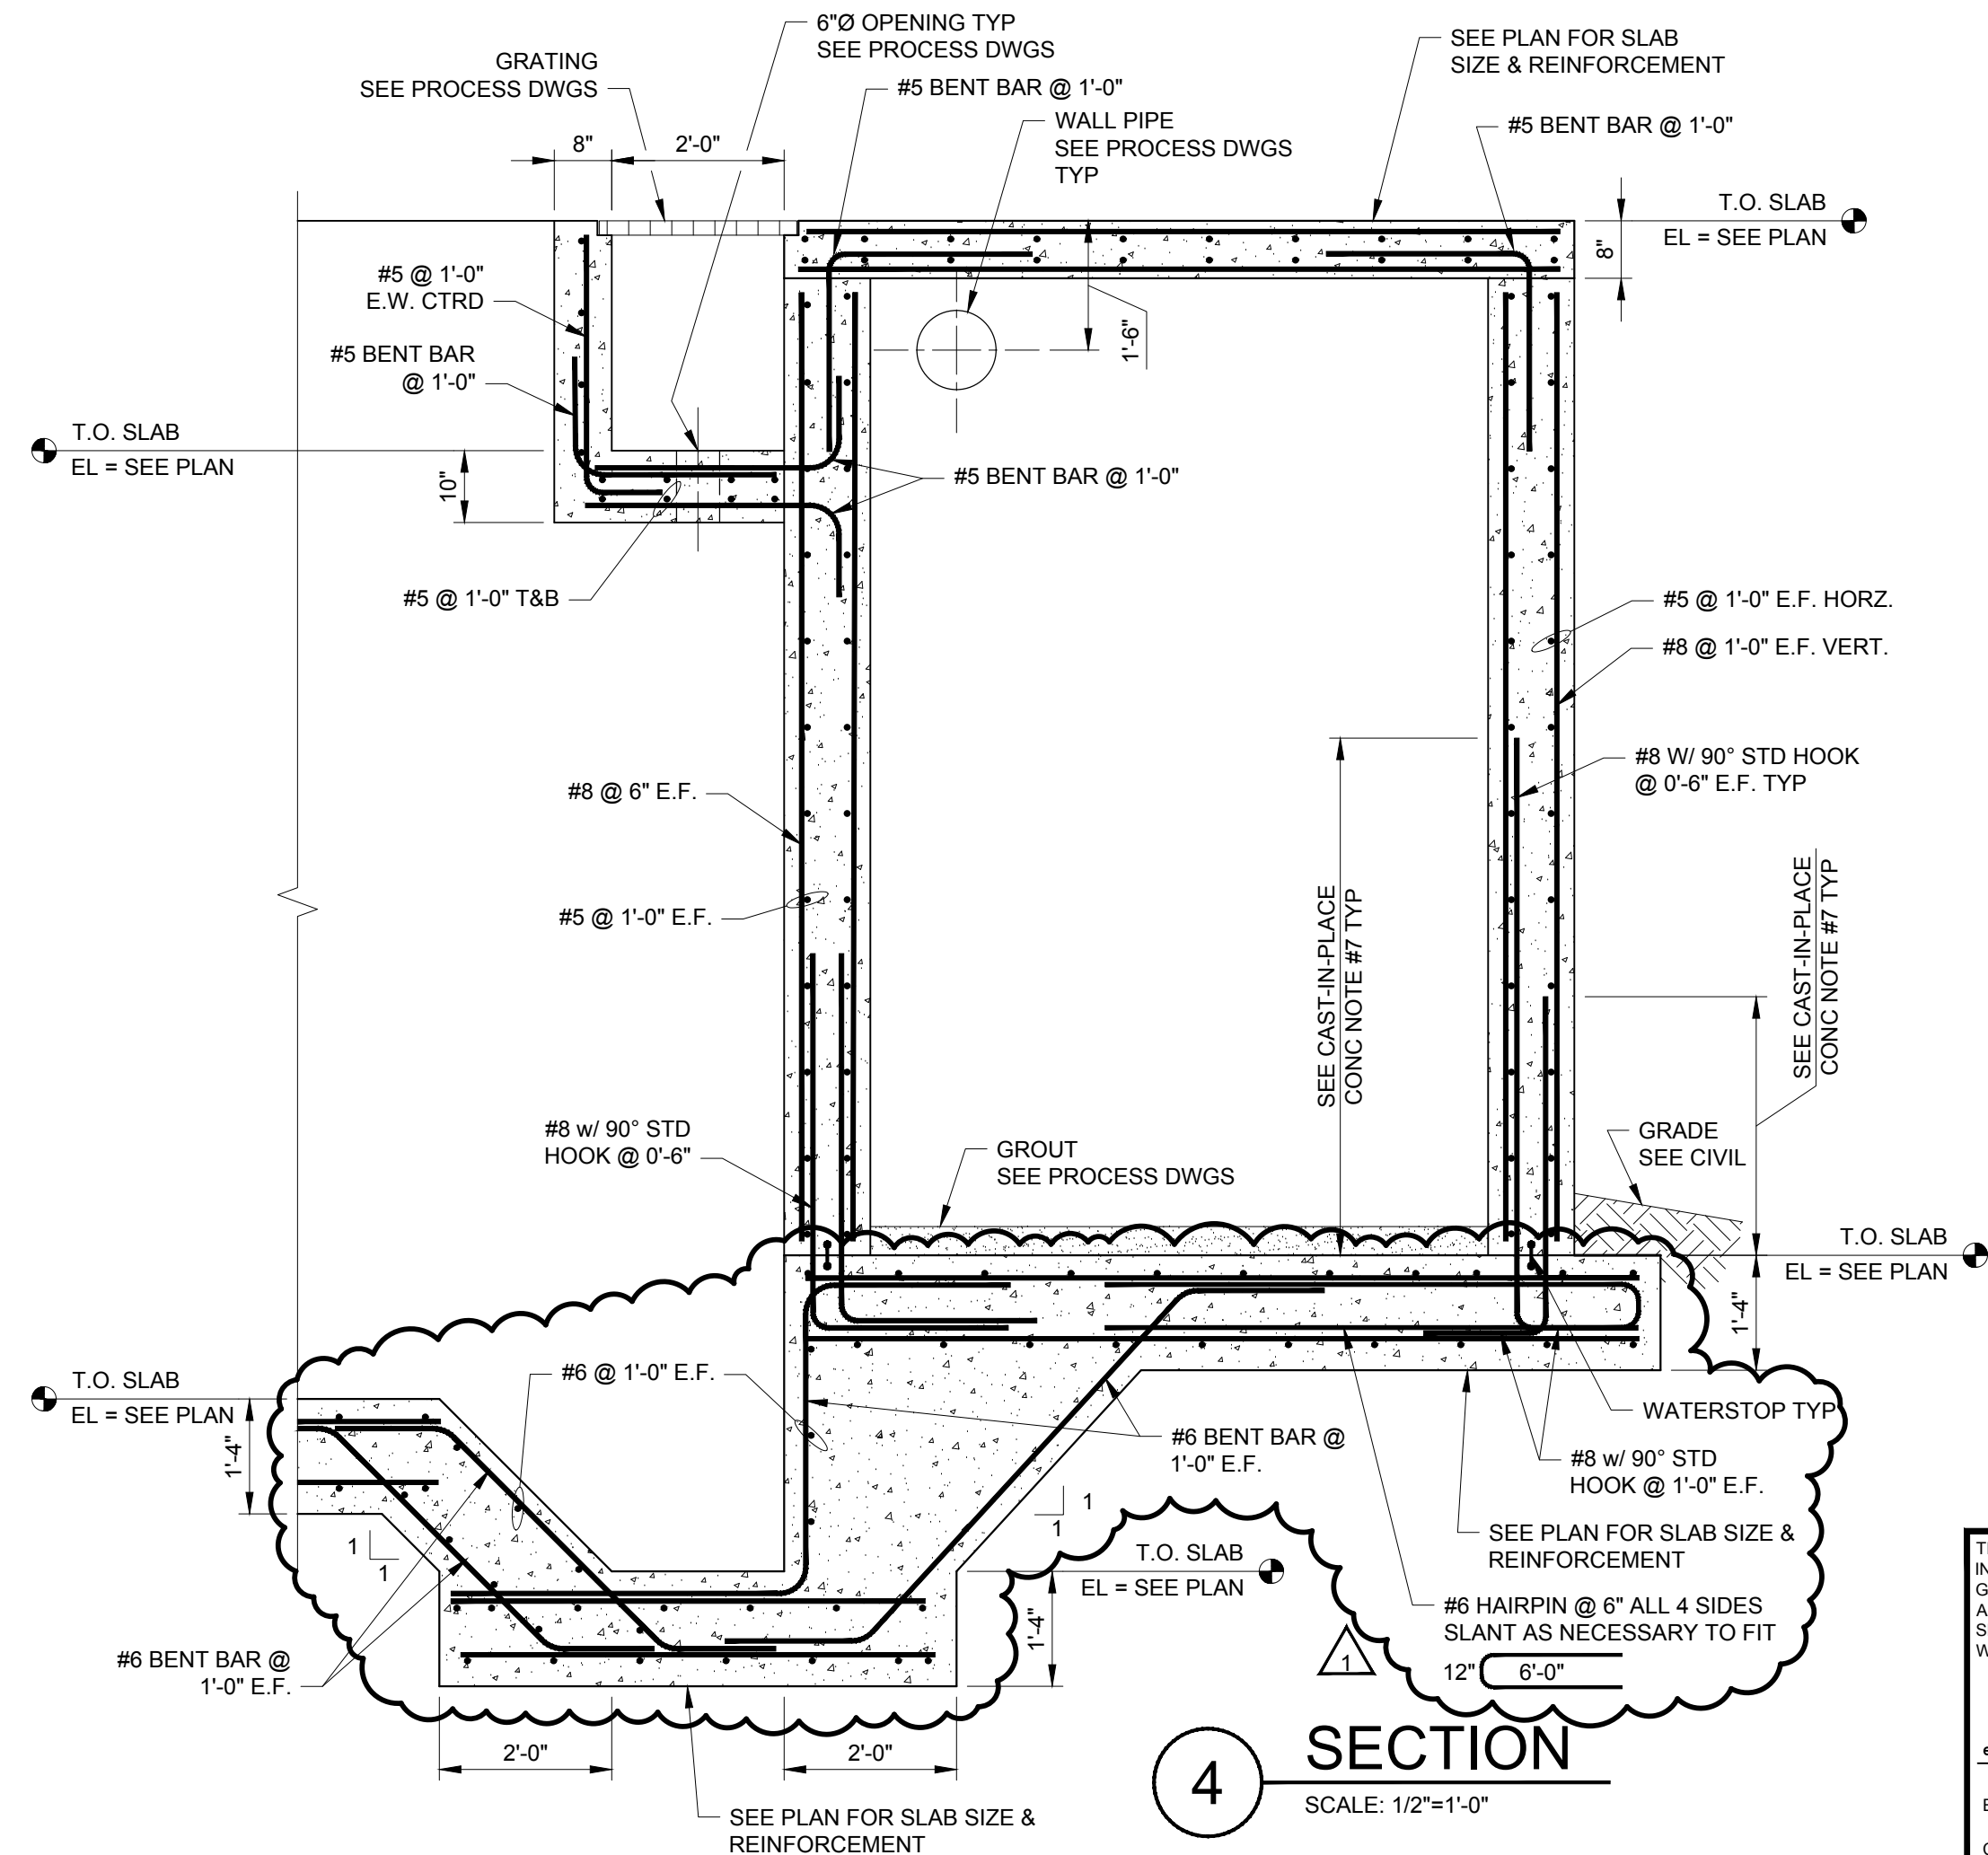
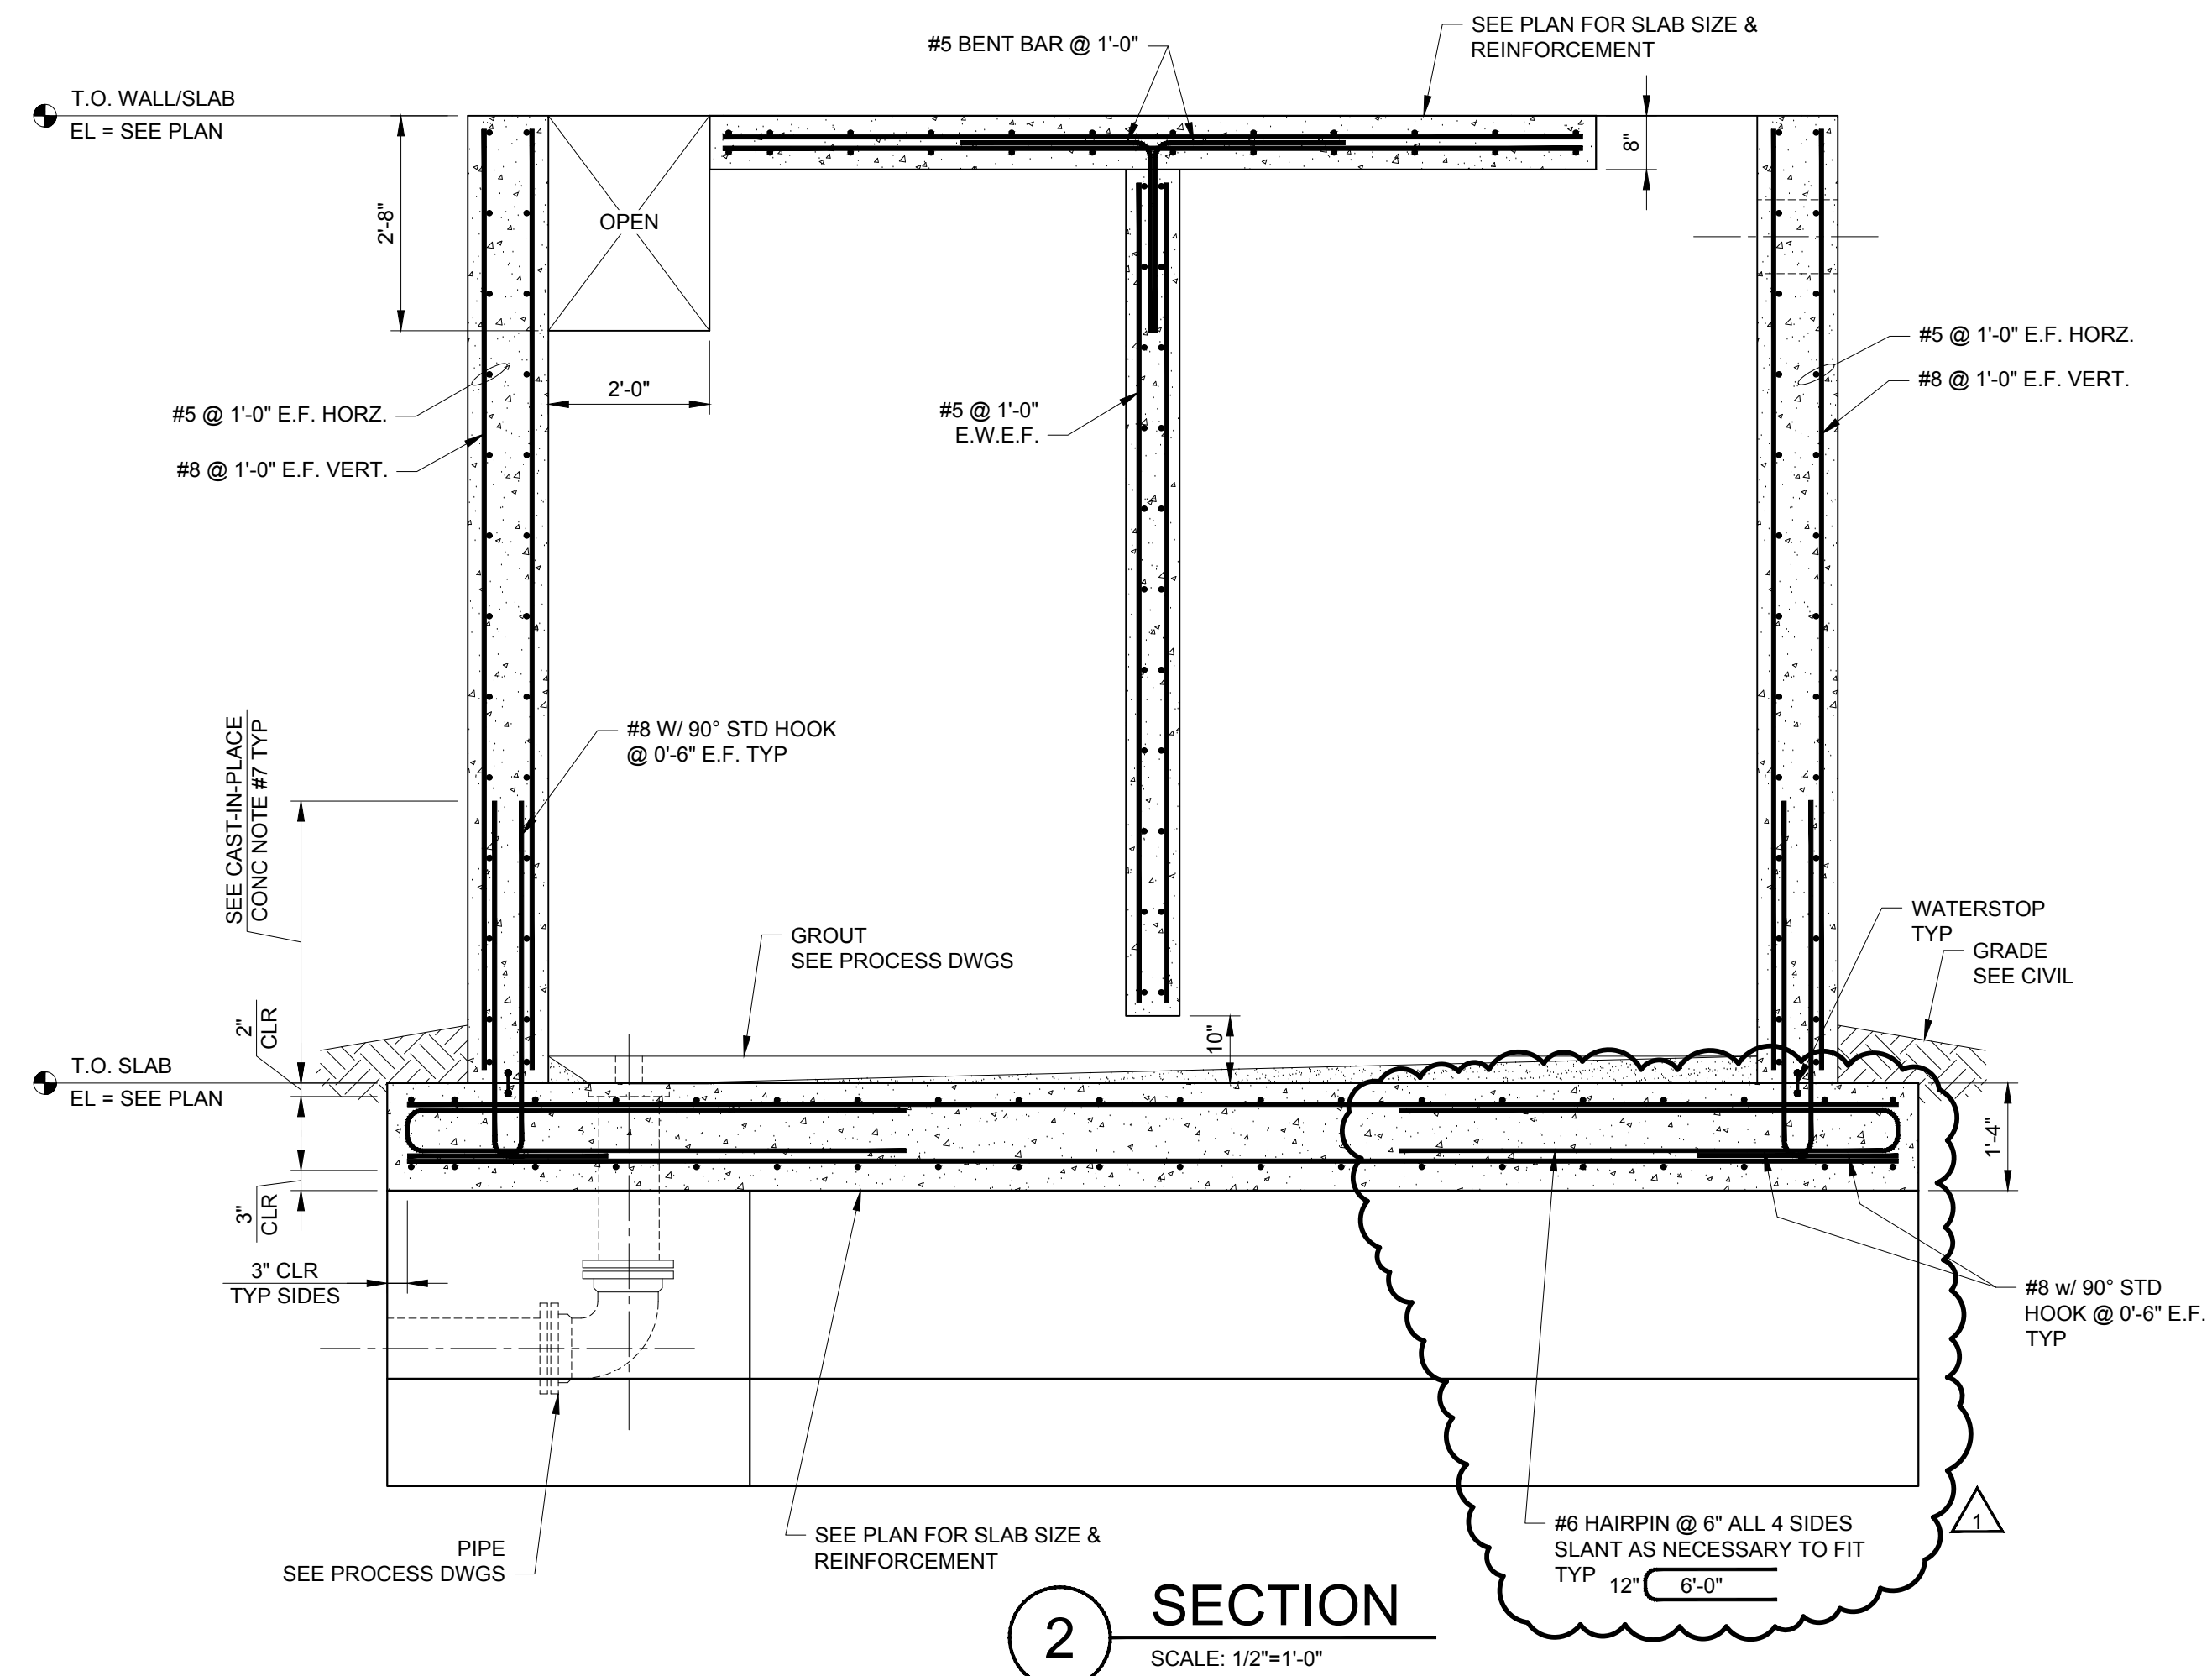
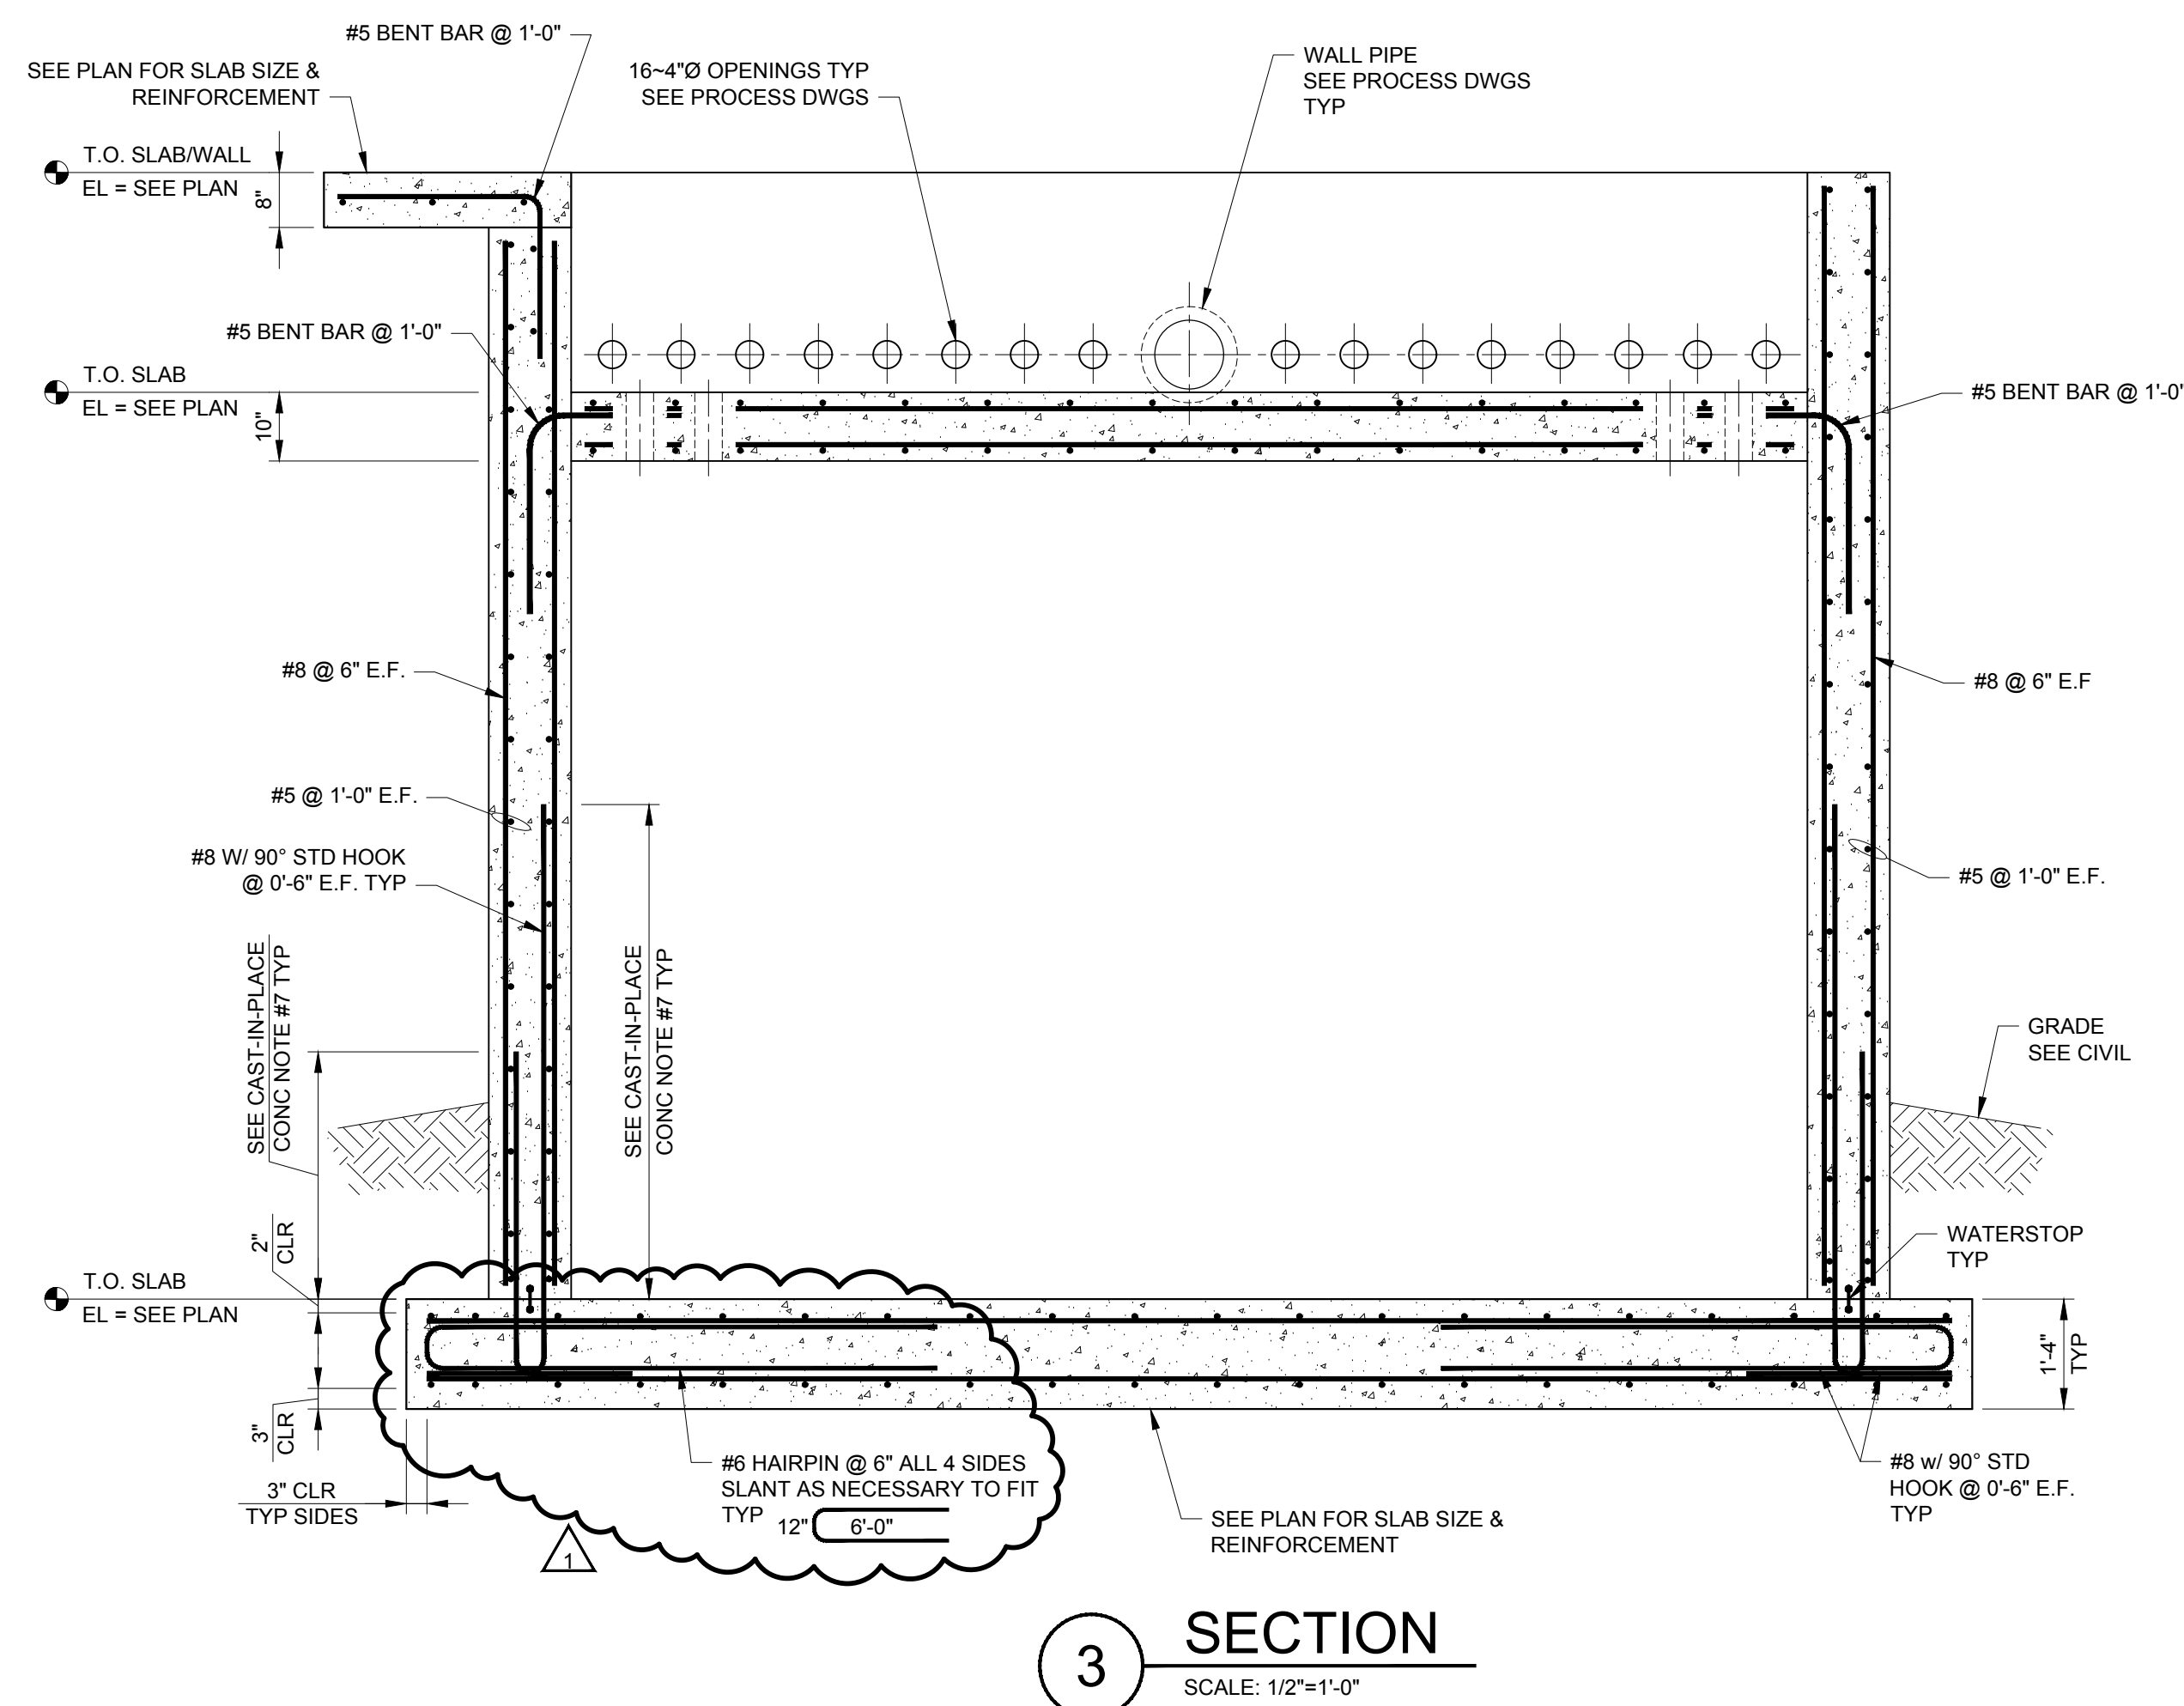


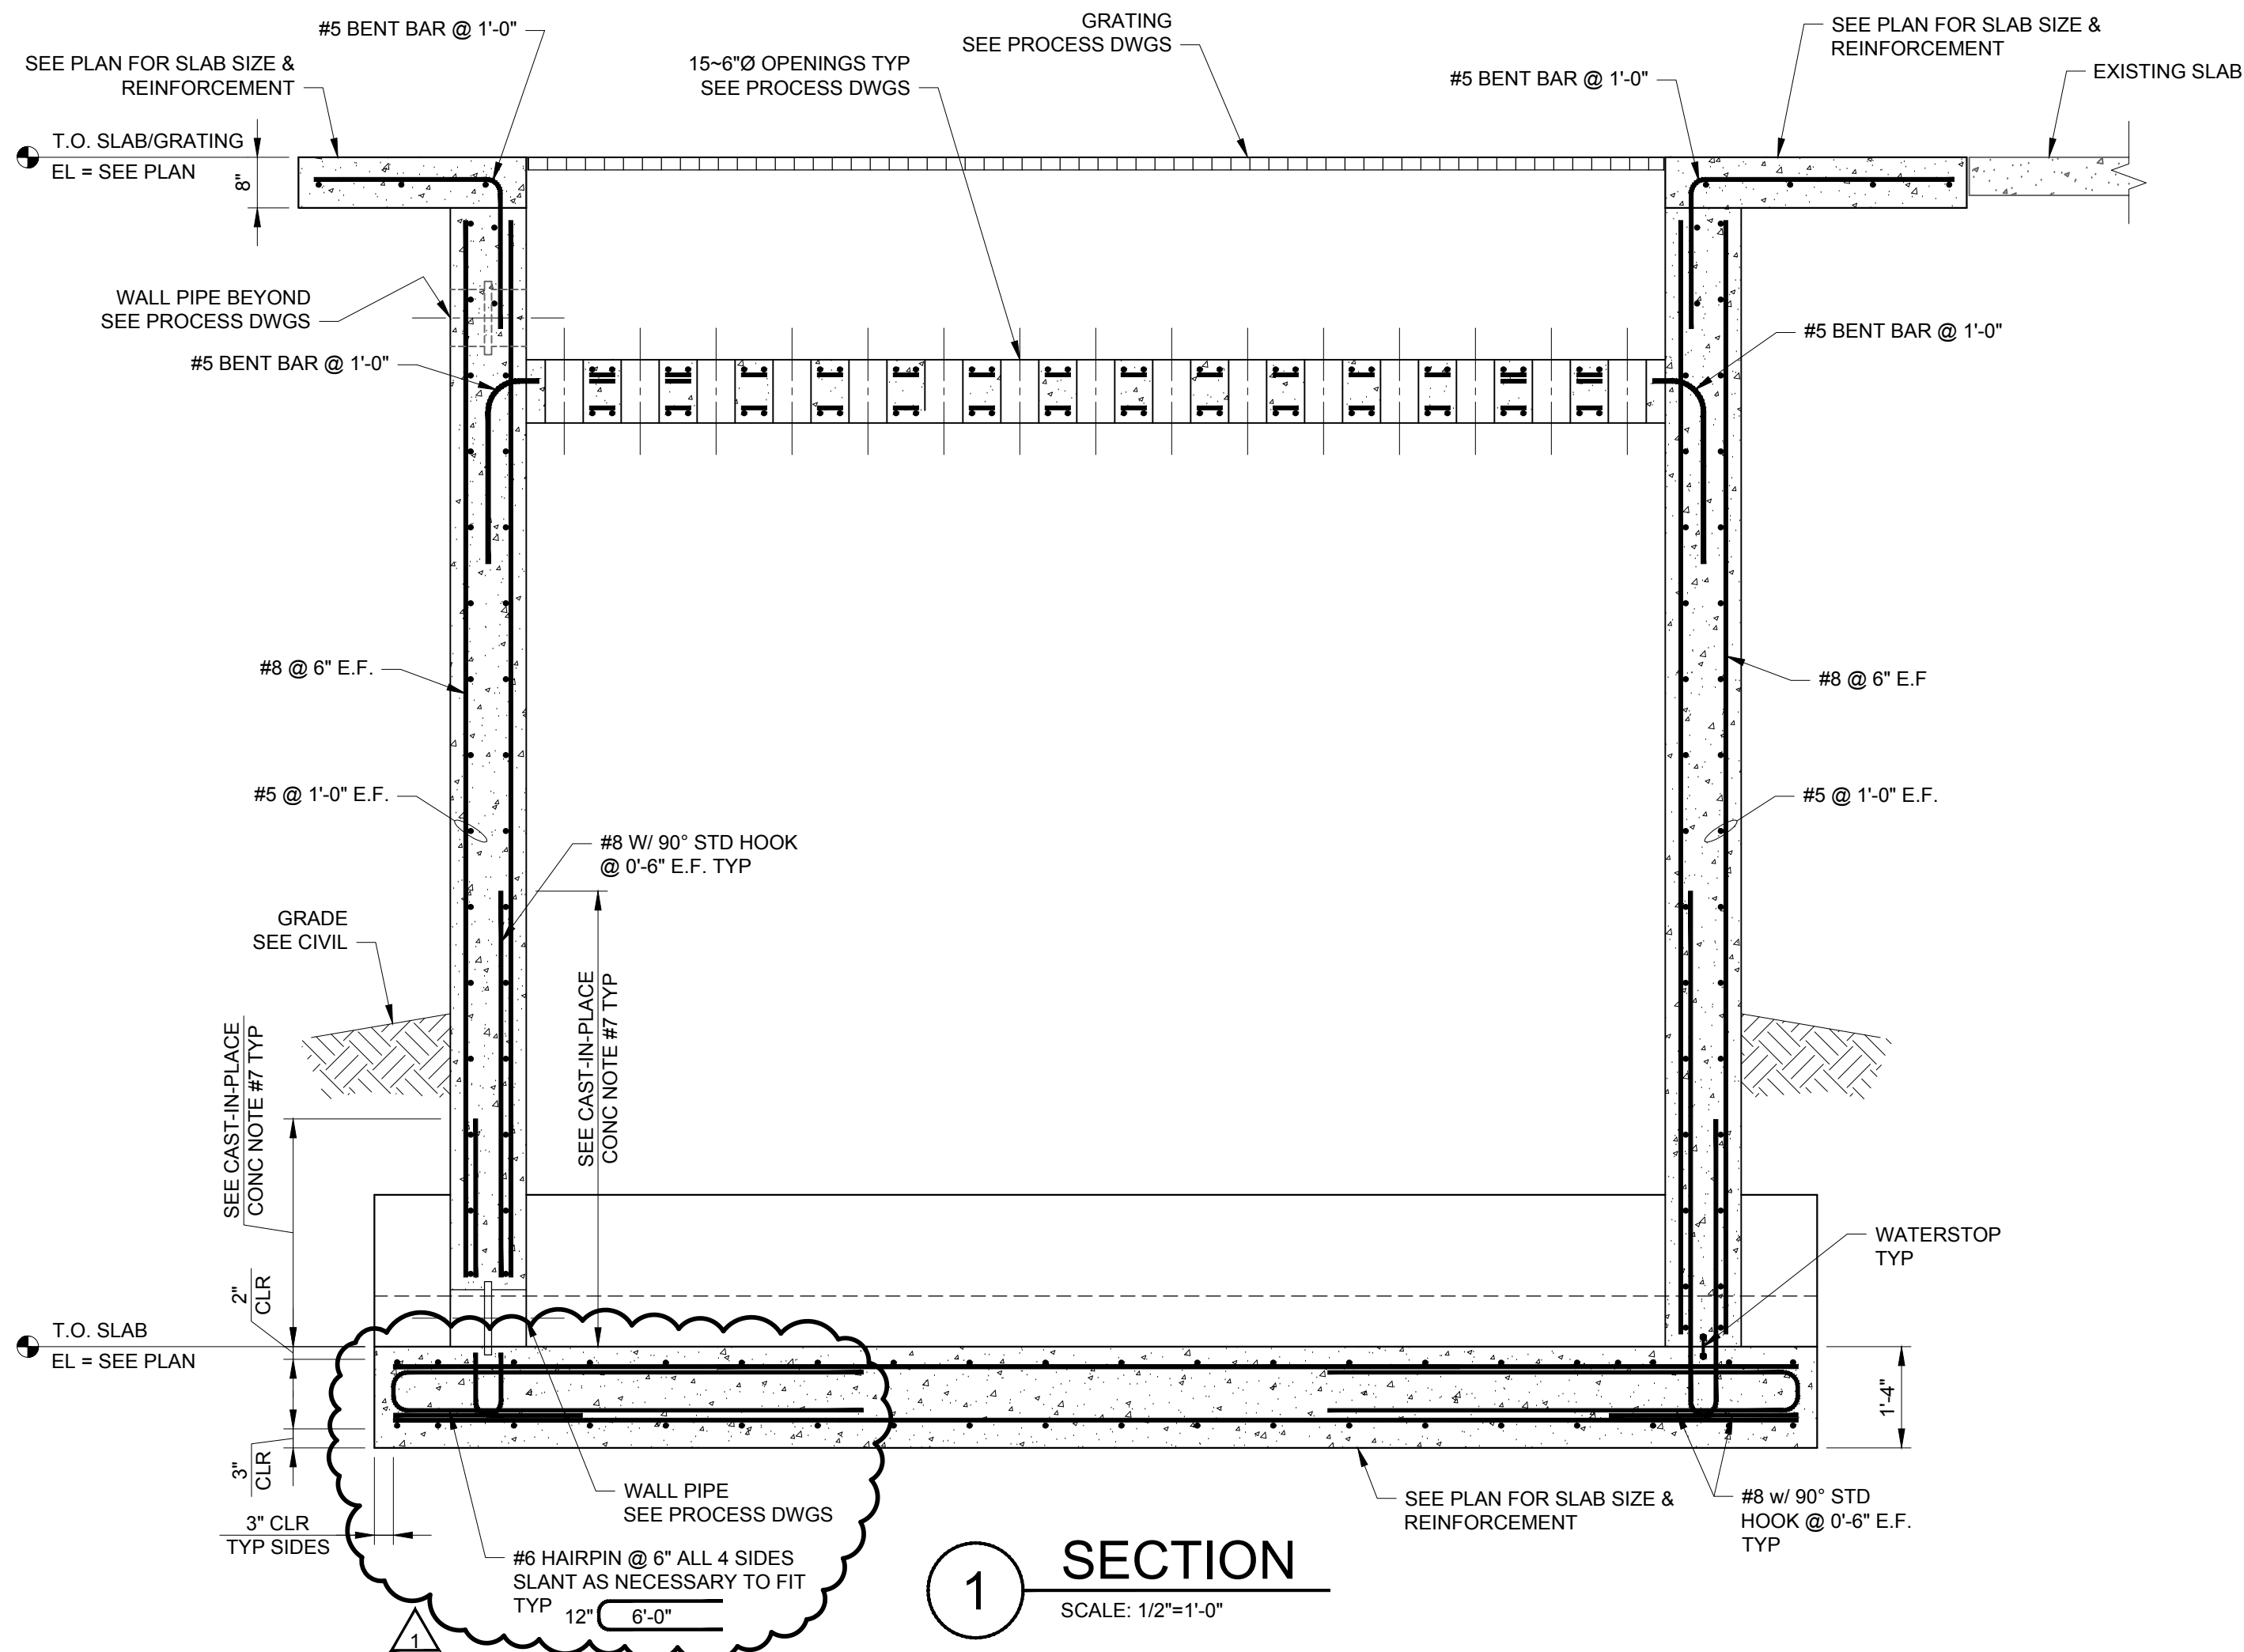

THIS RECORD DOCUMENT HAS BEEN PREPARED BASED ON INFORMATION PROVIDED BY THE CONSTRUCTION CONTRACTOR GRW ENGINEERS, INC. HAS ATTEMPTED TO VERIFY THE ACCURACY AND/OR COMPLETENESS OF THIS INFORMATION BUT SHALL NOT BE RESPONSIBLE FOR ANY ERRORS OR OMISSIONS WHICH MAY BE INCORPORATED HEREIN AS A RESULT.

GRW
engineering | architecture | geospatial
www.grwinc.com

ENGINEER/ARCHITECT: MICHAEL J. WHITE
CONSTRUCTION COMPANY: QUINN CONS CORP
09/27/2018

This document, originally issued, sealed, and signed by MICHAEL J. WHITE, Tennessee Professional Engineer, No. 117300, on JUNE 2015, shall not be used in lieu of a certified document.

GRW PROJECT NO. 3827-07

CLIENT PROJECT NO.



NEW FLOCCULATION / SEDIMENTATION BASIN
STRUCTURAL SECTIONS
WATER TREATMENT PLANT EXPANSION
CITY OF LOBELVILLE, TENNESSEE

DESIGNED		DRAWN		REVIEWED		APPROVED	
MJW		LN		MJW		MJW	
REVISIONS		DATE		DESCRIPTION		NO.	
1		10/12/18		FIELD ORDER		1	
DATE:		JUNE 2015		SCALE:		AS SHOWN	
SHEET NO.							

S-5-302