



FILE NAME: G:\3827-Lobelville\07-WTP Expansion\Working Drawings\AutoCAD - Record\Drawing\3827-07_S-6-301.dwg
PRINTED: 10/12/2018 @ 10:18AM
PLOTTED BY: razad

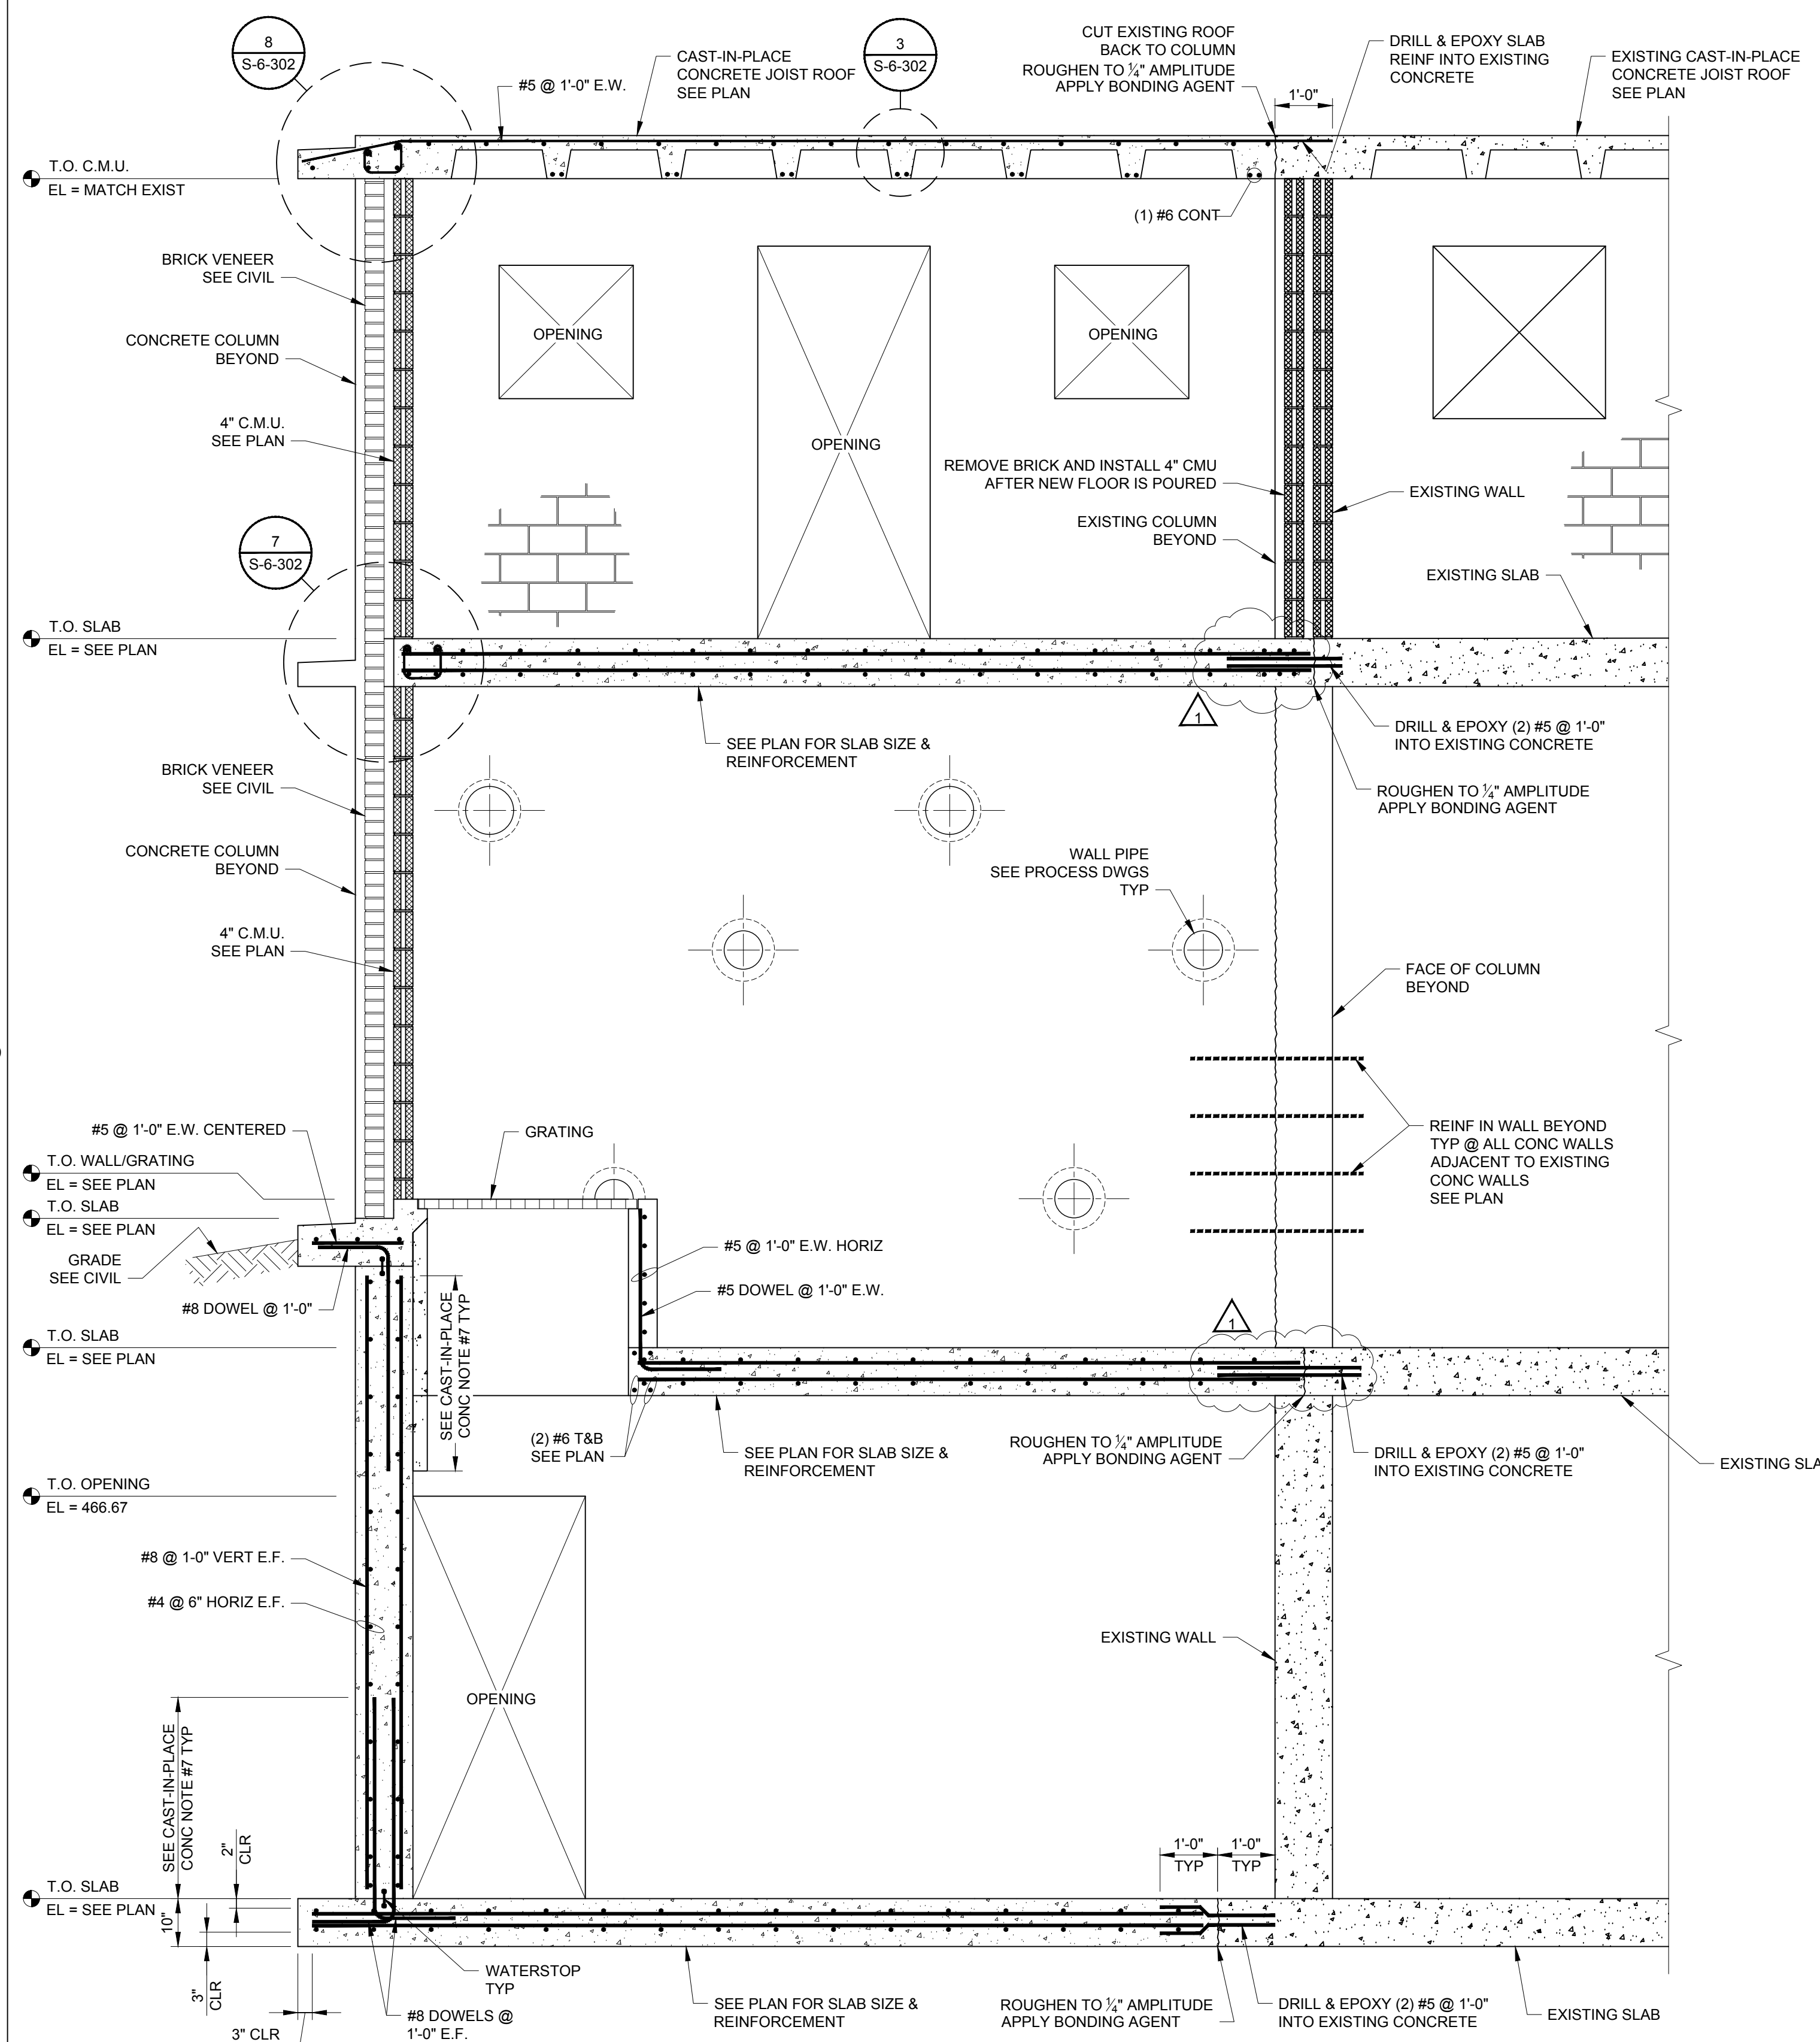

1 SECTION
SCALE: 1/2"=1'-0"

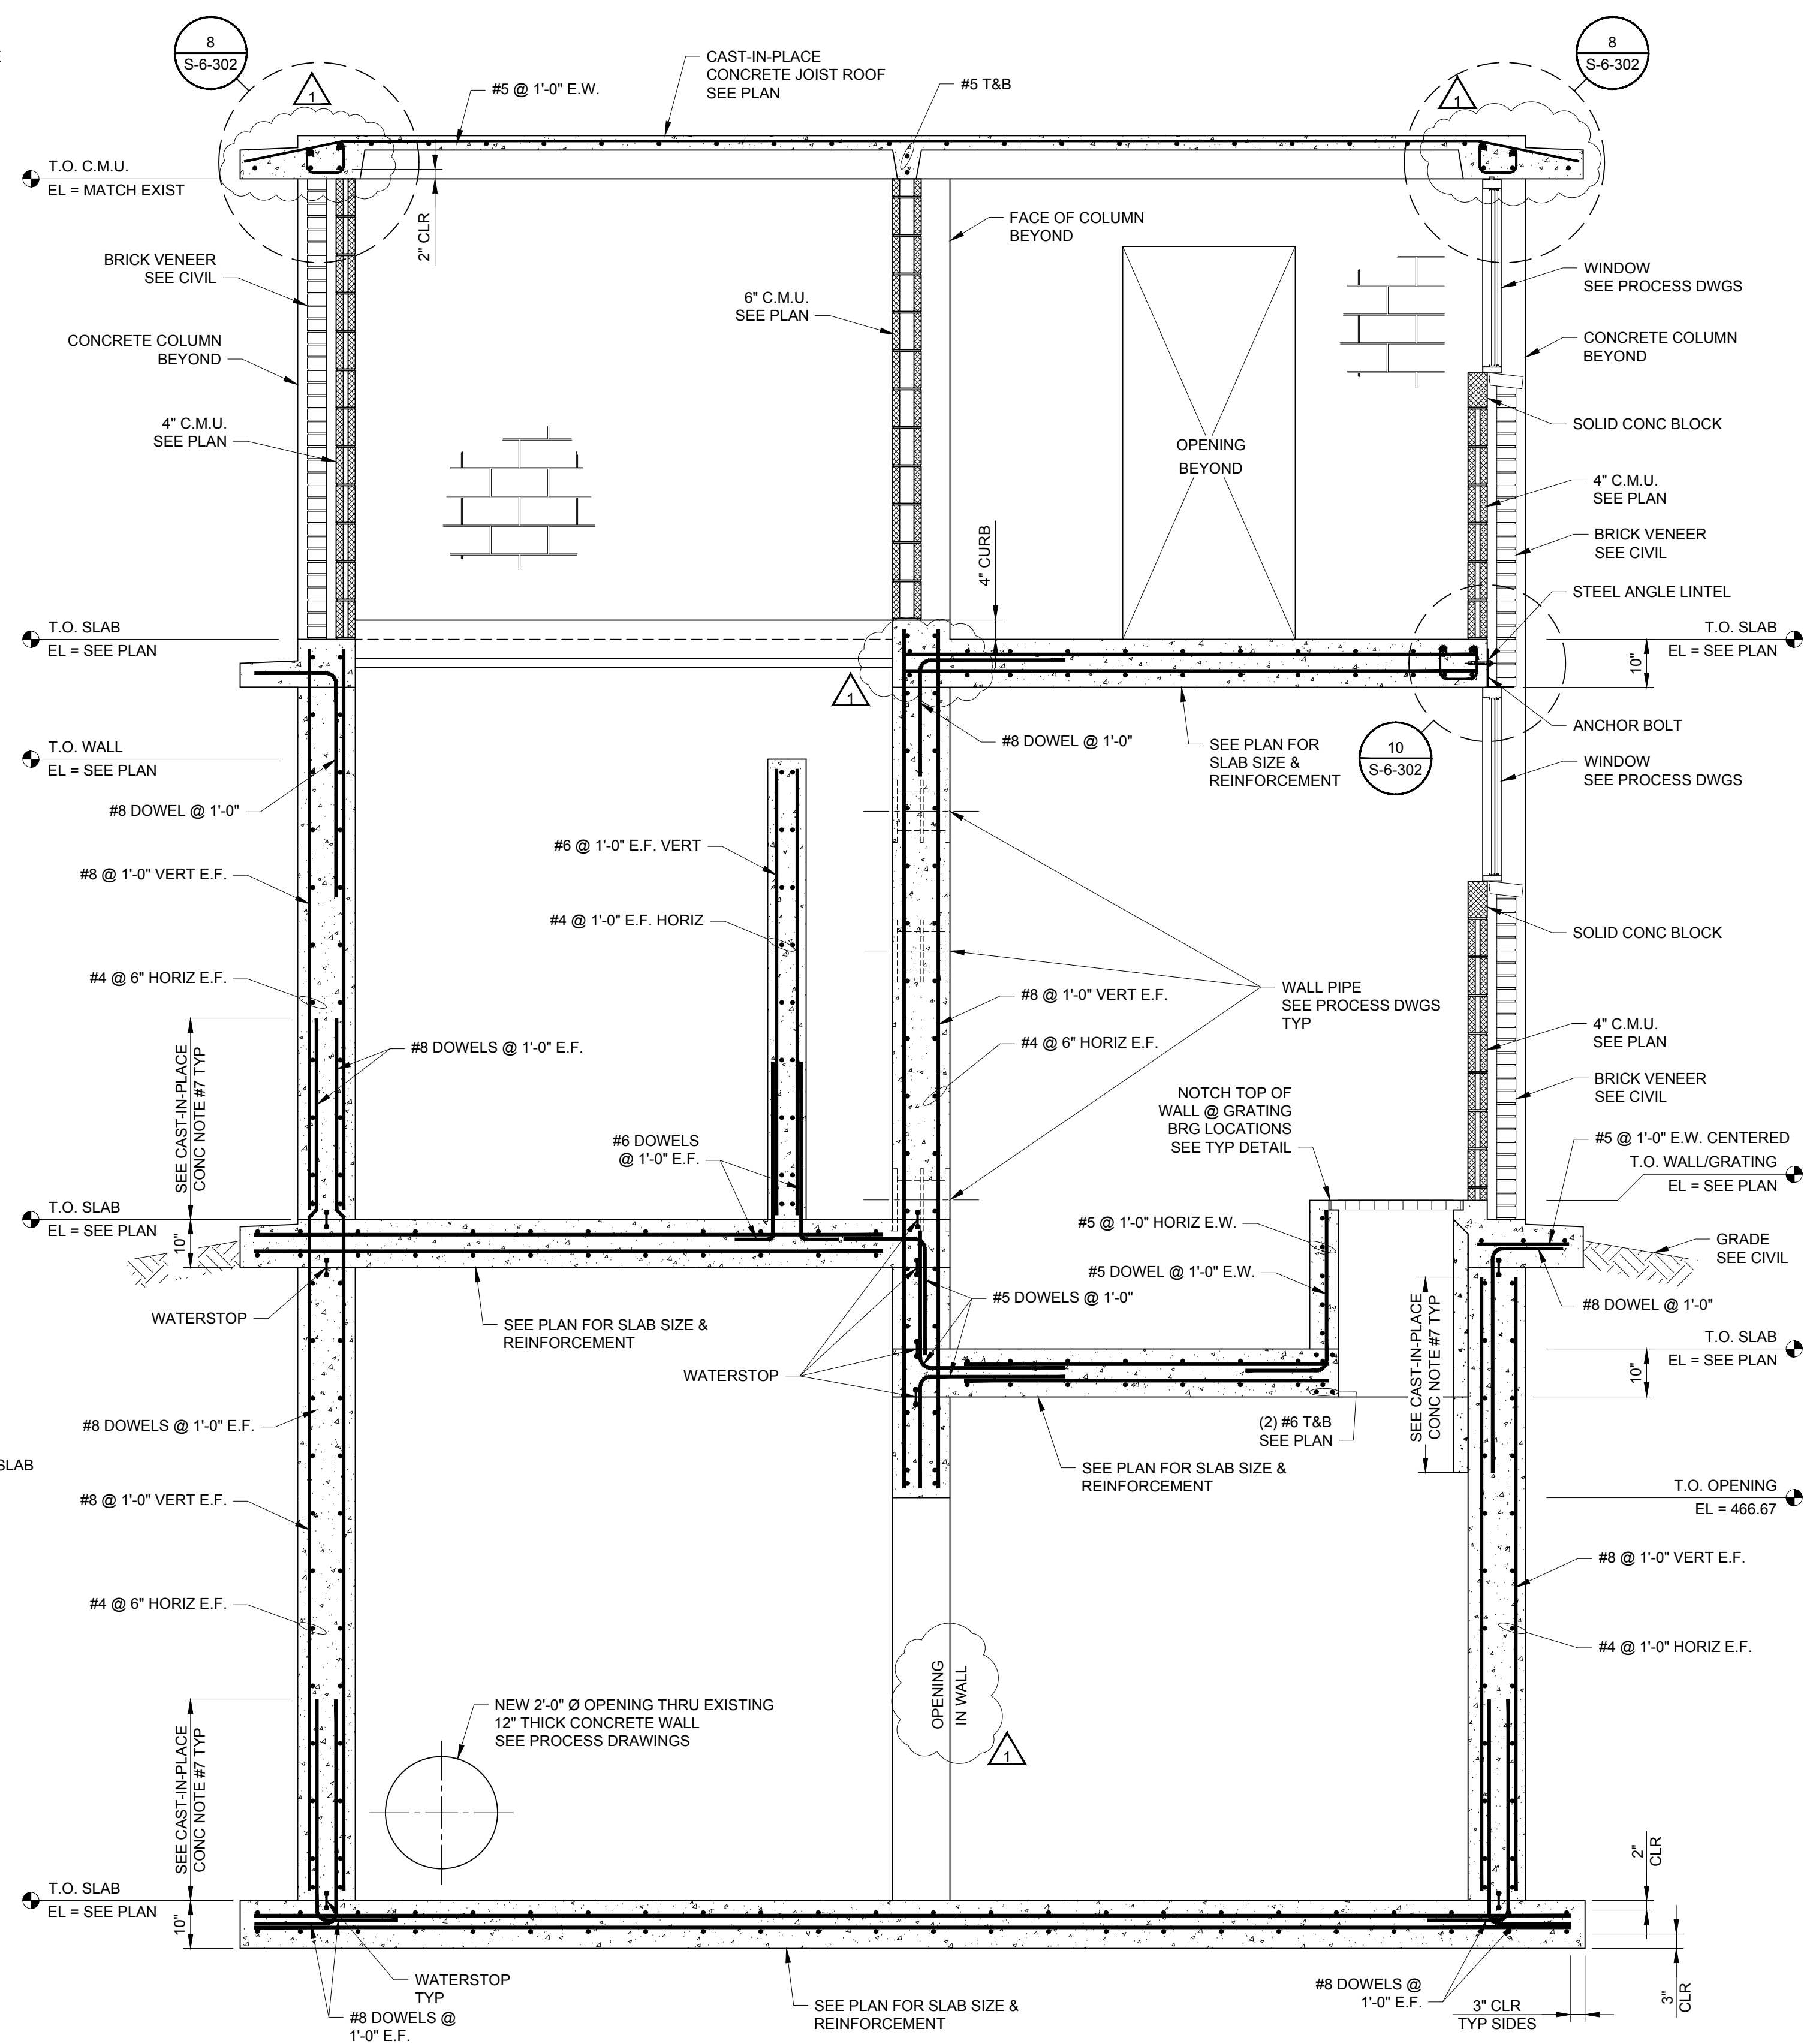

2 SECTION
SCALE: 1/2"=1'-0"

THIS RECORD DOCUMENT HAS BEEN PREPARED BASED ON INFORMATION PROVIDED BY THE CONSTRUCTION CONTRACTOR. GRW ENGINEERS, INC. HAS ATTEMPTED TO VERIFY THE ACCURACY AND/OR COMPLETENESS OF THIS INFORMATION BUT SHALL NOT BE RESPONSIBLE FOR ANY ERRORS OR OMISSIONS WHICH MAY BE INCORPORATED HEREIN AS A RESULT.

GRW
engineering | architecture | geospatial
www.grwinc.com

ENGINEER/ARCHITECT: MICHAEL J. WHITE
CONSTRUCTION COMPANY: QUINN CONS. CORP.
09/27/2018

GRW PROJECT NO. 3827-07

CLIENT PROJECT NO.

ALL RIGHTS RESERVED. THIS DOCUMENT IS THE PROPERTY OF GRW ENGINEERS, INC. AND SHALL NOT BE REPRODUCED IN WHOLE OR IN PART WITHOUT WRITTEN PERMISSION FROM GRW ENGINEERS, INC.

GRW
engineering | architecture | geospatial
www.grwinc.com

**FILTER BUILDING ADDITION
STRUCTURAL SECTIONS**

**WATER TREATMENT PLANT EXPANSION
CITY OF LOBELVILLE, TENNESSEE**

DESIGNED	MJW	DATE	BY	DATE	BY	DATE	BY	DATE	BY
NO.	1	FIELD ORDER							

REVISIONS

DATE: JUNE 2015

SCALE: AS SHOWN

SHEET NO.

SCALE CHECK: 1"=1'-0"

THIS MARK SHOULD MEASURE EXACTLY 1" WHEN PLOTTED

S-6-301