



PLOTTED BY: rnzad

PRINTED: 4/13/2016 @ 1:21PM


FILE NAME: G:\3827-Lobelville\08-SS Rehab\Working Drawings\AuscAD\3827-08-C-07.dwg

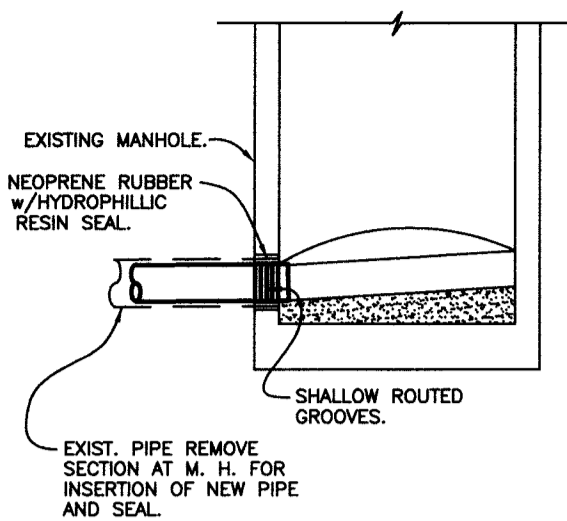


**END OF LINE MANHOLE CONNECTION DETAIL**  
NOT TO SCALE

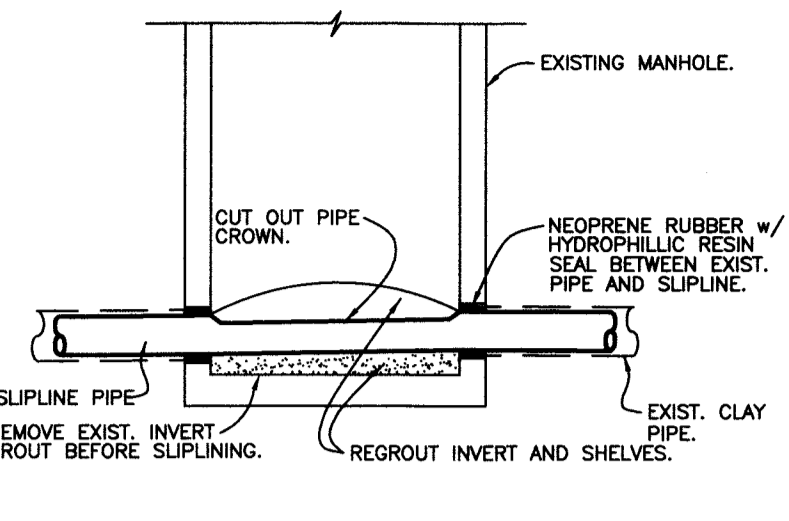


**SLIPLINE THROUGH MANHOLE DETAIL**  
NOT TO SCALE

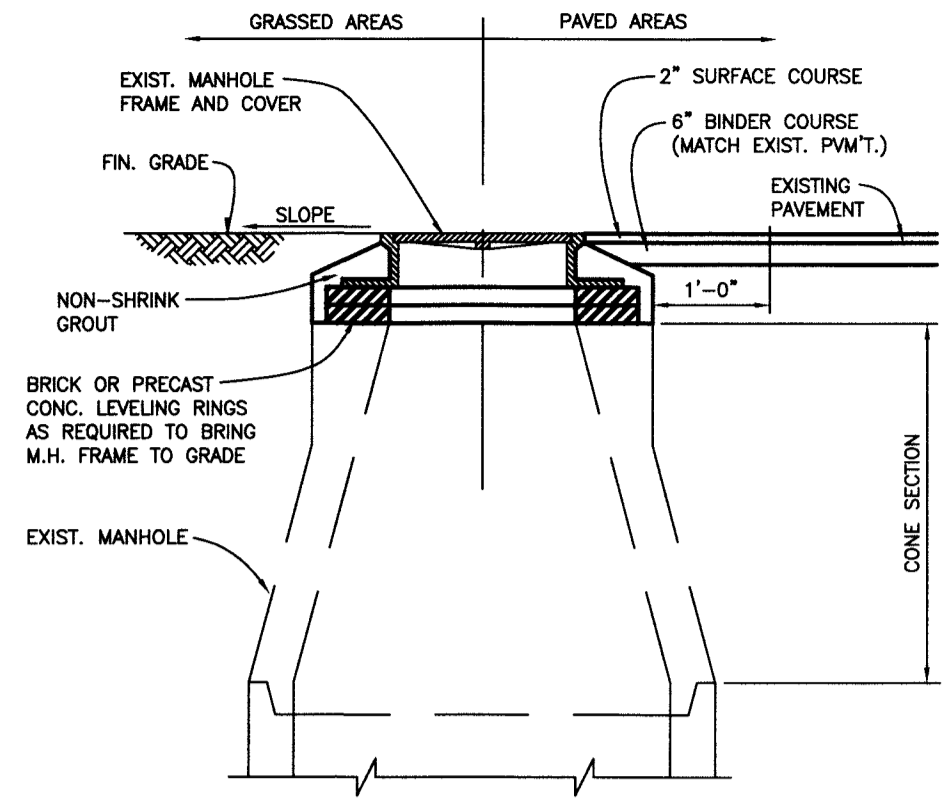


**RAISING CASTING INSTALLATION DETAIL**  
NOT TO SCALE

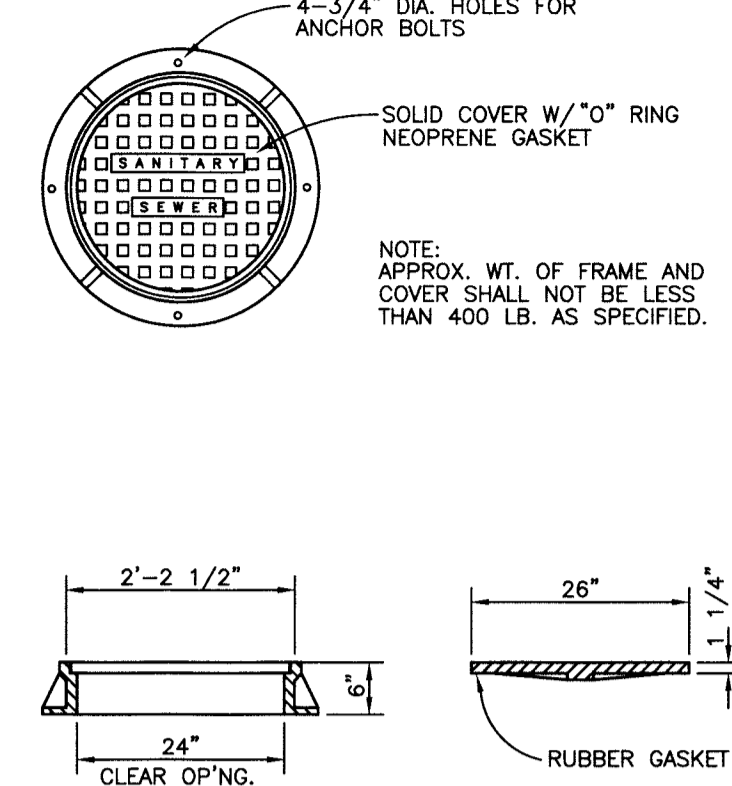


**STANDARD MANHOLE FRAME & COVER**  
NOT TO SCALE

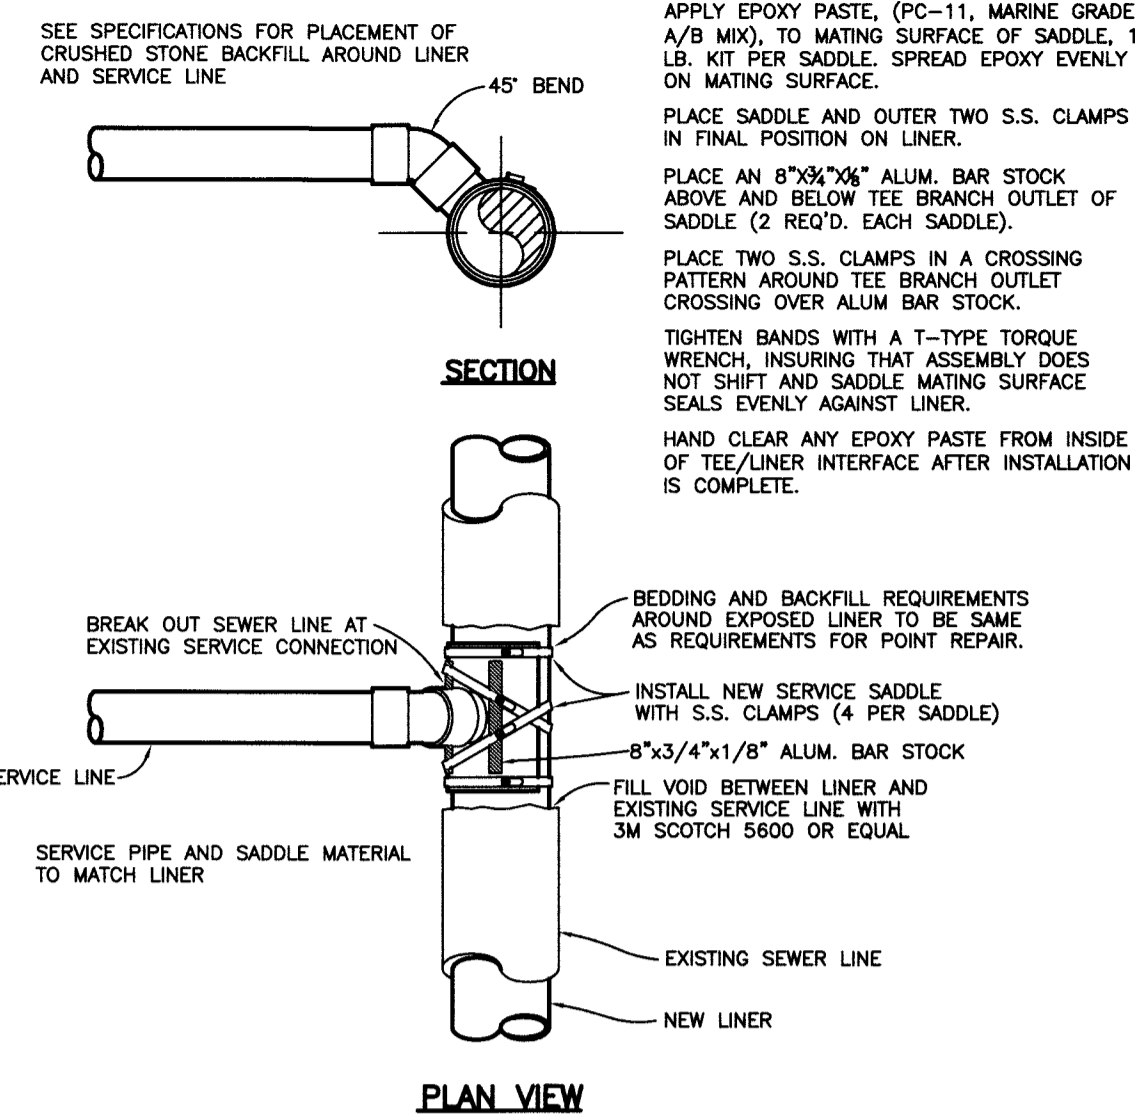


**SERVICE RECONNECTION TO LINER**  
NOT TO SCALE

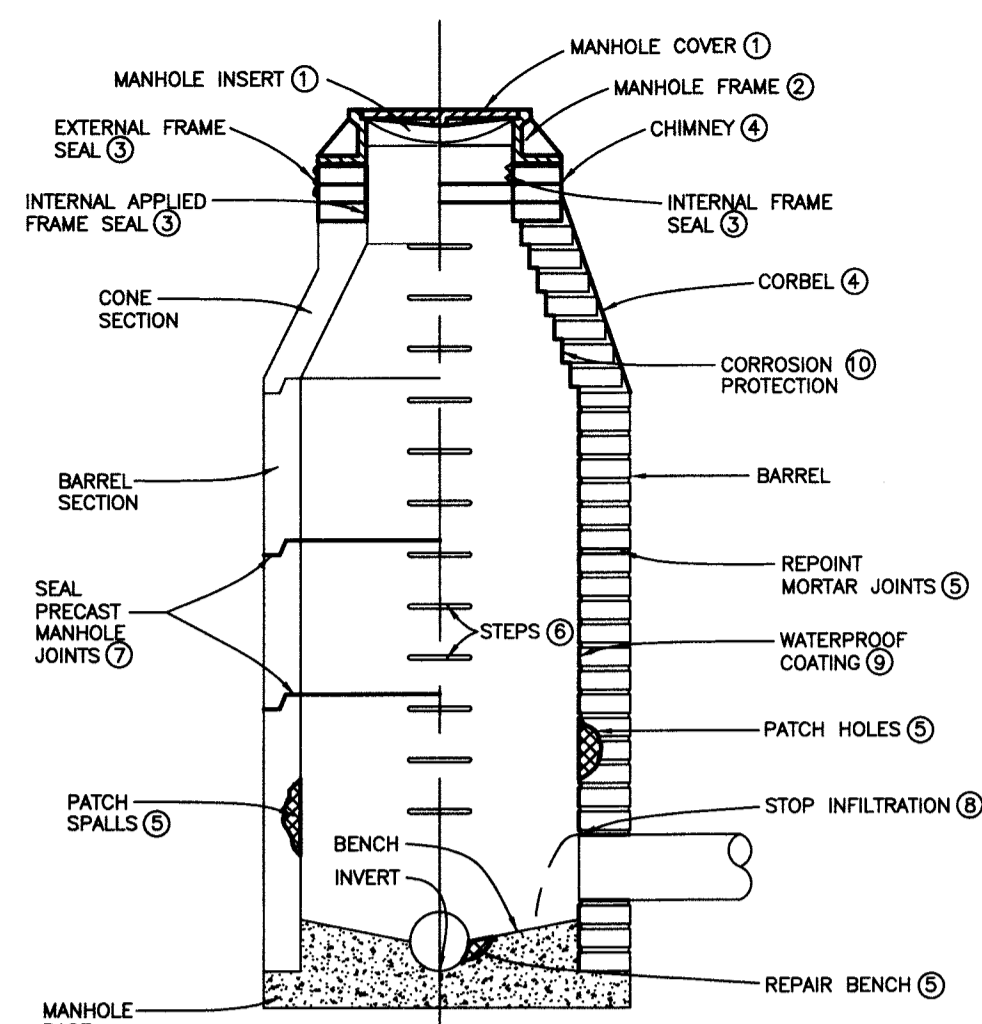


**MANHOLE REHABILITATION DETAIL**  
NOT TO SCALE

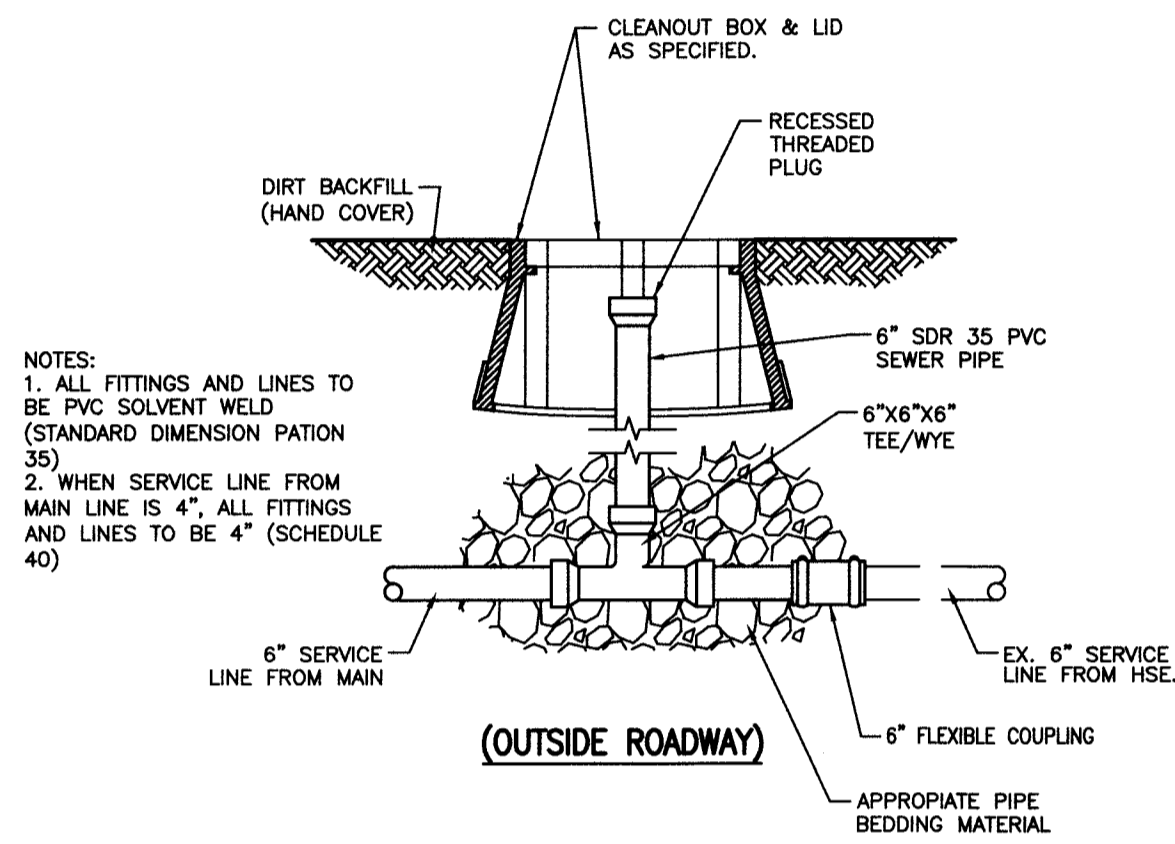


**CLEANOUT DETAIL**  
NOT TO SCALE

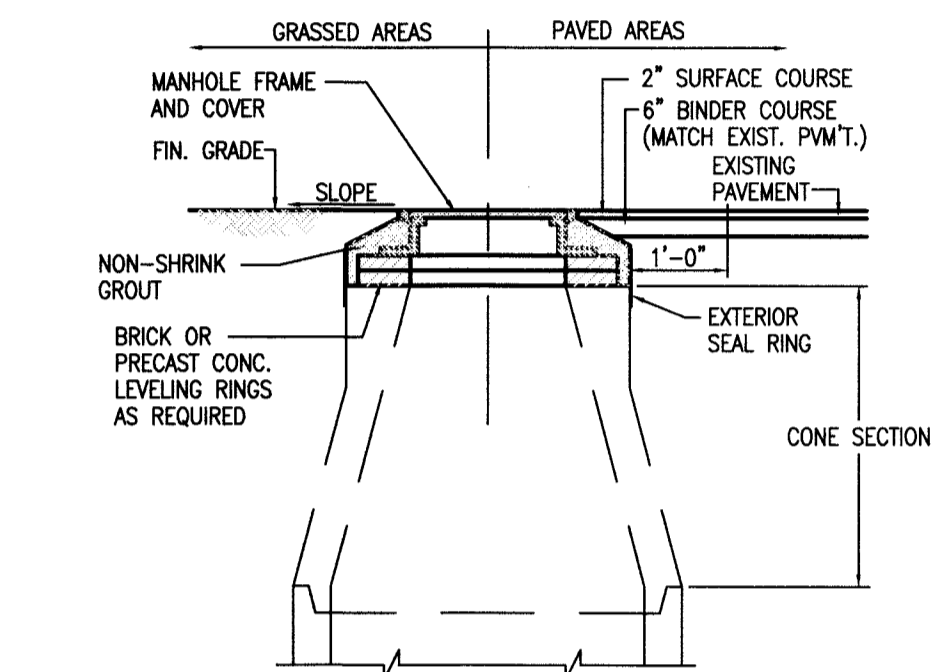


**CASTING INSTALLATION DETAIL**  
NOT TO SCALE

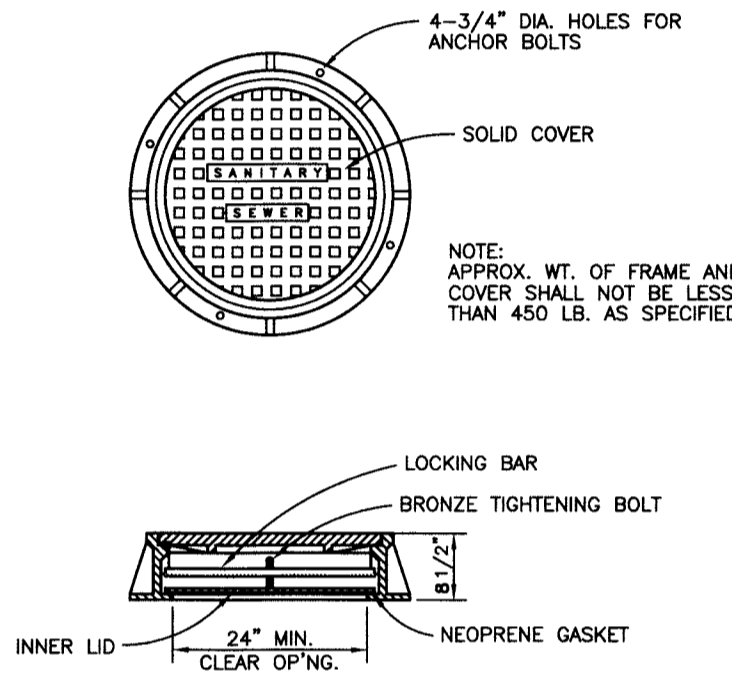


**WATERTIGHT FRAME & COVER**  
NOT TO SCALE

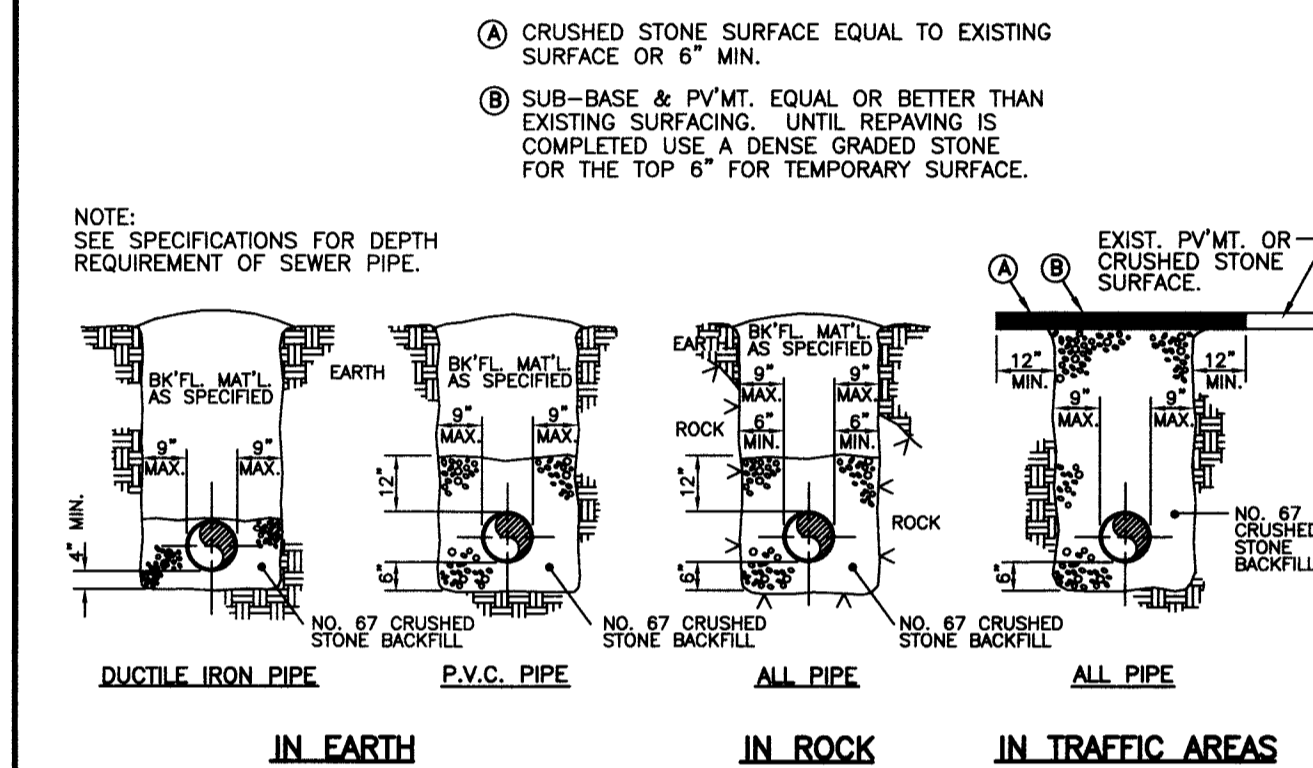


**STANDARD GRAVITY SEWER BEDDING AND BACKFILLING**  
NOT TO SCALE

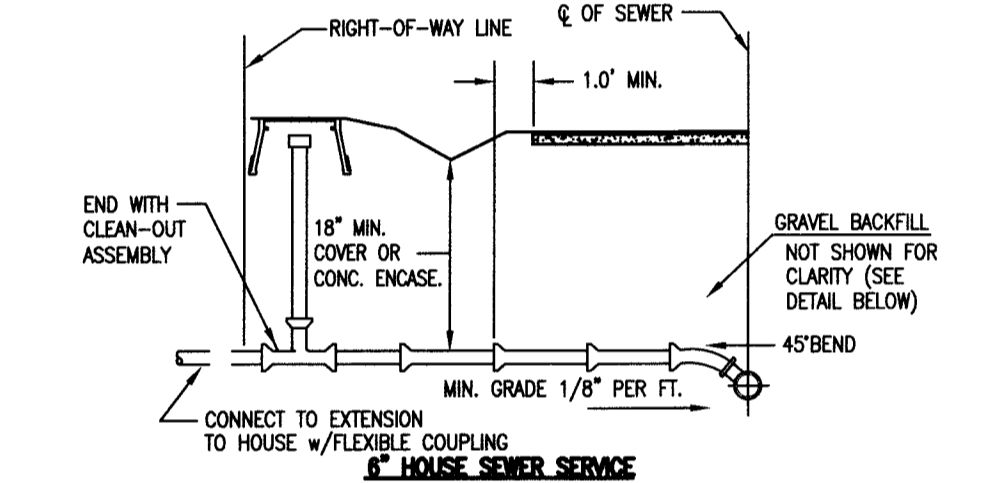


**SERVICE REPAIR DETAIL**  
NOT TO SCALE

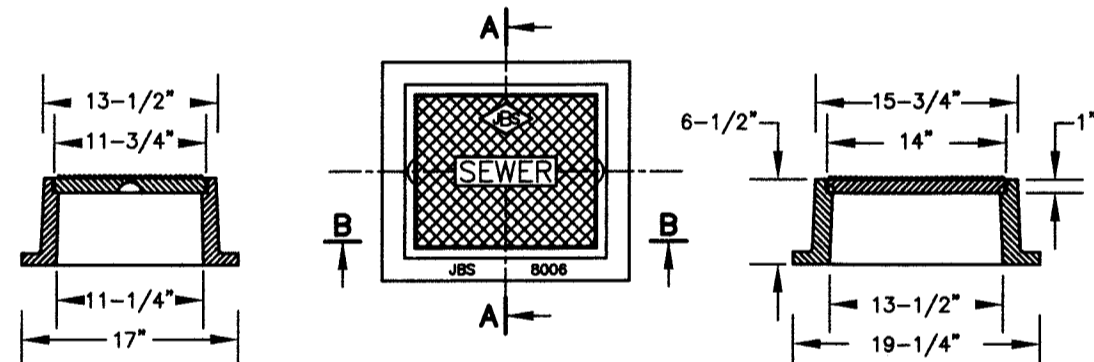


**TRAFFIC BEARING CLEANOUT BOX**  
NOT TO SCALE

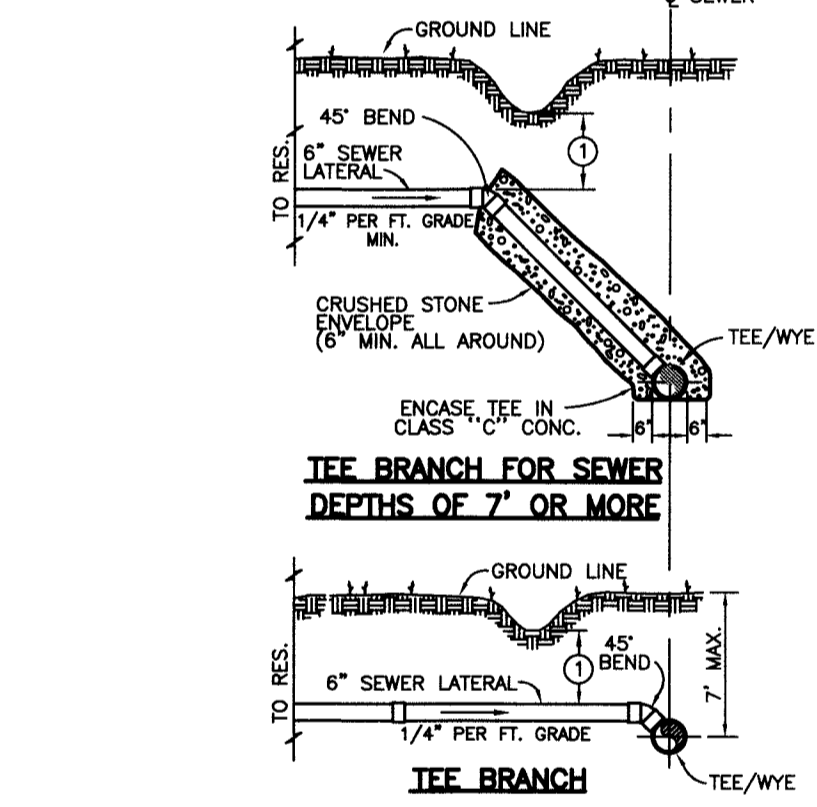


**SERVICE RECONNECTIONS AT POINT REPAIRS**  
NOT TO SCALE

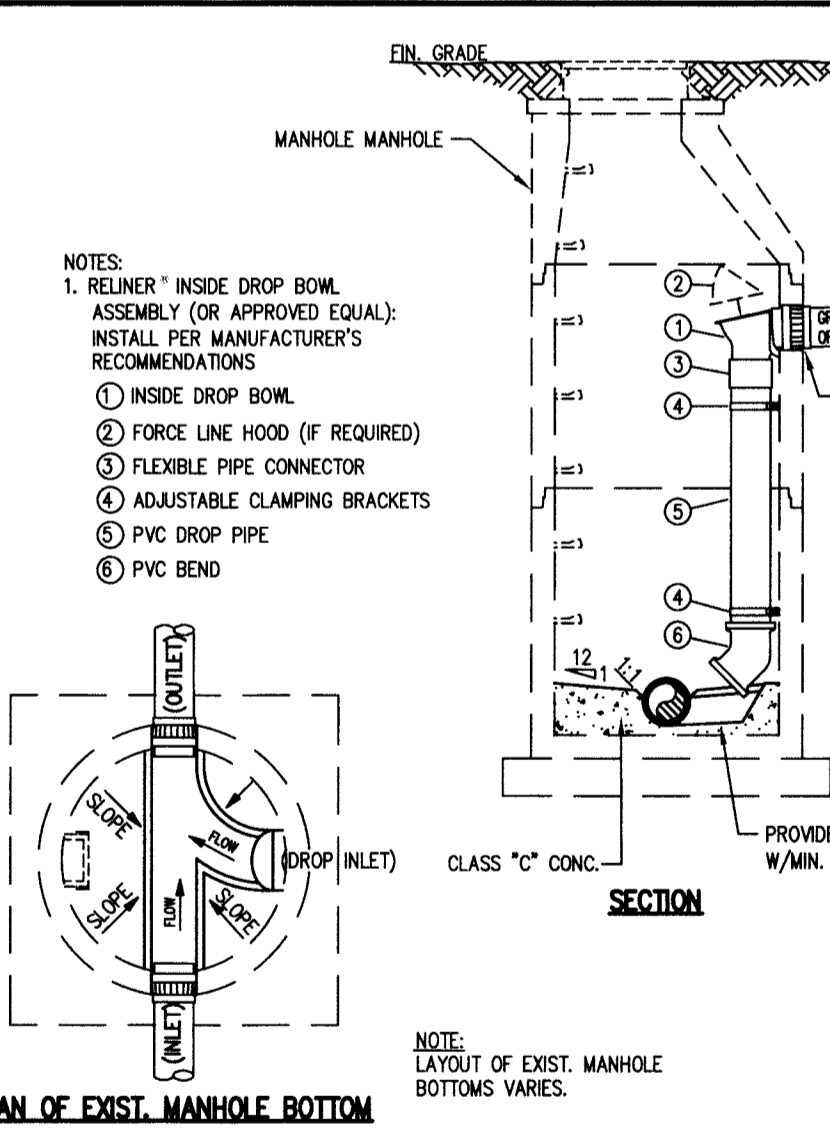


**INSIDE DROP AT EXISTING MANHOLE**  
NOT TO SCALE

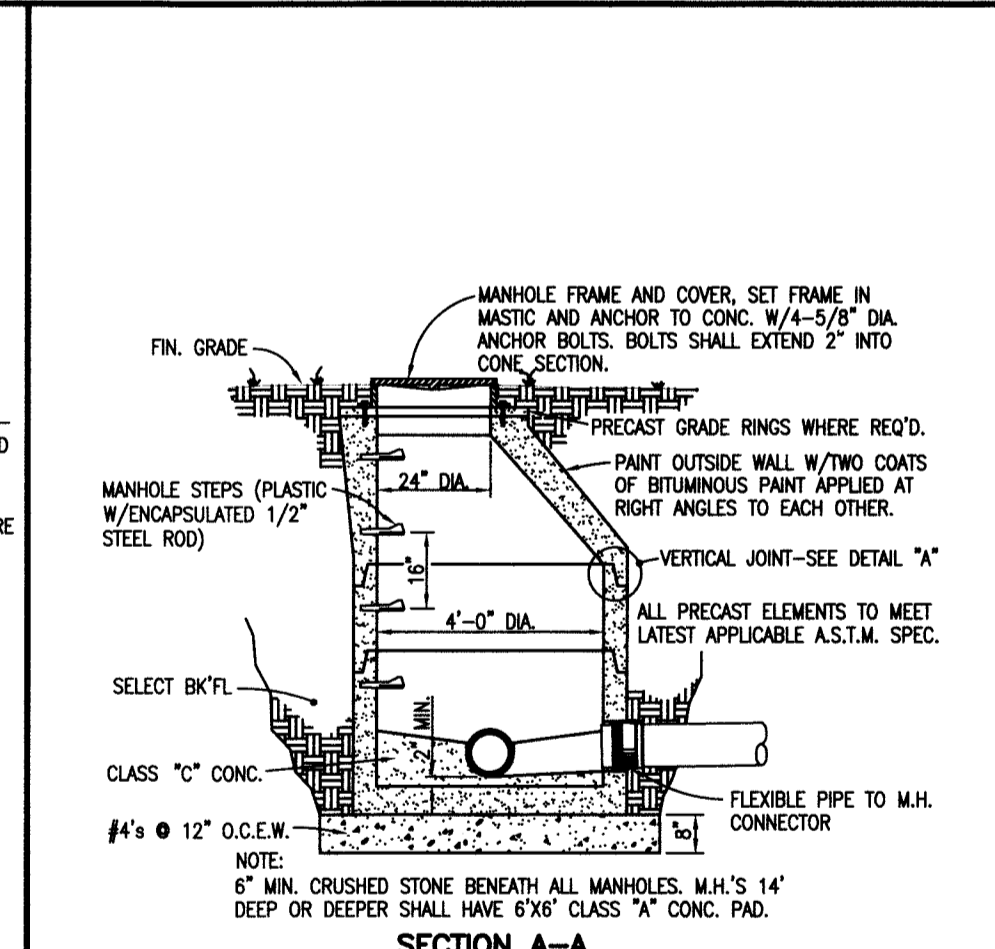


**STANDARD MANHOLE**  
NOT TO SCALE

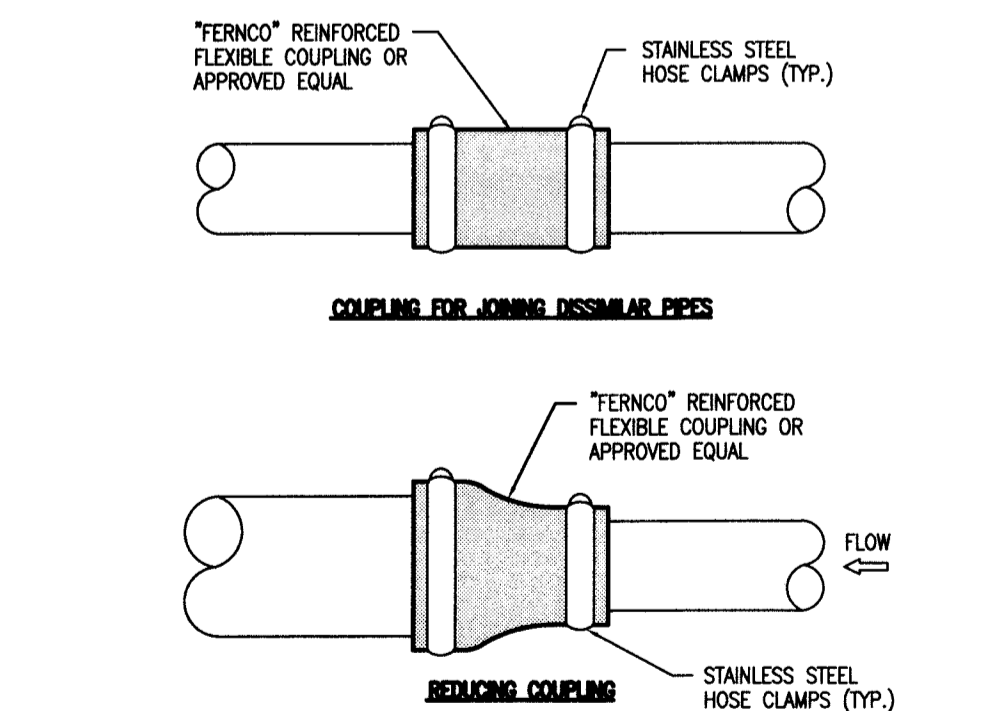


**FLEXIBLE COUPLING DETAIL**  
NOT TO SCALE

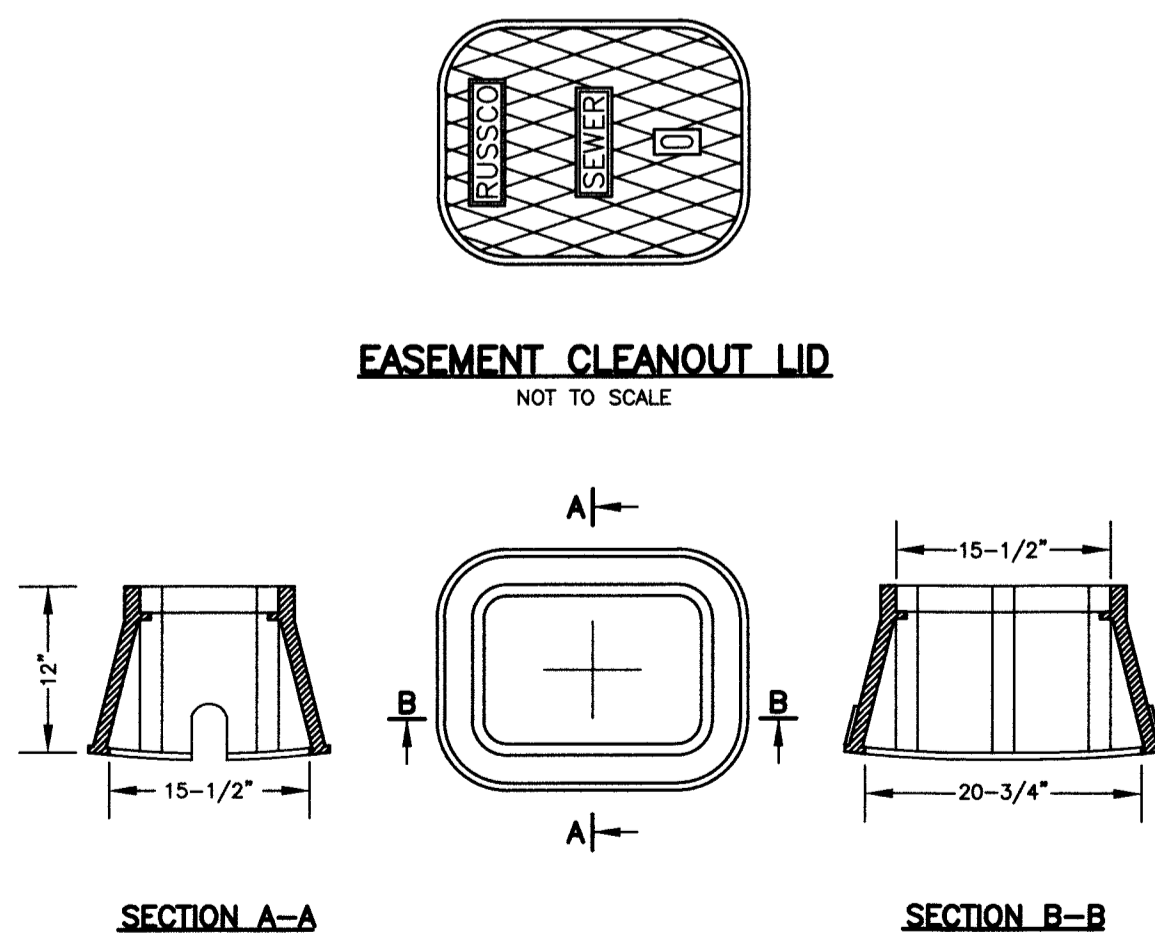


**EASEMENT CLEANOUT BOX**  
NOT TO SCALE

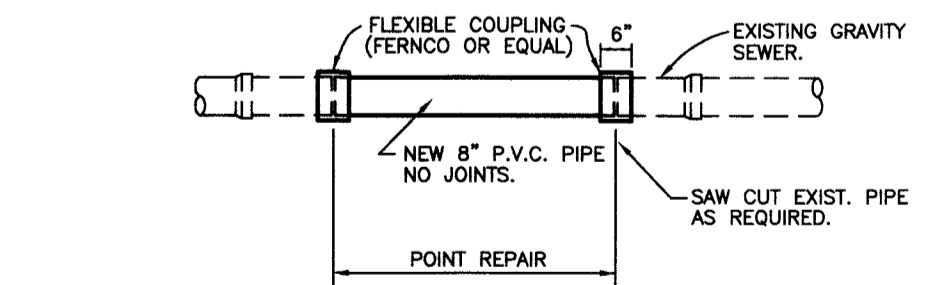

**POINT REPAIR DETAIL**  
NOT TO SCALE

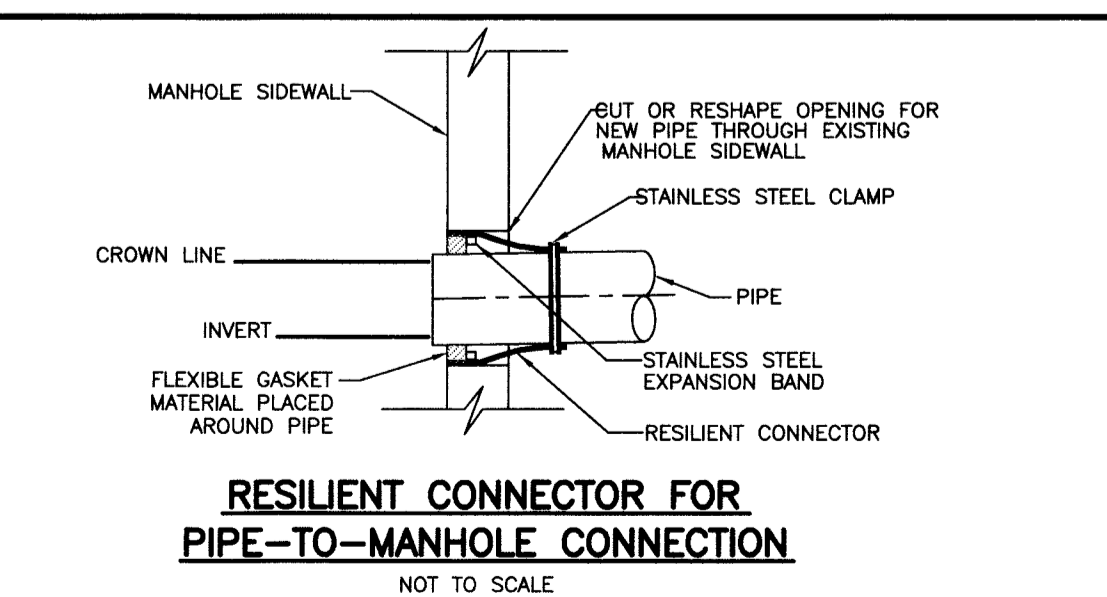

**RESILIENT CONNECTOR FOR PIPE-TO-MANHOLE CONNECTION**  
NOT TO SCALE

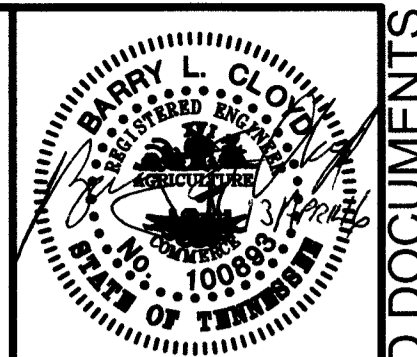

GRW PROJECT NO. 3849-07

**GRW**  
engineering | architecture | geospatial  
www.grwinc.com

**STANDARD SANITARY SEWER**  
2015 SEWER SYSTEM IMPROVEMENTS  
CITY OF LOBELVILLE, TENNESSEE

DESIGNED	BY	DATE	DESCRIPTION	NO.	REVISIONS	DATE	DESCRIPTION	NO.
BLC								
NA								
BLC								
BLC								

DATE: APRIL 2016  
SCALE: AS NOTED  
SHEET NO.

**C-07**

BID DOCUMENTS