		ESTIN
	ITEM NUMBER	


L.F. L.F. L.F. L.F. L.F. L.F. L.F. L.F. EACH EACH EACH EACH EACH EACH EACH EAC	QUANTITY 48 86 20 20 260 2,855 120 1 1 2 3 4 1 3 4 1 3 4 1 1 3 4
L.F. L.F. L.F. L.F. L.F. L.F. EACH EACH EACH EACH EACH EACH EACH EACH	20 20 260 2,855 120 1 1 2 3 4 1 3 4
L.F. L.F. L.F. L.F. L.F. EACH EACH EACH EACH EACH EACH EACH EACH	20 260 2,855 120 1 1 2 3 4 1 3 4 1 3 4
L.F. L.F. L.F. L.F. EACH EACH EACH EACH EACH EACH EACH EACH	20 260 2,855 120 1 1 2 3 4 1 3 4 2 3 4
L.F. L.F. L.F. L.F. EACH EACH EACH EACH EACH EACH EACH EACH	20 260 2,855 120 1 1 2 3 4 1 3 4 2 3 4
L.F. L.F. L.F. EACH EACH EACH EACH EACH EACH EACH EACH	260 2,855 120 1 1 2 3 4 1 3 4 2 3 4
L.F. L.F. EACH EACH EACH EACH EACH EACH EACH EAC	2,855 120 1 1 2 3 4 1 3 4 1 3 4 1 1 1 1 1 1 1 1 1 1 1 1
EACH EACH EACH EACH EACH EACH EACH EACH	120 1 1 2 3 4 1 3 4 1 3 4 1 1 1 1 1 1 1 1 1 1 1 1
EACH EACH EACH EACH EACH EACH EACH EACH	1 2 3 4 1 3 4 2 3 4
EACH EACH EACH EACH EACH EACH EACH EACH	1 2 3 4 1 3 4 2 3 4
EACH EACH EACH EACH EACH EACH EACH EACH	2 3 4 1 3 4 2 3 4
EACH EACH EACH EACH EACH EACH EACH EACH	3 4 1 3 4 2 3 4
EACH EACH EACH EACH EACH EACH EACH EACH	4 1 3 4 2 3 4
EACH EACH EACH EACH EACH EACH EACH EACH	1 3 4 2 3 4
EACH EACH EACH EACH EACH EACH EACH EACH	3 4 2 3 4
EACH EACH EACH EACH EACH EACH	4 2 3 4
E EACH E EACH VE EACH EACH	2 3 4
E EACH VE EACH EACH	3 4 1
VE EACH EACH	1
EACH	1
EACH	
	1
EACH	14
L.F.	716
L.F.	991
EACH	2
EACH	1
EACH	
	6
L.F.	3,023
L.S.	1
LBS	7,000
OD L.F.	38
OD L.F.	35
	EACH L.F. L.S. LBS OD L.F.

UTILITIES INDEX

SHEET NUMBER	SHEET NAME					
U2-1	QUANTITIES, INDEX AND PROJECT LOCATION MAP					
U2-2	PLAN VIEW LOCATION "E"- STA. 420+25 TO STA. 422+00					
U2-3	PLAN VIEW LOCATION "E" - STA. 422+00 TO STA. 430+65					
U2-4	PLAN VIEW LOCATION "H" - STA. 715+40 TO STA. 724+00					
U2-5	PLAN VIEW LOCATION "H" - STA. 724+00 TO STA. 733+15					
U2-6	PLAN VIEW LOCATION "K" - STA. 900+00 TO STA. 911+00					
U2-7	PLAN VIEW LOCATION "K" - STA. 911+00 TO STA. 923+00					
U2-8	PLAN VIEW LOCATION "K" - STA. 923+00 TO STA. 931+95					
U2-9	CROSS-SECTION - BEGIN: STA. 420+00 TO END: STA. 422+00					
U2-9B	CROSS-SECTION - BEGIN: STA. 422+50 TO END: STA. 424+50					
U2-10	CROSS-SECTION - BEGIN: STA. 427+50 TO END: STA. 429+50					
U2-11	CROSS-SECTION - BEGIN: STA. 430+00 TO END: STA. 430+50					
U2-12	CROSS-SECTION - BEGIN: STA. 716+50 TO END: STA. 718+00					
U2-13	CROSS-SECTION - BEGIN: STA. 718+50 TO END: STA. 720+00					
U2-14	CROSS-SECTION - BEGIN: STA. 724+50 TO END: STA. 726+00					
U2-14B	CROSS-SECTION - BEGIN: STA. 728+50 TO END: STA. 730+00					
U2-15	STANDARD WATER LINE CONSTRUCTION DETAILS					
U2-16	U2-16 STANDARD WATER LINE CONSTRUCTION DETAILS					
110 47	LIG 47 CTANDADD EDOCION CONTDOL DETAILS					

TYPE	YEAR	PROJECT NO.	SHEET NO.
CONST.	2020	68001-3251-14	U2-1
S.R. 13	S.R. 13 PERRY CO.		

PERRI CO.

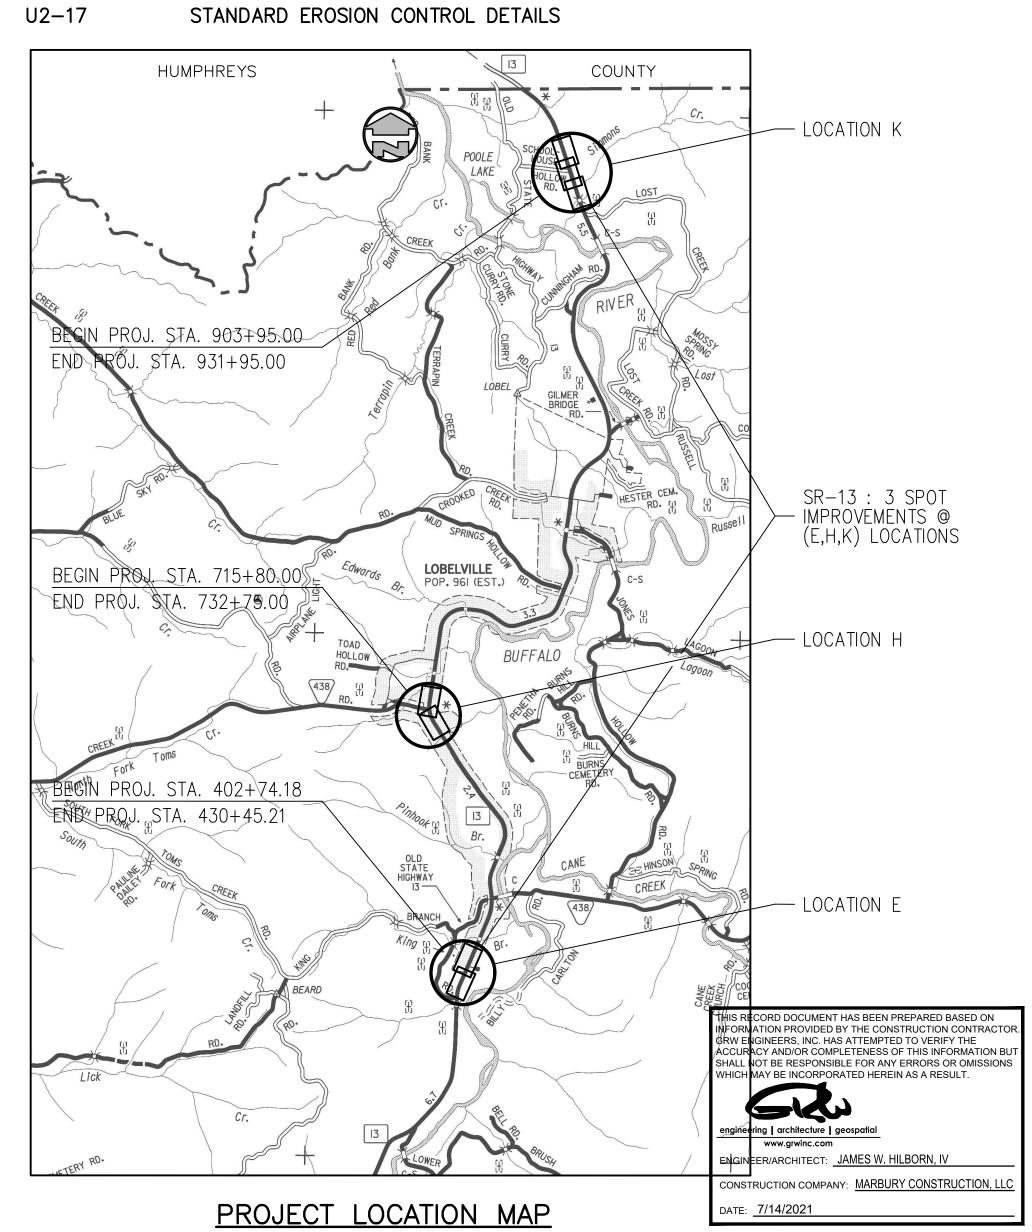

SCALE: 1" = 1 MILE

This document, originally issued, sealed and signed by James W. Hilborn, IV, Engineer No. 16514, on July 11, 2019, shall not be used in lieu of a certified document.

THIS MARK SHOULD MEASURE EXACTLY 1" WHEN PLOTTED				
ALL RIGHTS RESERVED: THIS DOCUMENT IS THE PROPERTY OF GRW ENGINEERS, INC. AND SHALL NOT B REPRODUCED IN WHOLE OR IN PART OR USED FOR CONSTRUCTION OF OTHER T THIS SPECIFIC PROJECT WITHOUT WRITTEN PERMISSION OF GRW ENGINEERS, INC.				
DATE:				
JULY 2019				
REVISION DATE:				
SCALE:				
1" = 50'				
PROJECT NO.				
3827-09				





CITY OF LOBELVILLE S.R. 13 WATER RELOCATIONS

WATER RELOCATIONS QUANTITIES

SCALE: 1" = 50'