

<div> <div>TENNESSEE D.O.T.</div> <div>DESIGN DIVISION</div> <div>FILE NO.</div> </div>

TYPE	YEAR	PROJECT NO.	SHEET NO.
CONST.	2020	68001-3251-14	U2-2

S.R. 13 PERRY CO.


03-03-14: UPDATED PROP. R.O.W. STA. 418+35.82, OFFSET
72.83' RT. FLAG.
ADDED Z BAR TO TRACT NO. 54.

07-11-14: UPDATED TRACT NO. 49 PROPERTY OWNER NAME.
UPDATED STRUCTURE TYPES ON TRACT NOS.
54 AND 56.

04-15-15: SHIFTED S.R. 13 ALIGNMENT.

08-24-16; UPDATED TRACT NO, 51 PROPERTY OWNER NAME.

04-20-17: UPDATED PRES. R.O.W. LINES AND PROPERTY LINES
ON TRACT NOS. 48 AND 49.
TRACT NO. 48 IS NOW ON THIS SHEET.

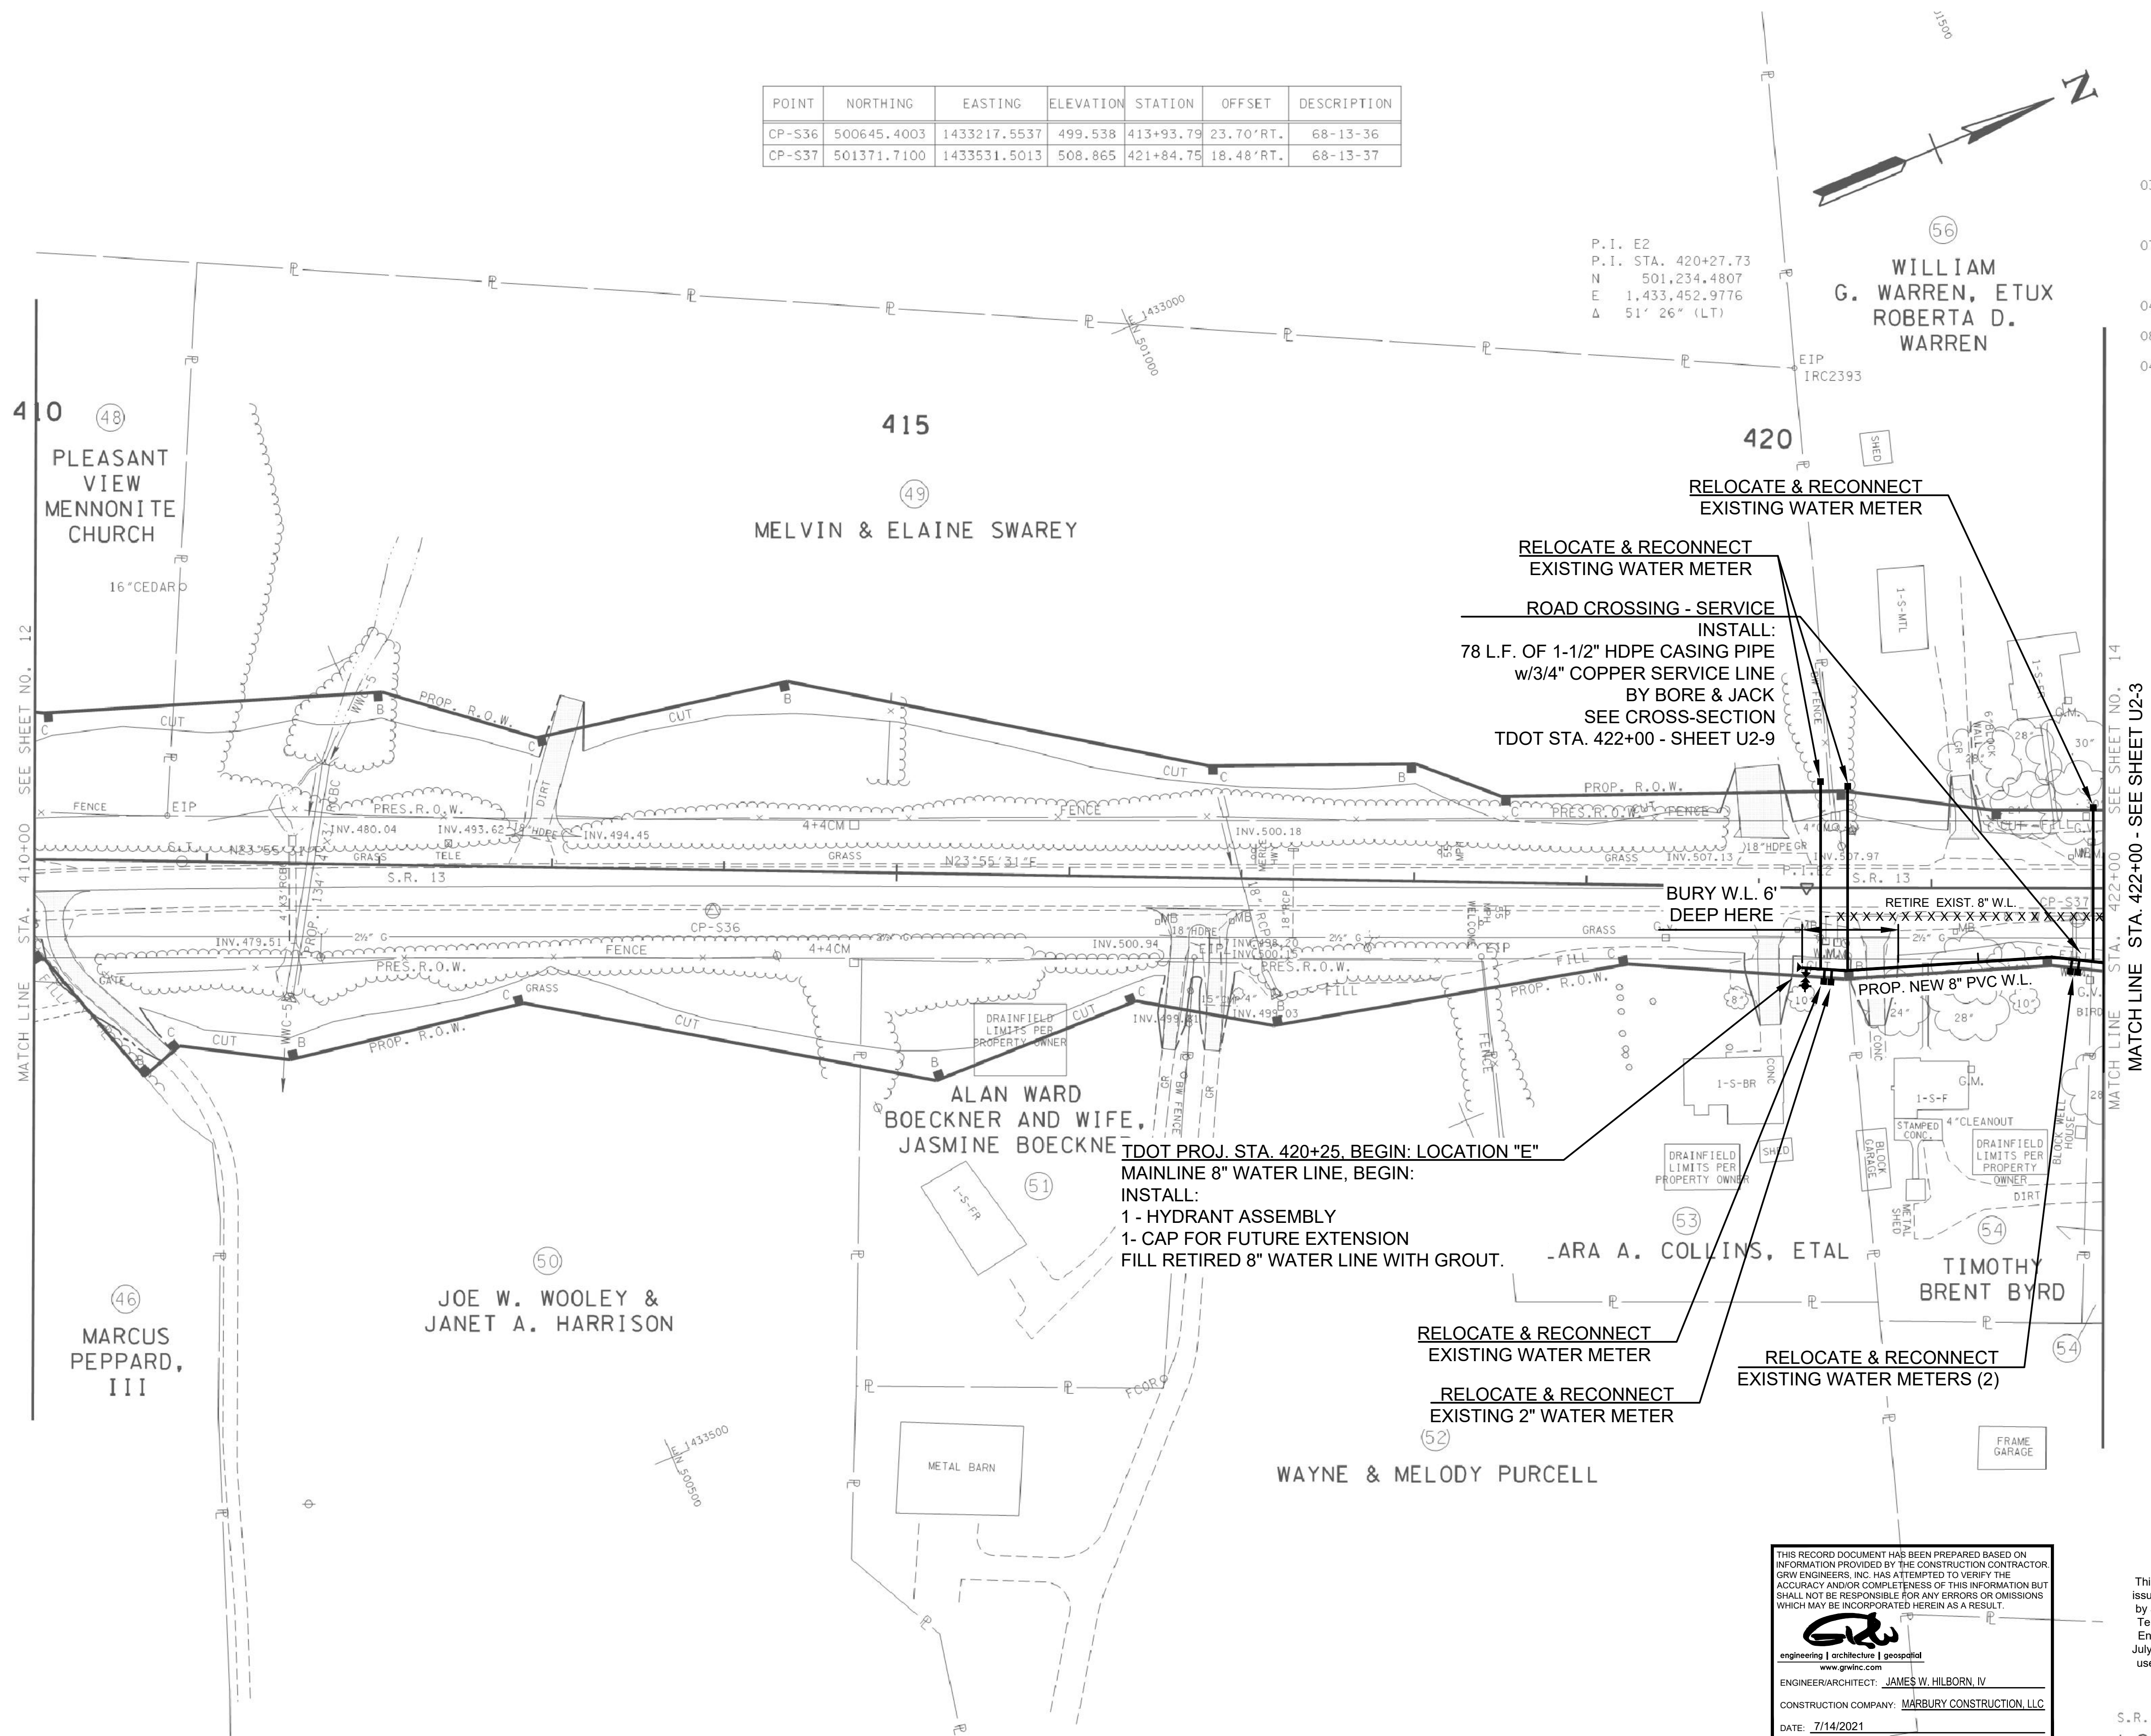

0 30 1 37 10 770 00.771 3.410 74113 110 13.41

DRAWING SCALE CHECK:		THIS MARK SHOULD MEASURE EXACTLY 1" WHEN PLOTTED
<p>ALL RIGHTS RESERVED: THIS DOCUMENT IS THE PROPERTY OF GWM ENGINEERS, INC. AND SHALL NOT BE REPRODUCED IN WHOLE OR IN PART OR USED FOR CONSTRUCTION OF OTHER THAN THIS SPECIFIC PROJECT WITHOUT WRITTEN PERMISSION OF GWM ENGINEERS, INC.</p>		
DESIGNED:	DATE:	
JWH	JULY 2019	
DRAWN:	REVISION DATE:	
DM		
REVIEWED:	SCALE:	
JWH	1" = 50'	
APPROVED:	PROJECT NO.	
JWH	3827-09	



CITY OF LOBELVILLE
S.R. 13 WATER RELOCATIONS

WATER RELOCATIONS

STA. 420+25 TO 422+00

SCALE: 1" = 50'

PRINTED: 7/15/2021 @ 7:45AM
FILE NAME: C:\3827-Lobelville\09-SR 13 Reloc\Working Drawings\Lobelville Funded\AutoCAD\3827-09-1345_U2-02-03-E.dwg