


TENNESSEE D.O.T.
DESIGN DIVISION
FILE NO.

TYPE	YEAR	PROJECT NO.	SHEET NO.
CONST.	2020	68001-3251-14	U2-11

S.R. 13	PERRY CO.
---------	-----------

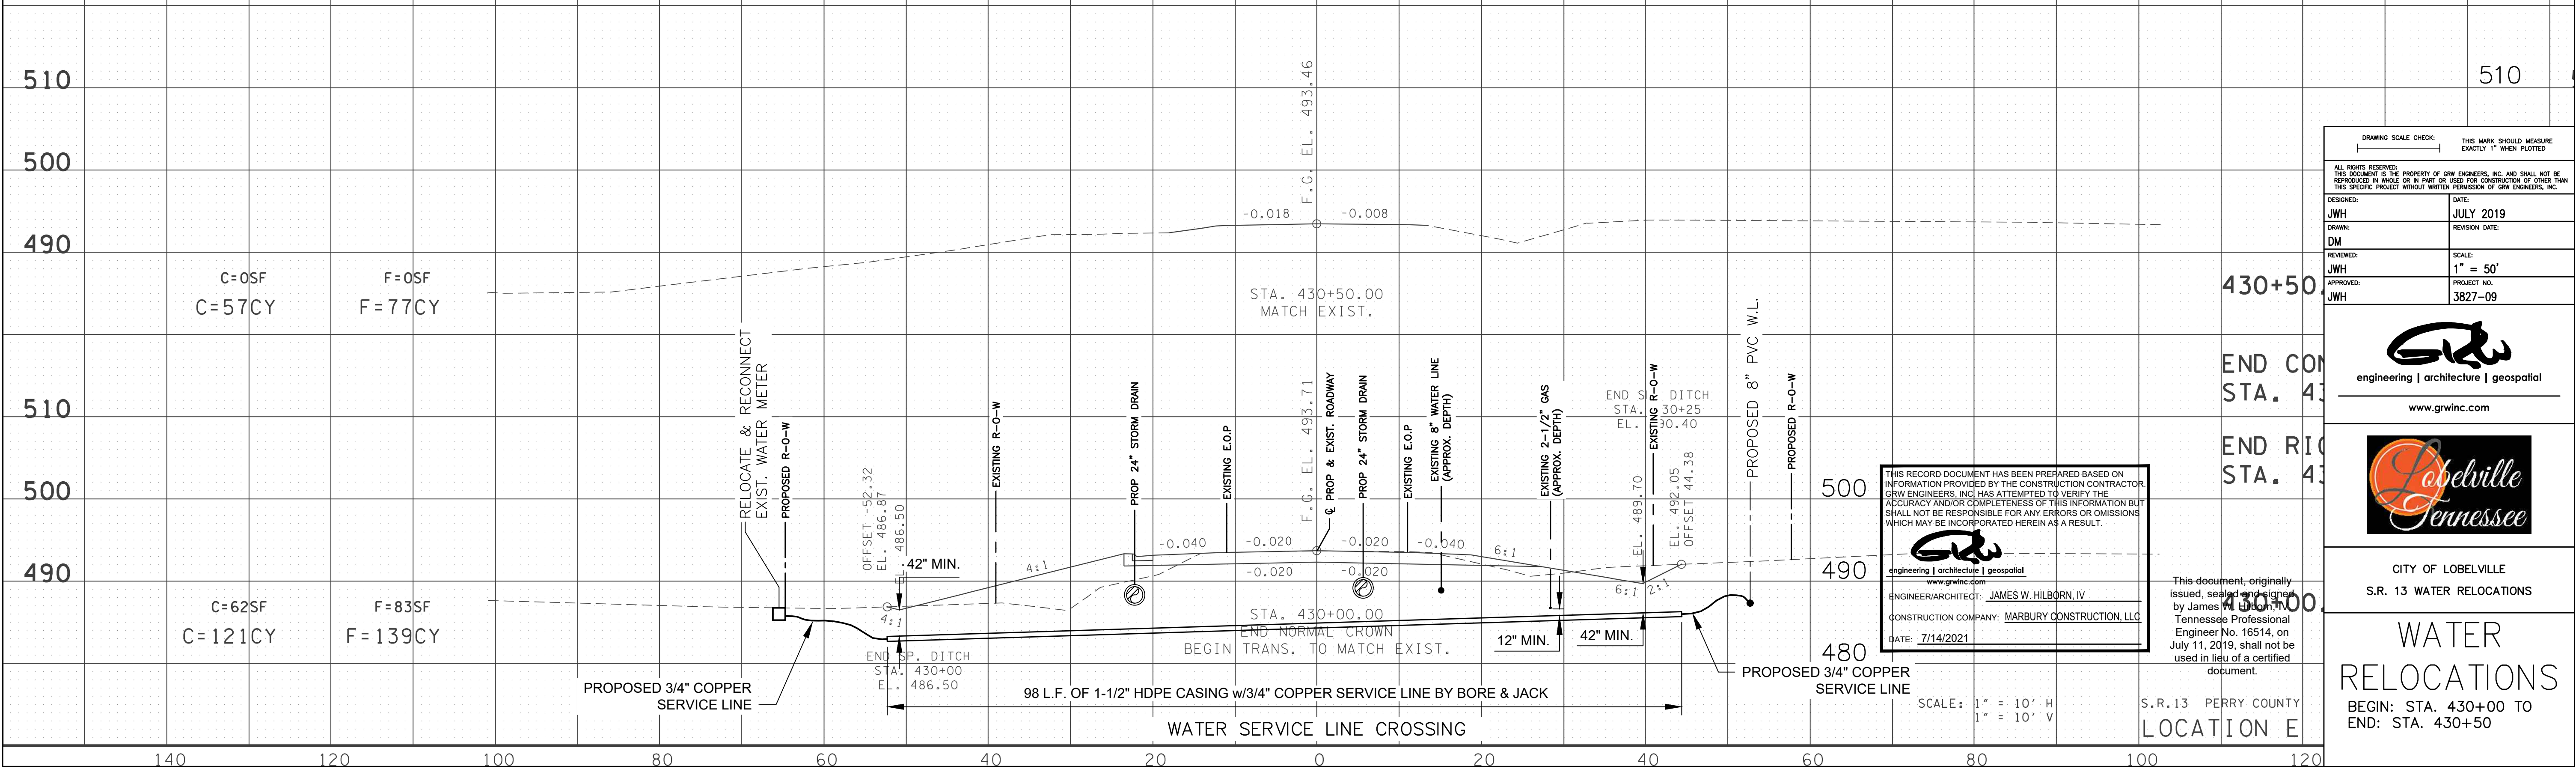

DRAWING SCALE CHECK:		THIS MARK SHOULD MEASURE EXACTLY 1" WHEN PLOTTED	
<p>ALL RIGHTS RESERVED: THIS DOCUMENT IS THE PROPERTY OF JGW ENGINEERS, INC. AND SHALL NOT BE REPRODUCED IN WHOLE OR IN PART OR USED FOR CONSTRUCTION OF OTHER THAN THIS SPECIFIC PROJECT WITHOUT WRITTEN PERMISSION OF JGW ENGINEERS, INC.</p>			
DESIGNED:	JWH	DATE:	JULY 2019
DRWN:	JWH	REVISION:	DATE:
REVIEWED:	JWH	SCALE:	1" = 50'
APPROVED:	JWH	PROJECT NO.	3827-09



This document, originally issued, sealed and signed by James W. Hilborn, Tennessee Professional Engineer No. 16514, on July 11, 2019, shall not be used in lieu of a certified document.

CITY OF LOBELVILLE
S.R. 13 WATER RELOCATIONS

WATER RELOCATIONS

BEGIN: STA. 430+00 TO
END: STA. 430+50