


<p>THIS RECORD DOCUMENT HAS BEEN PREPARED BASED ON INFORMATION PROVIDED BY THE CONSTRUCTION CONTRACTOR. GSW ENGINEERS, INC. HAS ATTEMPTED TO VERIFY THE ACCURACY AND COMPLETENESS OF THIS INFORMATION BUT SHALL NOT BE RESPONSIBLE FOR ANY ERRORS OR OMISSIONS WHICH MAY BE INCORPORATED HEREIN AS A RESULT.</p>		
		
<p>engineering architecture geospatial www.gswinc.com</p>		
<p>ENGINEER/ARCHITECT: JAMES V. HILBORN, IV</p>		
<p>CONSTRUCTION COMPANY: <u>MARBURY CONSTRUCTION, LLC</u></p>		
<p>DATE: 7/14/2021</p>		

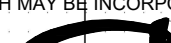