

EXISTING	NEW
	♦ ▶ 4 ▶ 1
소 [MM]	
	M
— — <u>又</u> — — — _ 凸	
— →>— — □ = = □	
	──// ⊑─ ──// ⊫ ─
 ⊗	
 Ø	ب
Ø	, S
ø→ ¢	
<u>SIGN</u>	
\odot	
——————————————————————————————————————	
— — SD— —	
— <u> </u>	
— — — —	
<u> </u>	xx
27-55	
۲	
∎ ∎P	

LEGEND

WATER LINE	1.	THE SMAI LIGH
WATER SERVICE LINE		AND
CASING PIPE		SHU TO T
CONC. ENCASEMENT/CREEK CROSSING		THE CON ^T
VALVE	2.	WHE
WATER METER	۷.	SAID
FIRE HYDRANT		ΑΤ Τ
BLOW OFF ASSEMBLY	3.	THE AN
MANUAL AIR BLEED VALVE		THE
MASTER METER		ANY
AIR RELEASE/AIR VACUUM VALVE		TO E BEFC
FLOW METER		τr
PRESSURE REDUCING VALVE		TE 1-
TEST METER BY-PASS		<u>72</u>
REDUCER	4.	
CULVERT PIPE		NOTE OPEF
EXIST. WATER LINE TO BE ABANDONED	5.	CON
CUT & CAP EXISTING LINE	0.	DEVI
CUT & PLUG EXISTING LINE	6.	CON
GAS LINE		FIRE WATE
GAS VALVE	7.	IF AI
UNDERGROUND TELEPHONE LINE	1.	DETE
TELEPHONE PEDESTAL		WITH BE E
UNDERGROUND ELECTRIC LINE	8.	SUFF
POWER POLE	0.	TO N
GUY POLE		SILT, POLL
LIGHT POLE		INTO MEAS
MAIL BOX		FEDE
SIGN		SOLE ARE
TREE		DOES OF T
UNDERGROUND CABLE TV		PERI
STORM DRAIN LINE		
STORM DRAIN DROP INLET	q	
HEADWALL OR INLET WALL	9.	THE COOF
CREEK OR DITCH		TO E
FENCE ROW		PERI
PROPERTY LINE/RIGHT OF WAY		AS L AS S
PARCEL NUMBER	10.	THE
PROPERTY CORNER	101	FEDE
IRON PIN		HIGH
	11.	STA1 OF 1
		QUES
		SHOL STA1
	12.	PROF
		COUI
	1 3	\// A TE

GENERAL NOTES

CONTRACTOR SHALL RESTORE ALL CULVERTS, FENCES, WALLS, ALL ORNAMENTAL TREES, CULTIVATED SHRUBS, FLOWERS, SIGNS, HTS AND POWER POLES, STREET MARKERS, MAIL BOXES, WATER GAS LINES. WATER AND GAS METERS AND BOXES INCLUDING JT-OFFS, AND LAWNS DISTURBED BY CONSTRUCTION OPERATIONS THEIR ORIGINAL CONDITIONS.

COST OF THIS WORK SHALL BE MERGED IN THE UNIT BID AND ITRACT PRICES FOR THE PROPOSED WORK.

ERE IN EASEMENTS THE CONTRACTOR SHALL PROTECT AND RESTORE D PROPERTY TO CONDITION SIMILAR OR EQUAL TO THAT EXISTING THE COMMENCEMENT OF CONSTRUCTION, EXCEPT AS NOTED.

E LOCATION OF EXISTING UNDERGROUND UTILITIES ARE SHOWN IN APPROXIMATE WAY ONLY. THE CONTRACTOR SHALL DETERMINE EXACT LOCATION OF ALL EXISTING UTILITIES BEFORE COMMENCING RK IN EACH AREA. HE AGREES TO BE FULLY RESPONSIBLE FOR AND ALL DAMAGES WHICH MIGHT BE CAUSED BY HIS FAILURE EXACTLY LOCATE AND PRESERVE ANY AND ALL UTILITIES. ORE CONSTRUCTION, CONTRACTOR SHALL CONTACT :

TENNESSEE ONE CALL SYSTEM 1-800-351-1111 72 HOURS NOTICE

NTRACTOR SHALL CUT & CAP EXISTING WATER LINES AT LOCATIONS TED ON PLANS OR AS DIRECTED BY ENGINEER AFTER NEW LINE IS IN ERATION & THE EXISTING HOUSE SERVICES HAVE BEEN RECONNECTED.

NTRACTOR SHALL NOT PLACE ANY VALVES OR OTHER ABOVE GRADE /ICES IN ANY DITCH LINE ON STATE HIGHWAY RIGHT OF WAY.

NTRACTOR SHALL RECONNECT ALL EXISTING WATER METERS & HYDRANTS SHOWN ON PLANS & NOTED BY ENGINEER AFTER NEW TER LINE IS IN OPERATION.

ANY EXISTING STORM SEWERS ARE SUBSTANTIALLY DAMAGED AS FERMINED BY THE A/E AND OR OWNER, THE REPAIR SHALL BE MADE H R.C.P. PIPE FROM STRUCTURE-TO-STRUCTURE. PIPE SIZE SHALL EQUAL TO EXISTING.

FFICIENT PRECAUTIONS SHALL BE TAKEN DURING CONSTRUCTION MINIMIZE THE RUN-OFF OF POLLUTING SUBSTANCES SUCH AS T, CLAY, FUELS, OILS, BITUMENS, CALCIUM CHLORIDE, OR OTHER LUTING MATERIALS HARMFUL TO HUMANS, FISH OR OTHER LIFE, O THE SUPPLIES AND SURFACE WATERS OF THE STATE. CONTROL ASURES MUST BE ADEQUATE TO ASSURE THAT LOCAL, STATE AND DERAL LAWS AND REGULATIONS ARE MET. THE CONTRACTOR IS LELY RESPONSIBLE FOR ENSURING THAT THE LAWS AND REGULATIONS MET AND IS RESPONSIBLE FOR ENSURING THAT CONSTRUCTION ES NOT HARM THE WATERS OF TENNESSEE. THE PROTECTION THE SITE SHALL CONTINUE THROUGHOUT THE CONSTRUCTION RIOD. SPECIAL PRECAUTIONS SHALL BE TAKEN IN THE USE OF NSTRUCTION EQUIPMENT TO PREVENT OPERATIONS WHICH DMOTE EROSION.

TEMPORARY POLLUTION CONTROL PROVISIONS SHALL BE ORDINATED WITH THE PERMANENT EROSION CONTROL MEASURES. ENSURE ECONOMICAL, EFFECTIVE, AND CONTINUOUS EROSION NTROL THROUGHOUT THE CONSTRUCTION AND POST-CONSTRUCTION RIOD OF THE PROJECT. NATURAL COVER SHOULD BE MAINTAINED LONG AS POSSIBLE AND GRADED AREAS SHOULD BE STABILIZED SOON AS POSSIBLE.

CONTRACTOR SHALL OBTAIN ALL PERMITS FROM THE APPROPRIATE DERAL, STATE, COUNTY AND/OR LOCAL AGENCIES TO CROSS ALL HWAYS, STREETS, STREAMS, EASEMENTS, ETC...


ATE HIGHWAY RIGHT-OF-WAY INFORMATION PROVIDED BY THE STATE TENNESSEE DEPARTMENT OF TRANSPORTATION. ESTIONS CONCERNING R-O-W LOCATION ON ANY STATE HIGHWAY OULD BE REFERRED TO THE APPROPRIATE REGIONAL OFFICE OF THE ATE OF TENNESSEE DEPARTMENT OF TRANSPORTATION:

OPERTY OWNERS AND PARCEL INFORMATION PROVIDED BY THE JNTY REGISTRAR OF DEEDS.

13. WATER LINE INFORMATION PROVIDED BY THE UTILITY DISTRICT.

14. COUNTY ROAD RIGHT-OF-WAY INFORMATION PROVIDED BY THE COUNTY HIGHWAY DEPT.

QUESTIONS CONCERNING R-O-W LOCATION ON ANY COUNTY ROAD SHOULD BE REFERRED TO THE COUNTY HIGHWAY DEPARTMENT.

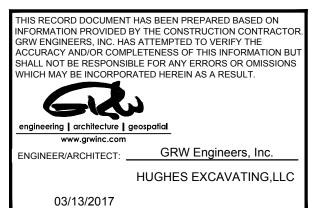

This document, originally issued, sealed, and signed by Barry L. Cloyd, Tennessee Professional Engineer, No. 100893, on December 14, 2015, shall not be used in lieu of a certified document.							ed I n	
				ALL RIGHTS RESERVED:	THIS DOCUMENT IS THE PROPERTY OF GRW ENGINEERS, INC. AND SHALL NOT DE DEPORATIOED IN MUCH E OD IN DADT		UTHEN THAN THIS SPECIFIC PROJECT WITHOUT WRITTEN PERMISSION	
					ENGINEERS - ARCHITECTS - PLANNERS		www.grwinc.com	
VICINITY MAP, LEGEND AND GENERAL NOTES			ROAN & CROOKED CREEK RDS. WATER LINE EXTENSIONS CDBG CONTRACT NO. 2737 PERRY COUNTY, TENNESSEE					
DESIGNED:	BLC	DRAWN:	DM	REVIEWED:	BLC	APPROVED:	BLC	
REVISIONS	NO. DESCRIPTION DATE BY						SCALE CHECK: HIS MARK SHOULD MEASURE EXACTLY 1" WHEN PLOTTED	
SCA	NU		RY 2	201	5			
	ET NC							
		L]-	U	/			1