



PRINTED: 5/11/2017 @ 1:30PM

FILE NAME: G:\4349-Perry Co\01-Road Crooked\Working Drawings\AutoCAD\Design Drawings - As Buid\02_4349-01-C-02_C-04.dwg

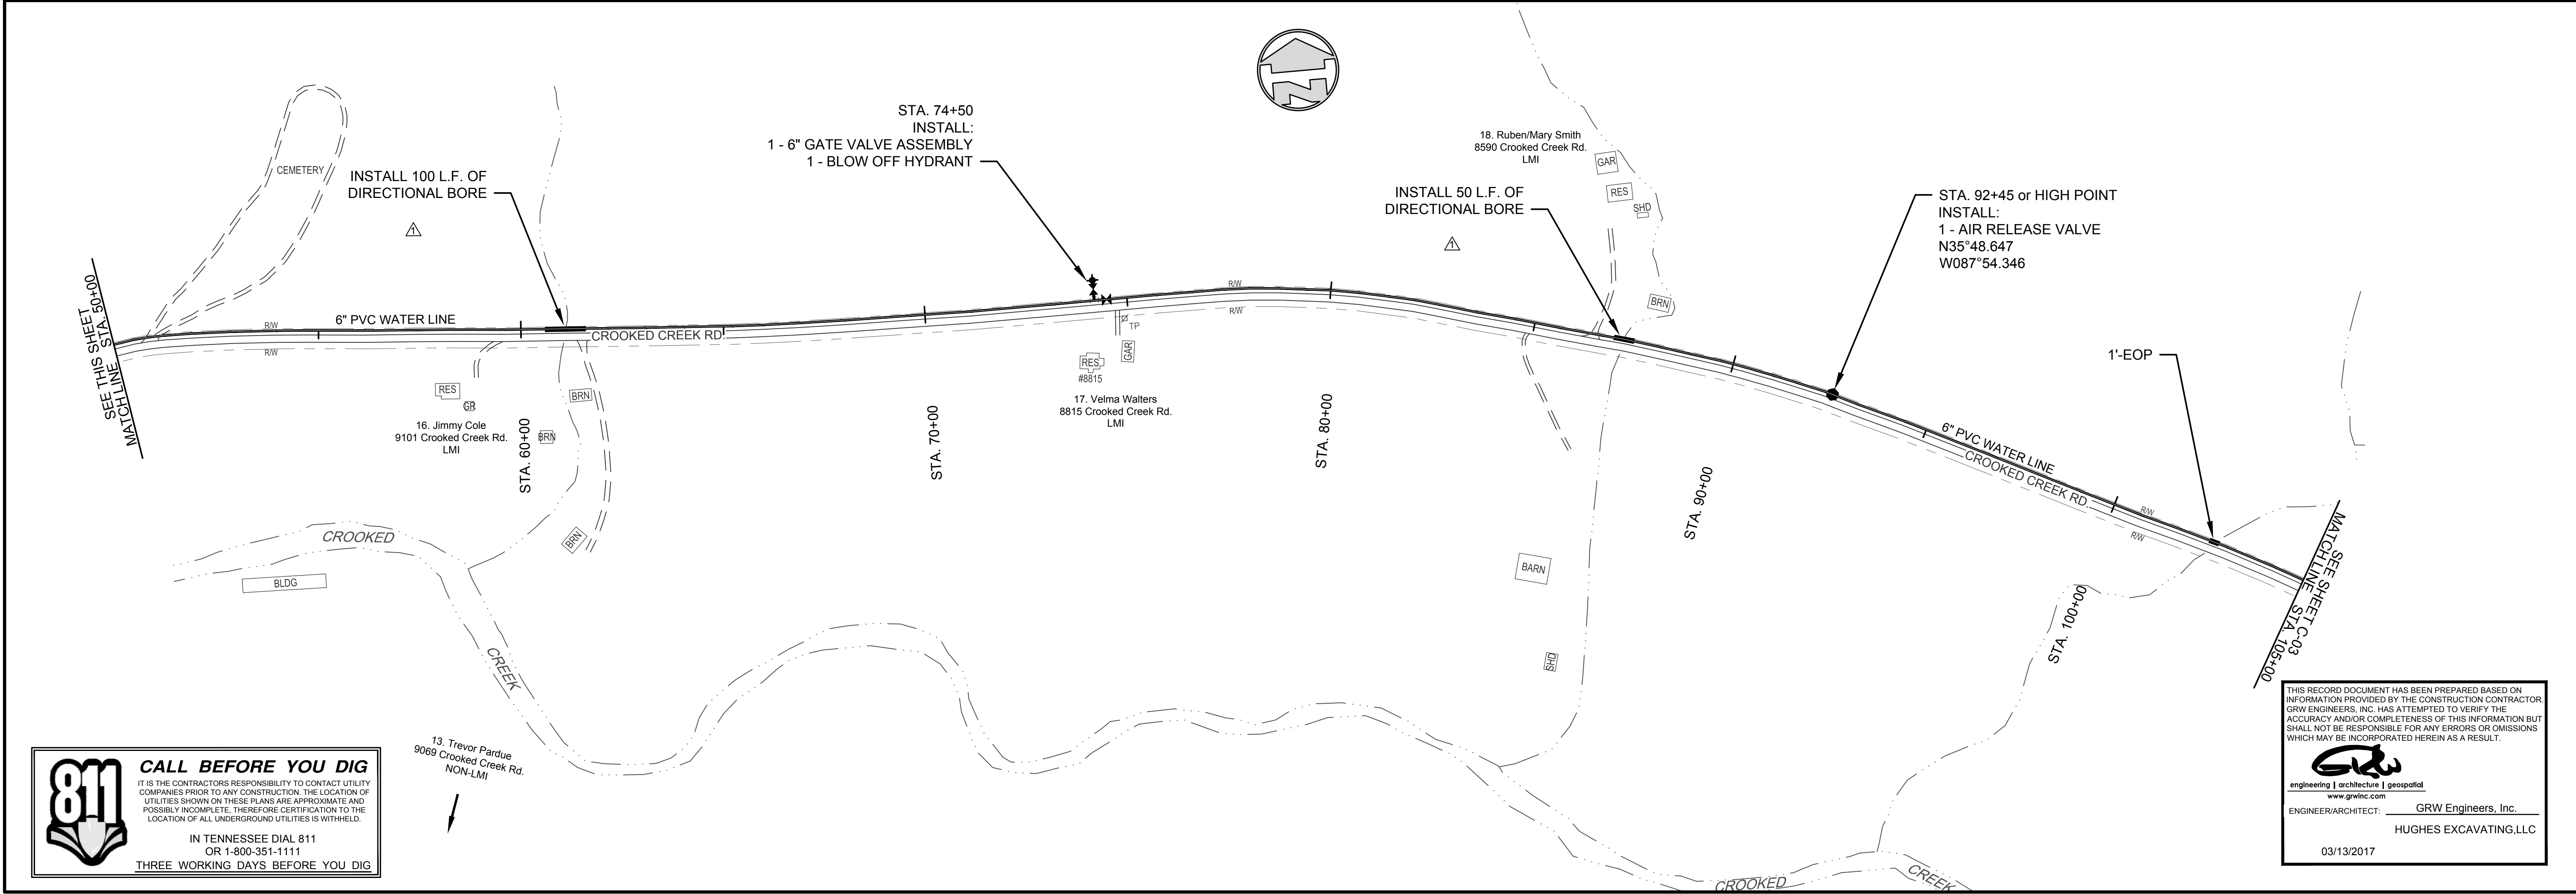

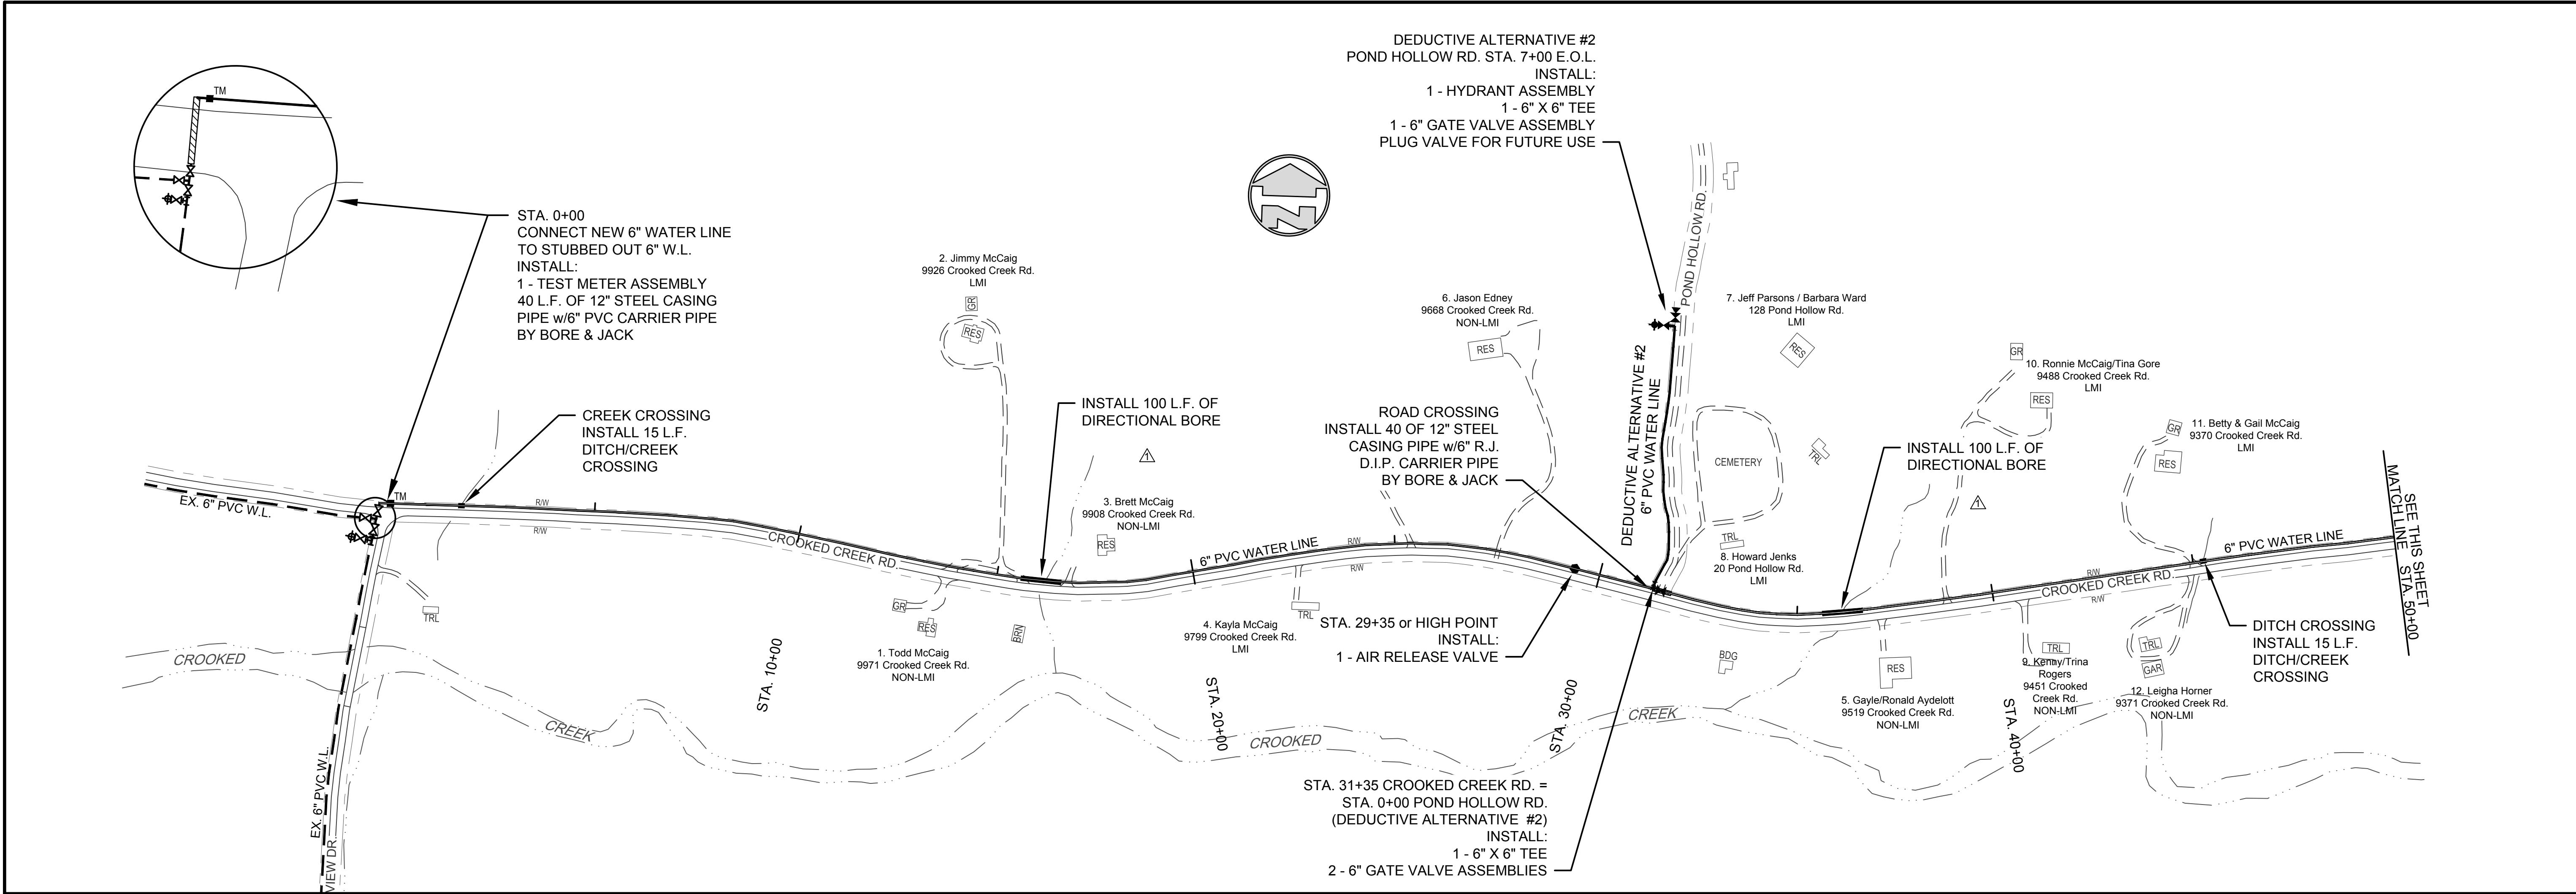

CALL BEFORE YOU DIG

IT IS THE CONTRACTOR'S RESPONSIBILITY TO CONTACT UTILITY COMPANIES PRIOR TO ANY CONSTRUCTION. THE LOCATION OF UTILITIES SHOWN ON THESE PLANS ARE APPROXIMATE AND POSSIBLY INCOMPLETE. THEREFORE CERTIFICATION TO THE LOCATION OF ALL UNDERGROUND UTILITIES IS WITHHELD.

IN TENNESSEE DIAL 811
OR 1-800-351-1111
THREE WORKING DAYS BEFORE YOU DIG

THIS RECORD DOCUMENT HAS BEEN PREPARED BASED ON INFORMATION PROVIDED BY THE CONSTRUCTION CONTRACTOR, GRW ENGINEERS, INC. HAS ATTEMPTED TO VERIFY THE ACCURACY AND/OR COMPLETENESS OF THIS INFORMATION BUT SHALL NOT BE RESPONSIBLE FOR ANY ERRORS OR OMISSIONS WHICH MAY BE INCORPORATED HEREIN AS A RESULT.



engineering | architecture | geospatial
www.grwinc.com

ENGINEER/ARCHITECT: GRW Engineers, Inc.
HUGHES EXCAVATING, LLC

03/13/2017

GRW PROJECT NO. 4349-01

ALL RIGHTS RESERVED. NO PART OF THIS DOCUMENT SHALL BE REPRODUCED IN WHOLE OR IN PART WITHOUT THE WRITTEN PERMISSION OF GRW ENGINEERS, INC. AND SHALL NOT BE USED IN CONNECTION WITH ANY OTHER PROJECT WITHOUT THE WRITTEN PERMISSION OF GRW ENGINEERS, INC.



ENGINEERS - ARCHITECTS - PLANNERS
www.grwinc.com

CROOKED CREEK RD. - STA. 0+00 TO 105+00
POND HOLLOW RD. - STA. 0+00 TO STA. 7+00 E.O.L.
ROAN & CROOKED CREEK RDS. WATER LINE EXTENSIONS
CDBG CONTRACT NO. 2737
PERRY COUNTY, TENNESSEE

REVISIONS	DESIGNED	BLC	DATE	BY	DM	REVIEWED	BLC	APPROVED	BLC
1	ADDED DIRECTIONAL BORE		3/12/15	DM					

DATE: JANUARY 2015

SCALE: 1" = 200'

SHEET NO.

C-02