



PRINTED: 5/11/2017 @ 1:31 PM

FILE NAME: C:\4349-Perry Co\01-Roan Crooked\Working Drawings\AutoCAD\Design Drawings - As Buid\02_4349-01-C-02_C-04.dwg

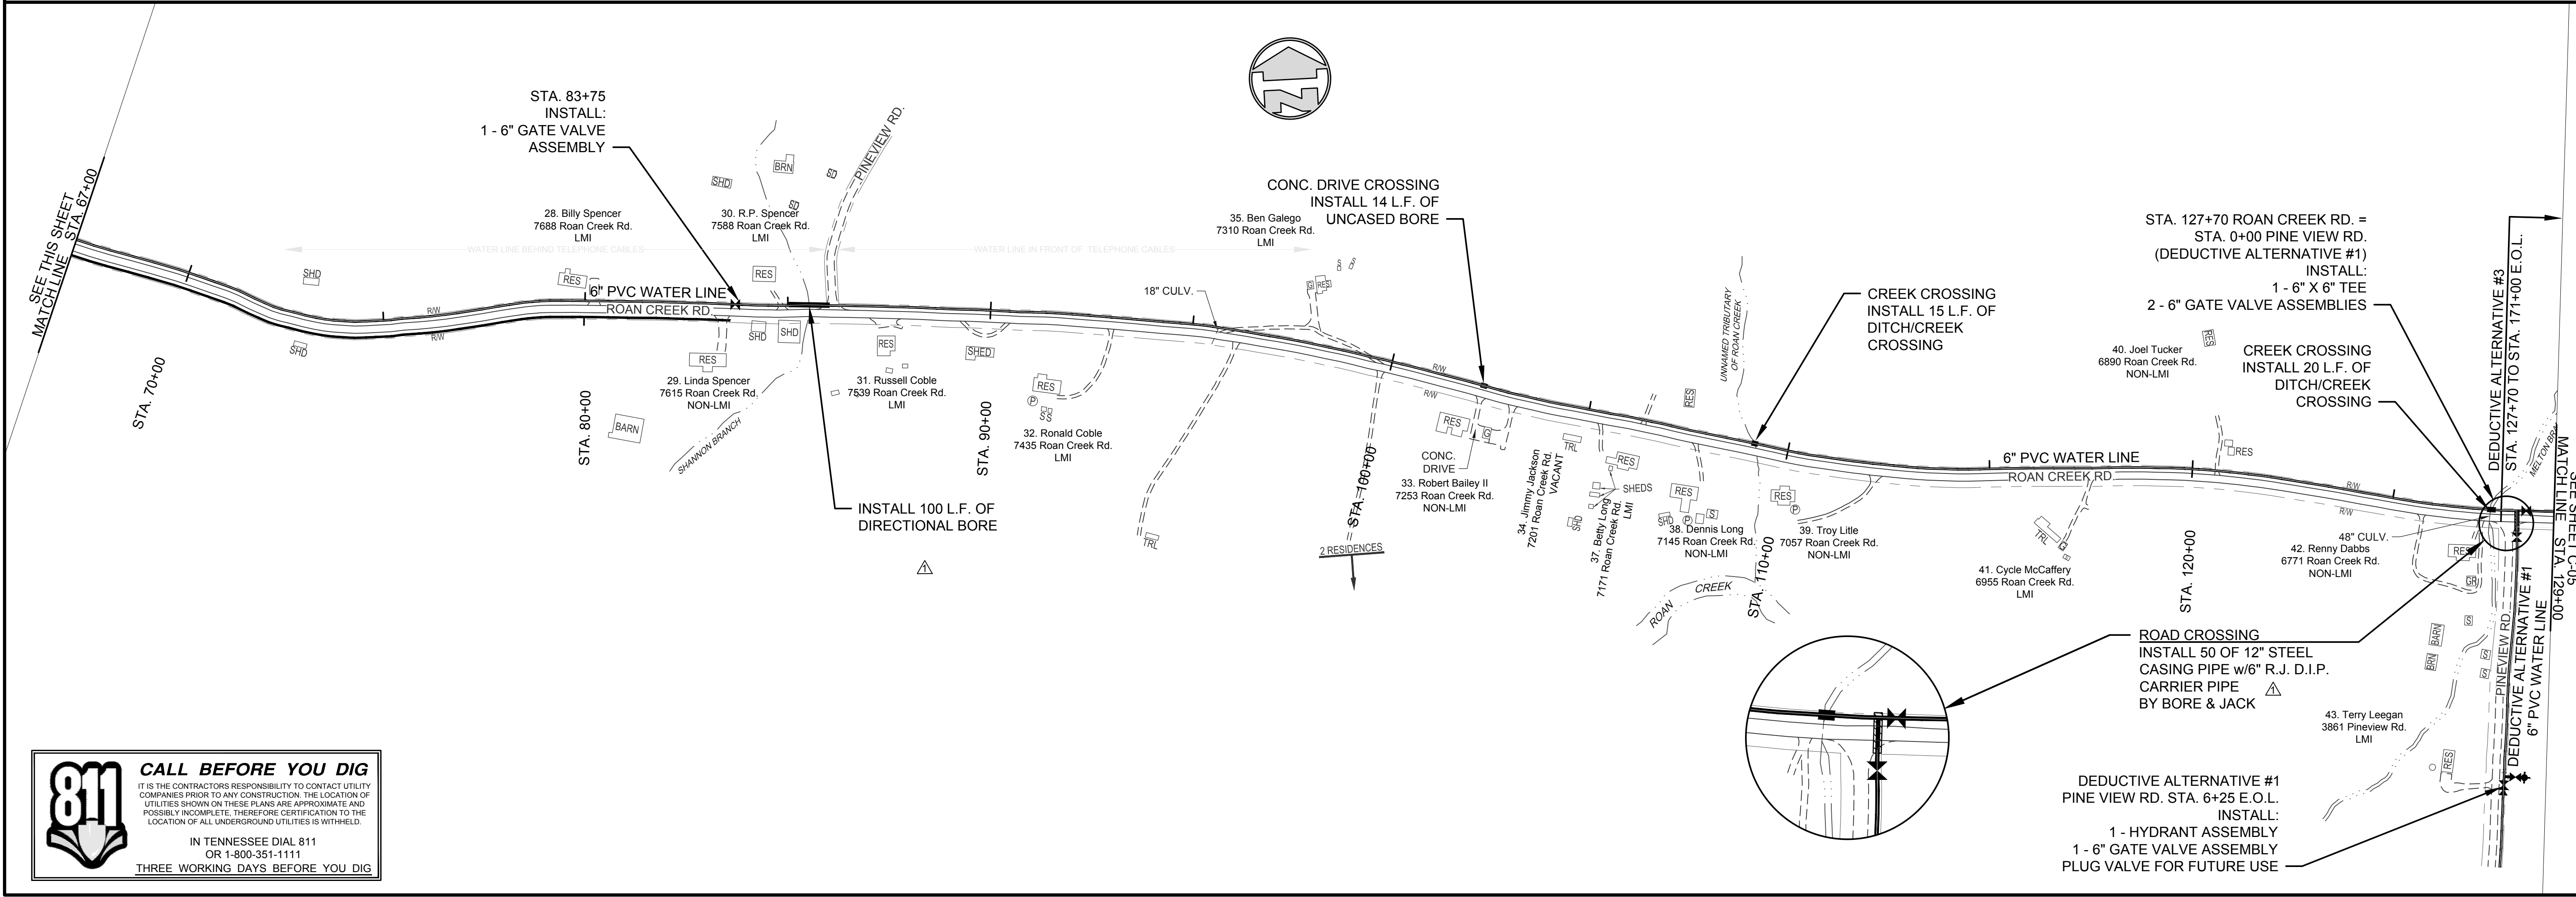

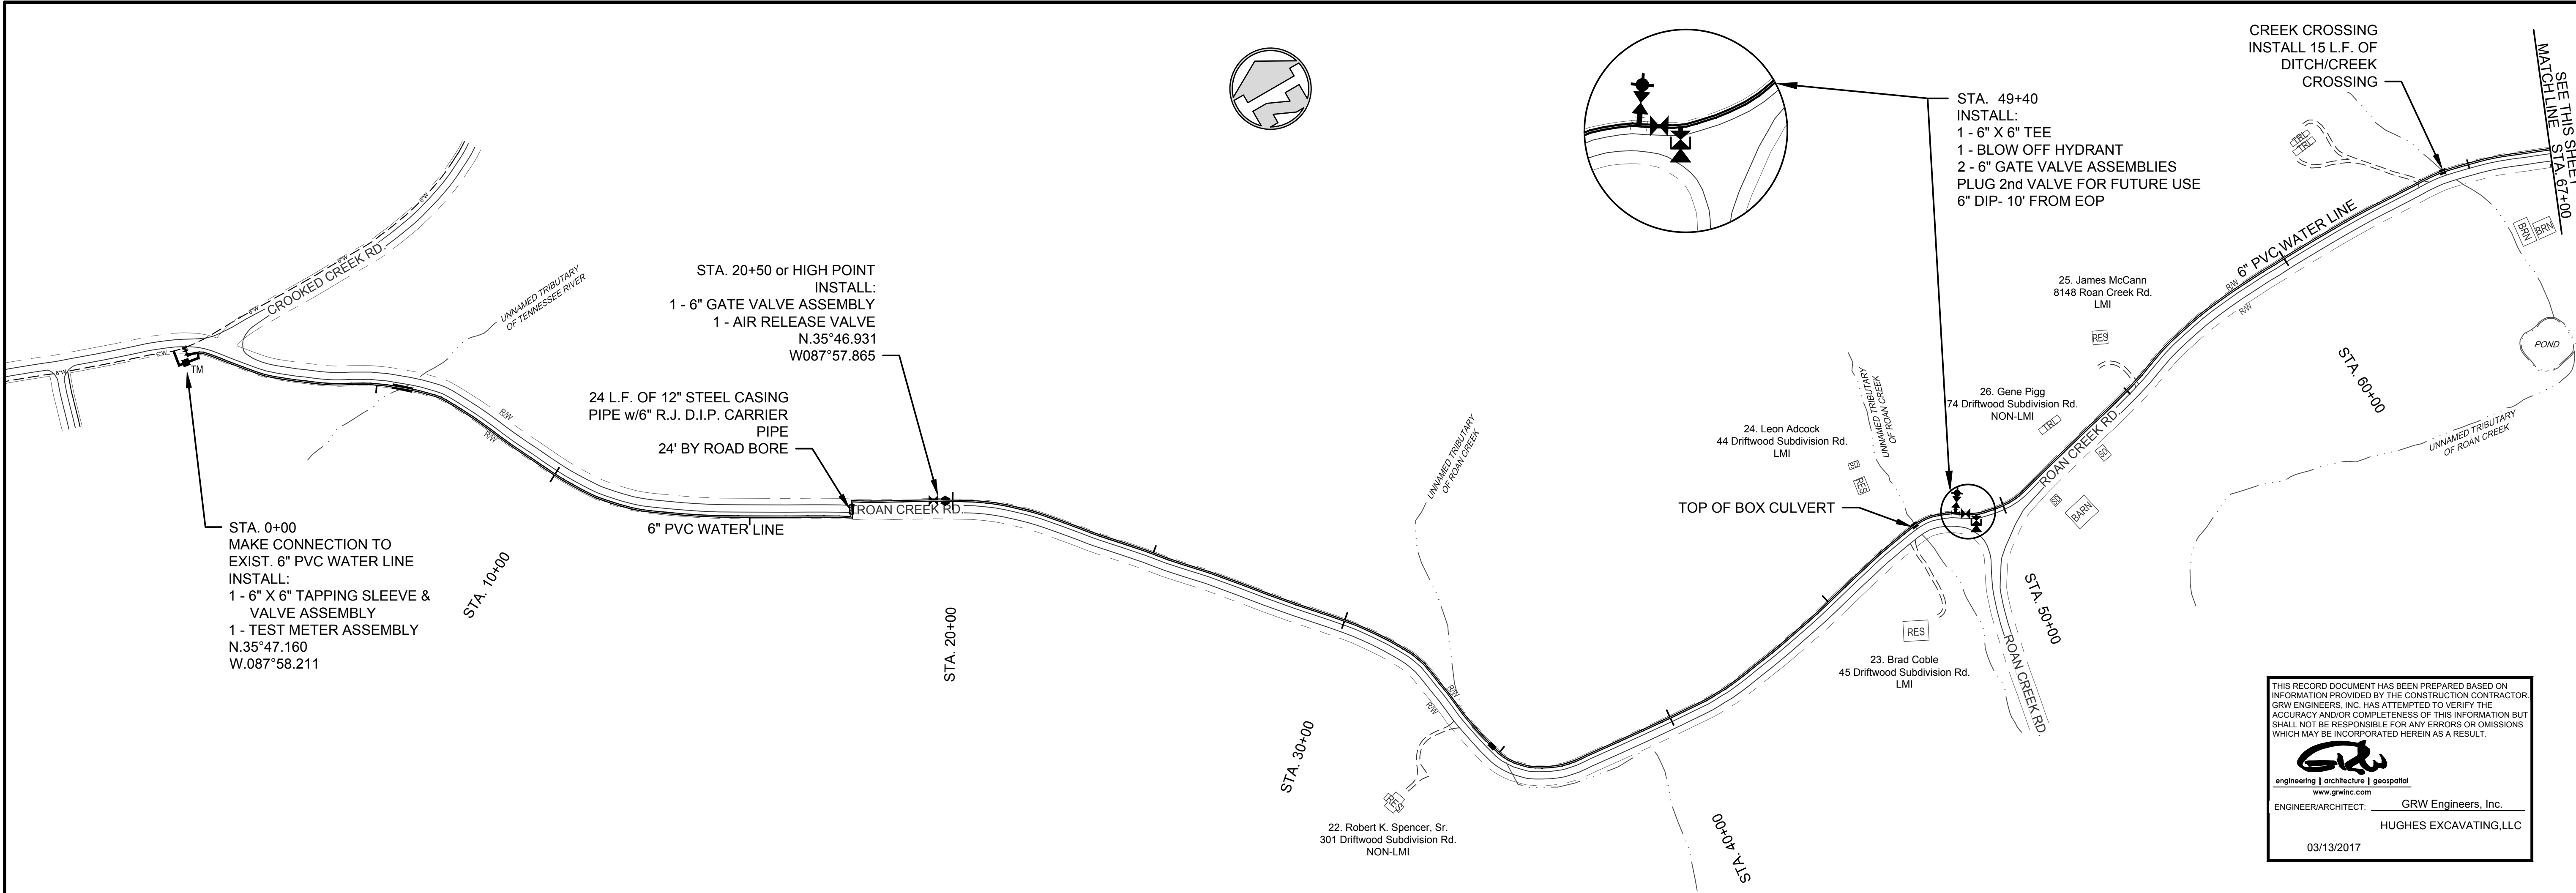

CALL BEFORE YOU DIG

IT IS THE CONTRACTOR'S RESPONSIBILITY TO CONTACT UTILITY COMPANIES PRIOR TO ANY CONSTRUCTION. THE LOCATION OF UTILITIES SHOWN ON THESE PLANS ARE APPROXIMATE AND POSSIBLY INCOMPLETE. THEREFORE CERTIFICATION TO THE LOCATION OF ALL UNDERGROUND UTILITIES IS WITHHELD.

IN TENNESSEE DIAL 811
OR 1-800-351-1111
THREE WORKING DAYS BEFORE YOU DIG

This document, originally issued, sealed, and signed by Barry L. Cloyd, Tennessee Professional Engineer, No. 100893, on December 14, 2015, shall not be used in lieu of a certified document.

GRW PROJECT NO. 4349-01

ALL RIGHTS RESERVED. NO PART OF THIS DOCUMENT SHALL BE REPRODUCED IN WHOLE OR IN PART WITHOUT THE WRITTEN PERMISSION OF GRW ENGINEERS, INC.

ENGINEERS - ARCHITECTS - PLANNERS

www.grwinc.com

ROAN CREEK RD. - STA. 0+00 TO STA. 129+00 E.O.L.
PINE VIEW RD. - STA. 0+00 TO STA. 6+25 E.O.L.
ROAN & CROOKED CREEK RDS. WATER LINE EXTENSIONS
CDBG CONTRACT NO. 2737
PERRY COUNTY, TENNESSEE

NO.	DATE	BY	REVISIONS
1	3/12/15	DM	ADDED DIRECTIONAL BORE

DATE: JANUARY 2015
SCALE: 1" = 200'
SHEET NO.

C-04