




FILE NAME: G:\4201-lobelville\01-Russell Lost\Working Drawings\AutoCAD - Record Drawing\4420-01-C-02_C-06.dwg
PRINTED: 5/11/2017 @ 12:58PM
PLOTTED BY: nazad

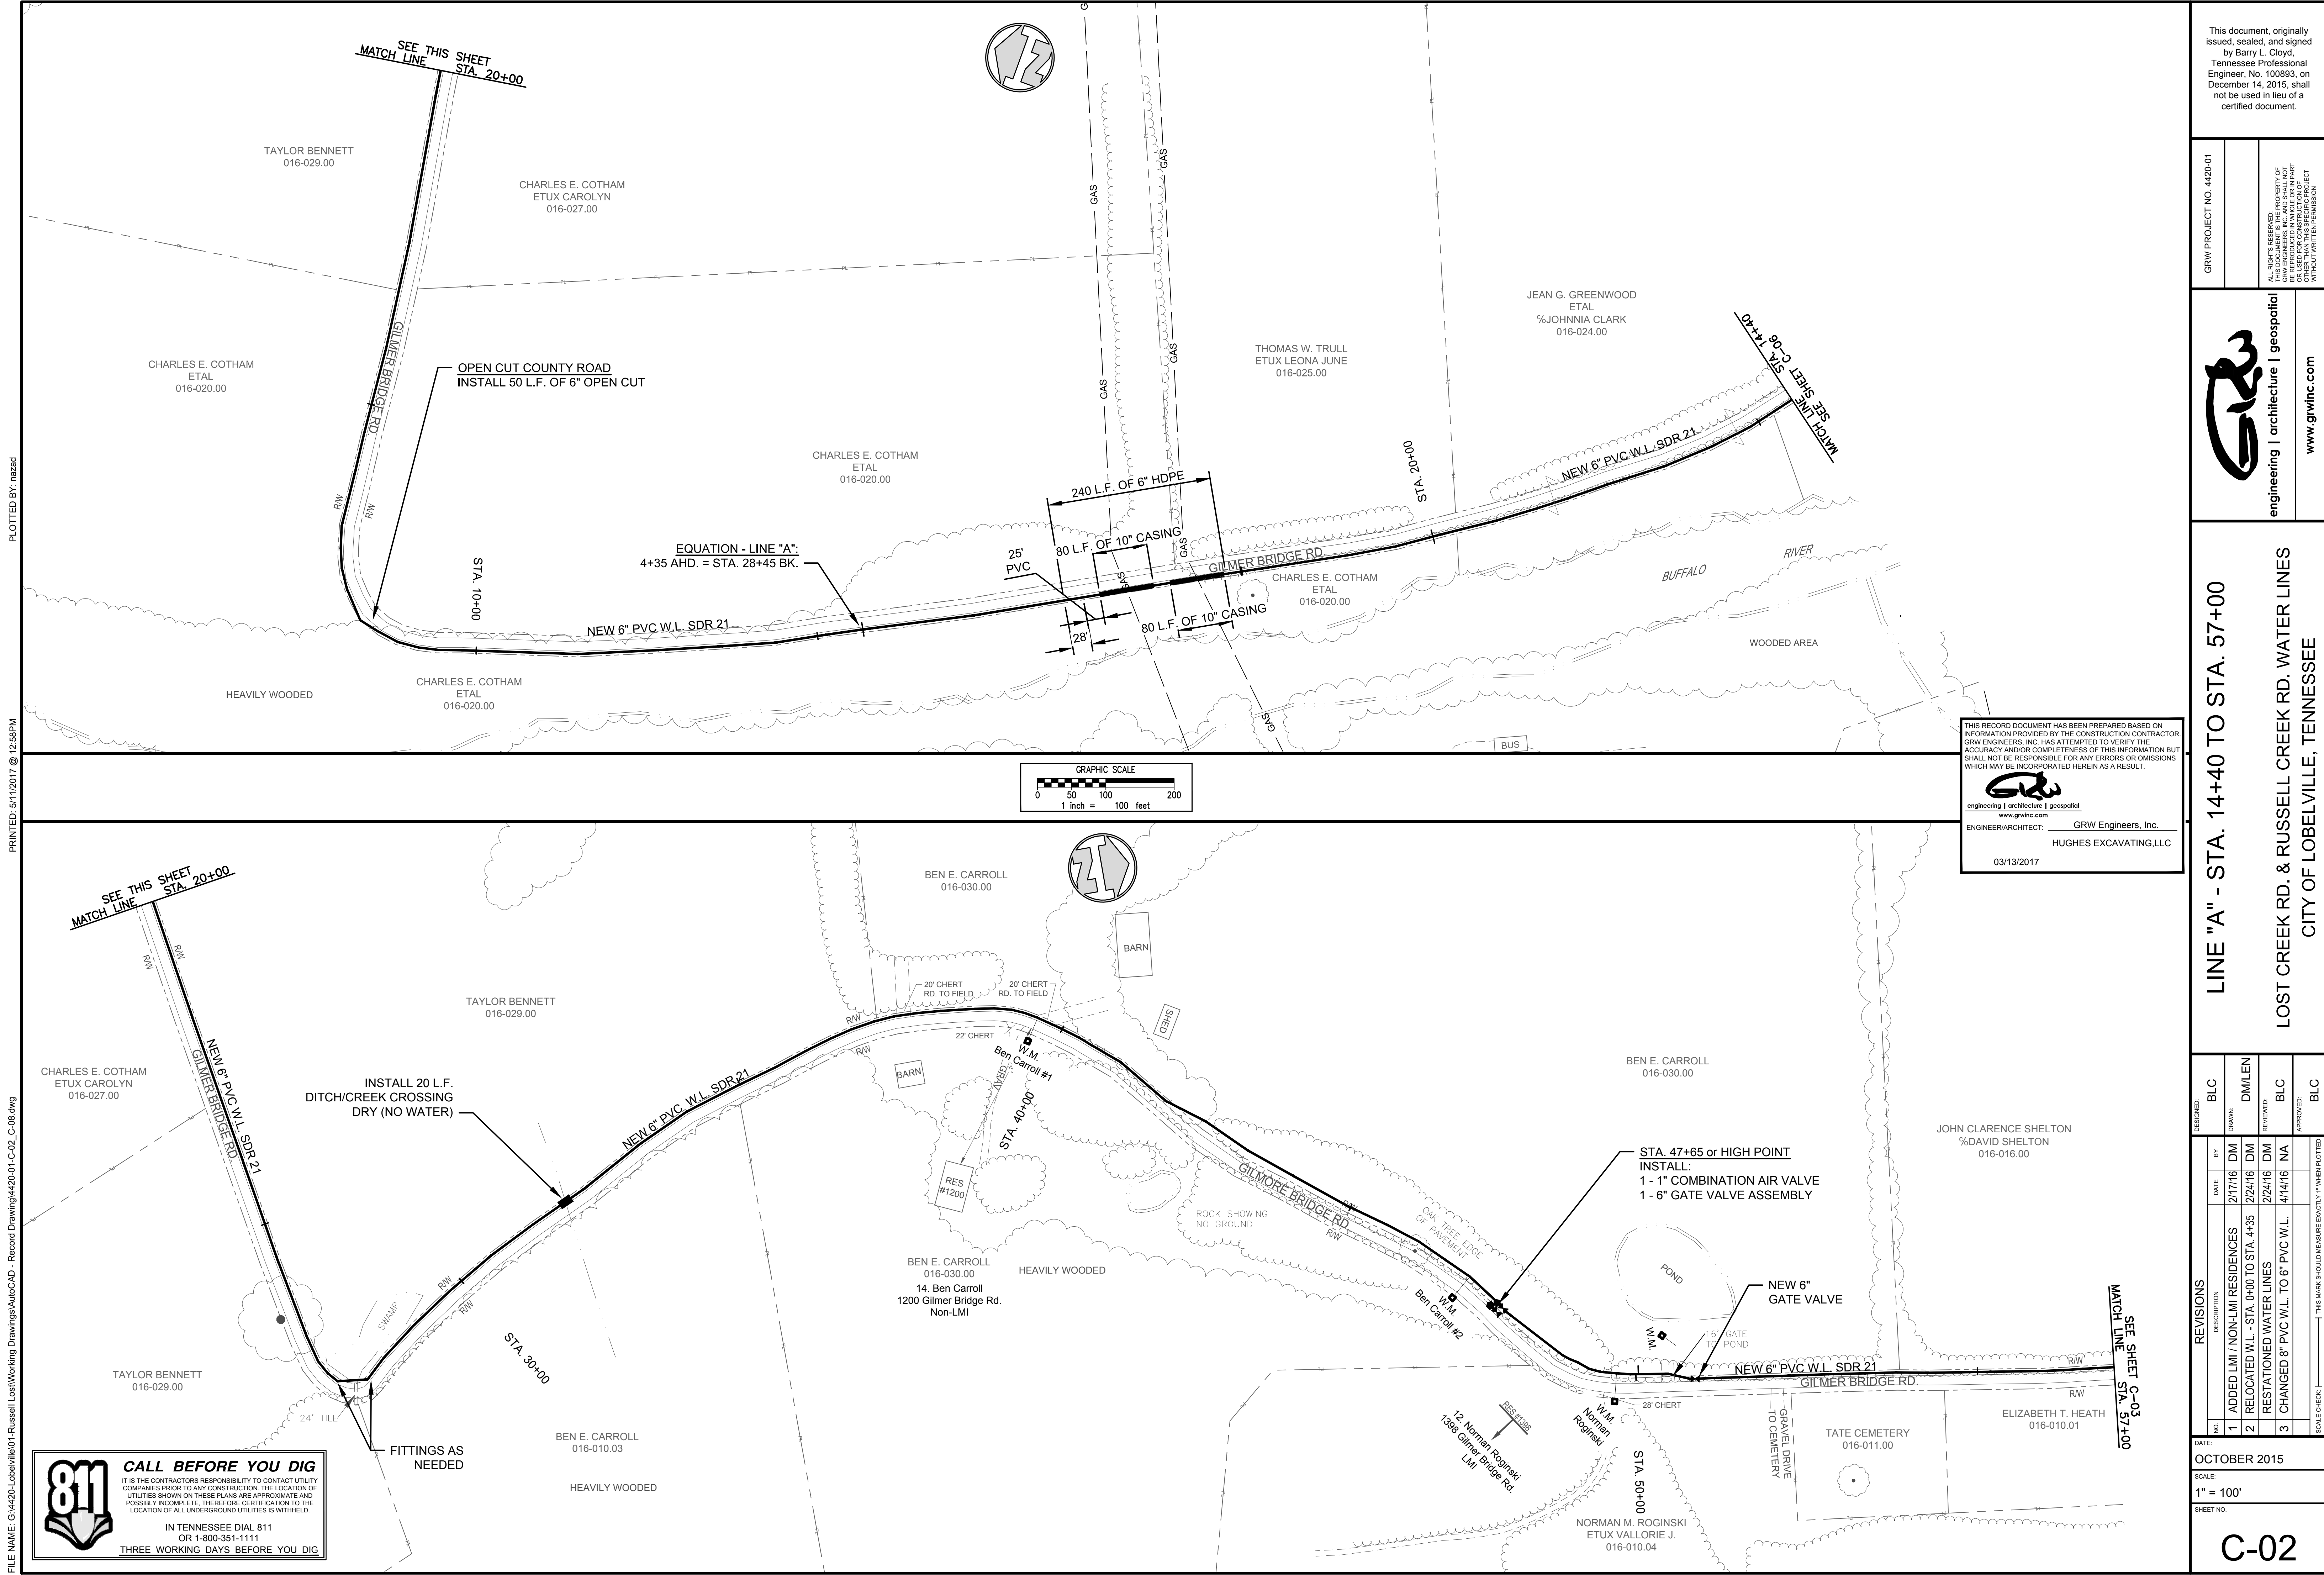


CALL BEFORE YOU DIG

IT IS THE CONTRACTOR'S RESPONSIBILITY TO CONTACT UTILITY COMPANIES PRIOR TO ANY CONSTRUCTION. THE LOCATION OF UTILITIES SHOWN ON THESE PLANS ARE APPROXIMATE AND POSSIBLY INCOMPLETE. THEREFORE CERTIFICATION TO THE LOCATION OF ALL UNDERGROUND UTILITIES IS WITHHELD.

IN TENNESSEE DIAL 811
OR 1-800-351-1111
THREE WORKING DAYS BEFORE YOU DIG

THIS RECORD DOCUMENT HAS BEEN PREPARED BASED ON INFORMATION PROVIDED BY THE CONSTRUCTION CONTRACTOR. GRW ENGINEERS, INC. HAS ATTEMPTED TO VERIFY THE ACCURACY AND/OR COMPLETENESS OF THIS INFORMATION BUT SHALL NOT BE RESPONSIBLE FOR ANY ERRORS OR OMISSIONS WHICH MAY BE INCORPORATED HEREIN AS A RESULT.

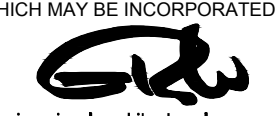

engineering | architecture | geospatial
www.grwinc.com

ENGINEER/ARCHITECT: GRW Engineers, Inc.
HUGHES EXCAVATING, LLC

03/13/2017

DESIGNED: BLC

DRAWN: DM/LEN

REVIEWED: BLC

APPROVED: BLC

NO.	REVISIONS	DATE	BY
1	ADDED LMI / NON-LMI RESIDENCES	2/17/16	DM
2	RELOCATED W.L. - STA. 0+00 TO STA. 4+35	2/24/16	DM
3	CHANGED 8" PVC W.L. TO 6" PVC W.L.	4/14/16	NA

DATE: OCTOBER 2015

SCALE: 1" = 100'

SHEET NO. C-02

GRW PROJECT NO. 4420-01

ALL RIGHTS RESERVED. NO PART OF THIS DOCUMENT MAY BE REPRODUCED IN WHOLE OR IN PART WITHOUT THE WRITTEN PERMISSION OF GRW ENGINEERS, INC. AND SHALL NOT BE USED IN ANY OTHER PROJECT OTHER THAN THIS SPECIFIC PROJECT WITHOUT THE WRITTEN PERMISSION.

engineering | architecture | geospatial
www.grwinc.com

LINE "A" - STA. 14+40 TO STA. 57+00

LOST CREEK RD. & RUSSELL CREEK RD. WATER LINES

CITY OF LOBELVILLE, TENNESSEE

RECORD DRAWINGS