


FILE NAME: G:\4201-lobelville\01-Russell Lost\Working Drawings\AutoCAD - Record Drawing\4420-01-C-02\_C-08.dwg  
PRINTED: 5/11/2017 @ 12:58PM  
PLOTTED BY: nazad

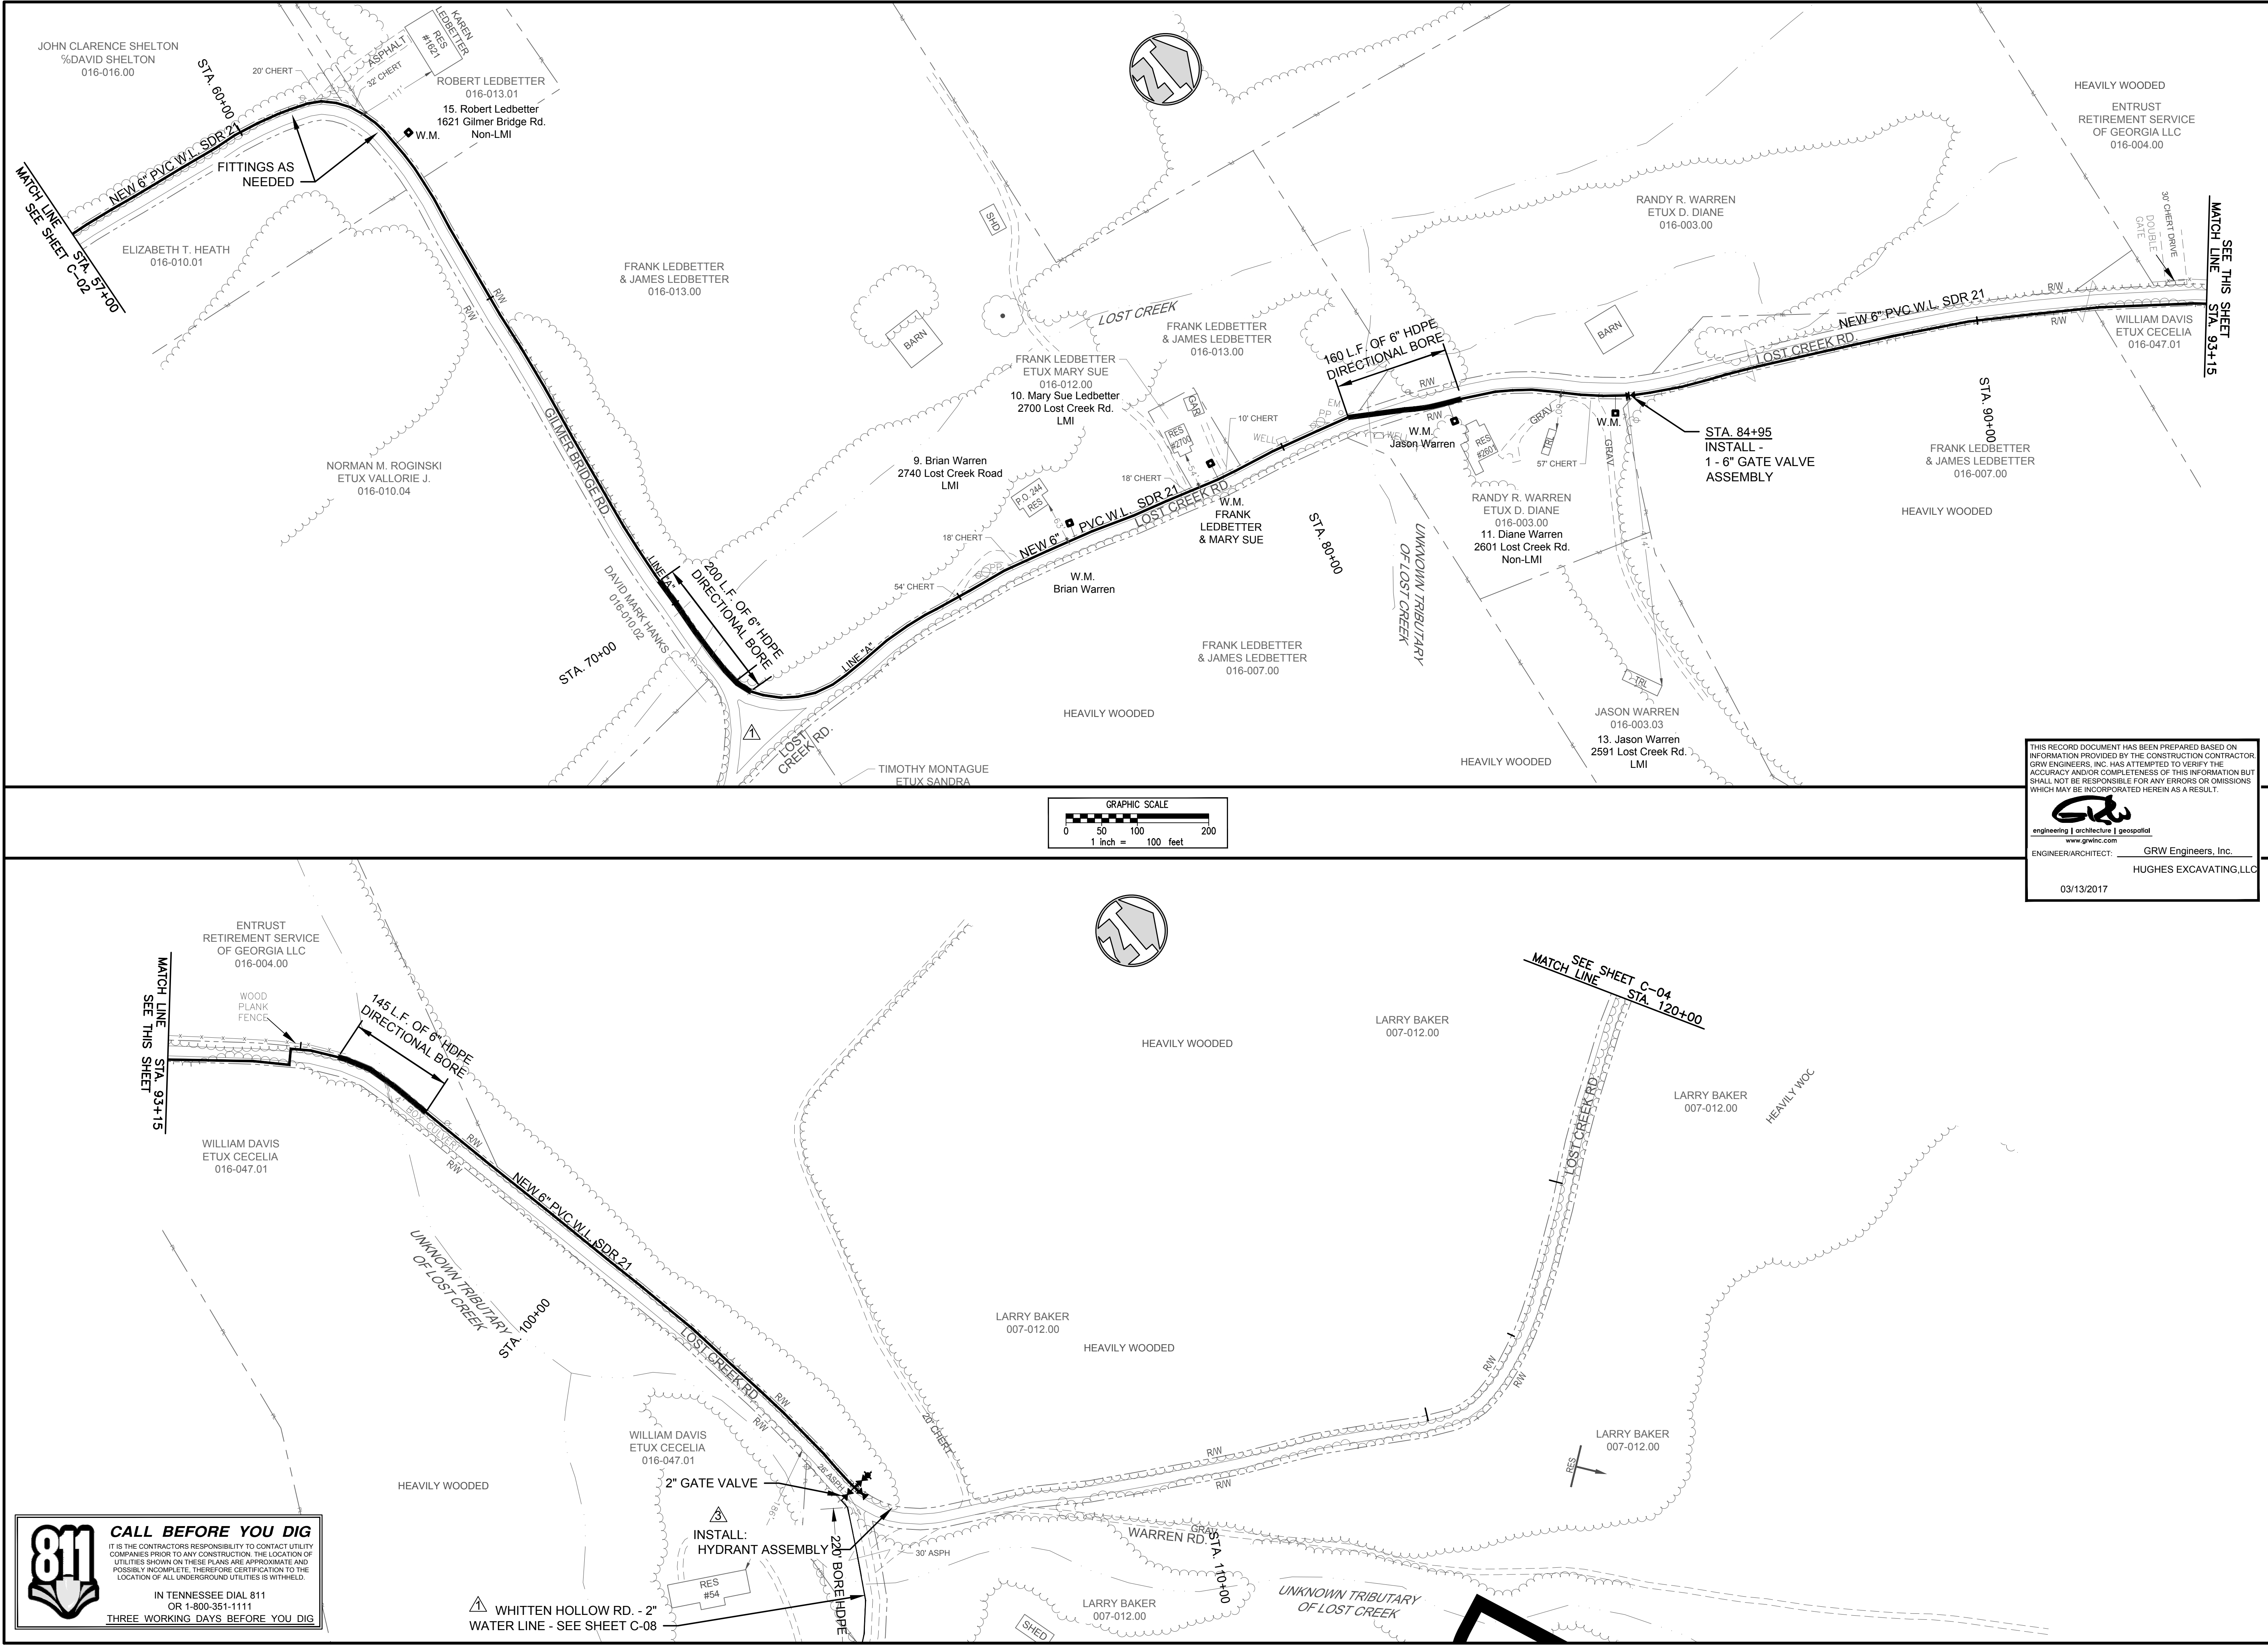

**811 CALL BEFORE YOU DIG**

IT IS THE CONTRACTOR'S RESPONSIBILITY TO CONTACT UTILITY COMPANIES PRIOR TO ANY CONSTRUCTION. THE LOCATION OF UTILITIES SHOWN ON THESE PLANS ARE APPROXIMATE AND POSSIBLY INCOMPLETE. THEREFORE CERTIFICATION TO THE LOCATION OF ALL UNDERGROUND UTILITIES IS WITHHELD.

IN TENNESSEE DIAL 811 OR 1-800-351-1111  
THREE WORKING DAYS BEFORE YOU DIG

THIS RECORD DOCUMENT HAS BEEN PREPARED BASED ON INFORMATION PROVIDED BY THE CONSTRUCTION CONTRACTOR. GRW ENGINEERS, INC. HAS ATTEMPTED TO VERIFY THE ACCURACY AND/OR COMPLETENESS OF THIS INFORMATION BUT SHALL NOT BE RESPONSIBLE FOR ANY ERRORS OR OMISSIONS WHICH MAY BE INCORPORATED HEREIN AS A RESULT.

**GRW**  
engineering | architecture | geospatial  
www.grwinc.com  
ENGINEER/ARCHITECT: GRW Engineers, Inc.  
HUGHES EXCAVATING, LLC  
03/13/2017

|                                                                                                                         |                                   |                                                                                                                                                                                                                                                                 |                                 |
|-------------------------------------------------------------------------------------------------------------------------|-----------------------------------|-----------------------------------------------------------------------------------------------------------------------------------------------------------------------------------------------------------------------------------------------------------------|---------------------------------|
| GRW PROJECT NO. 4420-01                                                                                                 |                                   | ALL RIGHTS RESERVED. NO PART OF THIS DOCUMENT MAY BE REPRODUCED IN WHOLE OR IN PART WITHOUT THE WRITTEN PERMISSION OF GRW ENGINEERS, INC. AND SHALL NOT BE USED IN CONNECTION WITH ANY OTHER PROJECT THAN THIS SPECIFIC PROJECT WITHOUT THE WRITTEN PERMISSION. |                                 |
|                                                                                                                         |                                   | engineering   architecture   geospatial<br>www.grwinc.com                                                                                                                                                                                                       |                                 |
| LINE "A" - STA. 57+00 TO STA. 120+00<br>LOST CREEK RD. & RUSSELL CREEK RD. WATER LINES<br>CITY OF LOBELVILLE, TENNESSEE |                                   |                                                                                                                                                                                                                                                                 |                                 |
| DESIGNED                                                                                                                | BLC                               | BY                                                                                                                                                                                                                                                              | DM                              |
| DATE                                                                                                                    | 2/17/16                           | DATE                                                                                                                                                                                                                                                            | 2/17/16                         |
| DESCRIPTION                                                                                                             | ADDED WHITTEN HOLLOW RD. LINE "C" | DESCRIPTION                                                                                                                                                                                                                                                     | REMOVED LOST CREEK RD. LINE "C" |
| NO                                                                                                                      | 1                                 | NO                                                                                                                                                                                                                                                              | 2                               |
| NO                                                                                                                      | 2                                 | NO                                                                                                                                                                                                                                                              | 3                               |
| NO                                                                                                                      | 3                                 | NO                                                                                                                                                                                                                                                              | 4                               |
| NO                                                                                                                      | 4                                 | NO                                                                                                                                                                                                                                                              | 5                               |
| NO                                                                                                                      | 5                                 | NO                                                                                                                                                                                                                                                              | 6                               |
| NO                                                                                                                      | 6                                 | NO                                                                                                                                                                                                                                                              | 7                               |
| NO                                                                                                                      | 7                                 | NO                                                                                                                                                                                                                                                              | 8                               |
| NO                                                                                                                      | 8                                 | NO                                                                                                                                                                                                                                                              | 9                               |
| NO                                                                                                                      | 9                                 | NO                                                                                                                                                                                                                                                              | 10                              |
| NO                                                                                                                      | 10                                | NO                                                                                                                                                                                                                                                              | 11                              |
| NO                                                                                                                      | 11                                | NO                                                                                                                                                                                                                                                              | 12                              |
| NO                                                                                                                      | 12                                | NO                                                                                                                                                                                                                                                              | 13                              |
| NO                                                                                                                      | 98                                | NO                                                                                                                                                                                                                                                              | 99                              |
| NO                                                                                                                      | 99                                | NO                                                                                                                                                                                                                                                              | 100                             |
| NO                                                                                                                      | 100                               | NO                                                                                                                                                                                                                                                              | 101                             |
| NO                                                                                                                      | 101                               | NO                                                                                                                                                                                                                                                              | 102                             |
| NO                                                                                                                      | 102                               | NO                                                                                                                                                                                                                                                              | 103                             |
| NO                                                                                                                      | 356                               | NO                                                                                                                                                                                                                                                              | 357                             |
| NO                                                                                                                      | 3                                 |                                                                                                                                                                                                                                                                 |                                 |