



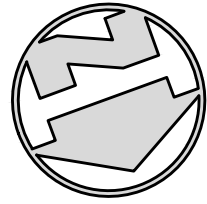

FILE NAME: G:\420-Lobellville\01-Russell\LostWorking Drawings\AutoCAD - Record Drawing\4420-01-C-02_C-08.dwg
PRINTED: 5/11/2017 @ 12:57PM
PLOTTED BY: nazad

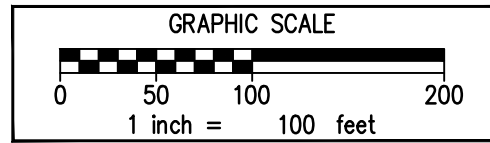

THIS RECORD DOCUMENT HAS BEEN PREPARED BASED ON INFORMATION PROVIDED BY THE CONSTRUCTION CONTRACTOR GRW ENGINEERS, INC. HAS ATTEMPTED TO VERIFY THE ACCURACY AND/OR COMPLETENESS OF THIS INFORMATION BUT SHALL NOT BE RESPONSIBLE FOR ANY ERRORS OR OMISSIONS WHICH MAY BE INCORPORATED HEREIN AS A RESULT.


engineering | architecture | geospatial
www.grwinc.com

ENGINEER/ARCHITECT: GRW Engineers, Inc.
HUGHES EXCAVATING, LLC
03/13/2017


 **CALL BEFORE YOU DIG**
IT IS THE CONTRACTORS RESPONSIBILITY TO CONTACT UTILITY COMPANIES PRIOR TO ANY CONSTRUCTION. THE LOCATION OF UTILITIES SHOWN ON THESE PLANS ARE APPROXIMATE AND POSSIBLY INCOMPLETE. THEREFORE CERTIFICATION TO THE LOCATION OF ALL UNDERGROUND UTILITIES IS WITHHELD.

IN TENNESSEE DIAL 811
OR 1-800-351-1111
THREE WORKING DAYS BEFORE YOU DIG

This document, originally issued, sealed, and signed by Barry L. Cloyd, Tennessee Professional Engineer, No. 100893, on December 14, 2015, shall not be used in lieu of a certified document.

GRW PROJECT NO. 4420-01

ALL RIGHTS RESERVED. NO PART OF THIS DOCUMENT SHALL BE REPRODUCED IN WHOLE OR IN PART WITHOUT THE WRITTEN PERMISSION OF GRW ENGINEERS, INC. AND SHALL NOT BE REPRODUCED IN WHOLE OR IN PART WITHOUT THE WRITTEN PERMISSION OF GRW ENGINEERS, INC.

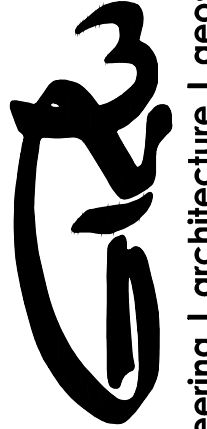 engineering | architecture | geospatial
www.grwinc.com

LINE "A" - STA. 120+00 TO STA. 185+00
LOST CREEK RD. & RUSSELL CREEK RD. WATER LINES
CITY OF LOBELVILLE, TENNESSEE

NO.	REVISIONS	DATE	BY	DESIGNED		DRAWN		REVIEWED		APPROVED	
				DESCRIPTION	BLC	DM/LEN	BLC	BLC			
1	RESTATIONED LOST CK. RD. WATER LN	2/24/16	DM								
2	CHANGED 8" PVC W.L. TO 6" PVC W.L.	4/14/16	NA								

DATE: OCTOBER 2015
SCALE: 1" = 100'
SHEET NO. C-04

THIS MARK SHOULD MEASURE EXACTLY 1" WHEN PLOTTED