
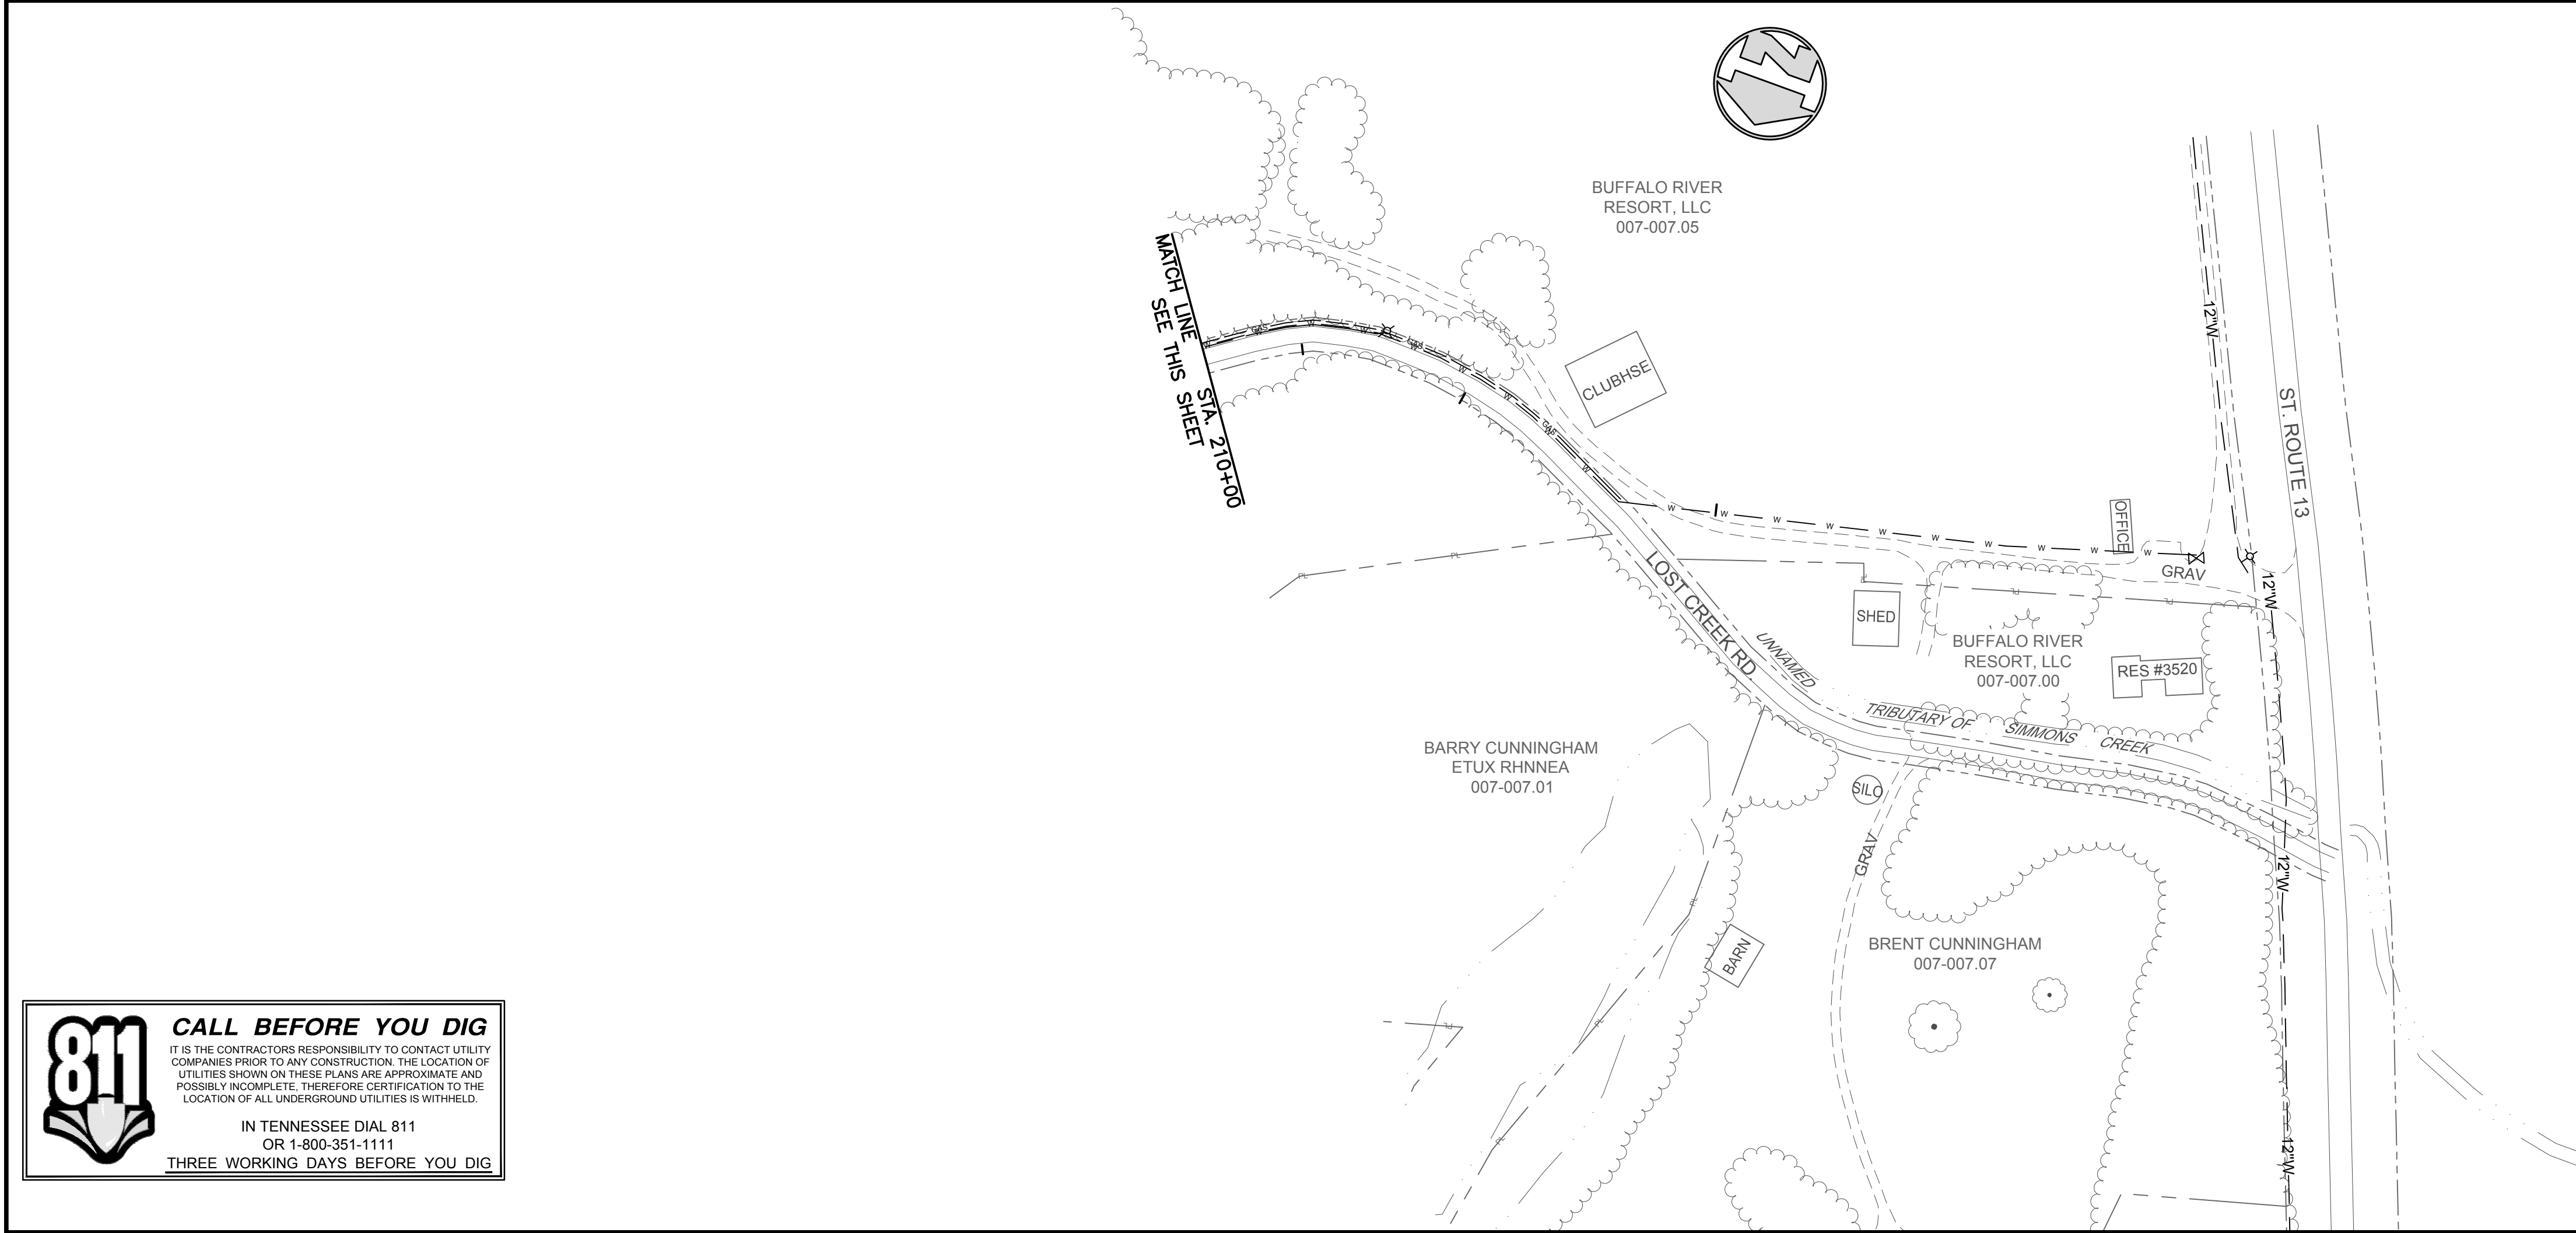


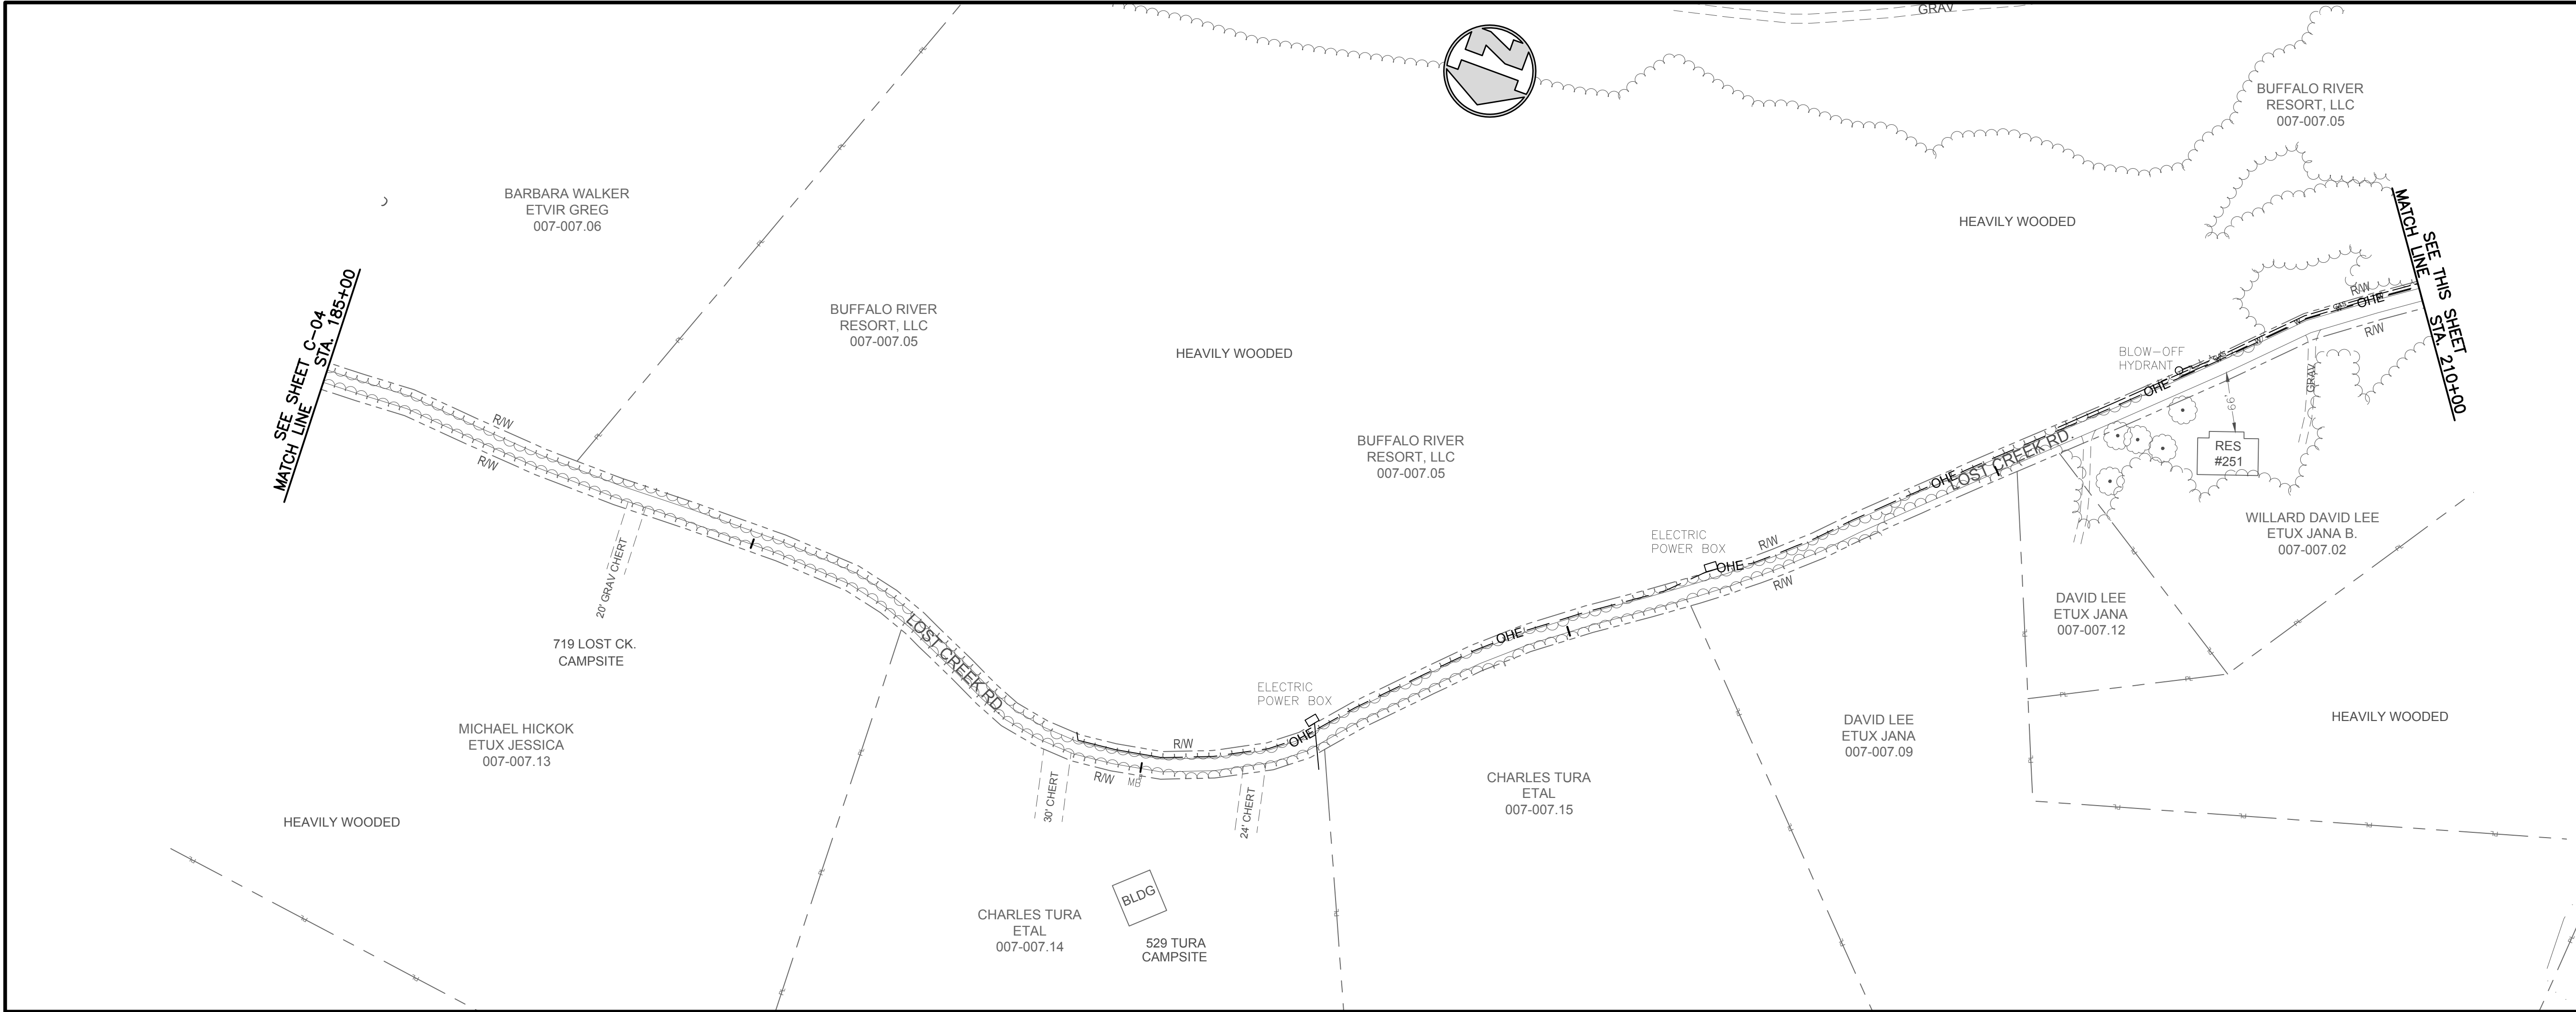

THIS RECORD DOCUMENT HAS BEEN PREPARED BASED ON THE INFORMATION PROVIDED BY THE CONSTRUCTION CONTRACTOR, GRW ENGINEERS, INC. HAS ATTEMPTED TO VERIFY THE ACCURACY AND/OR COMPLETENESS OF THIS INFORMATION BUT SHALL NOT BE RESPONSIBLE FOR ANY ERRORS OR OMISSIONS WHICH MAY BE INCORPORATED HEREIN AS A RESULT.


 engineering | architecture | geospatial
 www.grwinc.com

ENGINEER/ARCHITECT: _____ GRW Engineers, Inc.
 _____ HUGHES EXCAVATING, LLC

03/13/2017

This document, originally issued, sealed, and signed by Barry L. Cloyd, Tennessee Professional Engineer, No. 100893, on December 14, 2015, shall not be used in lieu of a certified document.			
GRW PROJECT NO. 4420-01		ALL RIGHTS RESERVED THIS DOCUMENT IS THE PROPERTY OF GEOSPATIAL ENGINEERING, INC. IT SHALL NOT BE REPRODUCED IN WHOLE OR IN PART WITHOUT THE WRITTEN PERMISSION OF GEOSPATIAL ENGINEERING, INC.	
		www.gwinc.com	
LINE "A" - STA. 185+00 TO STA. 219+30 E.O.L.			
LOST CREEK RD. & RUSSELL CREEK RD. WATER LINES			
CITY OF LOBELVILLE, TENNESSEE			
DESIGNED:	BY:	DATE:	DESCRIPTION:
BLC	DM	11/24/16	1 RESTATIONED LOST CK. RD. WATER LN/224/16
	DMILEN		2 MOVED DUCT NO. 1 TO E.O.L.
	BLC	4/14/16	2 CHANGED 8" PVC W.L. TO 6" PVC W.L.
	APPROVES:		
	BLC		
SCALE CHECK: _____			THIS MARK SHOULD MEASURE EXACTLY 1" WHEN PLOTTED
DATE: OCTOBER 2015			
SCALE: 1" = 100'			
SHEET NO. C-05			

RECORD DRAWINGS