

PLOTTED BY: nazad




PRINTED: 5/11/2017 @ 2:56PM

FILE NAME: G:\4201-Lobville\01-Russell\LostWorking Drawings\AutoCAD - Record Drawing\4420-01-C-02_C-08.dwg



CALL BEFORE YOU DIG
IT IS THE CONTRACTOR'S RESPONSIBILITY TO CONTACT UTILITY COMPANIES PRIOR TO ANY CONSTRUCTION. THE LOCATION OF UTILITIES SHOWN ON THESE PLANS ARE APPROXIMATE AND POSSIBLY INCOMPLETE. THEREFORE CERTIFICATION TO THE LOCATION OF ALL UNDERGROUND UTILITIES IS WITHHELD.

IN TENNESSEE DIAL 811
OR 1-800-351-1111
THREE WORKING DAYS BEFORE YOU DIG

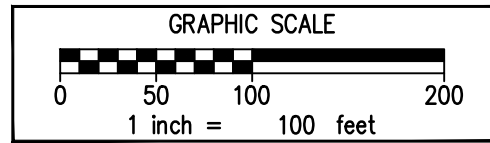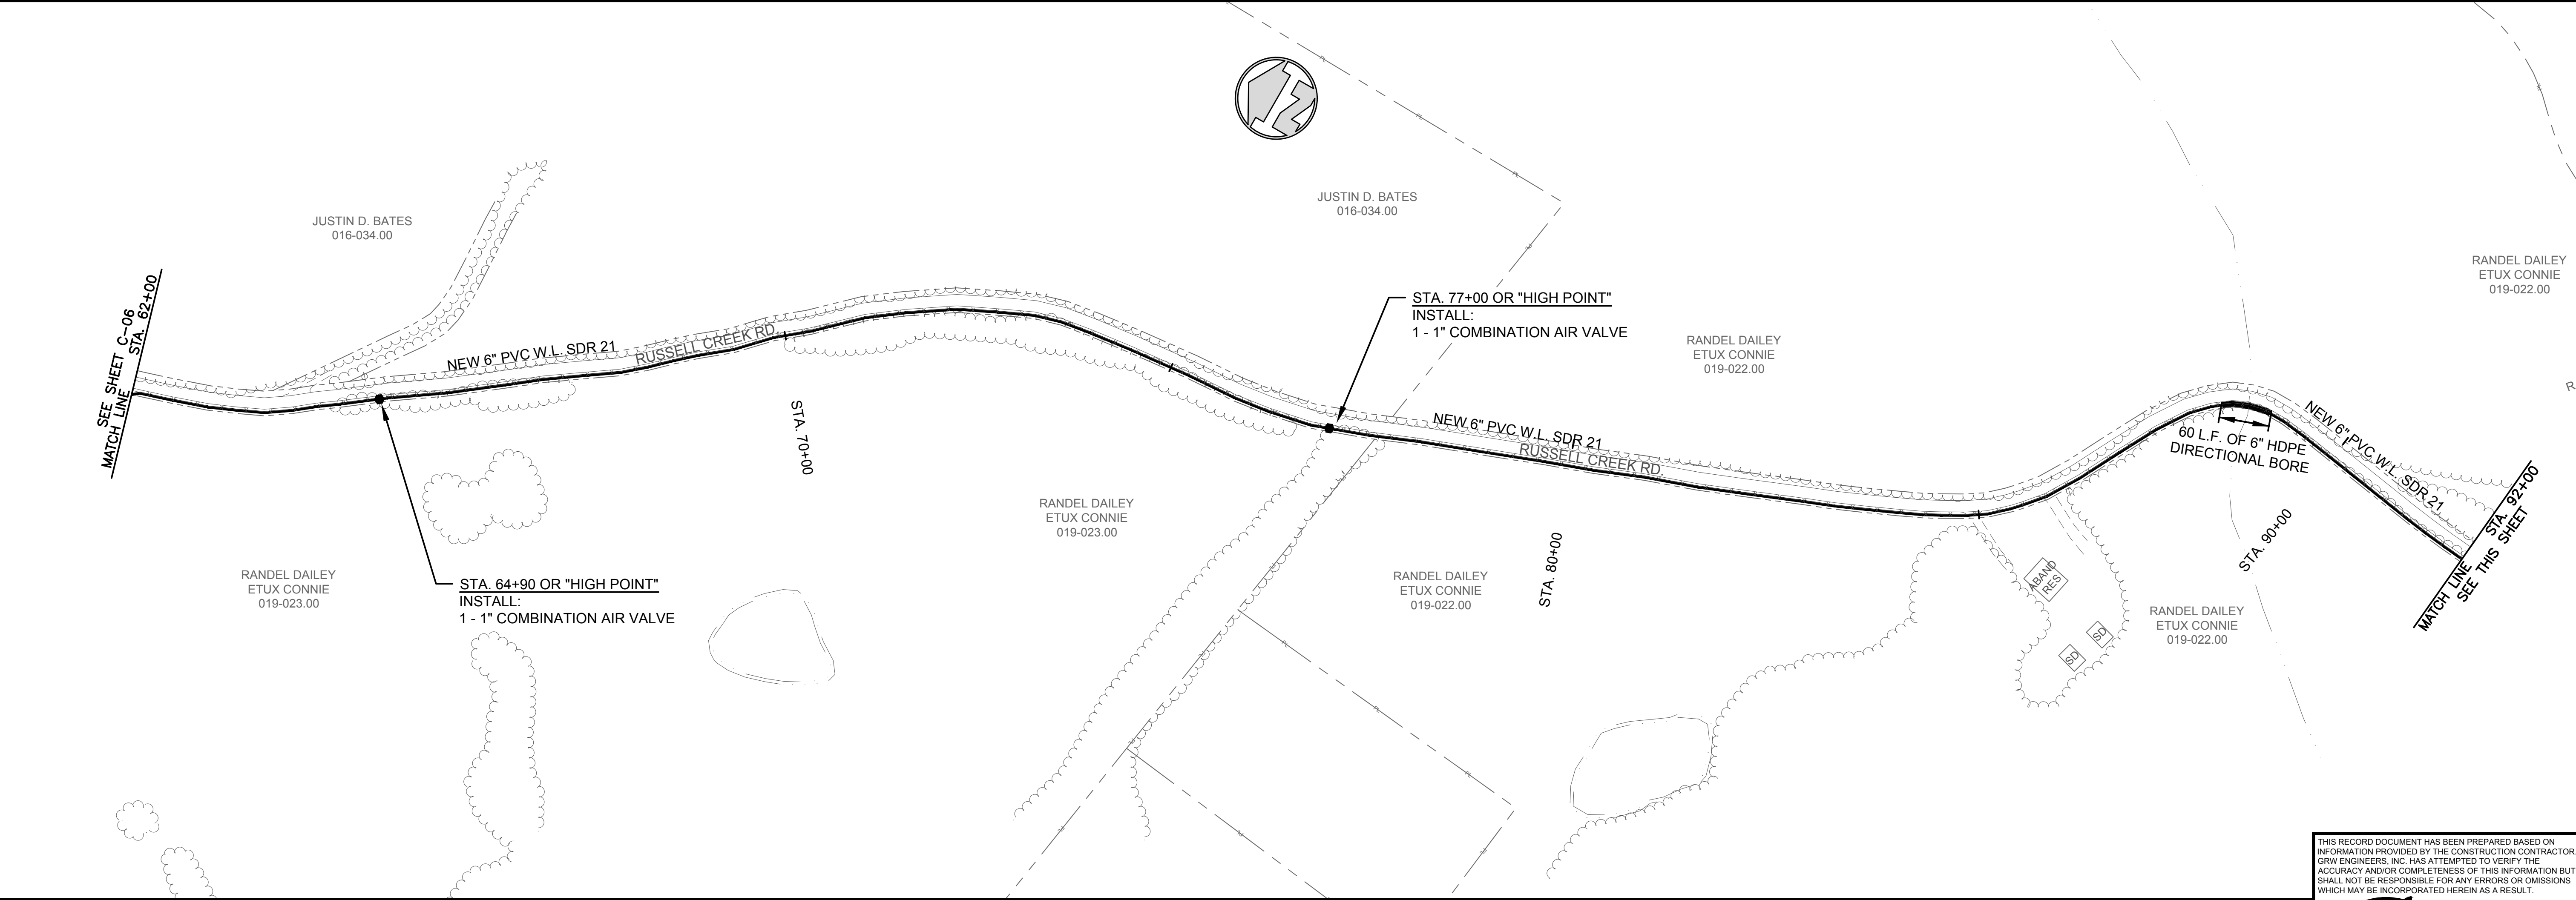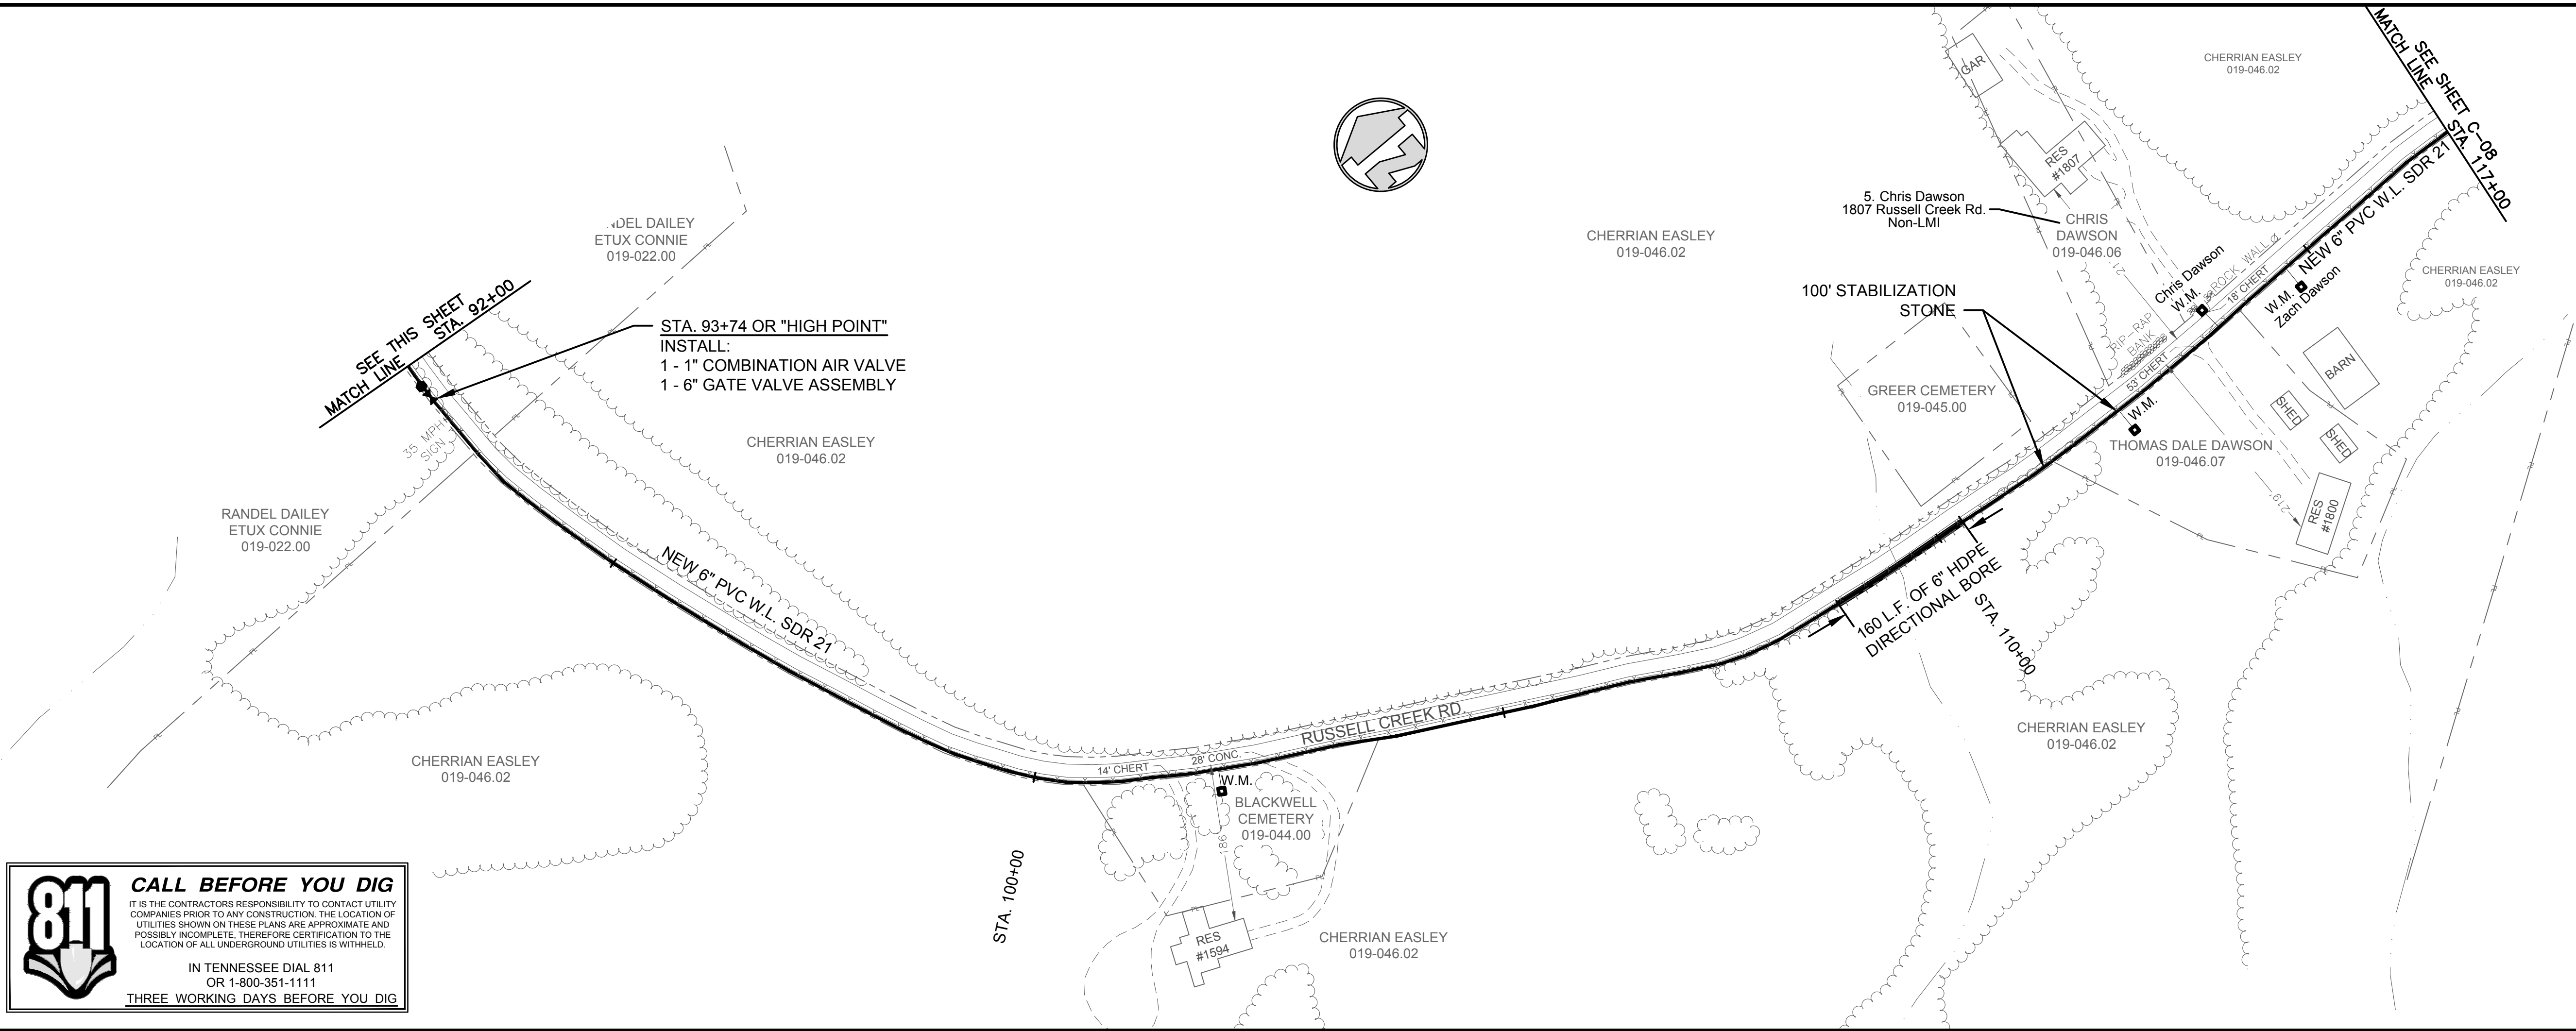

THIS RECORD DOCUMENT HAS BEEN PREPARED BASED ON INFORMATION PROVIDED BY THE CONSTRUCTION CONTRACTOR. GRW ENGINEERS, INC. HAS ATTEMPTED TO VERIFY THE ACCURACY AND/OR COMPLETENESS OF THIS INFORMATION BUT SHALL NOT BE RESPONSIBLE FOR ANY ERRORS OR OMISSIONS WHICH MAY BE INCORPORATED HEREIN AS A RESULT.


engineering | architecture | geospatial
www.grwinc.com
ENGINEER/ARCHITECT: GRW Engineers, Inc.
HUGHES EXCAVATING, LLC
03/13/2017

LINE "B" - STA. 62+00 TO STA. 117+00
LOST CREEK RD. & RUSSELL CREEK RD. WATER LINES
CITY OF LOBELVILLE, TENNESSEE

REVISIONS				DESIGNED:
NO	DESCRIPTION	DATE	BY	BLC
1	ADDED LMI / NON-LMI RESIDENCES	2/17/16	DM	DRAWN
				DM/LEN
				REVIEWED:
				BLC
				APPROVED
				BLC
SCALE CHECK: _____ THIS MARK SHOULD MEASURE EXACTLY 1" WHEN PLOTTED				
DATE: OCTOBER 2015				
SCALE: 1" = 100'				
SHEET NO. C-07				