
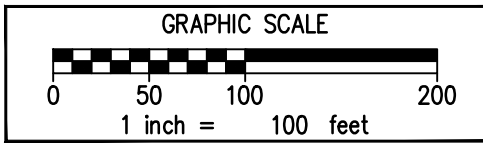


PLOTTED BY: nazad

PRINTED: 5/11/2017 @ 12:59PM

FILE NAME: G:\44201-lobelville\01-Russell\LostWorking Drawings\AutoCAD - Record Drawing\4420-01-C-02_C-08.dwg

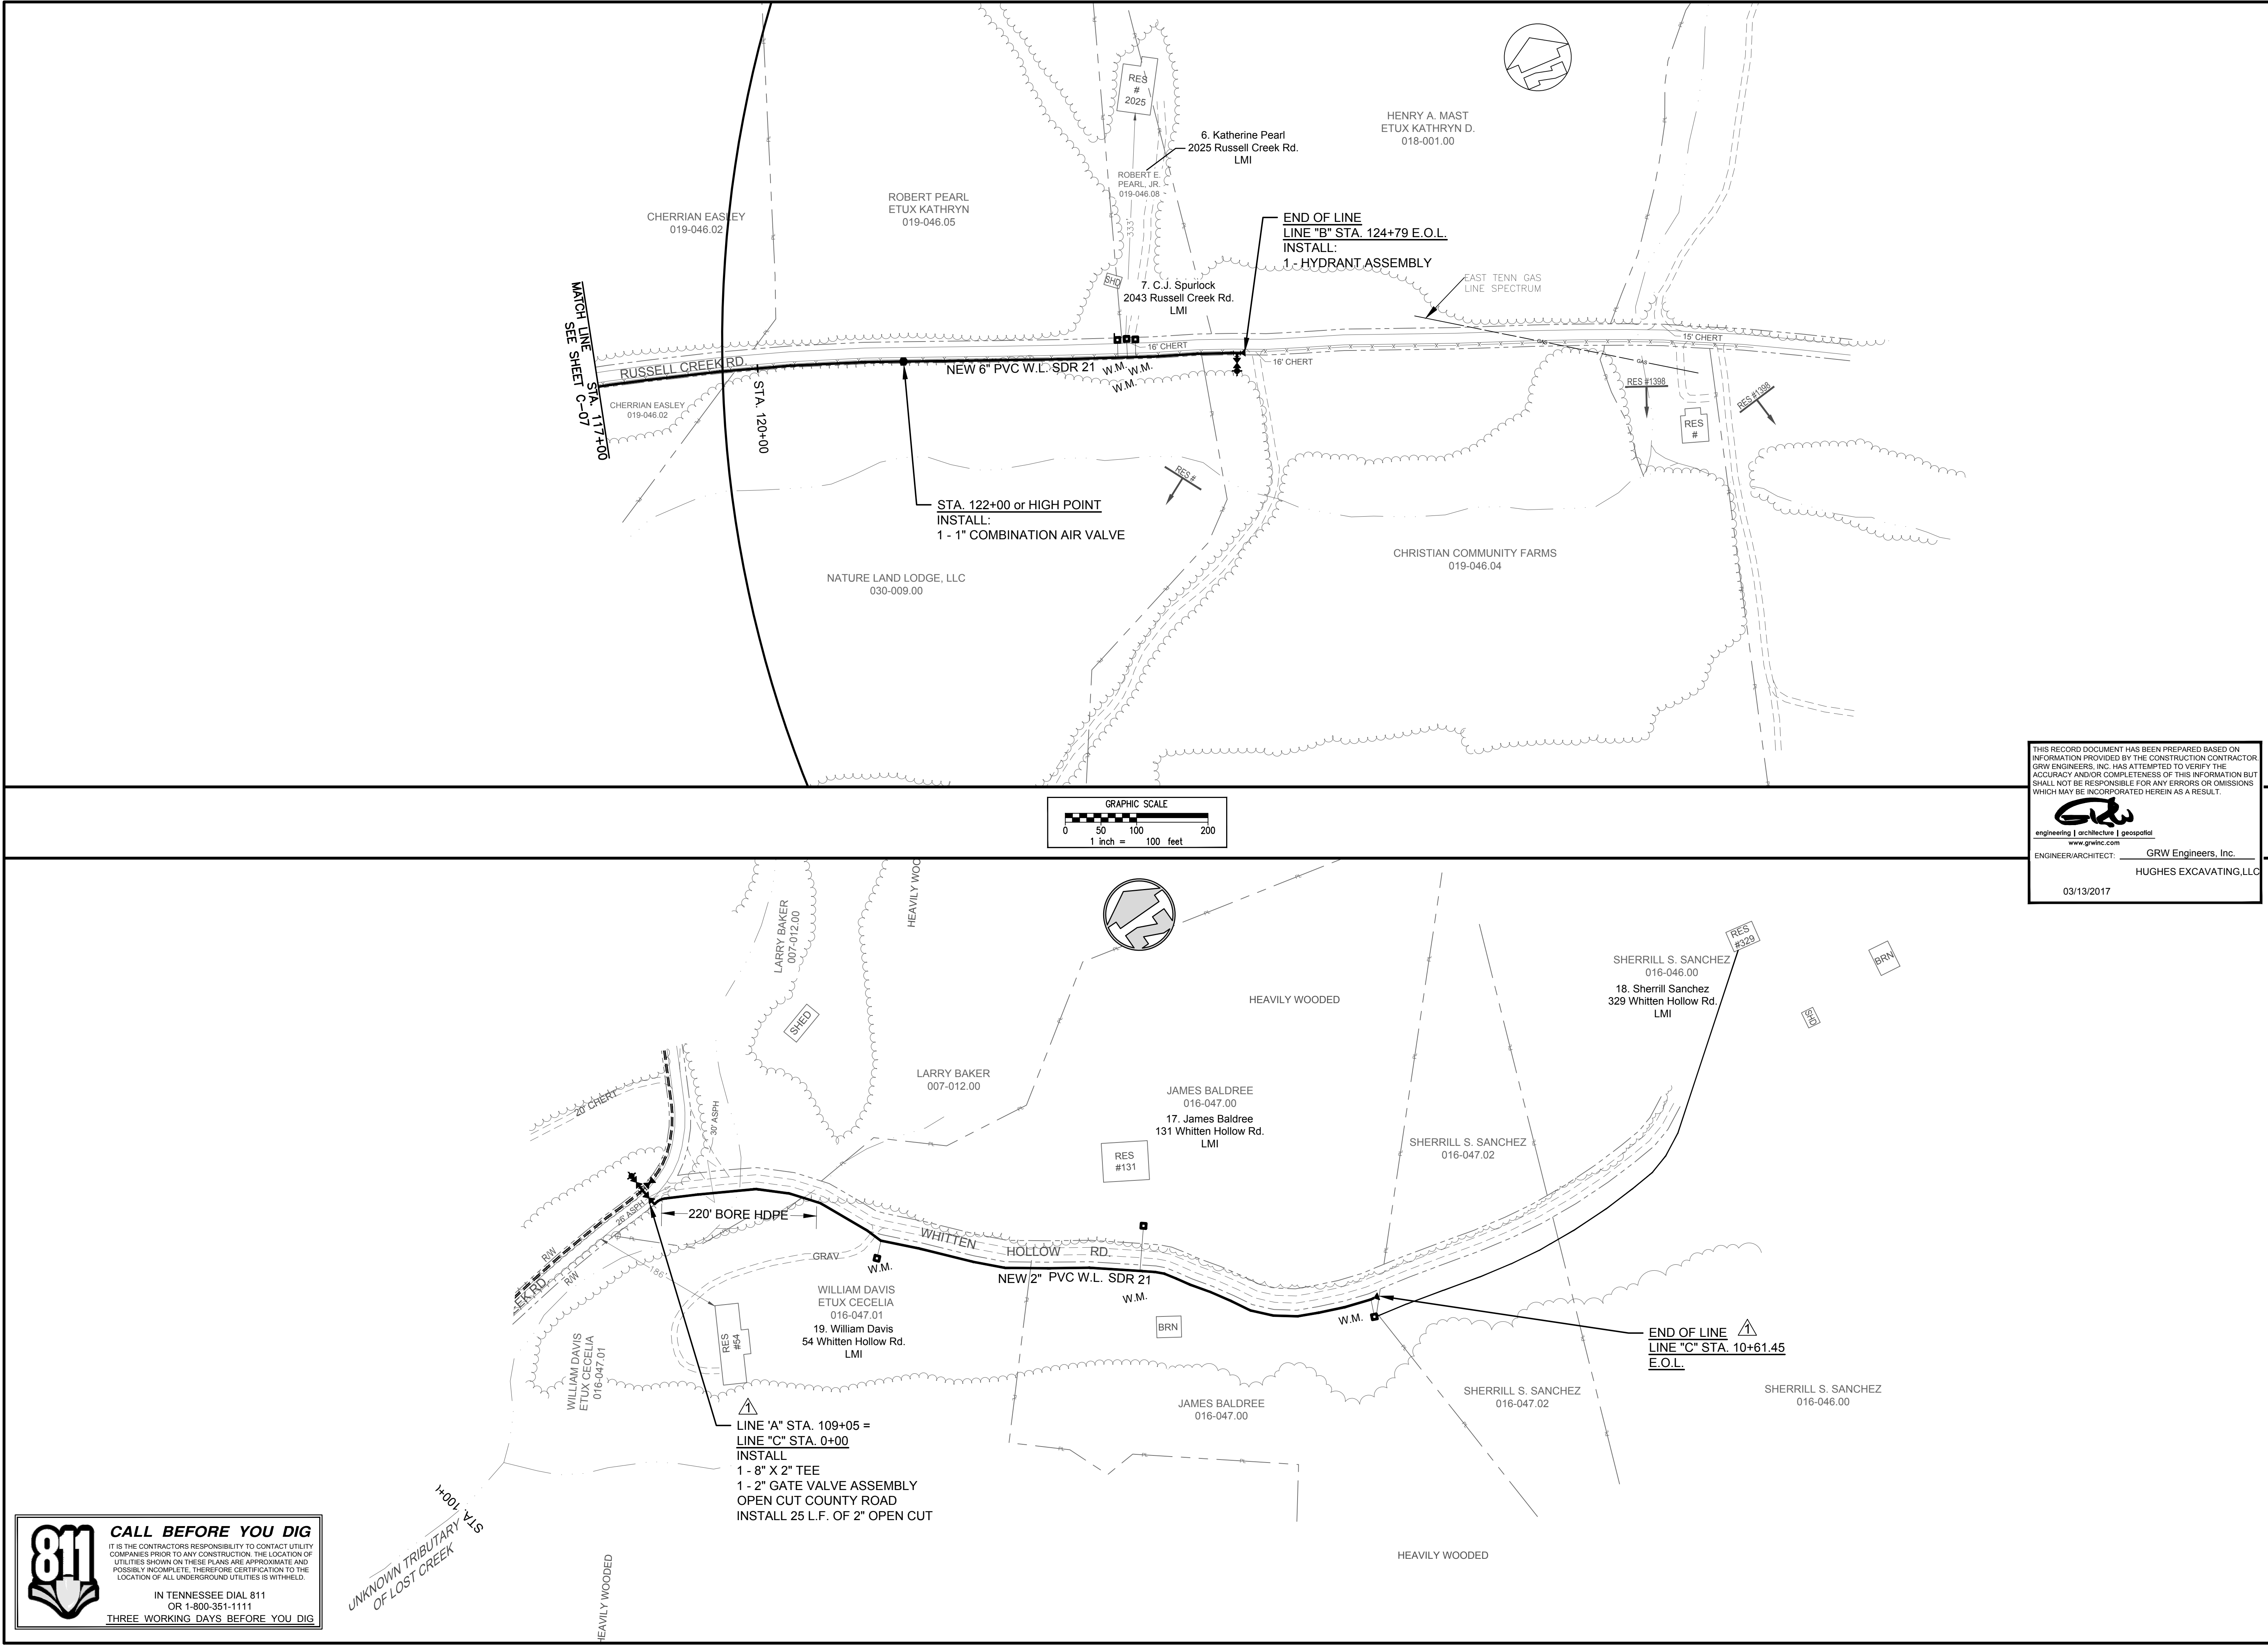

THIS RECORD DOCUMENT HAS BEEN PREPARED BASED ON INFORMATION PROVIDED BY THE CONSTRUCTION CONTRACTOR. GRW ENGINEERS, INC. HAS ATTEMPTED TO VERIFY THE ACCURACY AND/OR COMPLETENESS OF THIS INFORMATION BUT SHALL NOT BE RESPONSIBLE FOR ANY ERRORS OR OMISSIONS WHICH MAY BE INCORPORATED HEREIN AS A RESULT.


engineering | architecture | geospatial
www.grwinc.com

ENGINEER/ARCHITECT: GRW Engineers, Inc.
HUGHES EXCAVATING, LLC

03/13/2017

 **CALL BEFORE YOU DIG**

IT IS THE CONTRACTORS RESPONSIBILITY TO CONTACT UTILITY COMPANIES PRIOR TO ANY CONSTRUCTION. THE LOCATION OF UTILITIES SHOWN ON THESE PLANS ARE APPROXIMATE AND POSSIBLY INCOMPLETE. THEREFORE CERTIFICATION TO THE LOCATION OF ALL UNDERGROUND UTILITIES IS WITHHELD.

IN TENNESSEE DIAL 811
OR 1-800-351-1111
THREE WORKING DAYS BEFORE YOU DIG

This document, originally issued, sealed, and signed by Barry L. Cloyd, Tennessee Professional Engineer, No. 100893, on December 14, 2015, shall not be used in lieu of a certified document.

GRW PROJECT NO. 4420-01

ALL RIGHTS RESERVED. NO PART OF THIS DOCUMENT MAY BE REPRODUCED IN WHOLE OR IN PART WITHOUT THE WRITTEN PERMISSION OF GRW ENGINEERS, INC. AND SHALL NOT BE USED FOR ANY OTHER PROJECT OTHER THAN THIS SPECIFIC PROJECT WITHOUT THE WRITTEN PERMISSION.


engineering | architecture | geospatial
www.grwinc.com

LINE "B" - STA. 117+00 TO STA. 127+80 E.O.L.
LINE "C" - STA. 0+00 TO STA. 13+05 E.O.L.
LOST CREEK RD. & RUSSELL CREEK RD. WATER LINES
CITY OF LOBELVILLE, TENNESSEE

NO.	REVISIONS	DESCRIPTION	DATE	BY	DESIGNED		DRAWN		REVIEWED		APPROVED	
					BLC	DM	DM/LEN	BLC	BLC			
1	ADDED WHITTEN HOLLOW RD. LINE "C" 2/17/16	DM										
	ADDED LMI / NON-LMI RESIDENCES											

DATE: OCTOBER 2015

SCALE: 1" = 100'

SHEET NO. C-08

THIS MARK SHOULD MEASURE EXACTLY 1" WHEN PLOTTED

RECORD DRAWINGS