
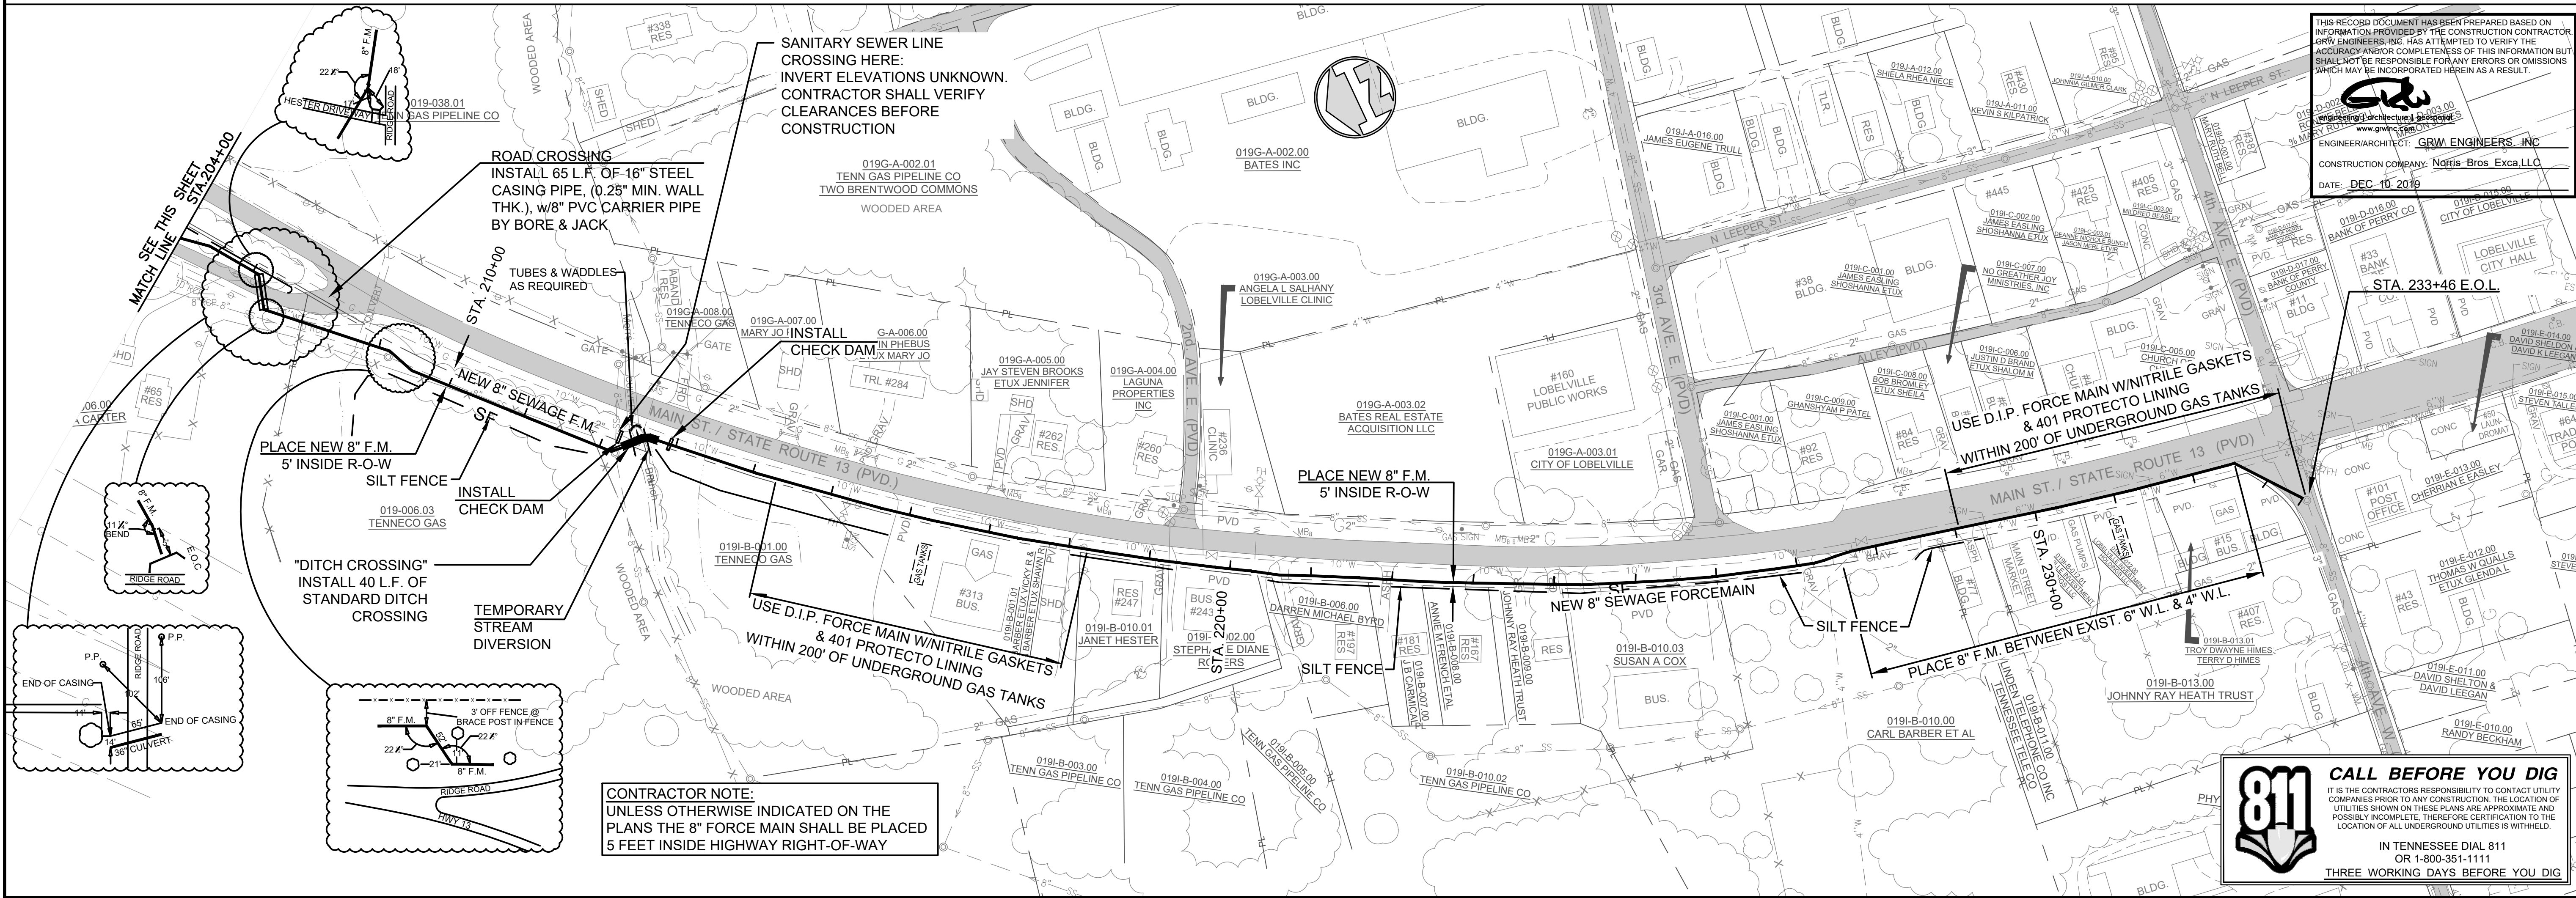


PLOTTED BY: Nazad

PRINTED: 12/10/2019 @ 11:18AM

FILE NAME: G:\4691-Perry Co\Info01-San Sewer\Working Drawings\RECORD DWGS\4691-01_M-101 thru M-104.dwg

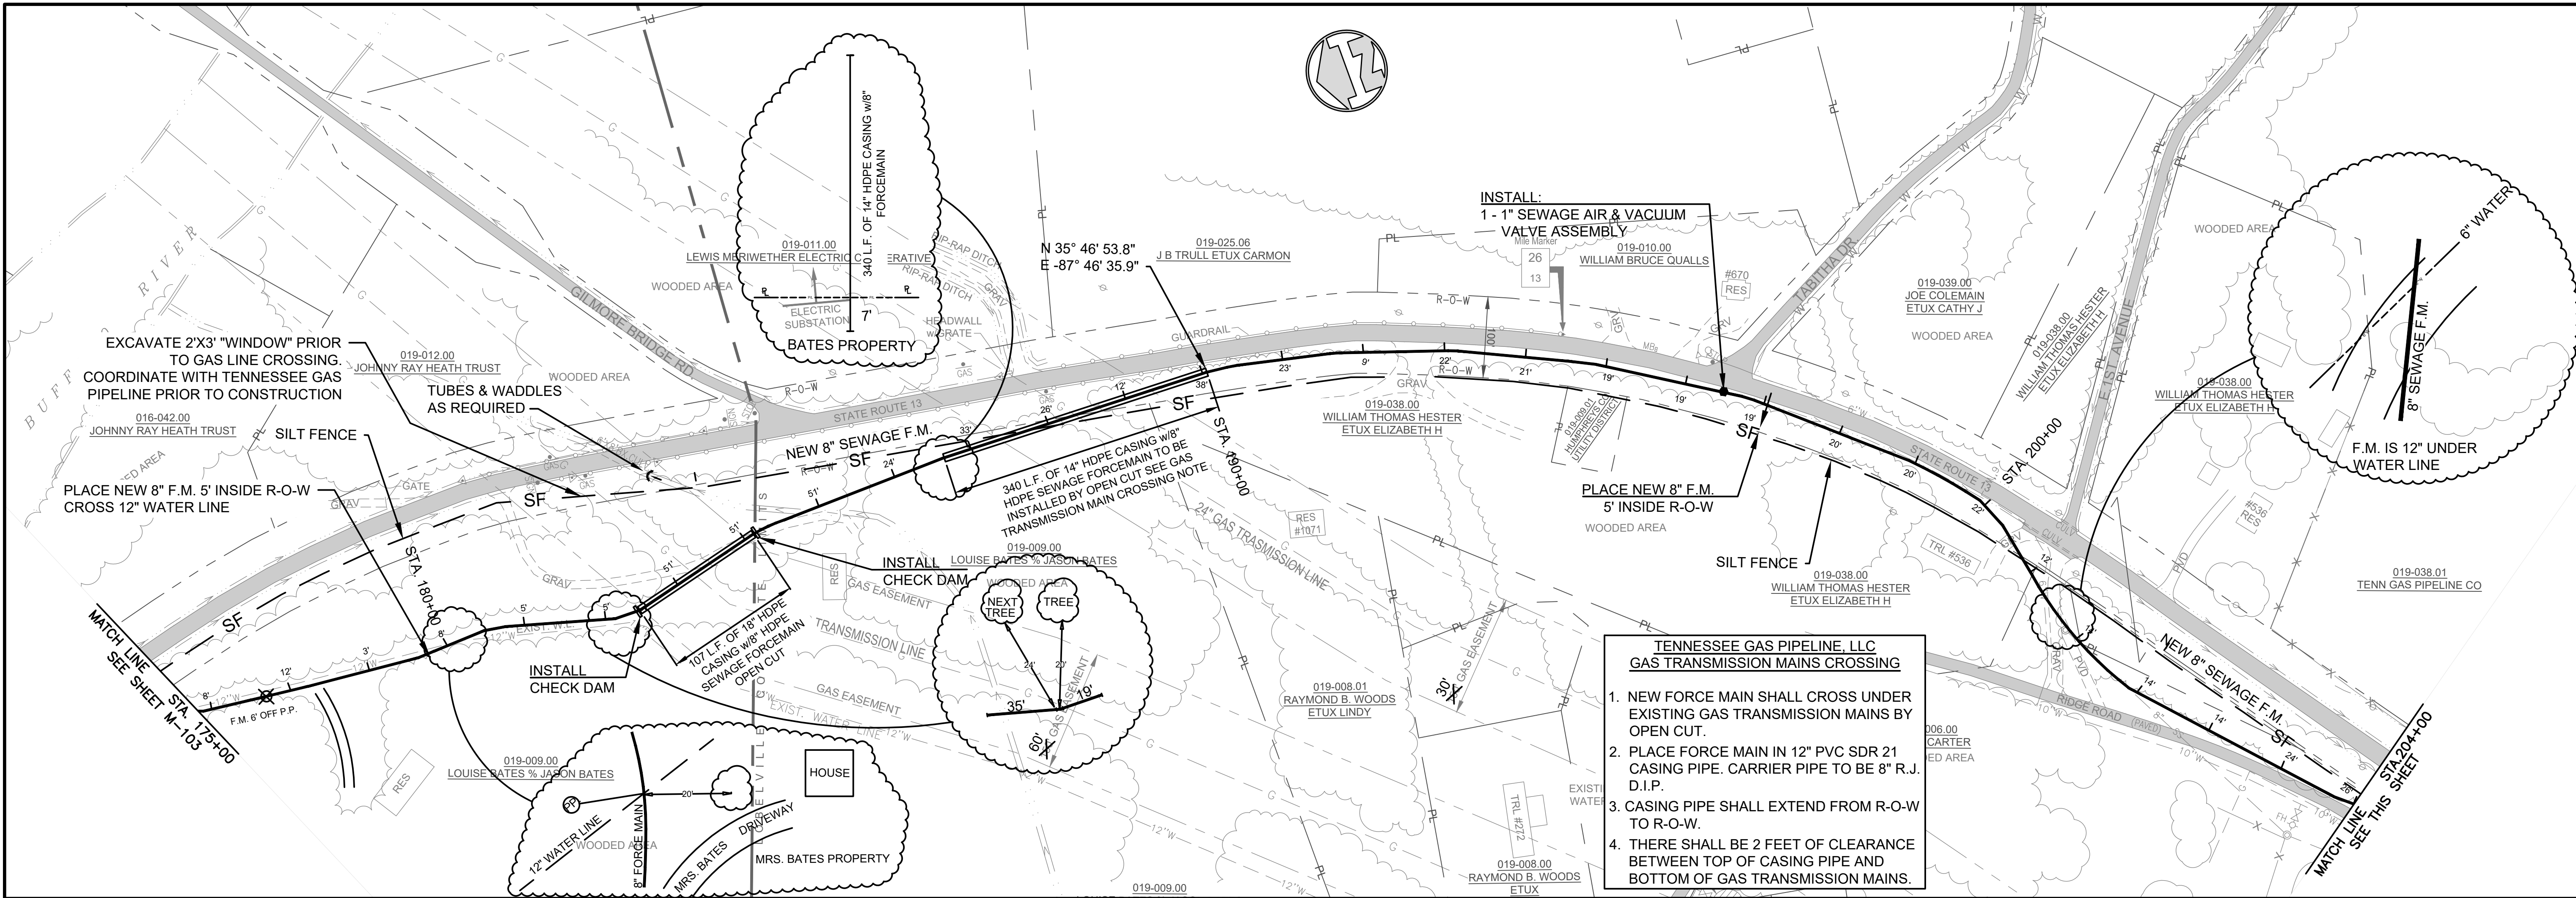

This document, originally issued, sealed, and signed by James W. Hilborn, Tennessee Professional Engineer, No. 16514, on Oct. 2018, shall not be used in lieu of a certified document.

GRW PROJECT NO. 4691-01

ALL RIGHTS RESERVED. NO PART OF THIS DOCUMENT MAY BE REPRODUCED IN WHOLE OR IN PART WITHOUT THE WRITTEN PERMISSION OF GRW ENGINEERS, INC. AND SHALL NOT BE USED FOR ANY OTHER PROJECT OTHER THAN THIS SPECIFIC PROJECT WITHOUT THE WRITTEN PERMISSION.

GRW
engineering | architecture | geospatial
www.grwinc.com

8" SEWAGE FORCE MAIN
STA. 175+00 TO STA. 231+15 E.O.L.
I-40 INDUSTRIAL PARK SITE - PUMP STATION & FORCE MAIN
INDUSTRIAL DEVELOPMENT BOARD OF PERRY CO., TENNESSEE

DESIGNED	DRAWN	REVIEWED	APPROVED
JWH	SH/DM	JWH	JWH

NO.	DATE	DESCRIPTION

DATE: OCTOBER 2018
SCALE: 1" = 100'
SHEET NO.

811
CALL BEFORE YOU DIG
IT IS THE CONTRACTOR'S RESPONSIBILITY TO CONTACT UTILITY COMPANIES PRIOR TO ANY CONSTRUCTION. THE LOCATION OF UTILITIES SHOWN ON THESE PLANS ARE APPROXIMATE AND POSSIBLY INCOMPLETE. THEREFORE CERTIFICATION TO THE LOCATION OF ALL UNDERGROUND UTILITIES IS WITHHELD.
IN TENNESSEE DIAL 811
OR 1-800-351-1111
THREE WORKING DAYS BEFORE YOU DIG

M-104

BID SET