


PLOTTED BY: Nazad

PRINTED: 12/10/2019 @ 11:16AM

FILE NAME: G:\4691-Perry Co\Ind01-San Sewer\Working Drawings\RECORD DWGS\4691-01_G-01.dwg

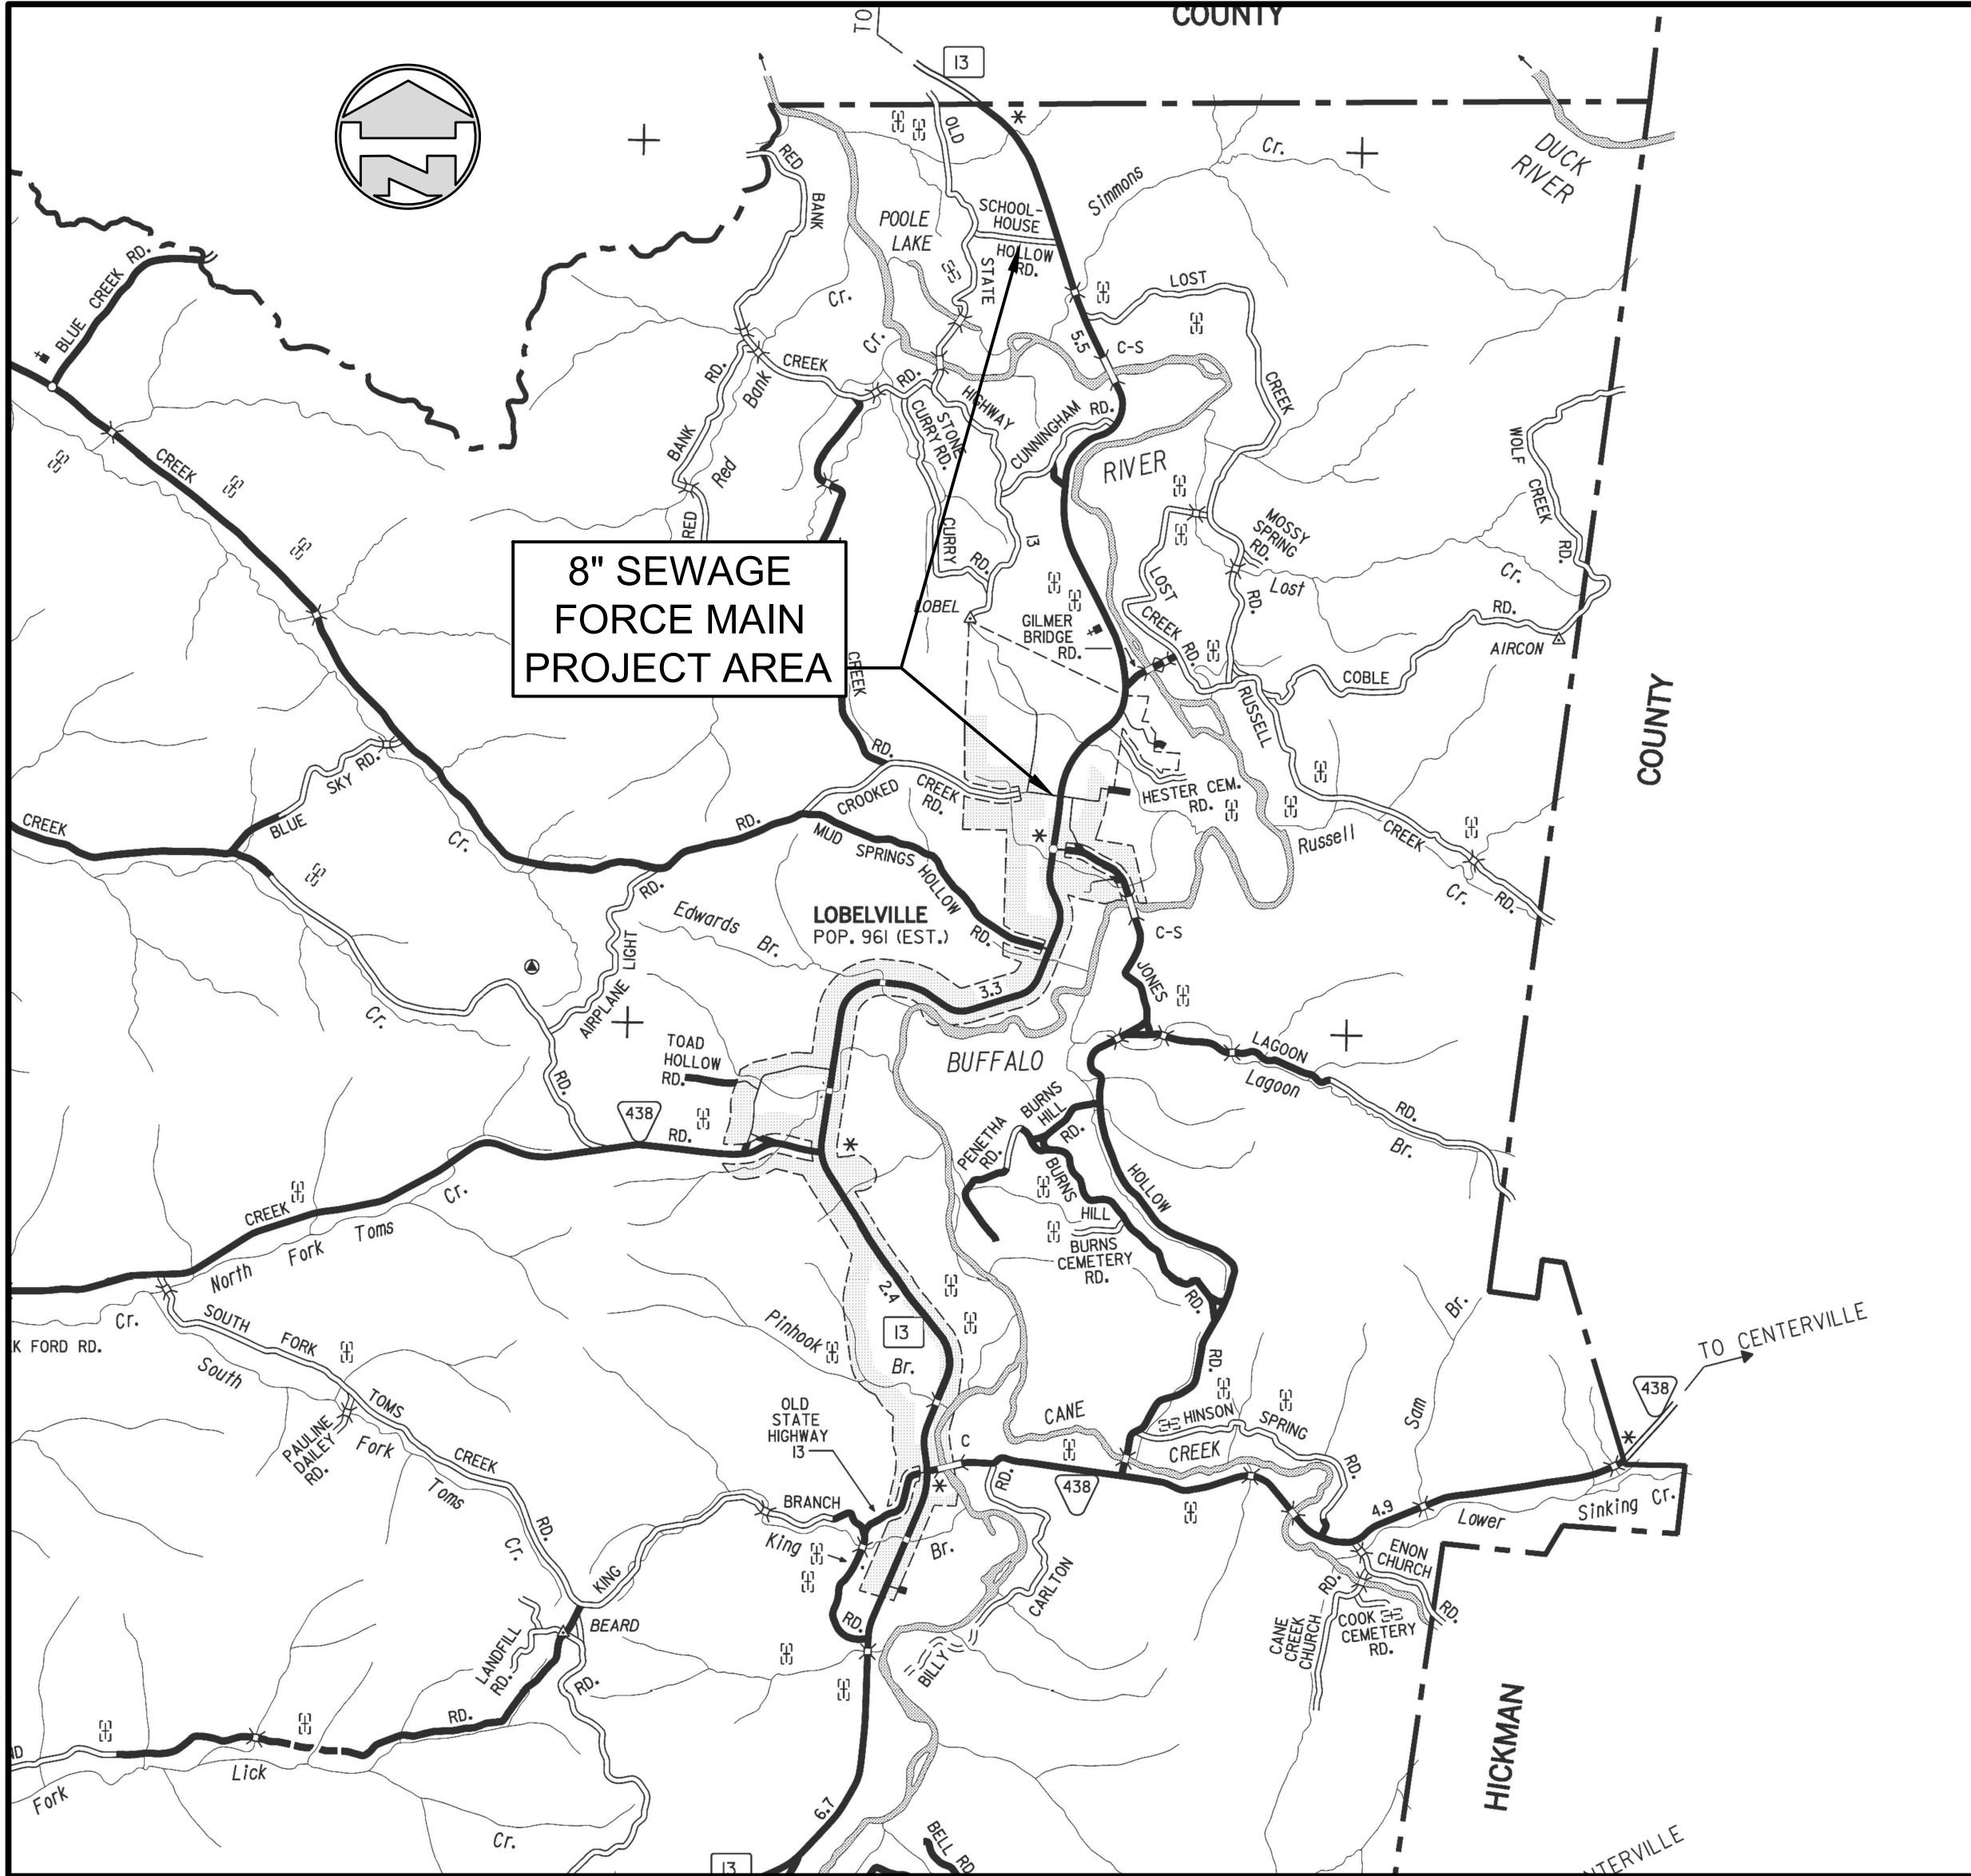

PROJECT LOCATION MAP

SCALE: 1" = 1 MILE

ECOLOGY NOTES:

1. CONTRACTOR SHALL OBSERVE REGULATIONS REGARDING "TAKING" OF LEGALLY PROTECTED STATE OR FEDERALLY LISTED THREATENED OR ENDANGERED AQUATIC FAUNA AND/OR CRITICAL HABITAT.
2. THE STATE THREATENED SADDLED MADTOM (NOTURUS FASCIATUS) HAS BEEN DOCUMENTED APPROXIMATELY 0.2 MILES FROM STREAM CROSSING # 7. THE OTHER PERENNIAL STREAMS TO BE CROSSED, SIMMONS CREEK, BUFFALO RIVER, AND AN UNNAMED TRIBUTARY TO THE BUFFALO RIVER ARE TO BE CROSSED BY HORIZONTAL DIRECTIONAL DRILLING. CROSSINGS OF WET WEATHER CONVEYANCES (CROSSING #2, CROSSING #5, CROSSING #6, AND CROSSING #8) WILL BE CONDUCTED BY OPEN CUT TRENCHING. THE STATE THREATENED SADDLED MADTOM (NOTURUS FASCIATUS) AND THE STATE THREATENED COPPERCHEEK DARTER (ETHEOSTOMA AQUALI) HAVE BEEN DOCUMENTED WITHIN THE REACH OF THE BUFFALO RIVER AND ITS TRIBUTARIES WHERE THESE CROSSINGS WILL OCCUR.
3. CONTACT THE FOLLOWING AGENCIES PRIOR TO WORK UNDERNEATH BUFFALO RIVER:

ROBBIE SYKES
 SUPERVISORY FISH AND WILDLIFE BIOLOGIST
 U.S. FISH AND WILDLIFE SERVICE
 446 NEAL STREET
 COOKEVILLE, TN 38501
 tele. 931-525-4979

EROSION & SEDIMENT CONTROL NOTES:

1. ALL WORK SHALL BE DONE IN ACCORDANCE WITH THE STORM WATER POLLUTION PREVENTION PLAN (SWPPP).
2. NO WORK MAY PROCEED UNTIL A NOTICE OF COVERAGE (NOC) HAS BEEN ISSUED BY THE STATE OF TENNESSEE DEPARTMENT OF ENVIRONMENT AND CONSERVATION.
3. THE SWPPP SHALL BE AVAILABLE AT THE SITE FOR REVIEW AT ALL TIMES.
4. AT A MINIMUM, THE CONTRACTOR SHALL INSTALL SILT FENCE ON THE DOWNHILL SIDE OF THE PROPOSED CONSTRUCTION AREA.
5. CONTRACTOR SHALL PROVIDE DITCH CHECKS AS REQUIRED.
6. CONTRACTOR SHALL FURNISH AND INSTALL TEMPORARY EROSION CONTROL BLANKET/MATTING ON ALL SLOPES GREATER THAN 4:1 UNLESS NOTED OTHERWISE.
7. ALL AREAS TO REMAIN BARE MORE THAN 15 DAYS SHALL BE TEMPORARILY STABILIZED IN ACCORDANCE WITH THE CURRENT BEST MANAGEMENT PRACTICES (BMP'S).
8. TDEC REGULATIONS REQUIRE THAT STABILIZATION MEASURES BE INITIATED WITHIN 7 DAYS AFTER CONSTRUCTION OR LAND DISTURBANCE ACTIVITIES HAVE BEEN TEMPORARILY OR PERMANENTLY TERMINATED.
9. THE ONLY EXCEPTIONS, FOR NOTE 8, ARE FOR CASES WHERE SNOW COVER, FROZEN GROUND, OR EXCESSIVELY WET CONDITIONS PRECLUDE INITIATION OF STABILIZATION OR WHERE LAND DISTURBANCE ACTIVITIES WILL BE RESUMED ON THAT PORTION OF THE SITE WITHIN 15 DAYS.
10. EROSION CONTROL MEASURES SHALL BE CHECKED AND REPAIRED IF NECESSARY AT LEAST TWICE EACH CALENDAR WEEK IN ACCORDANCE WITH THE SWPPP. INSPECTIONS TO BE SPACED 72 HOURS APART.
11. ALL EROSION CONTROL MEASURES UTILIZED WITHIN STATE OF TENNESSEE ROW'S SHALL MEET OR EXCEED THE TDOT REQUIREMENTS.

EXISTING	NEW	
		PUMP STATION
		SANITARY SEWER / FORCE MAIN
		SANITARY SEWER MANHOLE
		NEW SEWER DROP MANHOLE
		PRESSURE REDUCING VALVE
		AIR RELEASE / AIR VACUUM VALVE
		CASING PIPE
		CONC. ENCASEMENT / CREEK CROSSING
		CULVERT PIPE
		EXIST. WATER LINE
		GAS LINE
		GAS VALVE
		UNDERGROUND TELEPHONE LINE
		TELEPHONE PEDESTAL
		UNDERGROUND ELECTRIC LINE
		POWER POLE
		GUY POLE
		LIGHT POLE
		MAIL BOX
		SIGN
		HIGHWAY / ROAD SIGN
		GAS LINE MARKER
		FIBER OPTIC CABLE / TELEPHONE MARKER
		TREE
		UNDERGROUND CABLE TV
		STORM DRAIN LINE
		STORM DRAIN DROP INLET
		HEADWALL OR INLET WALL
		CREEK OR DITCH
		FENCE ROW
		PROPERTY LINE/RIGHT OF WAY
		PARCEL NUMBER
		PROPERTY CORNER
		IRON PIN

GENERAL NOTES

1. THE CONTRACTOR SHALL RESTORE ALL CULVERTS, FENCES, WALLS, SMALL ORNAMENTAL TREES, CULTIVATED SHRUBS, FLOWERS, SIGNS, LIGHTS AND POWER POLES, STREET MARKERS, MAIL BOXES, WATER AND GAS LINES, WATER AND GAS METERS AND BOXES INCLUDING SHUT-OFFS, AND LAWNS DISTURBED BY CONSTRUCTION OPERATIONS TO THEIR ORIGINAL CONDITIONS. THE COST OF THIS WORK SHALL BE MERGED IN THE UNIT BID AND CONTRACT PRICES FOR THE PROPOSED WORK.
2. WHERE IN EASEMENTS THE CONTRACTOR SHALL PROTECT AND RESTORE SAID PROPERTY TO CONDITION SIMILAR OR EQUAL TO THAT EXISTING AT THE COMMENCEMENT OF CONSTRUCTION, EXCEPT AS NOTED.
3. THE LOCATION OF EXISTING UNDERGROUND UTILITIES ARE SHOWN IN AN APPROXIMATE WAY ONLY. THE CONTRACTOR SHALL DETERMINE THE EXACT LOCATION OF ALL EXISTING UTILITIES BEFORE COMMENCING WORK IN EACH AREA. HE AGREES TO BE FULLY RESPONSIBLE FOR ANY AND ALL DAMAGES WHICH MIGHT BE CAUSED BY HIS FAILURE TO EXACTLY LOCATE AND PRESERVE ANY AND ALL UTILITIES. BEFORE CONSTRUCTION, CONTRACTOR SHALL CONTACT :
 TENNESSEE811
 DIAL 811 (OR 1-800-351-1111)
 72 HOURS NOTICE
4. CONTRACTOR SHALL NOT PLACE ANY VALVES OR OTHER ABOVE GRADE DEVICES IN ANY DITCH LINE ON STATE HIGHWAY RIGHT OF WAY.
5. IF ANY EXISTING STORM SEWERS ARE SUBSTANTIALLY DAMAGED AS DETERMINED BY THE A/E AND OR OWNER, THE REPAIR SHALL BE MADE WITH R.C.P. PIPE FROM STRUCTURE-TO-STRUCTURE. PIPE SIZE SHALL BE EQUAL TO EXISTING.
6. SUFFICIENT PRECAUTIONS SHALL BE TAKEN DURING CONSTRUCTION TO MINIMIZE THE RUN-OFF OF POLLUTING SUBSTANCES SUCH AS SILT, CLAY, FUELS, OILS, BITUMENS, CALCIUM CHLORIDE, OR OTHER POLLUTING MATERIALS HARMFUL TO HUMANS, FISH OR OTHER LIFE, INTO THE SUPPLIES AND SURFACE WATERS OF THE STATE. CONTROL MEASURES MUST BE ADEQUATE TO ASSURE THAT LOCAL, STATE AND FEDERAL LAWS AND REGULATIONS ARE MET. THE CONTRACTOR IS SOLELY RESPONSIBLE FOR ENSURING THAT THE LAWS AND REGULATIONS ARE MET AND IS RESPONSIBLE FOR ENSURING THAT CONSTRUCTION DOES NOT HARM THE WATERS OF TENNESSEE. THE PROTECTION OF THE SITE SHALL CONTINUE THROUGHOUT THE CONSTRUCTION PERIOD. SPECIAL PRECAUTIONS SHALL BE TAKEN IN THE USE OF CONSTRUCTION EQUIPMENT TO PREVENT OPERATIONS WHICH PROMOTE EROSION.
7. THE TEMPORARY POLLUTION CONTROL PROVISIONS SHALL BE COORDINATED WITH THE PERMANENT EROSION CONTROL MEASURES, TO ENSURE ECONOMICAL, EFFECTIVE, AND CONTINUOUS EROSION CONTROL THROUGHOUT THE CONSTRUCTION AND POST-CONSTRUCTION PERIOD OF THE PROJECT. NATURAL COVER SHOULD BE MAINTAINED AS LONG AS POSSIBLE AND GRADED AREAS SHOULD BE STABILIZED AS SOON AS POSSIBLE.
8. THE CONTRACTOR SHALL OBTAIN ALL PERMITS FROM THE APPROPRIATE FEDERAL, STATE, COUNTY AND/OR LOCAL AGENCIES TO CROSS ALL HIGHWAYS, STREETS, STREAMS, EASEMENTS, ETC...
9. STATE HIGHWAY RIGHT-OF-WAY INFORMATION PROVIDED BY THE STATE OF TENNESSEE DEPARTMENT OF TRANSPORTATION. QUESTIONS CONCERNING R-O-W LOCATION ON ANY STATE HIGHWAY SHOULD BE REFERRED TO THE APPROPRIATE REGIONAL OFFICE OF THE STATE OF TENNESSEE DEPARTMENT OF TRANSPORTATION:
10. PROPERTY OWNERS AND PARCEL INFORMATION OBTAINED FROM THE TENNESSEE COMPTROLLER OF THE TREASURY REAL ESTATE ASSESSMENT DATA WEBSITE (http://www.assessment.state.tn.us/).
11. SEWER LINE INFORMATION PROVIDED BY THE CITY OF LOBELVILLE.
12. COUNTY ROAD RIGHT-OF-WAY INFORMATION PROVIDED BY THE COUNTY HIGHWAY DEPARTMENT. QUESTIONS CONCERNING R-O-W LOCATION ON ANY COUNTY ROAD SHOULD BE REFERRED TO THE COUNTY HIGHWAY DEPARTMENT.

THIS RECORD DOCUMENT HAS BEEN PREPARED BASED ON INFORMATION PROVIDED BY THE CONSTRUCTION CONTRACTOR GRW ENGINEERS, INC. HAS ATTEMPTED TO VERIFY THE ACCURACY AND/OR COMPLETENESS OF THIS INFORMATION BUT SHALL NOT BE RESPONSIBLE FOR ANY ERRORS OR OMISSIONS WHICH MAY BE INCORPORATED HEREIN AS A RESULT.


engineering | architecture | geospatial

www.grwinc.com

ENGINEER/ARCHITECT: GRW ENGINEERS, INC.

CONSTRUCTION COMPANY: Norris Bros Exca,LLC

DATE: DEC 10 2019

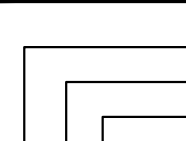SAMPLE SHEET NUMBER	DISCIPLINE LETTER	SHEET TYPE
 <p>DISCIPLINE LETTER STRUCTURE NUMBER SHEET TYPE SHEET NUMBER</p> <p>A-1-101</p>	G GENERAL	0 GENERAL
	C CIVIL	1 PLANS
	M SANITARY	2 ELEVATIONS
	L LANDSCAPE	3 SECTIONS
	S STRUCTURAL	4 ENLARGED PLANS
	A ARCHITECTURAL	5 DETAILS
	I INTERIORS	6 SCHEDULES & DIAGRAMS
	F FIRE PROTECTION	7 PLAN & PROFILE
	P PLUMBING	
	H HVAC	
E ELECTRICAL		
I INSTRUMENTATION & CONTROLS		

This document, originally issued, sealed, and signed by James W. Hillborn, Tennessee Professional Engineer, No. 16514, on Oct. 2018, shall not be used in lieu of a certified document.

GRW PROJECT NO. 4691-01

ALL RIGHTS RESERVED. NO PART OF THIS DOCUMENT MAY BE REPRODUCED IN WHOLE OR IN PART WITHOUT THE WRITTEN PERMISSION OF GRW ENGINEERS, INC.

engineering | architecture | geospatial

www.grwinc.com

GENERAL NOTES, PROJECT LOCATION MAP, LEGEND & EROSION SEDIMENT CONTROL NOTES

I-40 INDUSTRIAL PARK SITE - 8" FORCE MAIN

INDUSTRIAL DEVELOPMENT BOARD OF PERRY CO., TENNESSEE

DESIGNED	DRAWN	REVIEWED	APPROVED
JWH	SH	JWH	JWH

REVISIONS

NO	DATE	DESCRIPTION

DATE: OCTOBER 2018

SCALE: AS NOTED

SHEET NO. G-01

THIS MARK SHOULD MEASURE EXACTLY 1" WHEN PLOTTED

RECORD DRAWINGS