



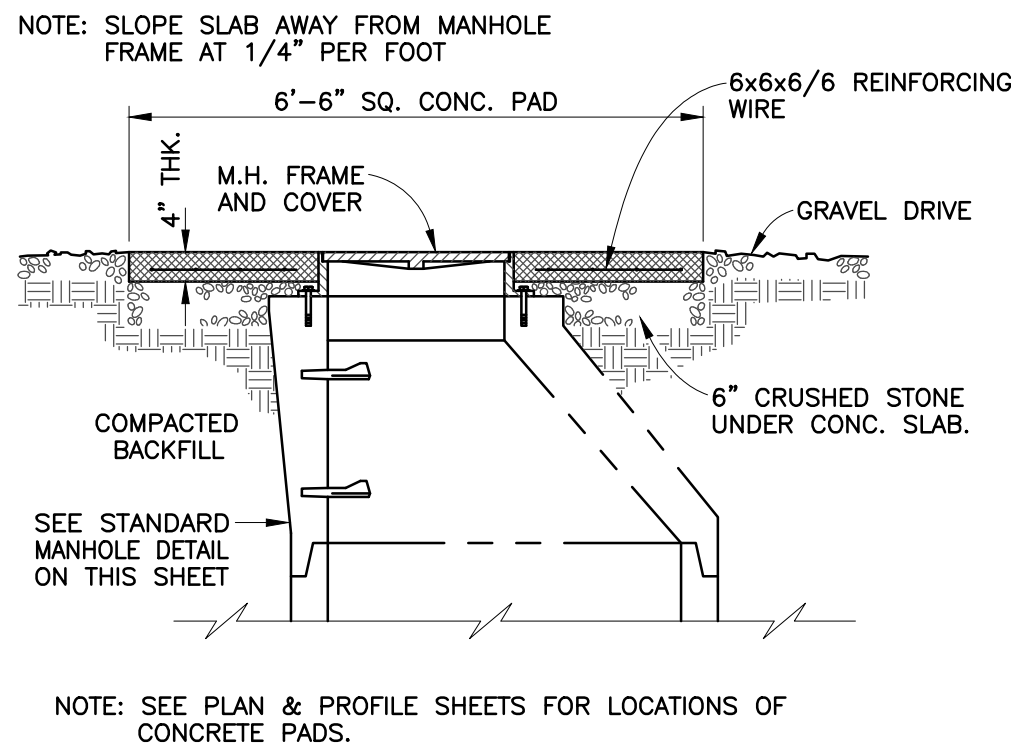


CONCRETE PAD @ MANHOLE IN GRAVEL DRIVE

NOT TO SCALE


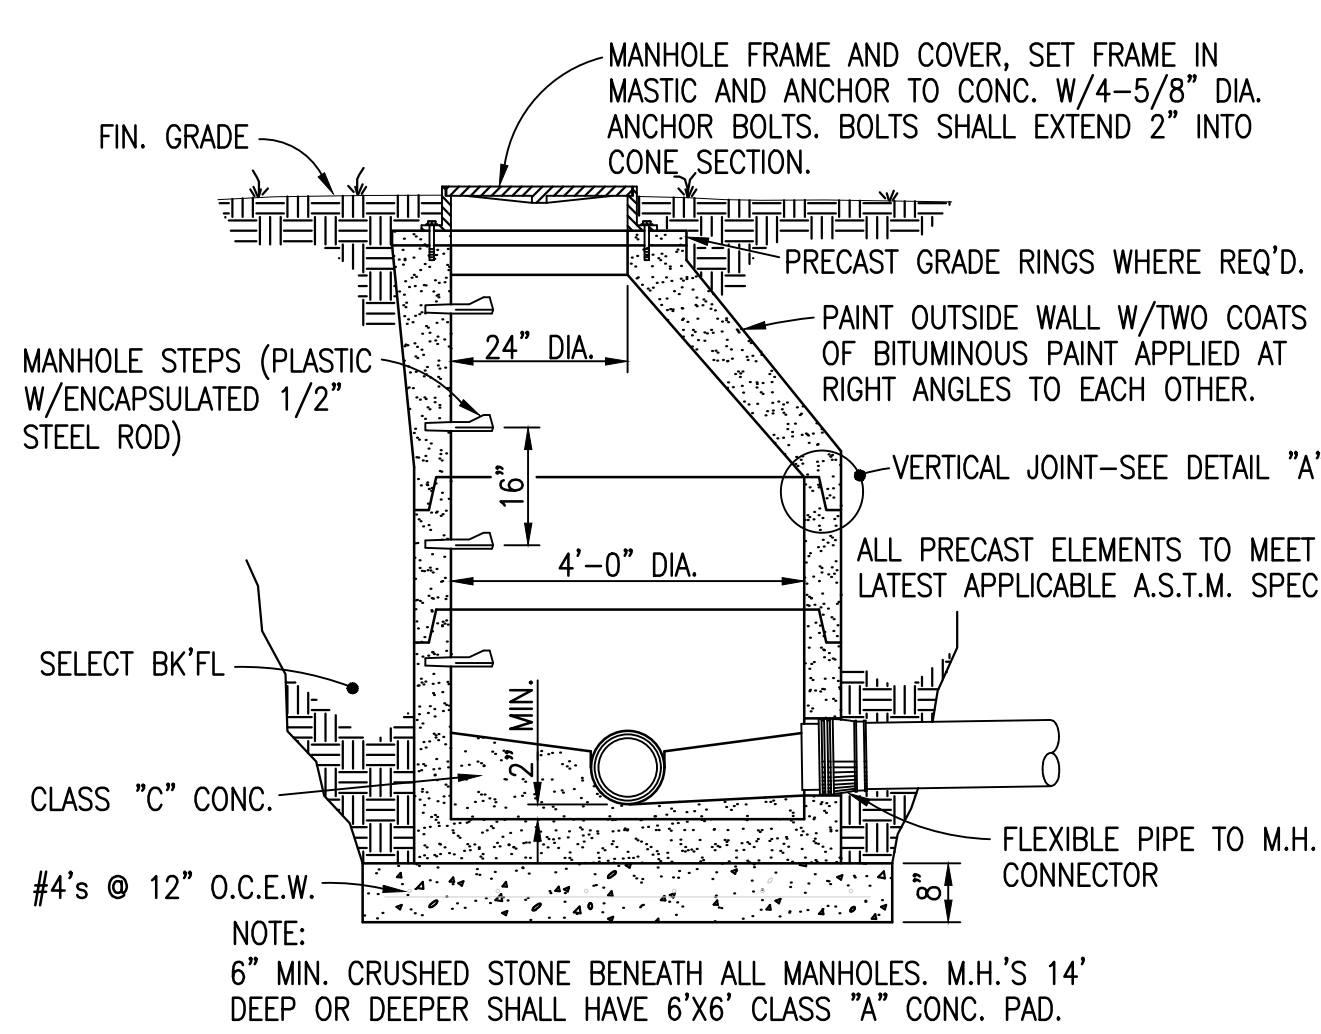


SECTION A - A

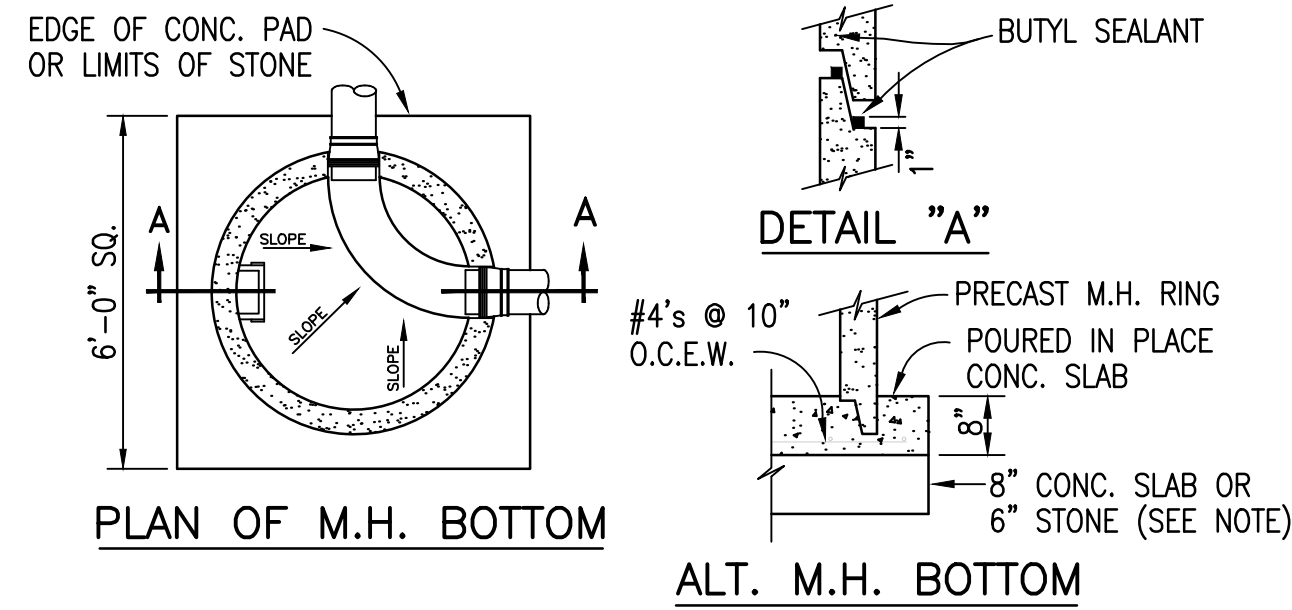





STANDARD MANHOLE

NOT TO SCALE

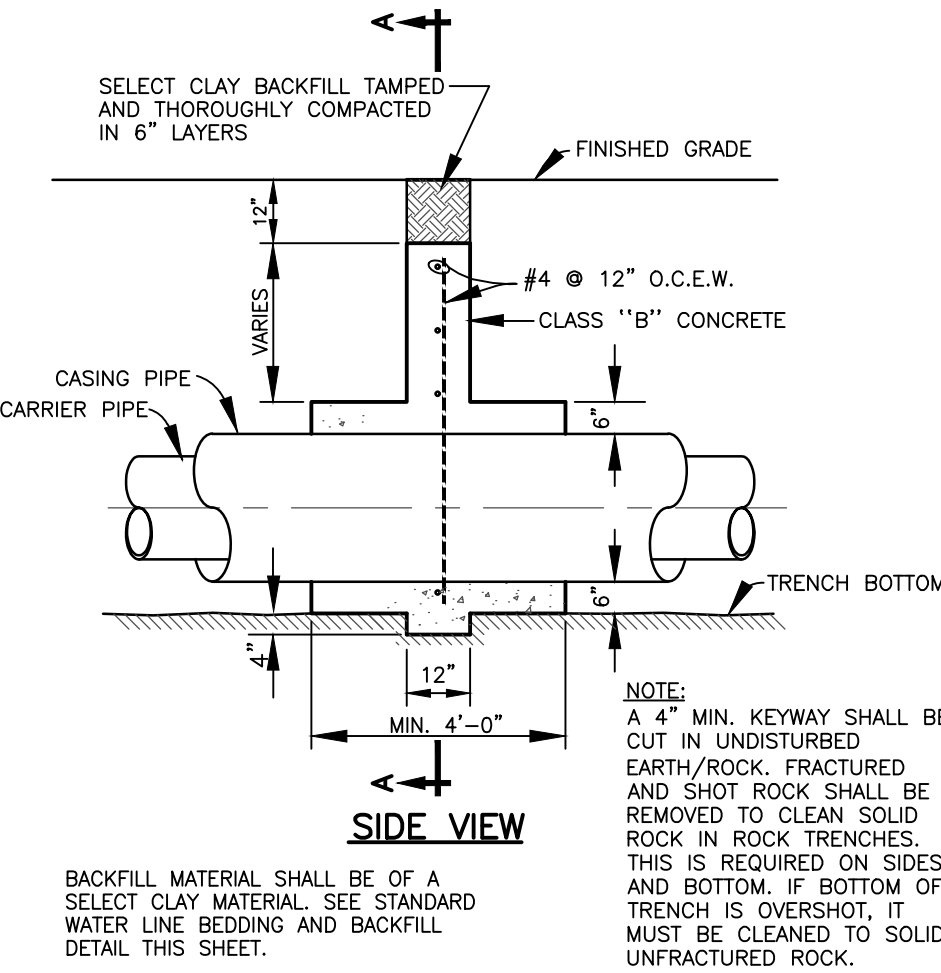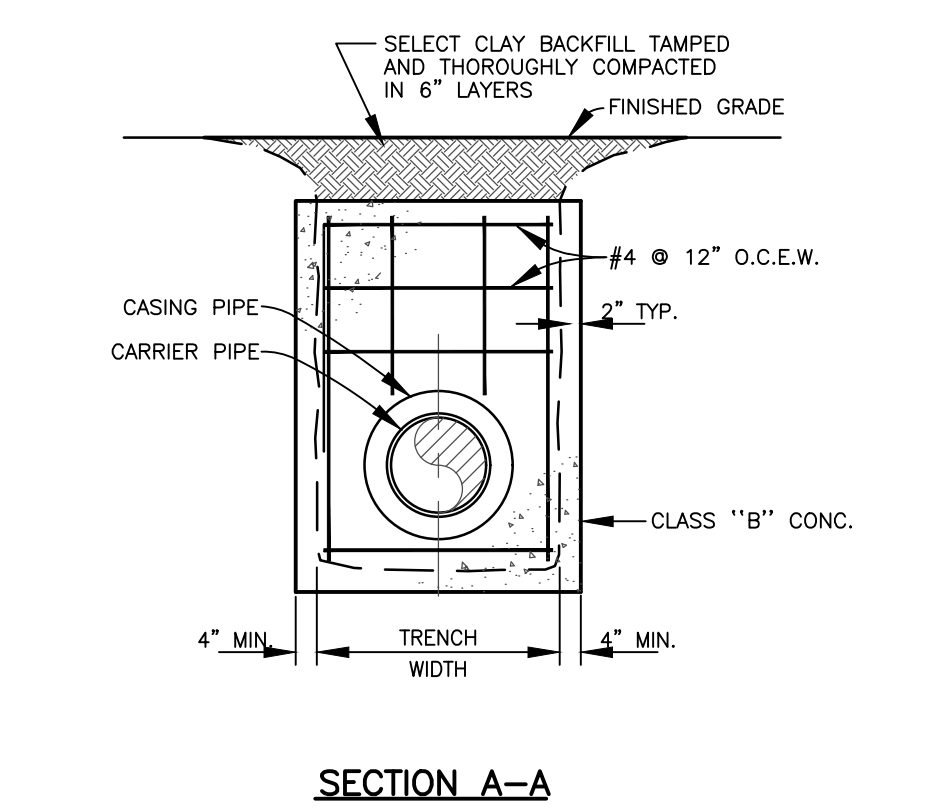

CONCRETE CHECK DAM

NOT TO SCALE

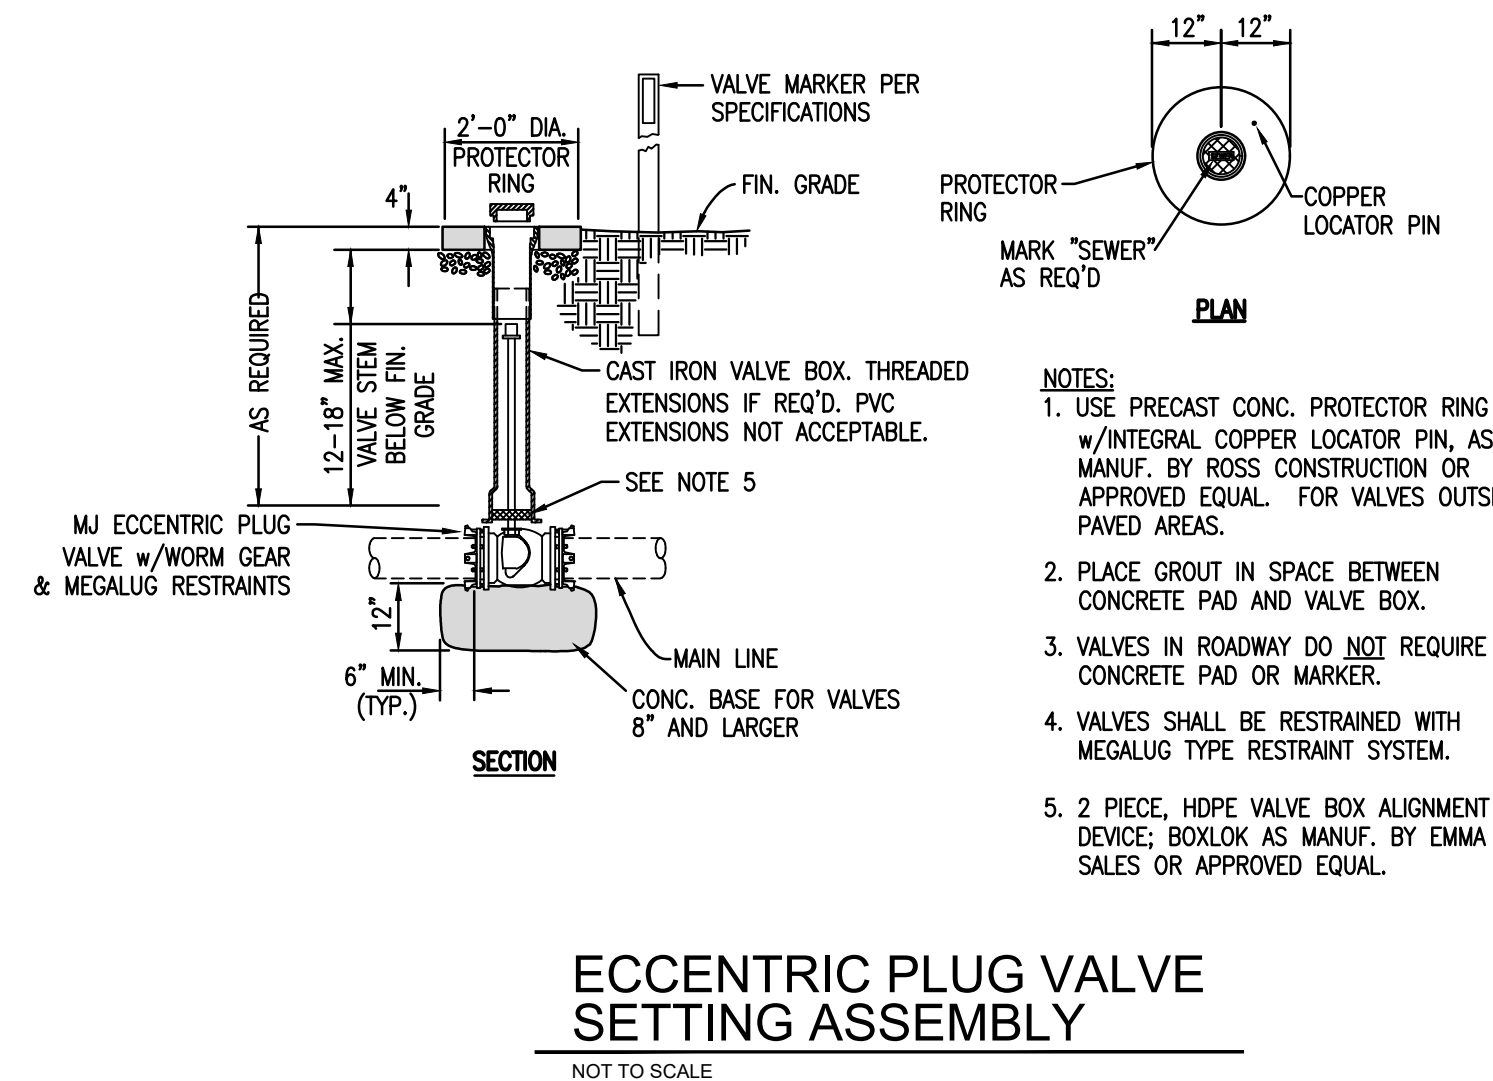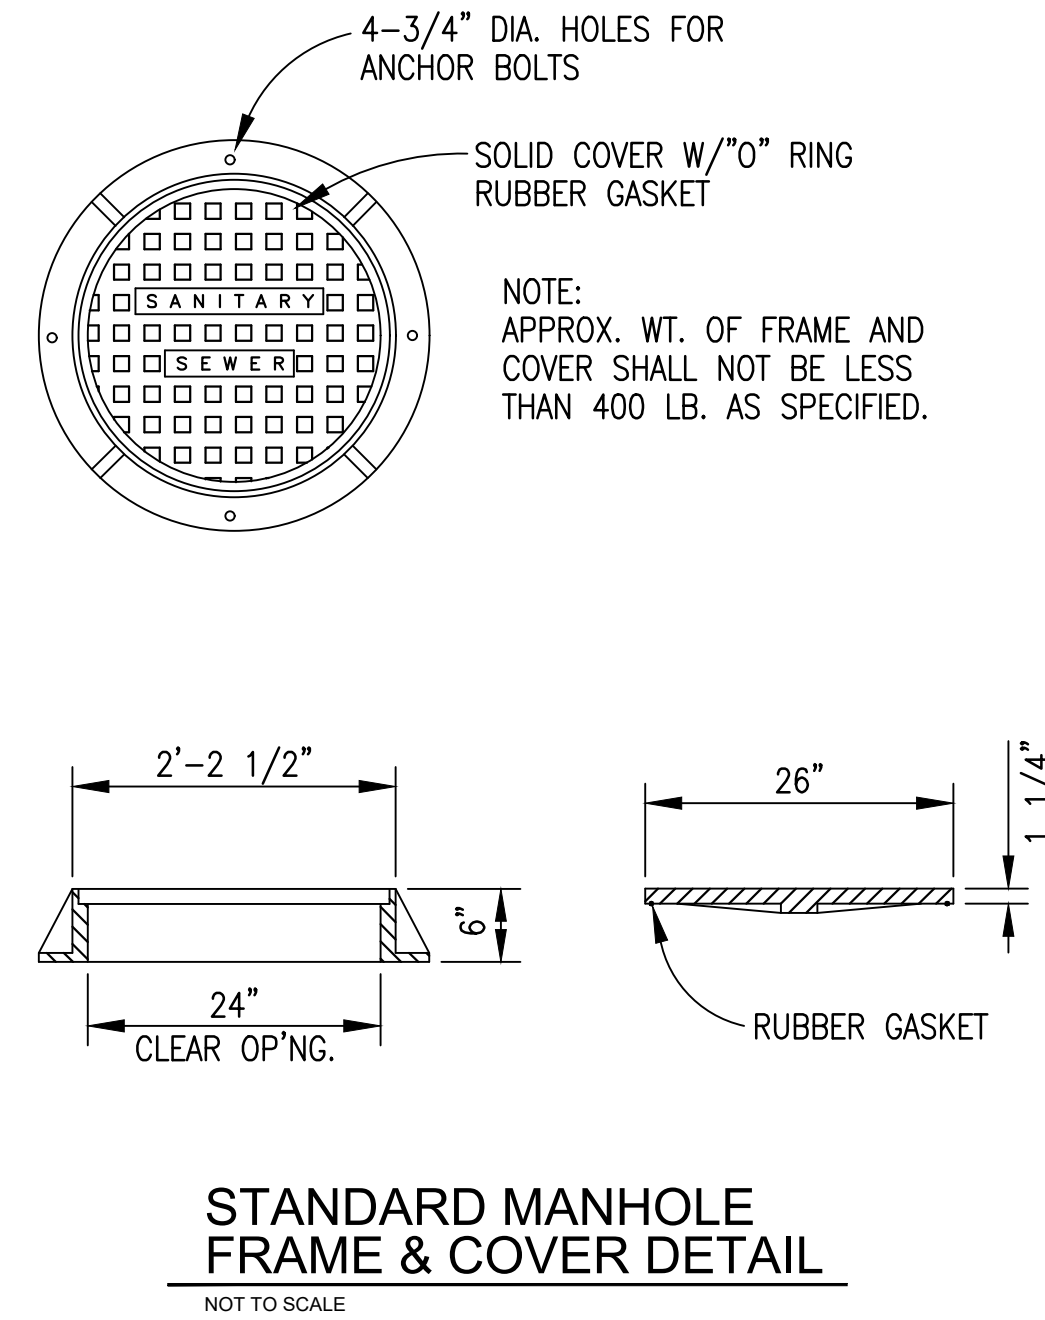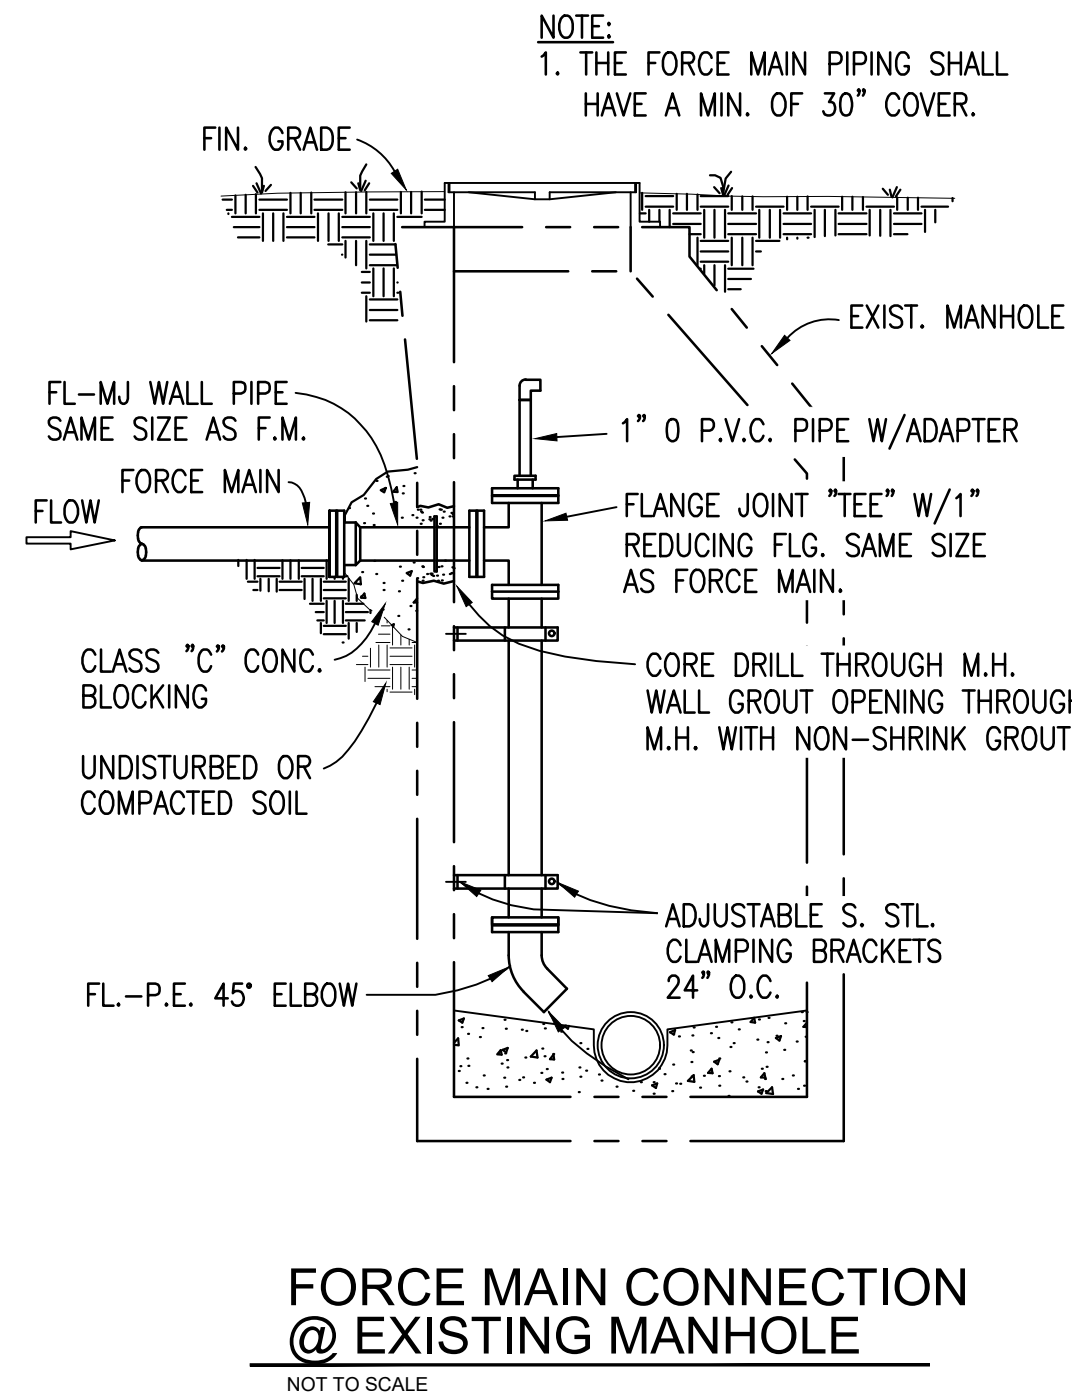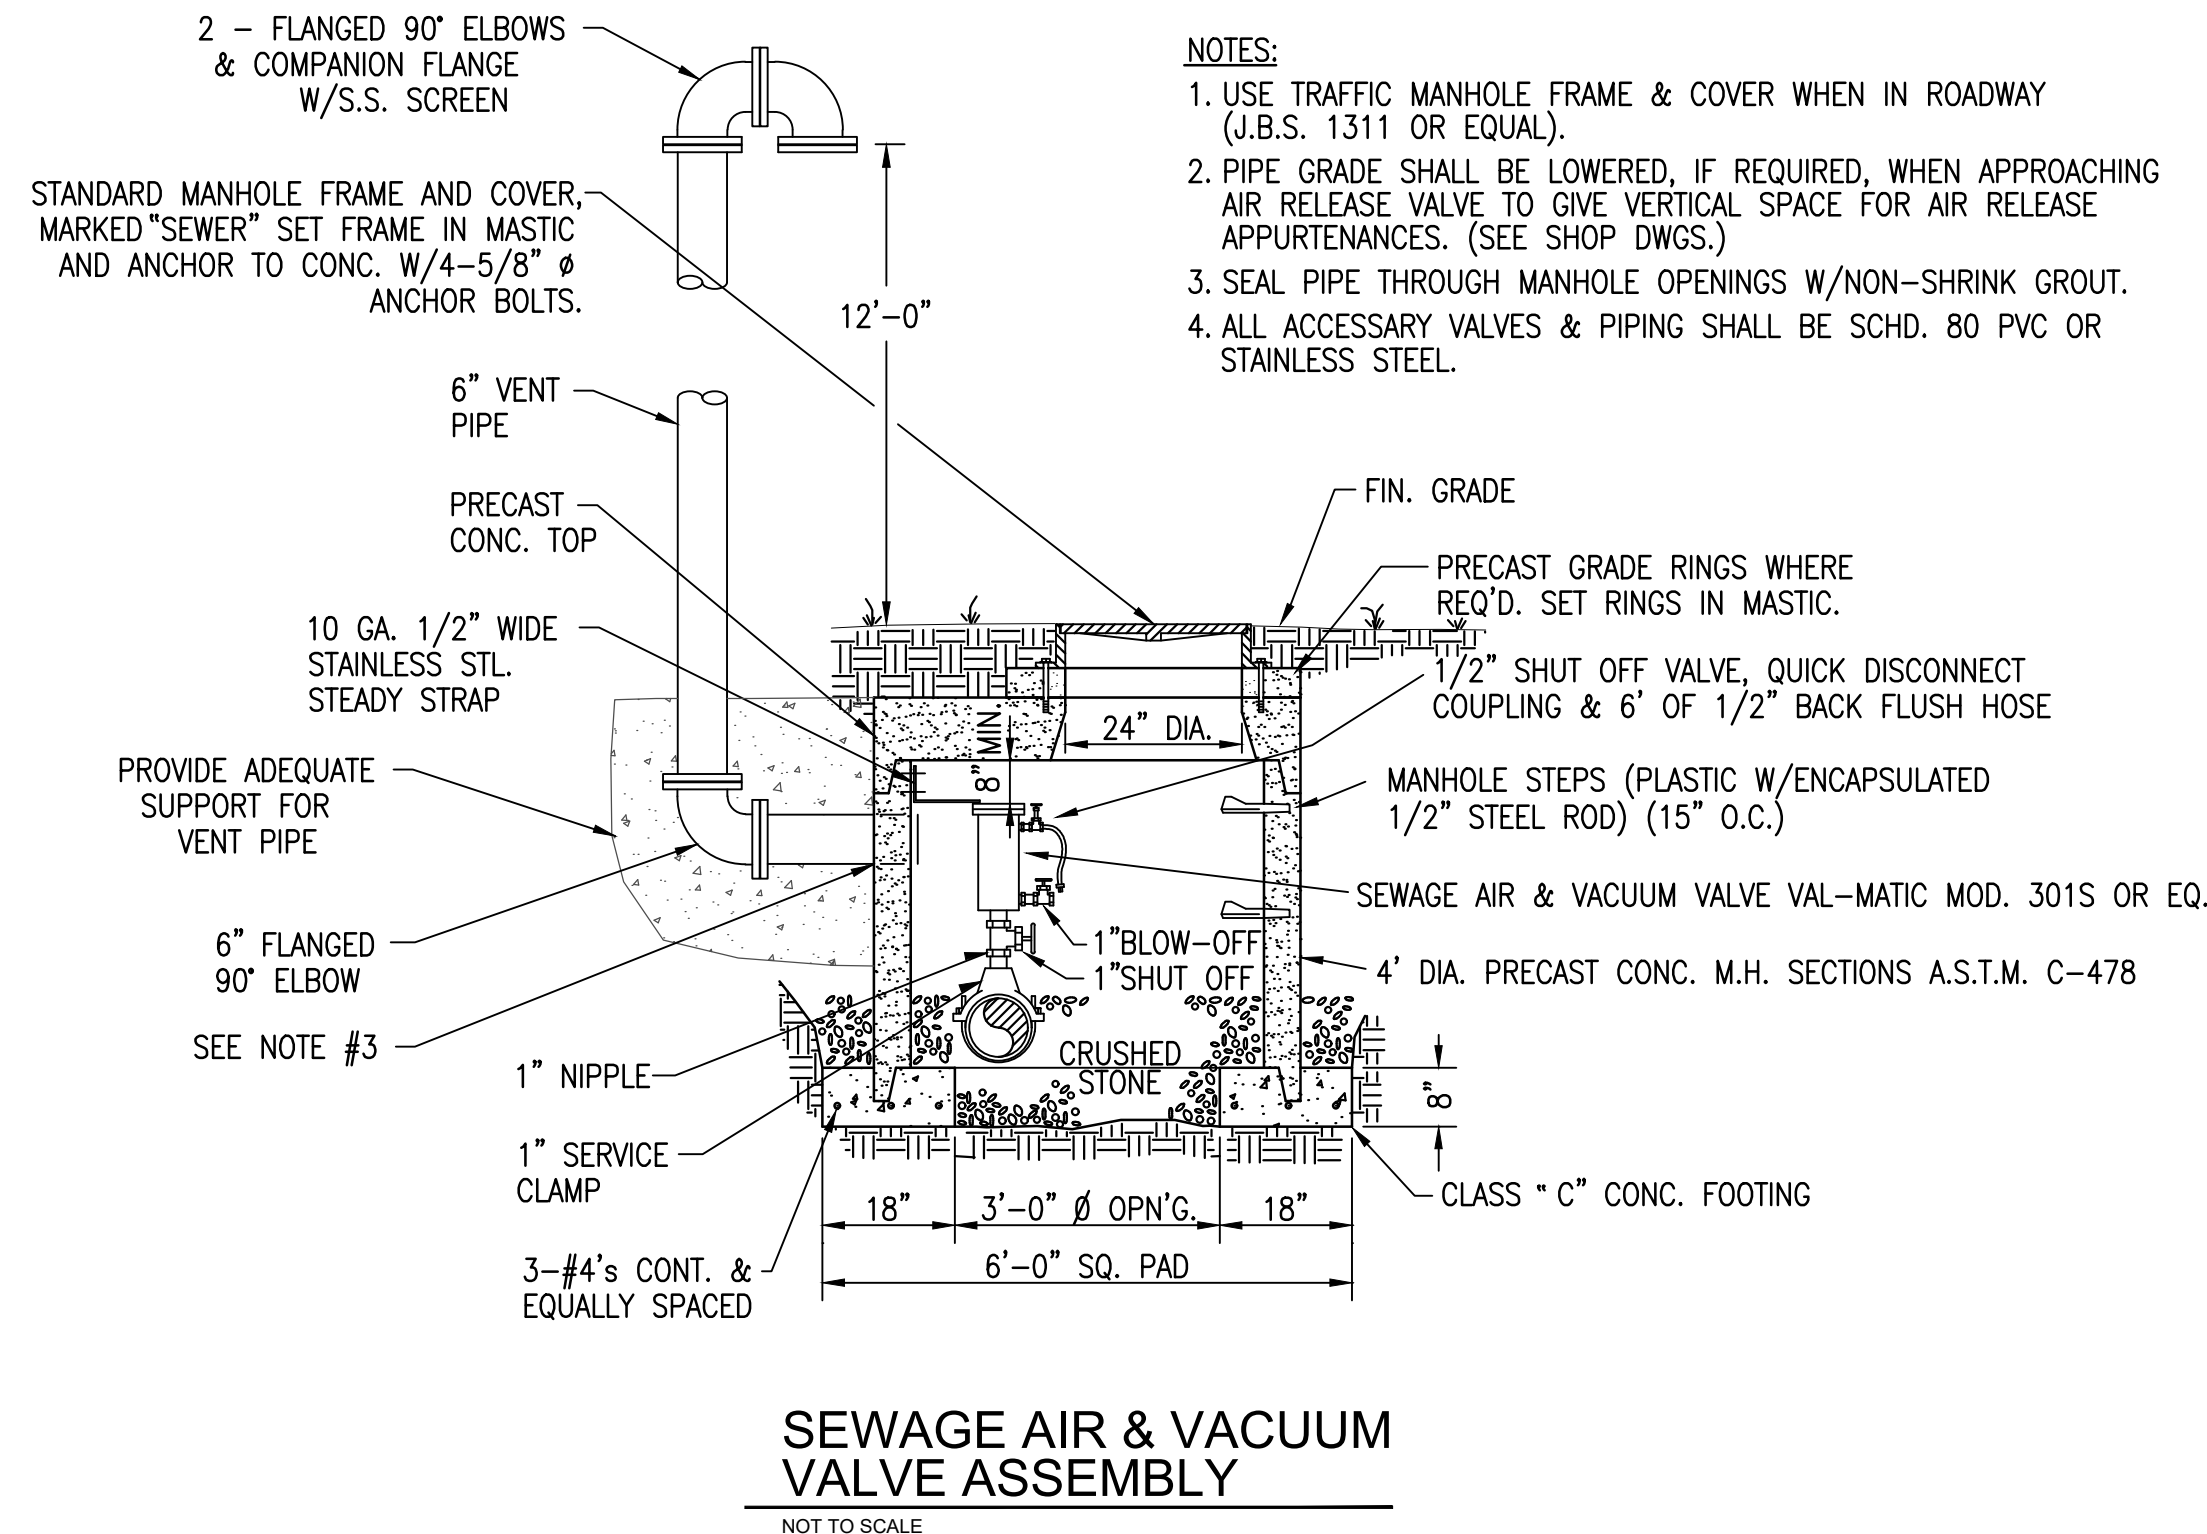

THIS RECORD DOCUMENT HAS BEEN PREPARED BASED ON INFORMATION PROVIDED BY THE CONSTRUCTION CONTRACTOR. GRW ENGINEERS, INC. HAS ATTEMPTED TO VERIFY THE ACCURACY AND/OR COMPLETENESS OF THIS INFORMATION BUT SHALL NOT BE RESPONSIBLE FOR ANY ERRORS OR OMISSIONS WHICH MAY BE INCORPORATED HEREIN AS A RESULT.

GRW

engineering | architecture | geospatial

www.grwinc.com

ENGINEER/ARCHITECT: GRW ENGINEERS, INC.

CONSTRUCTION COMPANY: Norris Bros Exca,LLC

DATE: DEC. 10, 2019

"AS-BUILT"
DRAWINGS

GRW PROJECT NO. 4691-01

ALL RIGHTS RESERVED. NO PART OF THIS DRAWING OR ANY INFORMATION CONTAINED HEREIN MAY BE REPRODUCED IN WHOLE OR IN PART WITHOUT THE WRITTEN PERMISSION OF GRW ENGINEERS, INC. AND SHALL NOT BE USED FOR ANY OTHER PROJECT OTHER THAN THIS SPECIFIC PROJECT WITHOUT THE WRITTEN PERMISSION.

engineering | architecture | geospatial

www.grwinc.com

SEWAGE FORCE MAIN AND GRAVITY
STANDARD DETAILS

I-40 INDUSTRIAL PARK SITE - 8" FORCE MAIN

INDUSTRIAL DEVELOPMENT BOARD OF PERRY CO., TENNESSEE

DESIGNED	JWH
DRAWN	SH
REVIEWED	JWH
APPROVED	JWH

REVISIONS	DATE	BY	DESCRIPTION
NO			

DATE:	OCTOBER 2018
SCALE:	AS NOTED
SHEET NO.	

THIS MARK SHOULD MEASURE EXACTLY 1" WHEN PLOTTED

G-03