


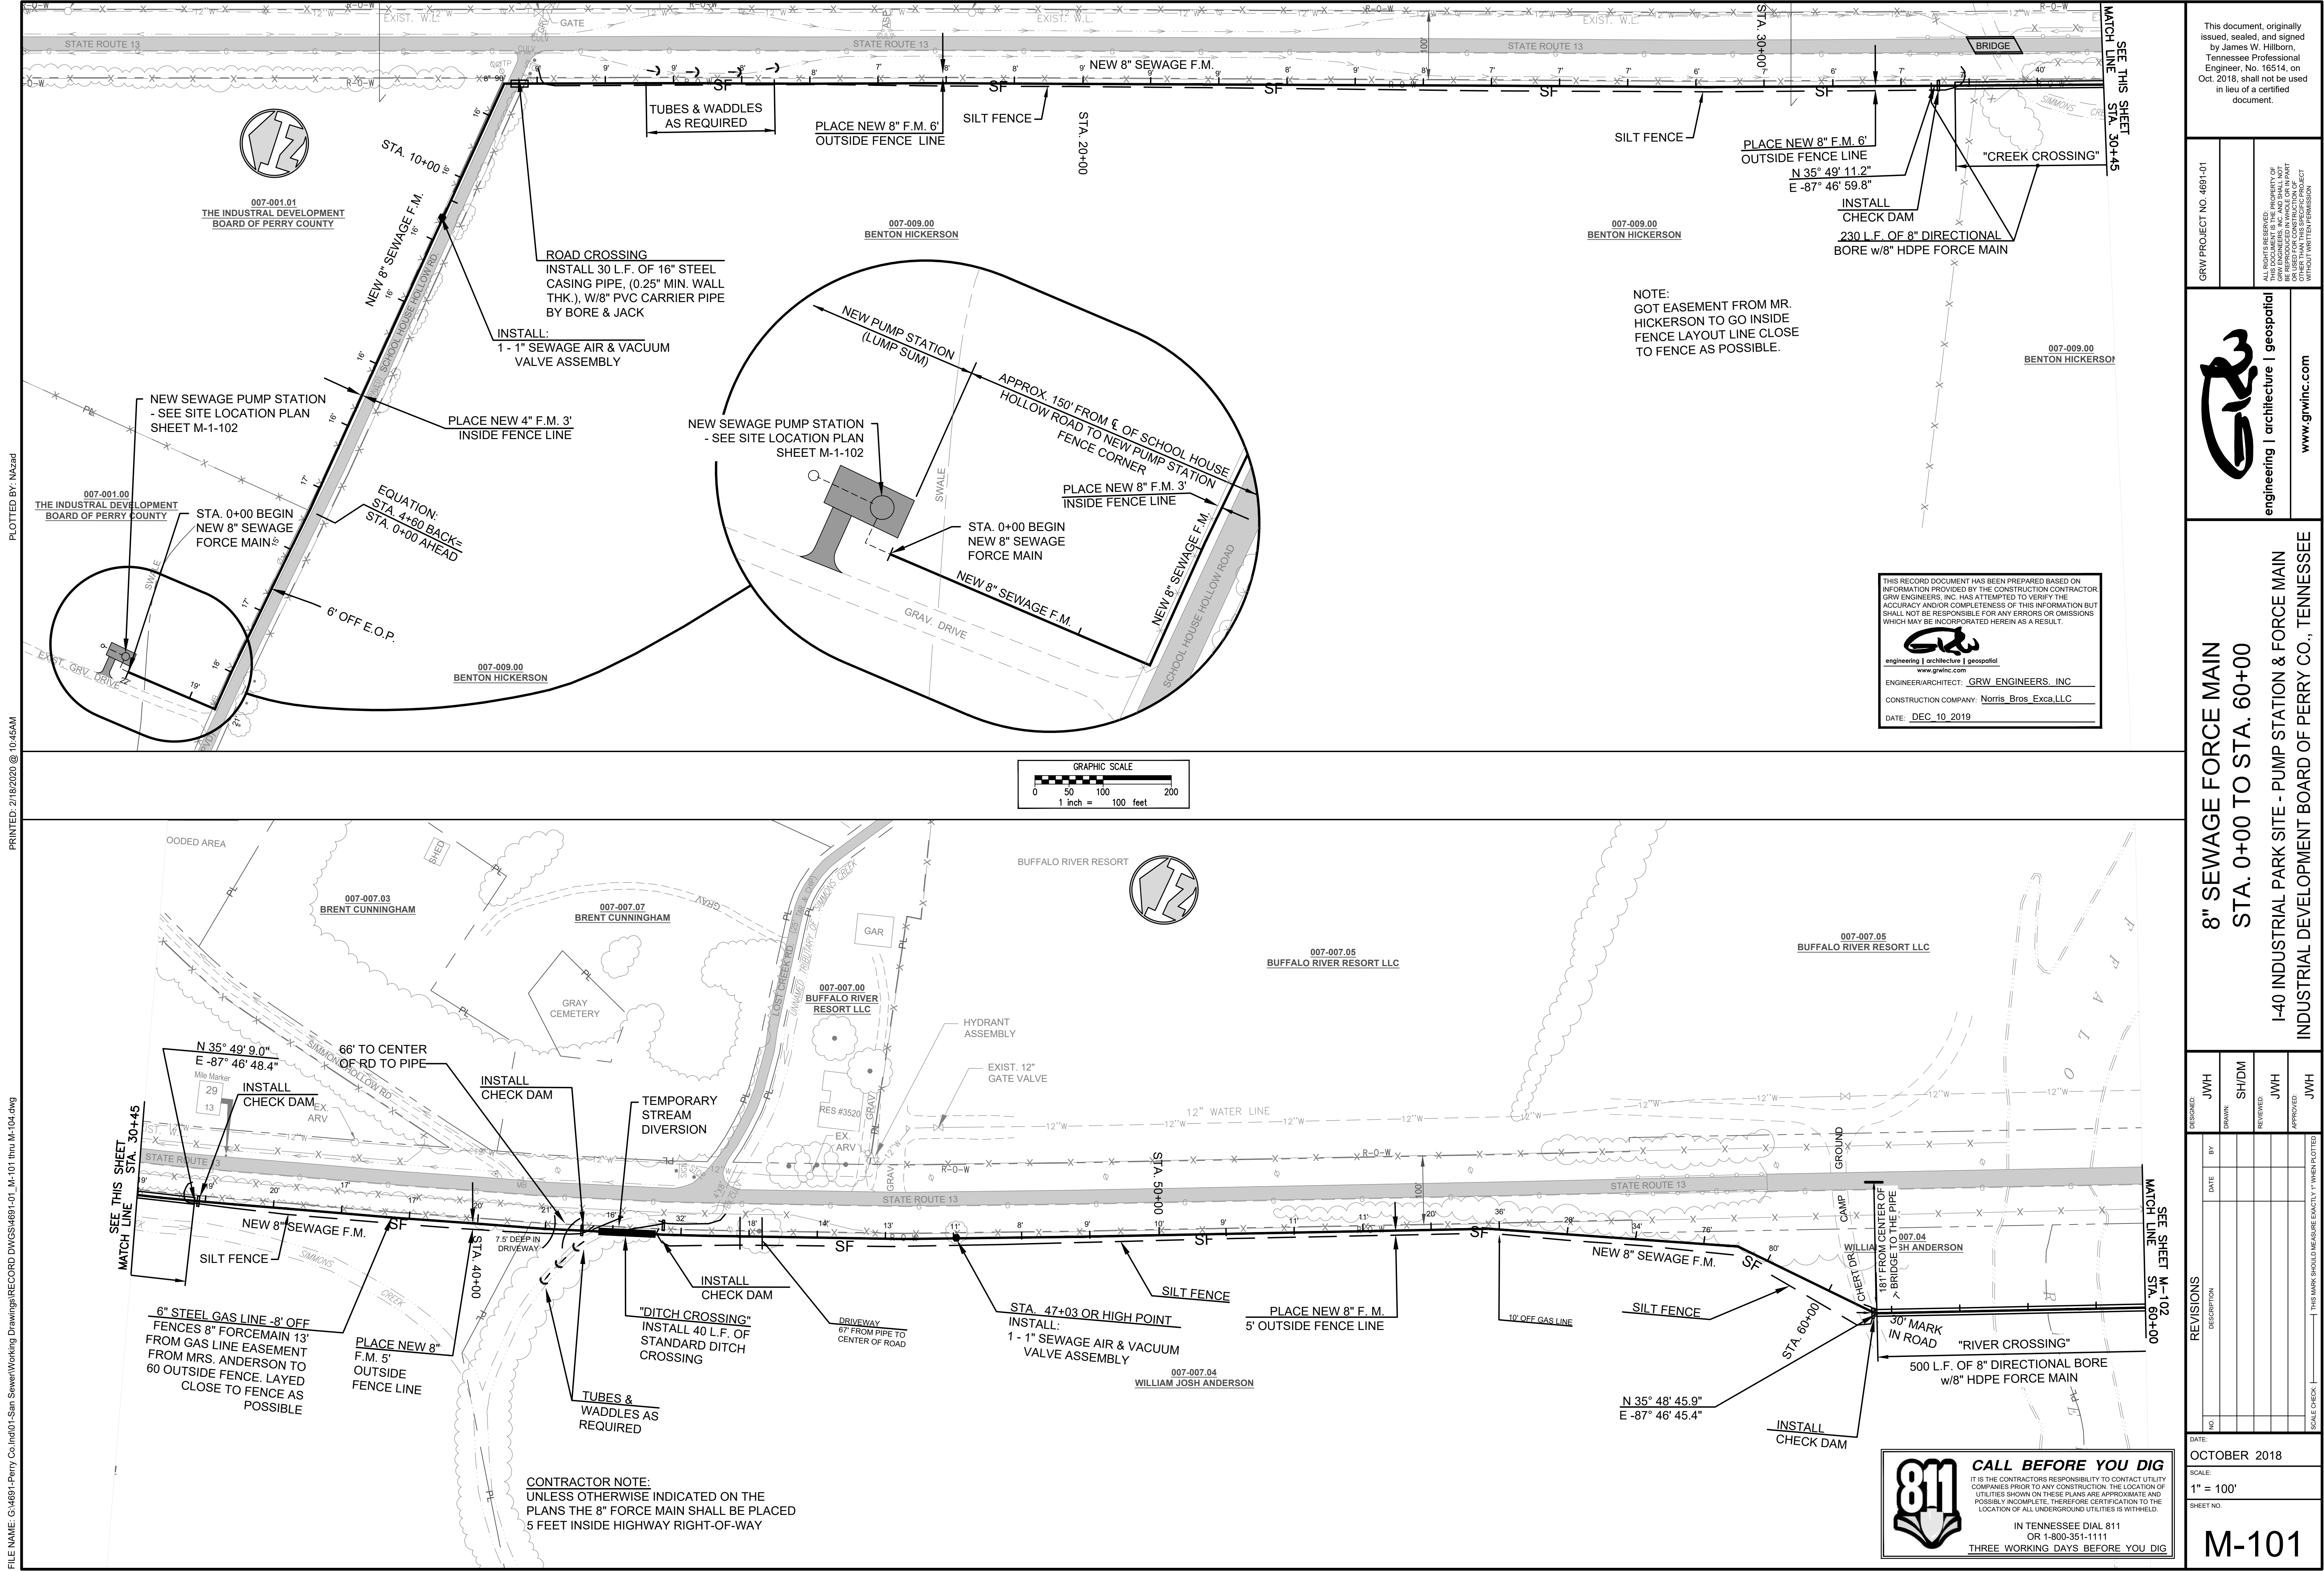

FILE NAME: G:\4691-Perry Co.\Ind01-San Sewer\Working Drawings\RECORD DWGS\4691-01_M-101.dwg
PLOT BY: Nazad
PRINTED: 2/18/2020 @ 10:45AM

This document, originally issued, sealed, and signed by James W. Hilborn, Tennessee Professional Engineer, No. 16514, on Oct. 2018, shall not be used in lieu of a certified document.

GRW PROJECT NO. 4691-01

ALL RIGHTS RESERVED. NO PART OF THIS DOCUMENT SHALL BE REPRODUCED IN WHOLE OR IN PART WITHOUT THE WRITTEN PERMISSION OF GRW ENGINEERS, INC.

GRW
engineering | architecture | geospatial

www.grwinc.com

8" SEWAGE FORCE MAIN
STA. 0+00 TO STA. 60+00

I-40 INDUSTRIAL PARK SITE - PUMP STATION & FORCE MAIN
INDUSTRIAL DEVELOPMENT BOARD OF PERRY CO., TENNESSEE

DESIGNED	DRAWN	REVIEWED	APPROVED
JWH	SH/DM	JWH	JWH

NO.	DATE	DESCRIPTION

DATE: OCTOBER 2018
SCALE: 1" = 100'
SHEET NO.

M-101

THIS RECORD DOCUMENT HAS BEEN PREPARED BASED ON INFORMATION PROVIDED BY THE CONSTRUCTION CONTRACTOR GRW ENGINEERS, INC. HAS ATTEMPTED TO VERIFY THE ACCURACY AND/OR COMPLETENESS OF THIS INFORMATION BUT SHALL NOT BE RESPONSIBLE FOR ANY ERRORS OR OMISSIONS WHICH MAY BE INCORPORATED HEREIN AS A RESULT.

GRW
engineering | architecture | geospatial
www.grwinc.com
ENGINEER/ARCHITECT: GRW ENGINEERS, INC.
CONSTRUCTION COMPANY: Norris Bros. Exca.LLC
DATE: DEC 10 2019

811 CALL BEFORE YOU DIG
IT IS THE CONTRACTOR'S RESPONSIBILITY TO CONTACT UTILITY COMPANIES PRIOR TO ANY CONSTRUCTION. THE LOCATION OF UTILITIES SHOWN ON THESE PLANS ARE APPROXIMATE AND POSSIBLY INCOMPLETE. THEREFORE CERTIFICATION TO THE LOCATION OF ALL UNDERGROUND UTILITIES IS WITHHELD.

IN TENNESSEE DIAL 811
OR 1-800-351-1111
THREE WORKING DAYS BEFORE YOU DIG