
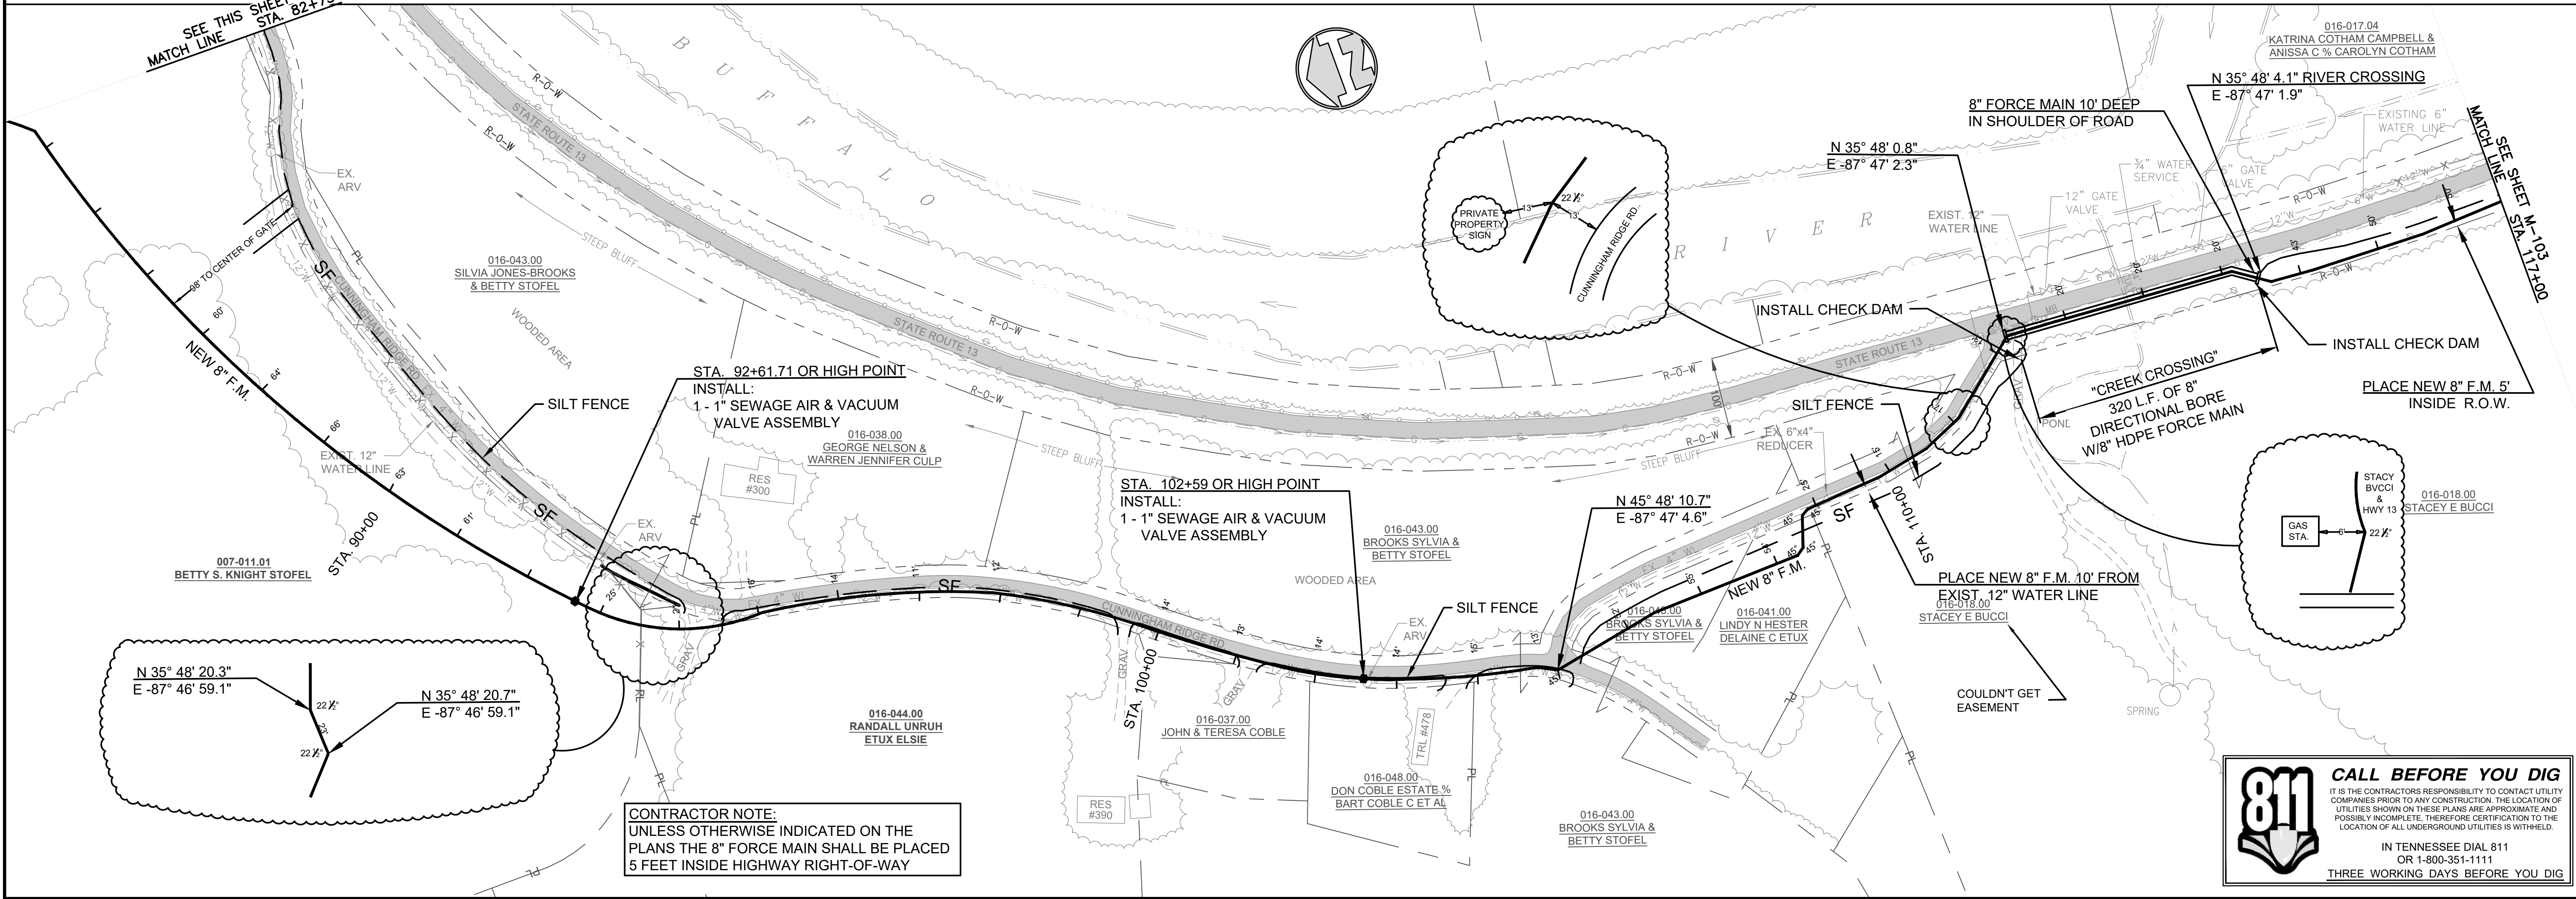


PLOTTED BY: Nazad

PRINTED: 12/10/2019 @ 11:17AM

FILE NAME: G:\4691-Perry Co\Ind01-San Sewer\Working Drawings\RECORD DWGS\4691-01_M-101 11ru M-104.dwg

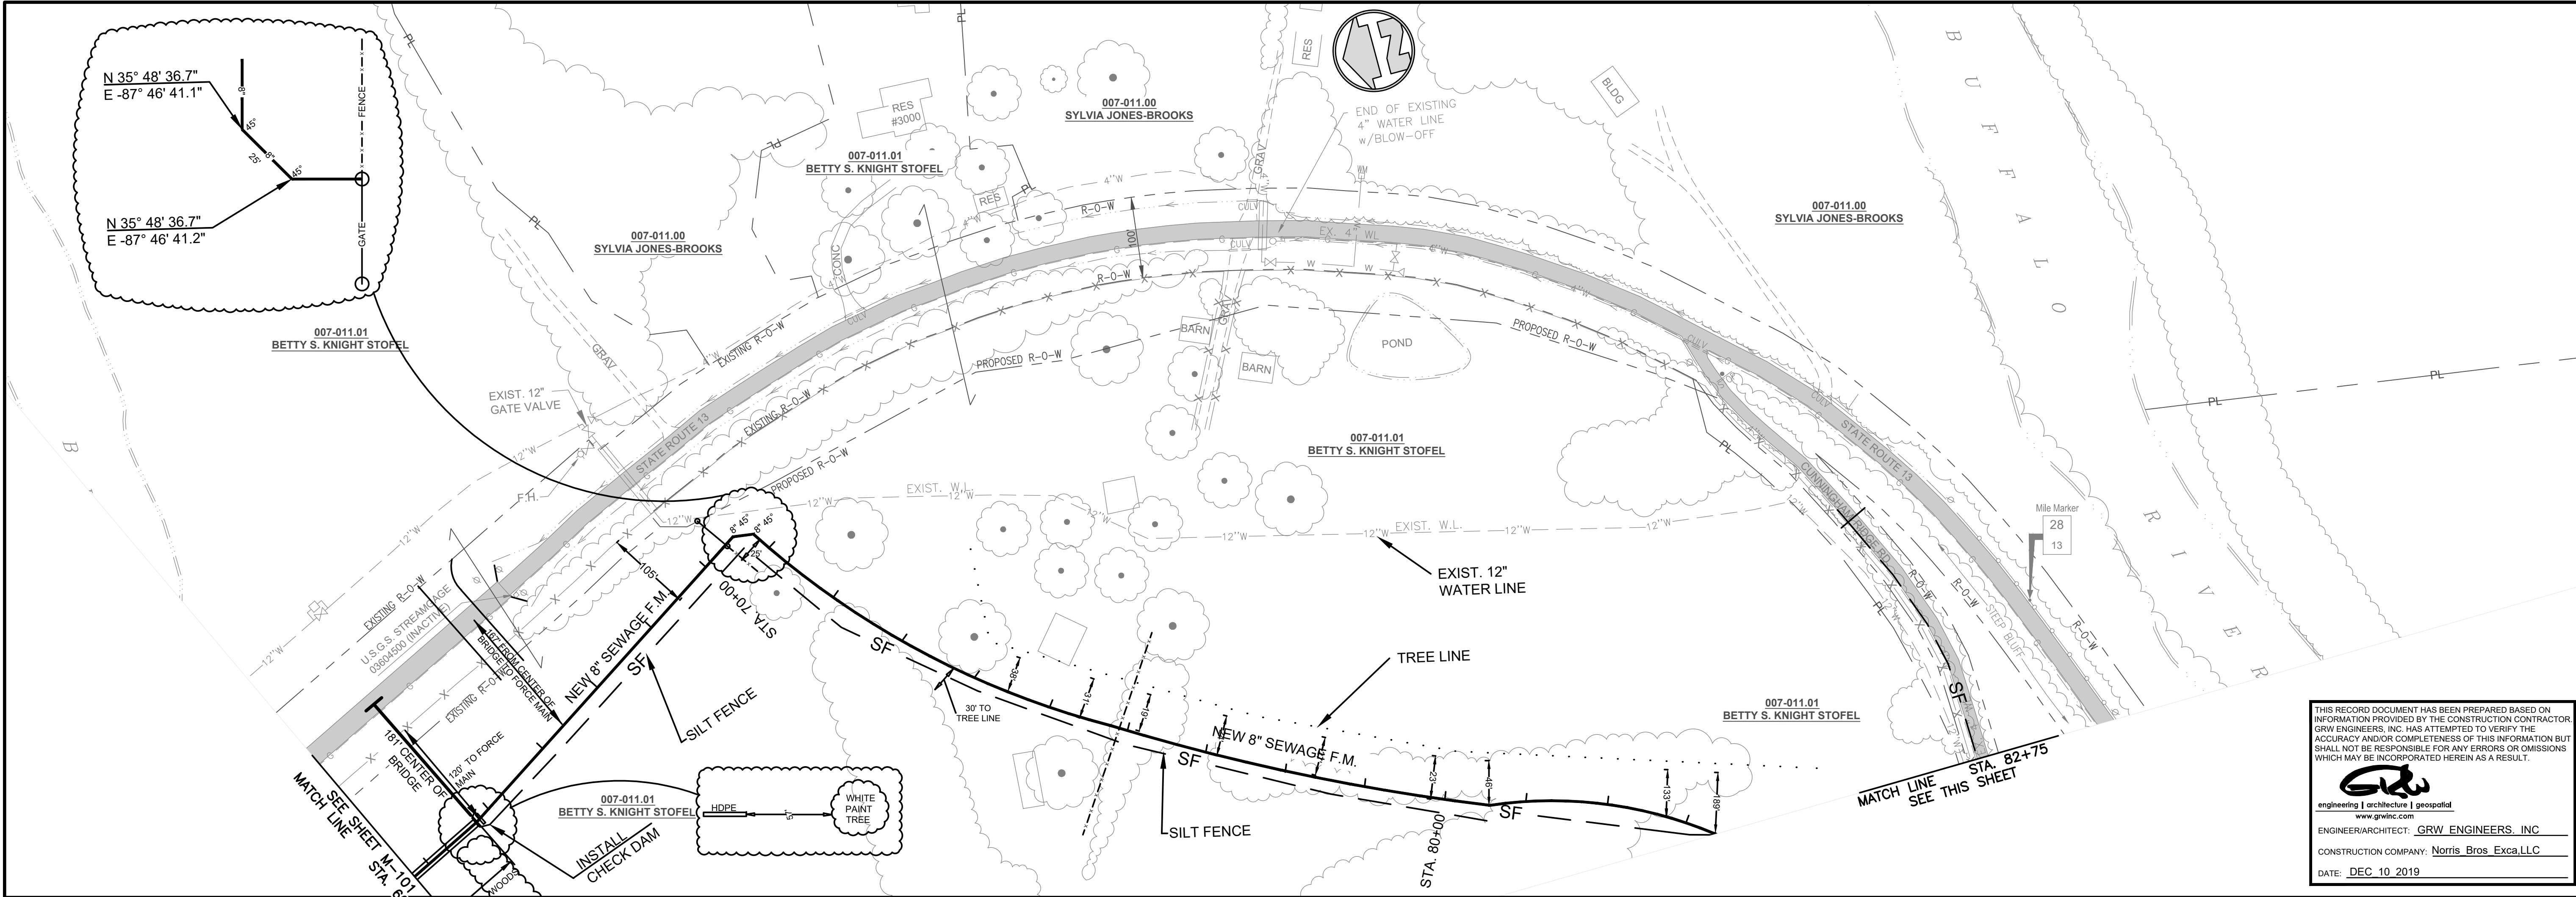

CONTRACTOR NOTE:
UNLESS OTHERWISE INDICATED ON THE
PLANS THE 8" FORCE MAIN SHALL BE PLACED
5 FEET INSIDE HIGHWAY RIGHT-OF-WAY

THIS RECORD DOCUMENT HAS BEEN PREPARED BASED ON
INFORMATION PROVIDED BY THE CONSTRUCTION CONTRACTOR.
GRW ENGINEERS, INC. HAS ATTEMPTED TO VERIFY THE
ACCURACY AND/OR COMPLETENESS OF THIS INFORMATION BUT
SHALL NOT BE RESPONSIBLE FOR ANY ERRORS OR OMISSIONS
WHICH MAY BE INCORPORATED HEREIN AS A RESULT.

GRW
engineering | architecture | geospatial
www.grwinc.com

ENGINEER/ARCHITECT: GRW ENGINEERS, INC.
CONSTRUCTION COMPANY: Norris Bros Exca LLC
DATE: DEC. 10 2019

811 CALL BEFORE YOU DIG

IT IS THE CONTRACTOR'S RESPONSIBILITY TO CONTACT UTILITY
COMPANIES PRIOR TO ANY CONSTRUCTION. THE LOCATION OF
UTILITIES SHOWN ON THESE PLANS ARE APPROXIMATE AND
POSSIBLY INCOMPLETE. THEREFORE CERTIFICATION TO THE
LOCATION OF ALL UNDERGROUND UTILITIES IS WITHHELD.

IN TENNESSEE DIAL 811
OR 1-800-351-1111
THREE WORKING DAYS BEFORE YOU DIG

GRW
engineering | architecture | geospatial
www.grwinc.com

GRW PROJECT NO. 4691-01

ALL RIGHTS RESERVED. NO PART OF THIS DOCUMENT MAY BE REPRODUCED IN WHOLE OR IN PART WITHOUT THE WRITTEN PERMISSION OF GRW ENGINEERS, INC. AND SHALL NOT BE USED FOR ANY OTHER PROJECT OTHER THAN THIS SPECIFIC PROJECT WITHOUT THE WRITTEN PERMISSION OF GRW ENGINEERS, INC.

8" SEWAGE FORCE MAIN
STA. 60+00 TO STA. 117+00
I-40 INDUSTRIAL PARK SITE - PUMP STATION & FORCE MAIN
INDUSTRIAL DEVELOPMENT BOARD OF PERRY CO., TENNESSEE

DESIGNED	JWH	DRAWN	SH/DM	REVIEWED	JWH	APPROVED	JWH
DATE							
NO.							

DATE: OCTOBER 2018
SCALE: 1" = 100'
SHEET NO. M-102

BID SET