



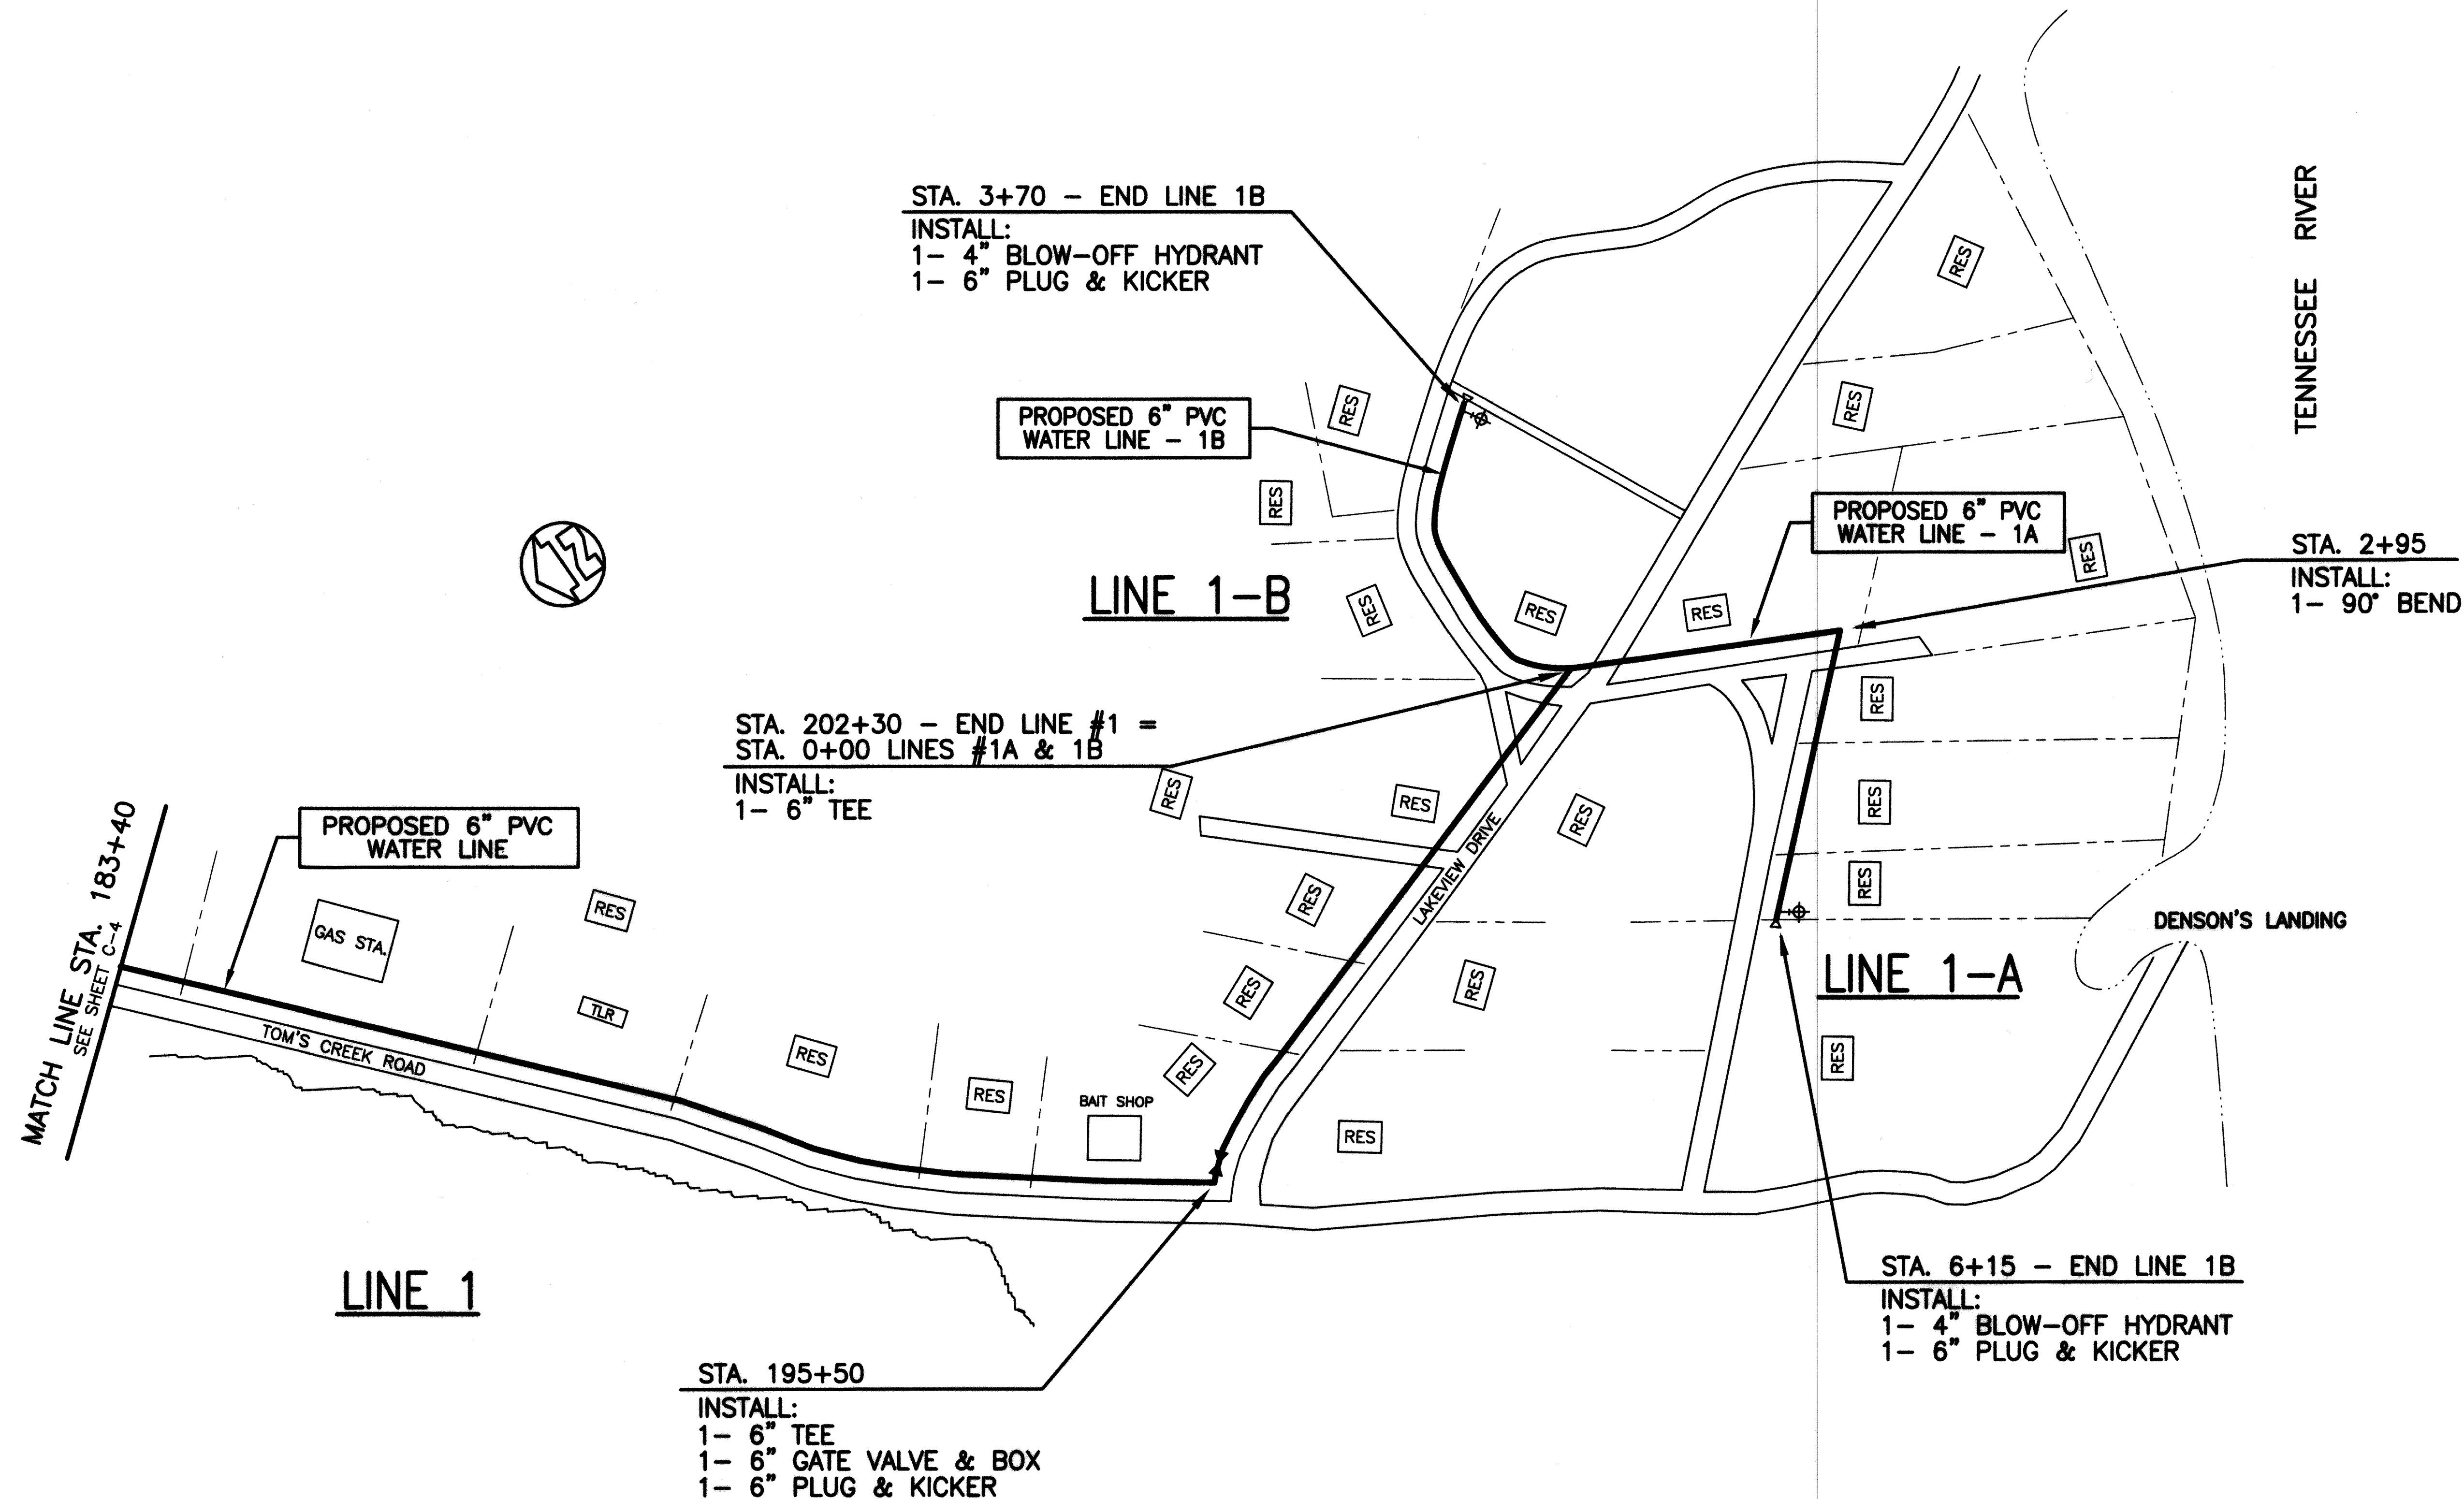

BURIED TELEPHONE CABLE
TEL. 1-800-351-1111 , TN ONE CALL

THIS DOCUMENT IS THE PROPERTY OF GRW ENGINEERS, INC. AND SHALL NOT BE REPRODUCED IN WHOLE OR IN PART OR USED FOR CONSTRUCTION OF OTHER THAN THIS SPECIFIC PROJECT WITHOUT WRITTEN PERMISSION OF GRW ENGINEERS, INC.			
NO.	DESCRIPTION	DATE	BY
REVISIONS			

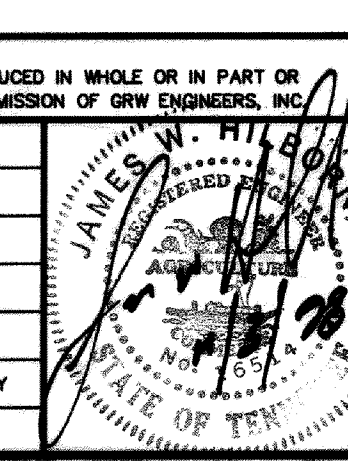

GRW PROJECT NO. 7385-03

TOM'S CREEK ROAD - 6" WATER LINE LOBELVILLE, TENNESSEE



GRW Engineers, Inc.
Engineers, Architects, Planners
LEXINGTON LOUISVILLE NASHVILLE INDIANAPOLIS

DESIGNED: KRS	DATE: OCTOBER, 1998
DRAWN: GAM	SCALE: 1"= 100'
REVIEWED: KRS	SHEET NO.
APPROVED: JWH	C-5