

WATER WORKS IMPROVEMENTS FOR CITY of LOBELVILLE, TENNESSEE

WATER TREATMENT PLANT REHABILITATION AND EXPANSION

APRIL, 1999

MAYOR

James E. Richardson

CITY COUNCIL


Don Barnett
Robbie Moore
James Hinson
Barry Arnold



GRW Engineers, Inc.
Engineers, Architects, Planners
LEXINGTON LOUISVILLE NASHVILLE INDIANAPOLIS

I N D E X

C-1	LOCATION MAP AND SITE PLAN
C-2	INTAKE STRUCTURE AND BUILDING
C-3	EXISTING FLOCCULATION / SEDIMENTATION BASIN
C-4	NEW FLOCCULATION / SEDIMENTATION BASIN
C-5	FLOCCULATION UNITS
C-6	SLUDGE COLLECTION SYSTEM
C-7	FILTERS AND PIPE GALLERY
E-1	NEW FLOCCULATION / SEDIMENTATION BASIN
E-2	FILTERS AND PIPE GALLERY ELECTRICAL
ICS-1	INSTRUMENTATION SYMBOLOGY & DETAILS
ICS-2	INSTRUMENTATION LOOP DIAGRAMS

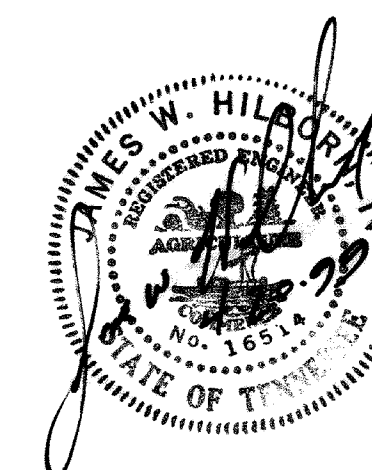

REVIEWED: CITY OF LOBELVILLE

SET NO. _____

PROJECT NO. 7385