


LOCATION MAP

GENERAL NOTES:

- 1. ALL FEES, LICENSES, AND PERMITS NECESSARY FOR THIS CONSTRUCTION ARE TO BE OBTAINED PRIOR TO THE INITIATION OF CONSTRUCTION AND THE COST OF SAME TO BE BORNE BY THE CONTRACTOR.
- 2. INSTALL HORIZONTAL AND VERTICAL BENDS AS REQUIRED TO AVOID CONFLICTS WITH EXISTING UTILITIES. SEE STANDARD DETAIL SHEET.
- 3. WHERE NEITHER 10-FEET OF HORIZONTAL SEPARATION, NOR 18-INCHES OF VERTICAL SEPARATION BETWEEN EXISTING SEWER AND THE WATER LINE CANNOT BE MAINTAINED, ENCASE THE WATER LINE IN CONCRETE. SEE STANDARD DETAIL SHEET.
- THE OWNER DOES NOT ASSUME RESPONSIBILITY FOR THE POSSIBILITY THAT DURING CONSTRUCTION, UTILITIES OTHER THAN THOSE SHOWN MAY BE ENCOUNTERED OR THAT ACTUAL LOCATION OF THOSE SHOWN MAY BE DIFFERENT FROM THE LOCATIONS DESIGNATED ON THE CONTRACT DRAWINGS. IN AREAS WHERE IT IS NECESSARY THAT EXACT LOCATIONS BE KNOWN OF UNDERGROUND FACILITIES, THE CONTRACTOR SHALL, AT HIS OWN EXPENSE, FURNISH ALL LABOR AND TOOLS TO EITHER VERIFY AND SUBSTANTIATE OR DEFINITELY ESTABLISH THE POSITION OF UNDERGROUND UTILITY LINES. THIS INCLUDES STORM SEWERS.
- 5. ALL LINES TO BE TESTED, DISINFECTED, AND APPROVED BEFORE PLACING INTO SERVICE.

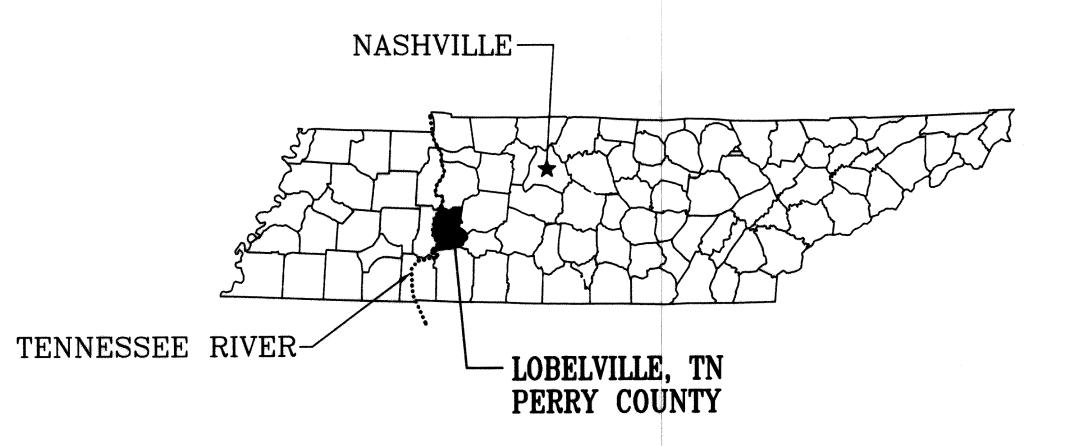

LEGEND

PROPOSED

WATER MAIN

WATER VALVE

FIRE HYDRANT

REDUCER

BLOW-OFF

CASING PIPE

EXISTING FEATURES

PAVED ROAD PAVED ROAD WITH SHOULDERS GRAVEL ROAD RIGHT-OF-WAY PROPERTY LINE FENCE CREEK TREE LINE TRANSMISSION LINE RAILROAD TRACKS **GUARDRAIL** ASPH. DR. PAVED DRIVEWAY GR. DR. GRAVEL DRIVEWAY CONCRETE DRIVEWAY

EXISTING UTILITIES

 — W — 6" —
 WATER MAIN & SIZE

 — G — 4" —
 GAS MAIN & SIZE

 — S — 8" —
 SEWER LINE & SIZE

 — T — T —
 BURIED TELEPHONE CABLE

 — E — E —
 BURIED ELECTRICAL LINE

 — P/T — P/T —
 OVERHEAD POWER AND/OR TELEPHONE LINES

 — C — C —
 CABLE TELEVISION LINE

EXISTING FEATURES

□	BRIDGE		EXISTING WATER VALVE
	CULVERT	⊡	EXISTING WATER METER
NAME OF ESTABLISHMENT	STORE, CHURCH, BUSINESS ETC. AS NOTED	G. V. & B.	GATE VALVE & BOX
	BARN		CATCH BASIN
BARN	BARN	©	IRON PIN
SHED	SHED	0	CONCRETE MONUMENT
GAR	GARAGE	•	BENCH MARK
	TRAILER	MAP 150 PARCEL 2	TAX MAP NO. PARCEL NO.
	CEMETERY		BLOW-OFF
	TREE	0	SEWER MANHOLE
-	FIRE HYDRANT	౼	BURIED TELEPHONE WARNING SIGN
b	REDUCER	Φ	TELEPHONE MANHOLE
o	TELEPHONE JUNCTION BOX	→ ,	POWER POLE
Ø	GAS METER & VALVE ASSEMBLY	ф>	POWER POLE W/GUY WIRE

BURIED TELEPHONE CABLES AND UTILITIES CALL TENNESSEE ONE CALL (1-800-351-111

CALL: TENNESSEE ONE CALL (1-800-351-1111)

ALL RIGHTS RESERVED:
THIS DOCUMENT IS THE PROPERTY OF GRW ENGINEERS, INC. AND SHALL NOT BE REPRODUCED IN WHOLE OR IN PART OR USED FOR CONSTRUCTION OF OTHER THAN THIS SPECIFIC PROJECT WITHOUT WRITTEN PERMISSION OF GRW ENGINEERS INC.

NO. DESCRIPTION

DESCRIPTION

DATE BY

OF TENNIAN LEXICING

PERRY COUNTY
LOBELVILLE, TENNESSEE
WATER LINE EXPANSION
LOCATION MAP & SITE PLAN



DLT MAY, 2001

DRAWN: SCALE:

DLT NO SCALE

REVIEWED: SHEET NO.

EEM

APPROVED: