

WATER WORKS IMPROVEMENTS FOR CITY of LOBELVILLE, TENNESSEE

WATER LINE EXTENSION BRITTS LANDING

APRIL, 2002

MAYOR

Robbie Moore

CITY COUNCIL

Don Barnett
Frank Hinson
Timmy Trull
Chris Coble



GRW Elrod Dunson Engineers, Inc.
Engineers, Architects, Planners

REVIEWED: CITY OF LOBELVILLE


404 BNA Drive - NASHVILLE, TN 37217
PH. (615)366-1600 FAX (615)366-0406

LEXINGTON LOUISVILLE NASHVILLE KNOXVILLE INDIANAPOLIS

I N D E X

	COVER SHEET
C-1	VACINITY MAP AND LEGEND
C-2	LAYOUT DRAWING AND LOCATION PLAN
C-3	WATER LINE STA. 0+00 TO STA. 30+00
C-4	WATER LINE STA. 30+00 TO STA. 60+XX & WATER LINE CONTINUATION TO SHEET C-6
C-5	WATER LINE STA. 60+00 TO 85+00
C-6	WATER LINE CONTINUATION TO SHEET C-4
C-7	STANDARD WATER DETAILS
C-8	EROSION CONTROL MEASURES

SET NO. _____

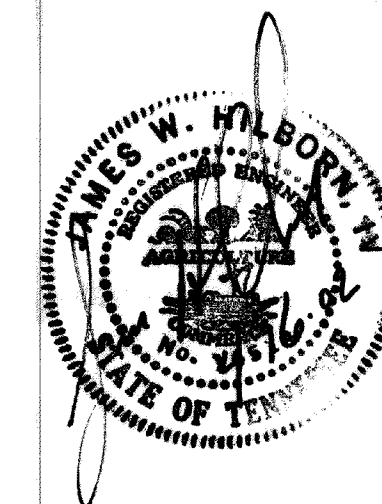

PROJECT NO. 7408-04