


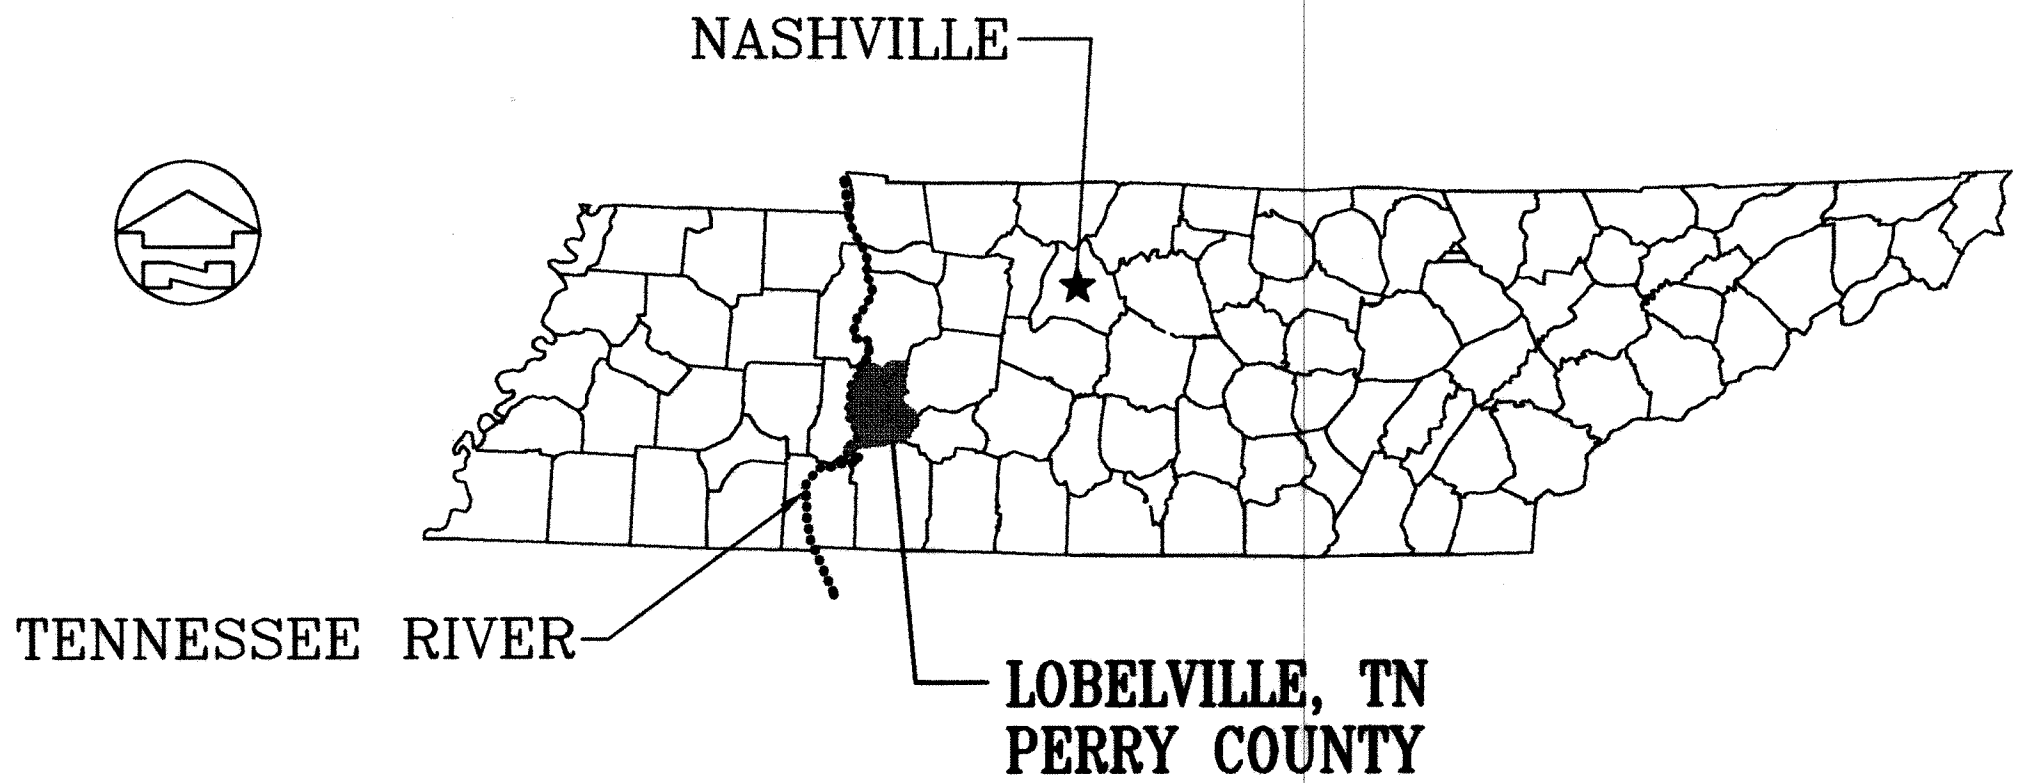

VACINITY MAP
NOT TO SCALE

GENERAL NOTES:

- ALL FEES, LICENSES, AND PERMITS NECESSARY FOR THIS CONSTRUCTION ARE TO BE OBTAINED PRIOR TO THE INITIATION OF CONSTRUCTION AND THE COST OF SAME TO BE BORNE BY THE CONTRACTOR.
- INSTALL HORIZONTAL AND VERTICAL BENDS AS REQUIRED TO AVOID CONFLICTS WITH EXISTING UTILITIES. SEE STANDARD DETAIL SHEET.
- WHERE NEITHER 10- FEET OF HORIZONTAL SEPARATION , NOR 18-INCHES OF VERTICAL SEPARATION BETWEEN EXISTING SEWER AND THE WATER LINE CANNOT BE MAINTAINED, ENCASE THE WATER LINE IN CONCRETE. SEE STANDARD DETAIL SHEET.
- THE OWNER DOES NOT ASSUME RESPONSIBILITY FOR THE POSSIBILITY THAT DURING CONSTRUCTION, UTILITIES OTHER THAN THOSE SHOWN MAY BE ENCOUNTERED OR THAT ACTUAL LOCATION OF THOSE SHOWN MAY BE DIFFERENT FROM THE LOCATIONS DESIGNATED ON THE CONTRACT DRAWINGS. IN AREAS WHERE IT IS NECESSARY THAT EXACT LOCATIONS BE KNOWN OF UNDERGROUND FACILITIES, THE CONTRACTOR SHALL, AT HIS OWN EXPENSE, FURNISH ALL LABOR AND TOOLS TO EITHER VERIFY AND SUBSTANTIATE OR DEFINITELY ESTABLISH THE POSITION OF UNDERGROUND UTILITY LINES. THIS INCLUDES STORM SEWERS.
- ALL LINES TO BE TESTED, DISINFECTED, AND APPROVED BEFORE PLACING INTO SERVICE.



LEGEND

PROPOSED

—	WATER MAIN
—	WATER VALVE
—	FIRE HYDRANT
—	REDUCER
—	BLOW-OFF
—	CASING PIPE

EXISTING FEATURES

—	PAVED ROAD
—	PAVED ROAD WITH SHOULDERS
—	GRAVEL ROAD
—	RIGHT-OF-WAY
—	PROPERTY LINE
—	FENCE
—	CREEK
—	TREE LINE
—	TRANSMISSION LINE
—	RAILROAD TRACKS
—	GUARDRAIL
—	PAVED DRIVEWAY
—	GRAVEL DRIVEWAY
—	CONCRETE DRIVEWAY

EXISTING UTILITIES


— W — 6" —	WATER MAIN & SIZE
— G — 4" —	GAS MAIN & SIZE
— S — 8" —	SEWER LINE & SIZE
— T — T —	BURIED TELEPHONE CABLE
— E — E —	BURIED ELECTRICAL LINE
— P/T — P/T —	OVERHEAD POWER AND/OR TELEPHONE LINES
— C — C —	CABLE TELEVISION LINE

EXISTING FEATURES

BRIDGE	EXISTING WATER VALVE
CULVERT	EXISTING WATER METER
STORE, CHURCH, BUSINESS ETC. AS NOTED	GATE VALVE & BOX
BARN	CATCH BASIN
SHED	IRON PIN
GARAGE	CONCRETE MONUMENT
TRAILER	BENCH MARK
CEMETERY	TAX MAP NO. PARCEL NO.
TREE	BLOW-OFF
FIRE HYDRANT	SEWER MANHOLE
REDUCER	BURIED TELEPHONE WARNING SIGN
TELEPHONE JUNCTION BOX	TELEPHONE MANHOLE
GAS METER & VALVE ASSEMBLY	POWER POLE
	POWER POLE w/GUY WIRE

BURIED TELEPHONE CABLES AND UTILITIES
CALL: TENNESSEE ONE CALL (1-800-361-1111)

THIS DOCUMENT IS THE PROPERTY OF GRW ELROD DUNSON, INC. AND SHALL NOT BE REPRODUCED IN WHOLE OR IN PART OR USED FOR CONSTRUCTION OF OTHER THAN THIS SPECIFIC PROJECT WITHOUT WRITTEN PERMISSION OF GRW ELROD DUNSON, INC.			
NO.	DESCRIPTION	DATE	BY
	REVISIONS		

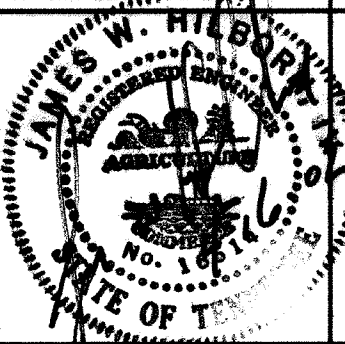

GRW PROJECT NO. 7408-04
PERRY COUNTY
LOBELVILLE, TENNESSEE
WATER LINE EXTENSION, BRITTS LANDING
VACINITY MAP & LEGEND

DESIGNED: JWH	DATE: APRIL, 2002
DRAWN: DLT	SCALE: AS NOTED
REVIEWED: KRS	SHEET NO. C-1
APPROVED: JWH	

GRW Elrod Dunson, Inc.
Engineers, Architects, Planners
LEXINGTON LOUISVILLE INDIANAPOLIS
NASHVILLE KNOXVILLE