


BURIED TELEPHONE CABLES AND UTILITIES
CALL: TENNESSEE ONE CALL (1-800-351-1111)

ALL RIGHTS RESERVED.
THIS DOCUMENT IS THE PROPERTY OF GRW ELROD DUNSON, INC. AND SHALL NOT BE REPRODUCED IN WHOLE OR IN PART OR USED FOR CONSTRUCTION OF OTHER THAN THIS SPECIFIC PROJECT WITHOUT WRITTEN PERMISSION OF GRW ELROD DUNSON, INC.

NO.	DESCRIPTION	DATE	BY

REVISIONS

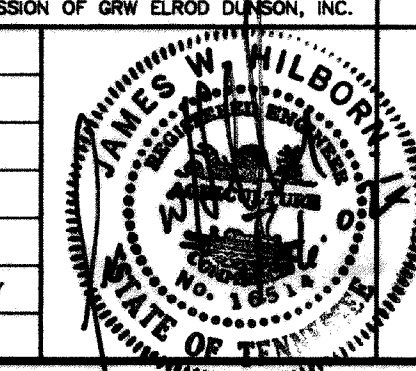

GRW PROJECT NO. 7408-04

PERRY COUNTY
LOBELVILLE, TENNESSEE
WATER LINE EXTENSION, BRITTS LANDING
PROPOSED WATER LINE

GRW
GRW Elrod Dunson, Inc.
Engineers, Architects, Planners
LEXINGTON LOUISVILLE INDIANAPOLIS
NASHVILLE KNOXVILLE

DESIGNED: JWH	DATE: APRIL, 2002
DRAWN: DLT	SCALE: AS NOTED
REVIEWED: KRS	SHEET NO. C-6
APPROVED: JWH	