

MANHOLE COMPONENTS DETAIL

6" MIN. COMPACTED CRUSHED STONE UNDER PIPE TO A MIN. OF 12" OVER PIPE. ALL MUD SHALL BE UNDERCUT FROM BELOW PIPE AND BACKFILLED WITH STONE.

PAVEMENT REPLACEMENT TO CONSIST OF 6" BINDER AND 2" SURFACE COURSE (MIN.).

G OF POINT REPAIR

NOT TO SCALE

1. REPLACEMENT PIPE IS TO BE ONE PIECE.


10. USE EXCAVATED MATERIAL IN UNPAVED AREAS.


INVERTS OF NEW PIPE TO MATCH EXISTING (TYP.).

3.* CLASS 52 D.I.P. IS TO BE USED WHERE EXIST. PIPE IS D.I.P. BEDDING FOR POINT REPAIR SHALL BE CRUSHED STONE.


BACKFILL IN PAVED AREAS SHALL BE CRUSHED STONE.

UPPER 6" OF BACKFILL IN GRASSED AREAS IS TO BE TOPSOIL.

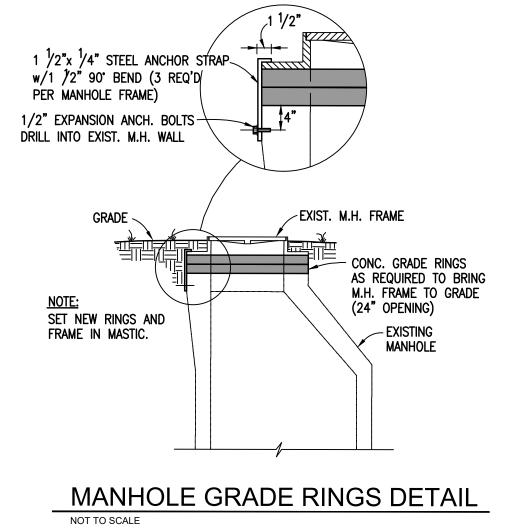

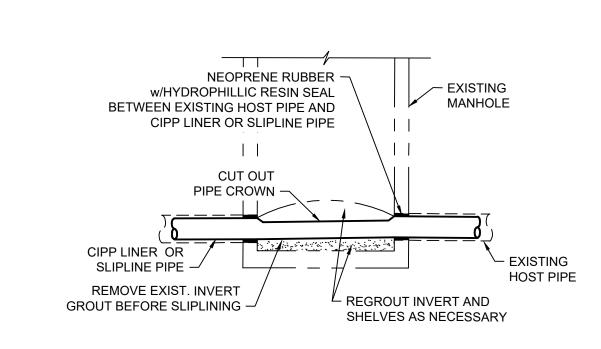


REHAB THROUGH MANHOLE DETAIL

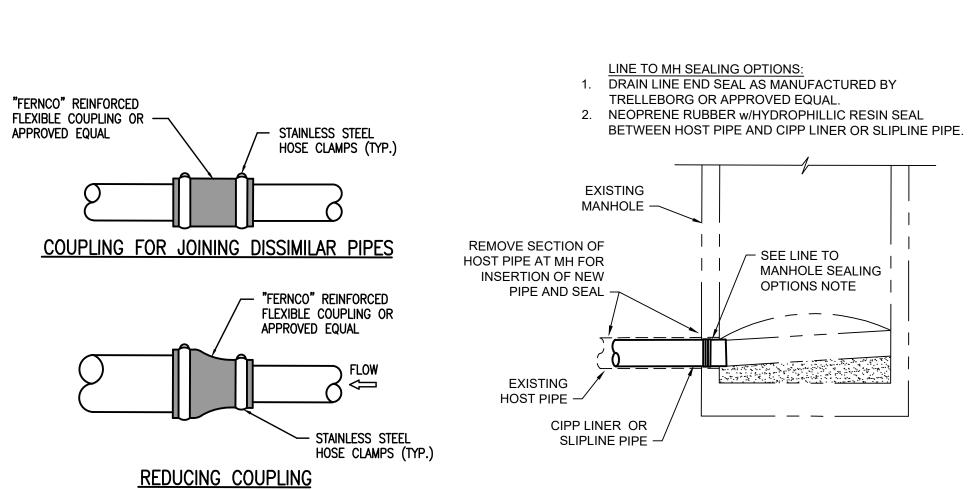


FLEXIBLE COUPLING DETAIL



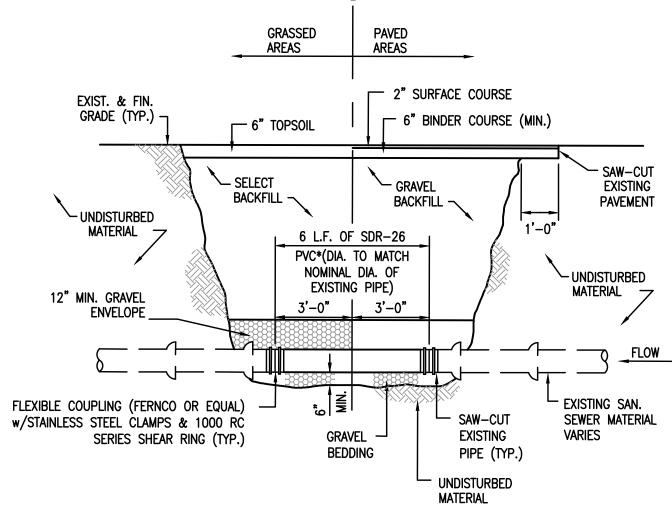

POINT REPAIR DETAIL NOT TO SCALE

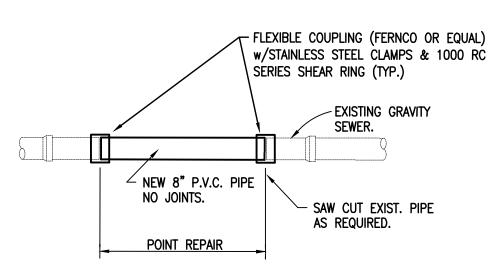

REPLACEMENT PIPE IS TO BE ONE PIECE. INVERTS OF NEW PIPE TO MATCH EXISTING (TYP.). 3.* CLASS 52 D.I.P. IS TO BE USED WHERE EXIST. PIPE IS D.I.P. 4. BEDDING FOR POINT REPAIR SHALL BE CRUSHED STONE. 6" MIN. COMPACTED CRUSHED STONE UNDER PIPE TO A MIN. OF 12" OVER PIPE. ALL MUD SHALL BE UNDERCUT FROM BELOW PIPE AND BACKFILLED WITH STONE. UPPER 6" OF BACKFILL IN GRASSED AREAS IS TO BE TOPSOIL. 8. BACKFILL IN PAVED AREAS SHALL BE CRUSHED STONE. 9. PAVEMENT REPLACEMENT TO CONSIST OF 6" BINDER AND 2" SURFACE COURSE (MIN.).

10. USE EXCAVATED MATERIAL IN UNPAVED AREAS.

POINT REPAIR DETAIL NOT TO SCALE

ATION SSEE SANITARY SEWER
CITY OF LOBELVIL

DETAILS

REHAB

STANDARD

SEPTEMBER 2024

AS NOTED

RD-09