


PLOTTED BY: NAWAD

PRINTED: 1/28/2025 @ 4:14PM


FILE NAME: C:\Users\stazad\AppData\Local\Temp\Ap\Publish_2316013827-16-Set.dwg

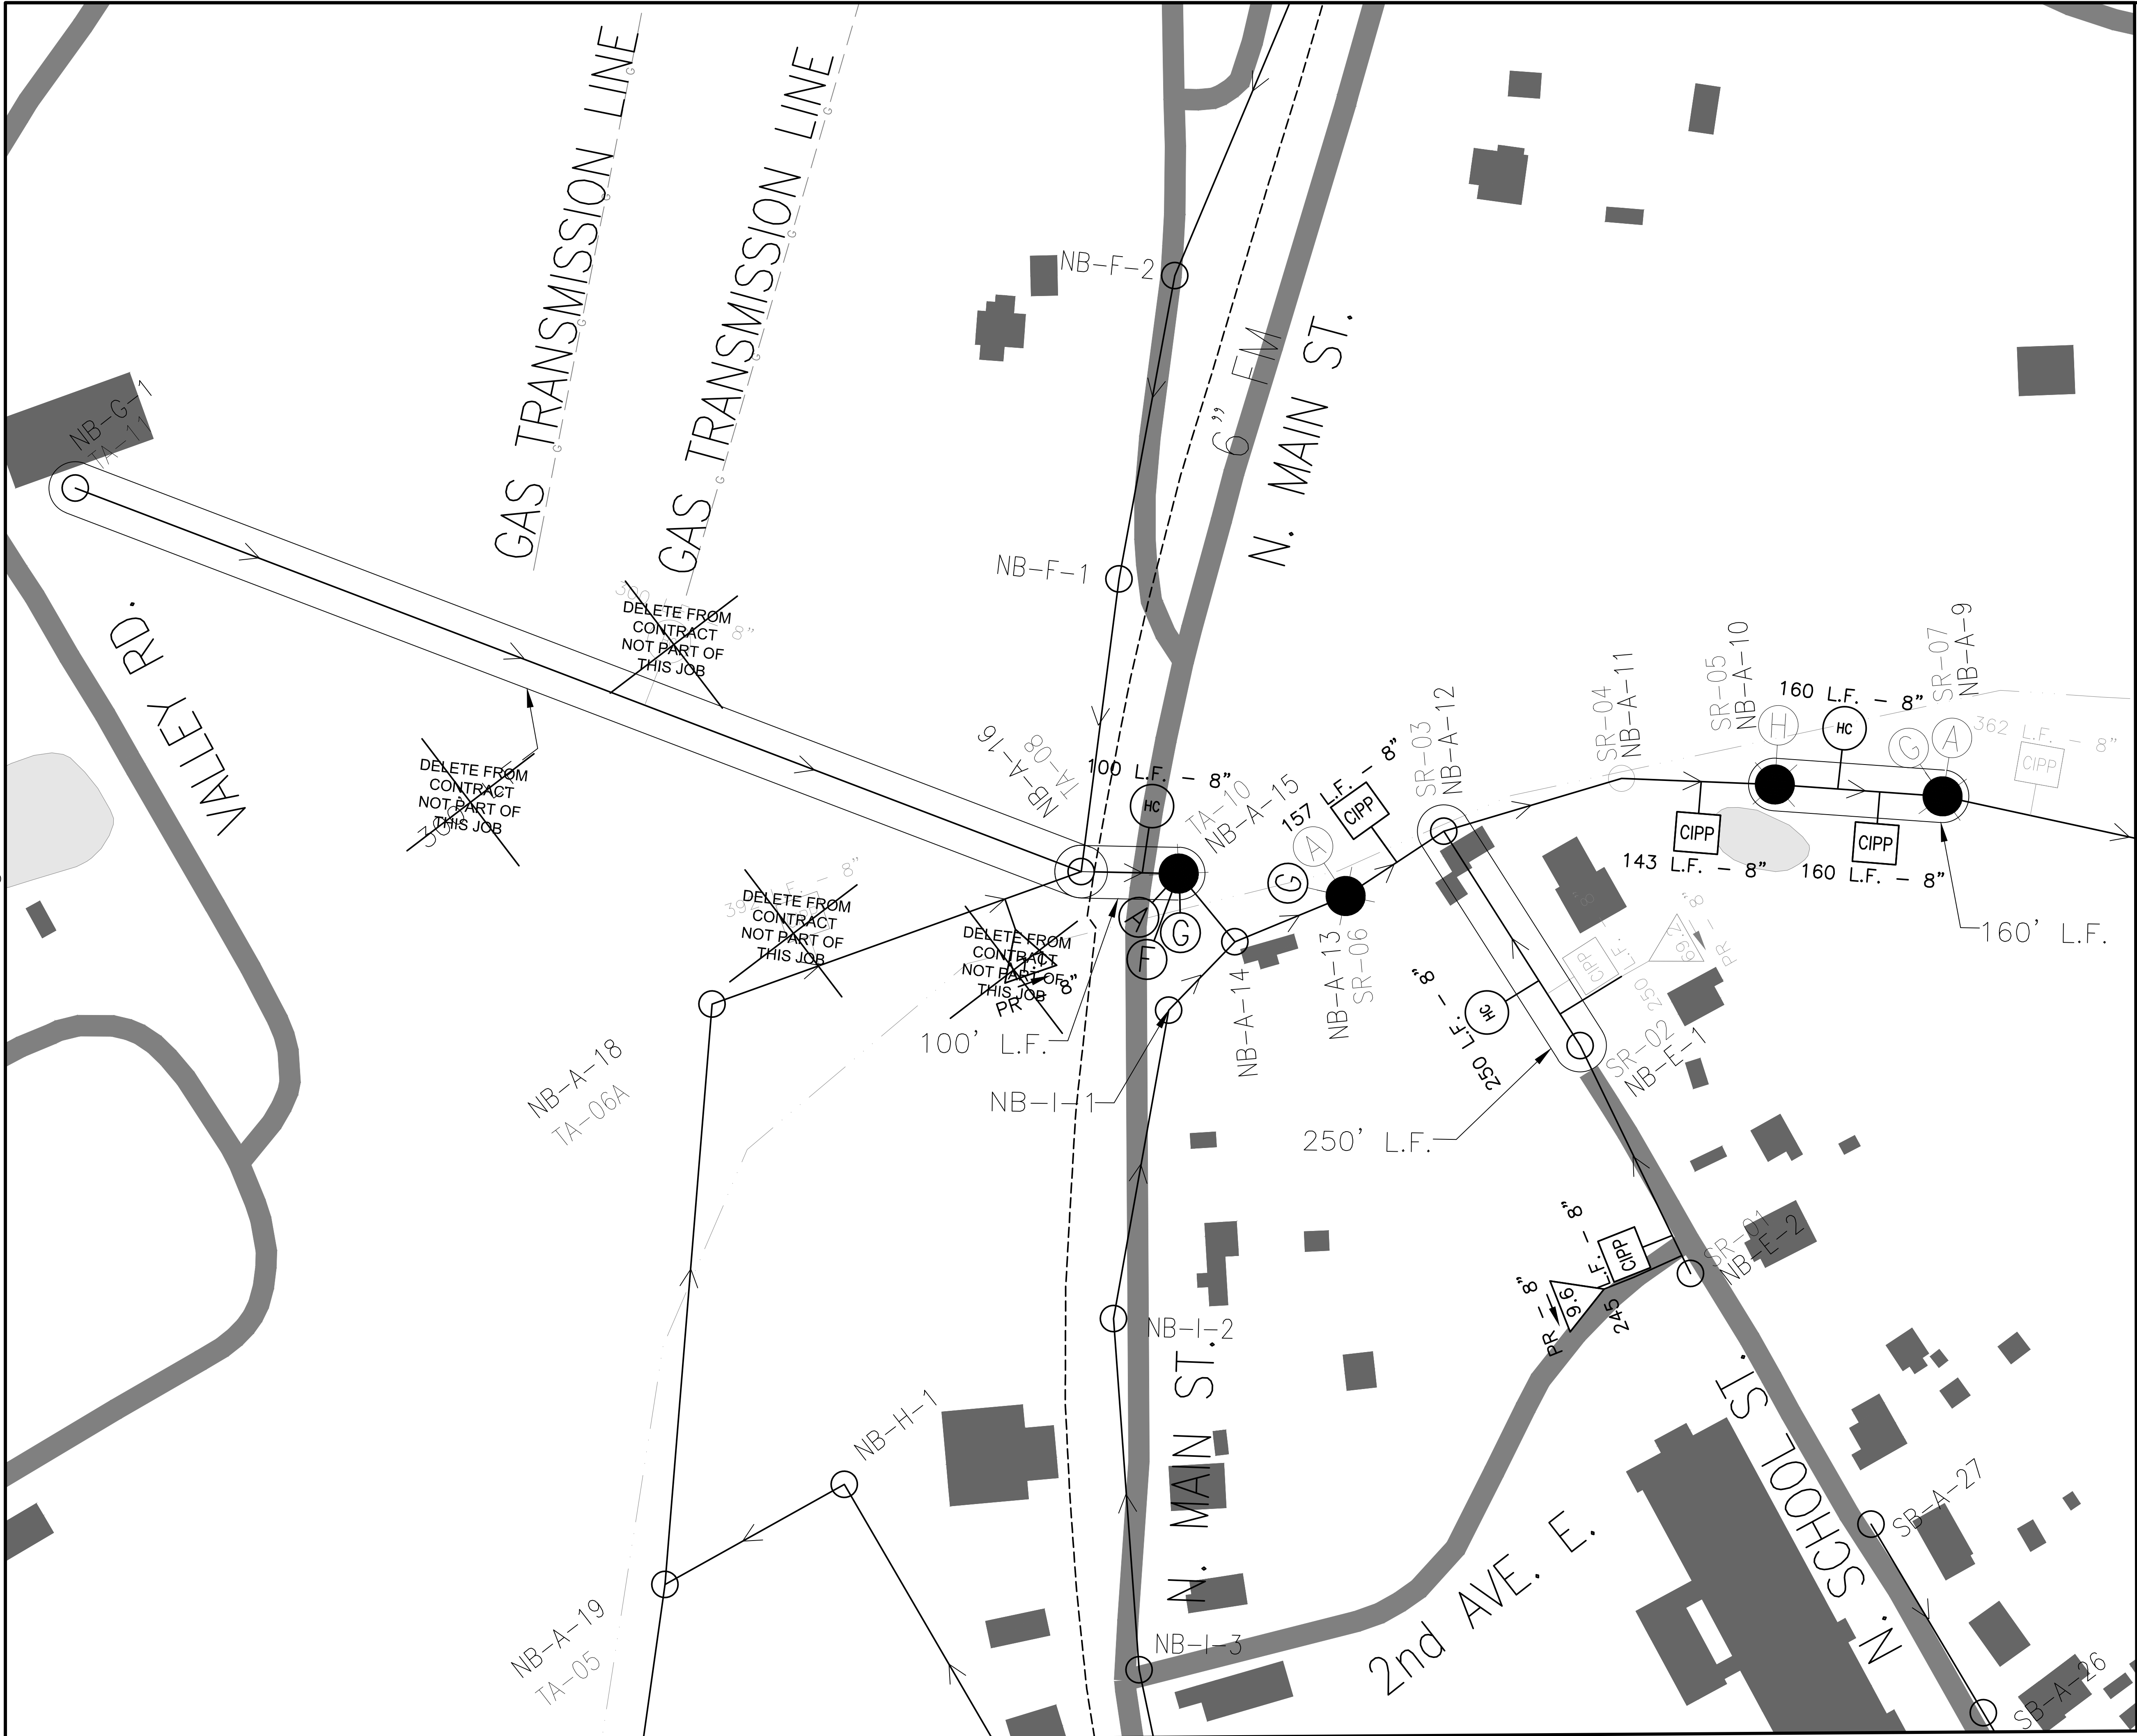

MATCHLINE SHEET C-02

MATCHLINE SHEET C-04

SEWER REHABILITATION
STANDARD LEGEND

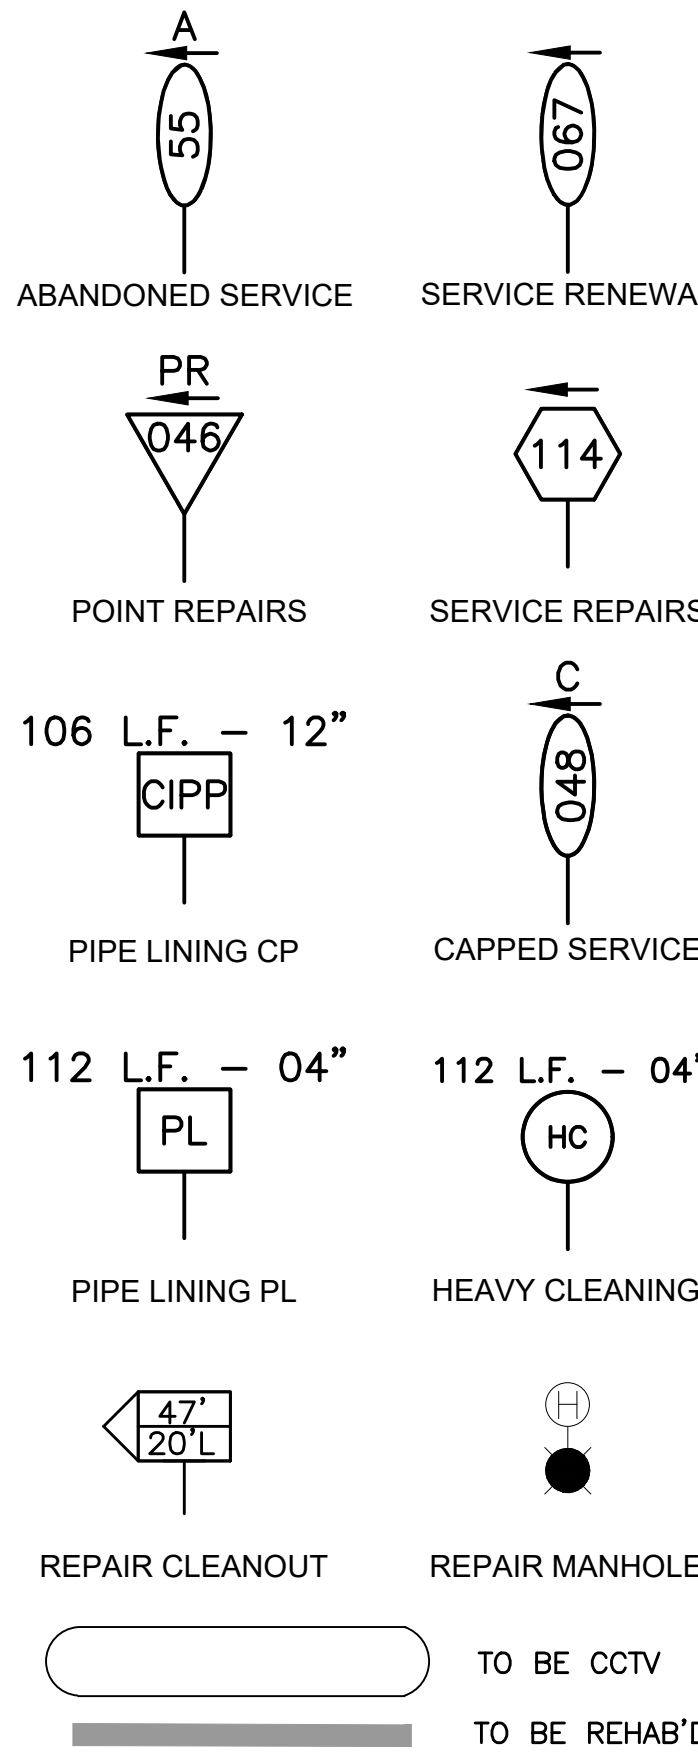

MANHOLE REHABILITATION

MANHOLE EXTRA DEPTH


- (8) 6.1 TO 8.0 DEPTH
- (10) 8.1 TO 10.0 DEPTH
- (12) 10.1 TO 12.0 DEPTH
- (14) 12.1 TO 14.0 DEPTH
- (16) 14.1 TO 16.0 DEPTH
- (20) 18.1 TO 20.0 DEPTH
- (NA) UNKNOWN DEPTH

MANHOLE REPAIRS

- (A) LOCATE/UNCOVER
- (B) NON-ENTRY INSPECTION
- (C) RESET FRAME
- (D) REPLACE FRAME/COVER
- (E) REPLACE COVER
- (F) REPLACE EXISTING WATERTIGHT FRAME & COVER
- (G) RAISE CASTING
- (H) MANHOLE REHABILITATION
- (H2) ADD H2S PROTECTION
- (J) NEW MANHOLE INSTALLATION
- (J) ADD BENCH TO MANHOLE BOTTOM
- (K) PLUG & FILL AROUND PIPES
- (L) REHAB RISERS
- (M) MISC. SEE NOTE

ABBREVIATIONS

- CCTV - CLEAN AND CCTV LINE
- CO - REPLACE CLEANOUT
- CNL - COULD NOT LOCATE
- CP - CURED-IN-PLACE LINING
- IPR - INTERNAL POINT REPAIR
- C/L - CLEAN AND LINE MANHOLE
- NA - NOT APPLICABLE
- PE - POLYETHYLENE
- PL - PIPE LINING
- PL/B - PIPE BURSTING
- PL/R - REPLACE PIPE
- PP - PRIVATE PROPERTY
- PR - POINT REPAIR
- PVC - POLYVINYL CHLORIDE
- SL - SLIPLINING
- SOS - SERVICES ON SEGMENT
- SR - SERVICE REPAIR

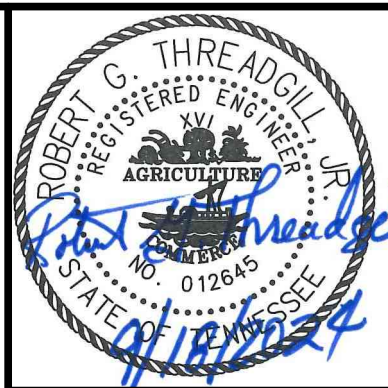

SRW PROJECT NO. 3827-16



SANITARY SEWER REHABILITATION
NORTH MAIN STREET
SANITARY SEWER REHABILITATION
CITY OF LOBELVILLE, TENNESSEE

REVISIONS	DESCRIPTION	DATE	BY	RGD	BHH	RGD	RGD
NO							

DATE: SEPTEMBER 2024

SCALE:

1:75

SHEET NO.

C-03

CONTRACT DRAWINGS