


PLOTTED BY: NAZAD

PRINTED: 1/28/2025 @ 4:14PM

FILE NAME: C:\Users\nazad\AppData\Local\Temp\ApAcPublish_2316013827-16-Set.dwg

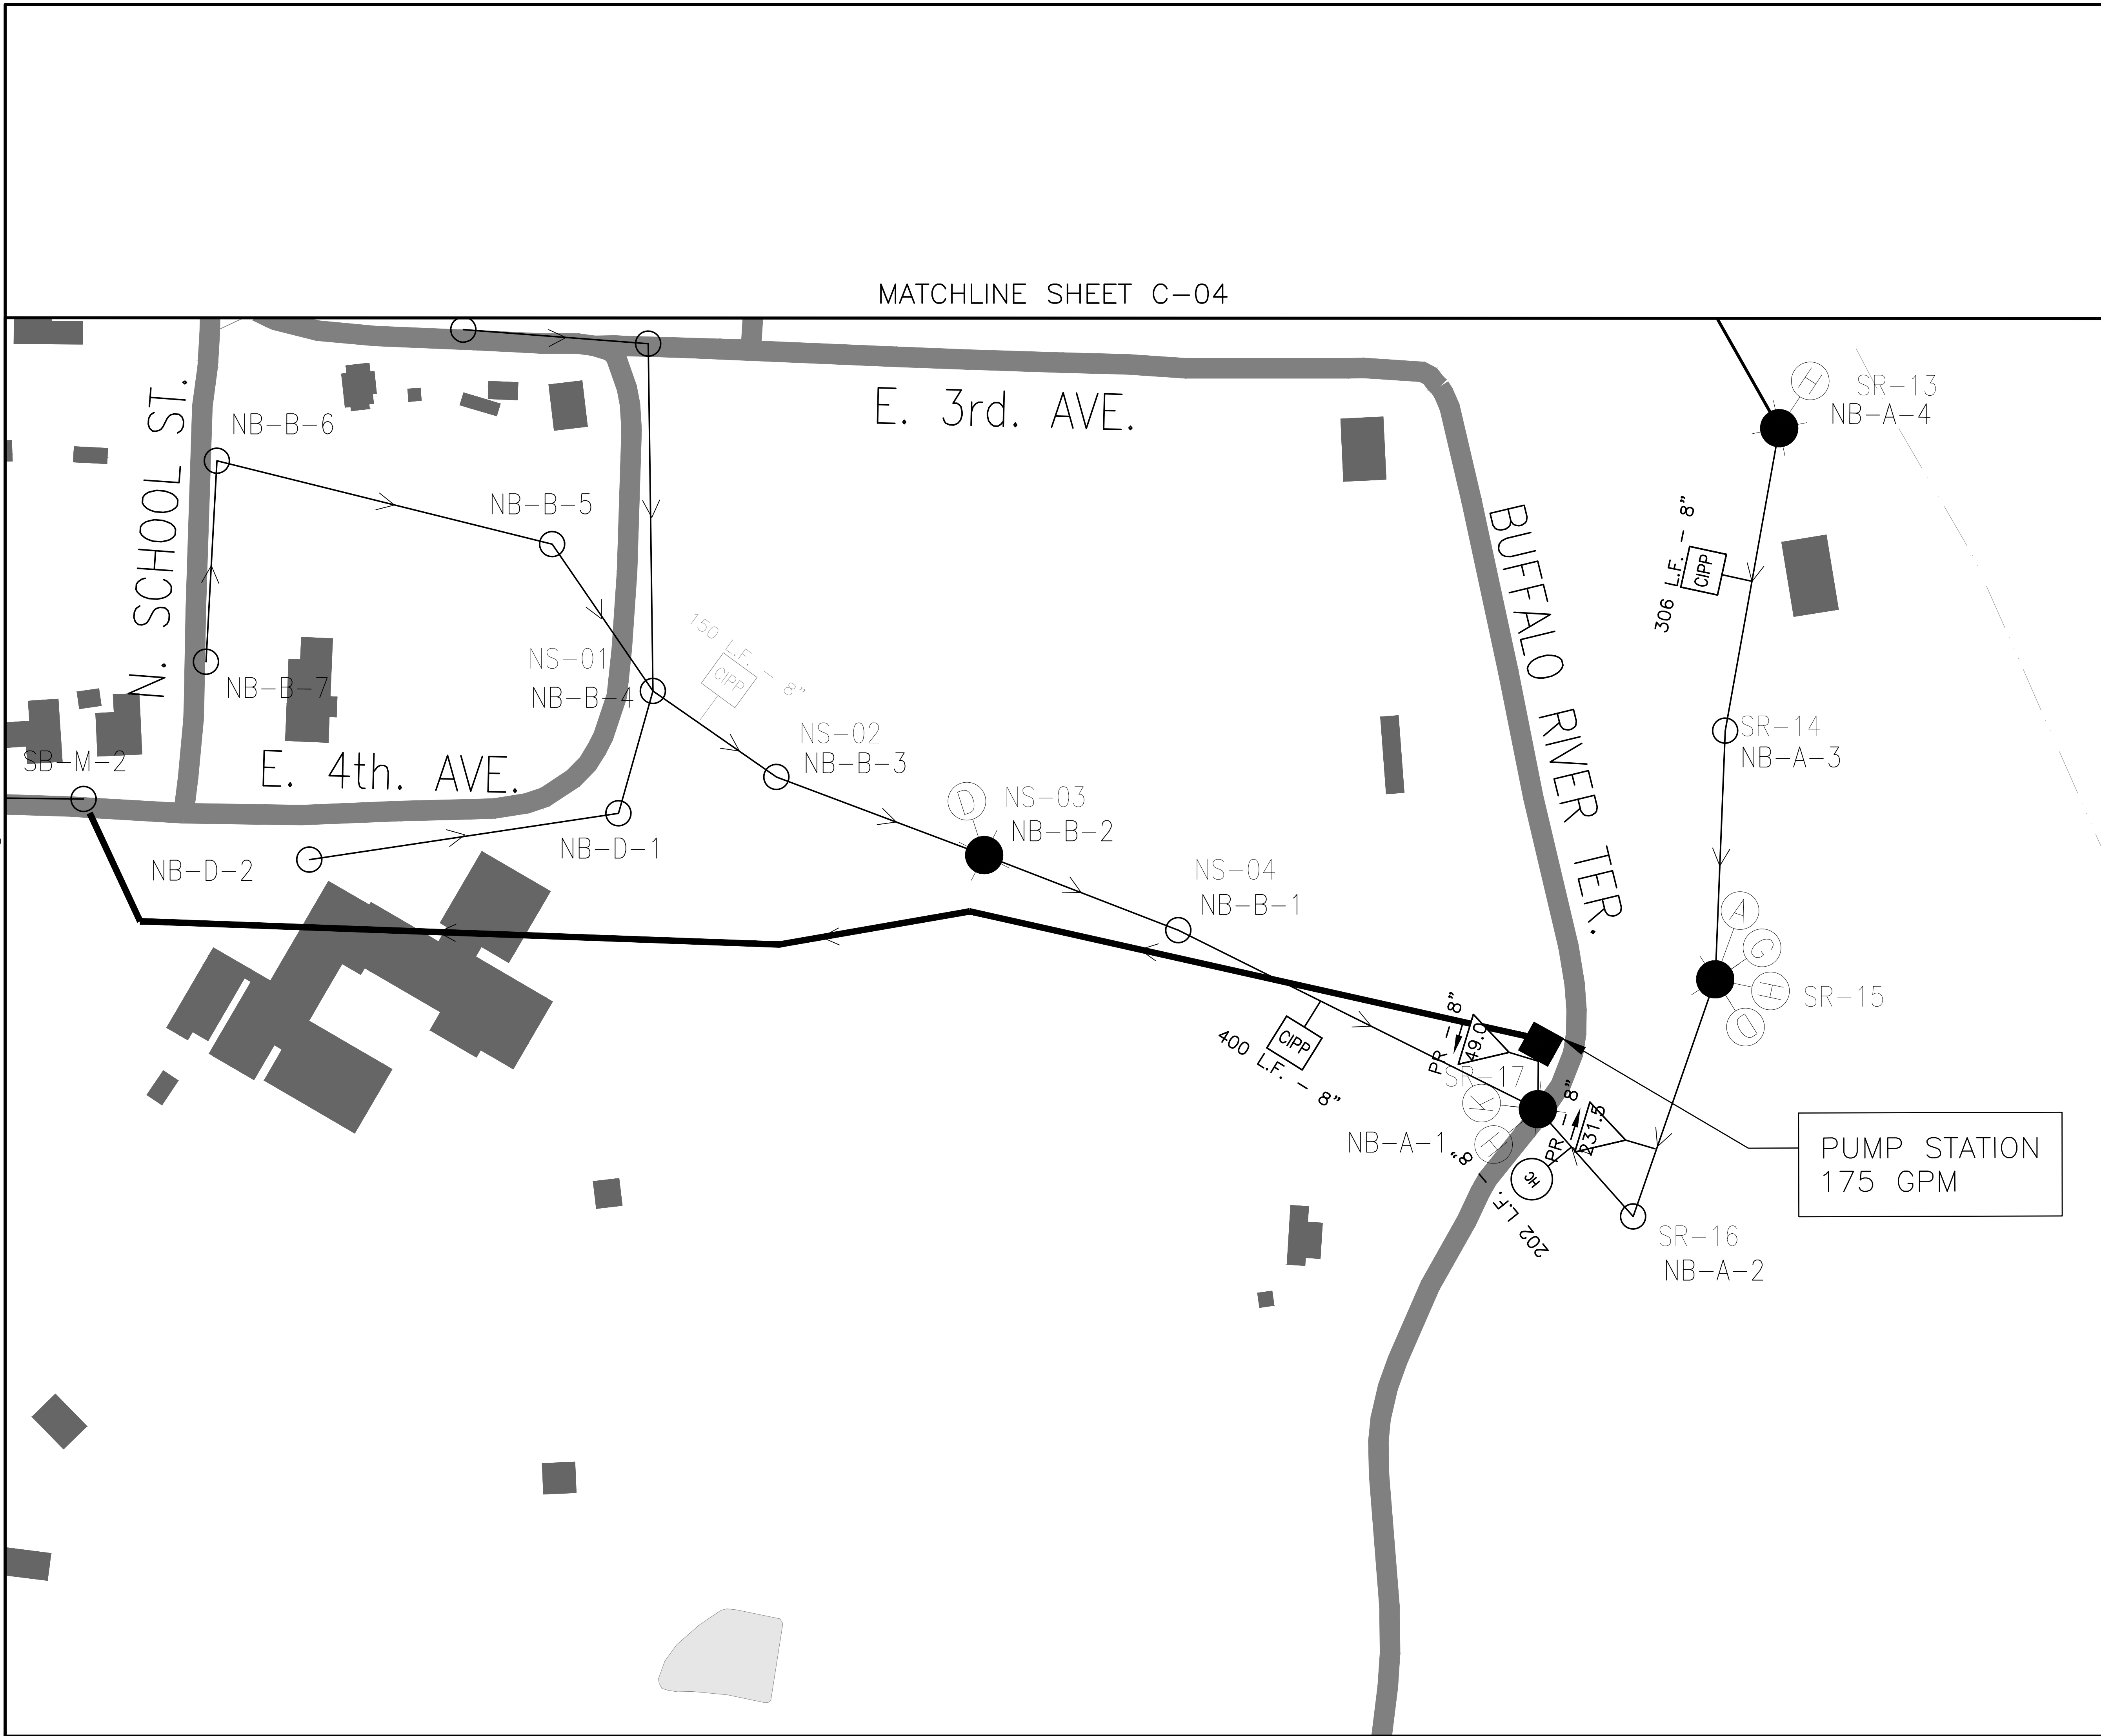

SEWER REHABILITATION
STANDARD LEGEND

ABANDONED SERVICE: 55' (circle with cross)
 SERVICE RENEWAL: 067' (circle with arrow)
 POINT REPAIRS: PR 046' (inverted triangle)
 SERVICE REPAIRS: 114' (hexagon)
 PIPE LINING CP: 106 L.F. - 12" CIPP (rectangle)
 CAPPED SERVICE: 048' (circle with 'C')
 PIPE LINING PL: 112 L.F. - 04" PL (rectangle)
 HEAVY CLEANING: 112 L.F. - 04" HC (circle)
 REPAIR CLEANOUT: 47' 20" L (arrow)
 REPAIR MANHOLE: 47' 20" L (circle)
 TO BE CCTV: (thin line)
 TO BE REHAB'D: (thick line)

MANHOLE REHABILITATION
MANHOLE EXTRA DEPTH


- 8 6.1 TO 8.0 DEPTH
- 10 8.1 TO 10.0 DEPTH
- 12 10.1 TO 12.0 DEPTH
- 14 12.1 TO 14.0 DEPTH
- 16 14.1 TO 16.0 DEPTH
- 20 18.1 TO 20.0 DEPTH
- NA UNKNOWN DEPTH

MANHOLE REPAIRS

- A LOCATE/UNCOVER
- B NON-ENTRY INSPECTION
- C RESET FRAME
- D REPLACE FRAME/COVER
- E REPLACE COVER
- F REPLACE EXISTING WATERTIGHT FRAME & COVER
- G RAISE CASTING
- H MANHOLE REHABILITATION
- H2 ADD H2S PROTECTION
- I NEW MANHOLE INSTALLATION
- J ADD BENCH TO MANHOLE BOTTOM
- K PLUG & FILL AROUND PIPES
- L REHAB RISERS
- M MISC. SEE NOTE

ABBREVIATIONS

- CCTV - CLEAN AND CCTV LINE
- CO - REPLACE CLEANOUT
- CNL - COULD NOT LOCATE
- CP - CURED-IN-PLACE LINING
- IPR - INTERNAL POINT REPAIR
- C/L - CLEAN AND LINE MANHOLE
- NA - NOT APPLICABLE
- PE - POLYETHYLENE
- PL - PIPE LINING
- PL/B - PIPE BURSTING
- PL/R - REPLACE PIPE
- PP - PRIVATE PROPERTY
- PR - POINT REPAIR
- PVC - POLYVINYL CHLORIDE
- SL - SLIPLINING
- SOS - SERVICES ON SEGMENT
- SR - SERVICE REPAIR

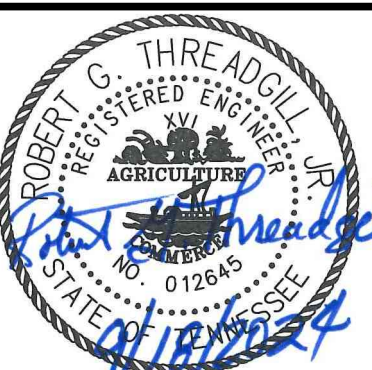

GRW PROJECT NO. 3827-16



SANITARY SEWER REHABILITATION
BUFFALO RIVER TER.
SANITARY SEWER REHABILITATION
CITY OF LOBELVILLE, TENNESSEE

DESIGNED	RGD	BY	DATE	REVIEWED	BHH	DATE	APPROVED	RGD
NO								

DATE: SEPTEMBER 2024
 SCALE: 1:75
 SHEET NO. C-05

CONTRACT DRAWINGS