



PLOTTED BY: NAZAD

PRINTED: 1/28/2025 @ 4:15PM

FILE NAME: C:\Users\nazad\AppData\Local\Temp\ApacPublish\_2316013827-16-Set.dwg

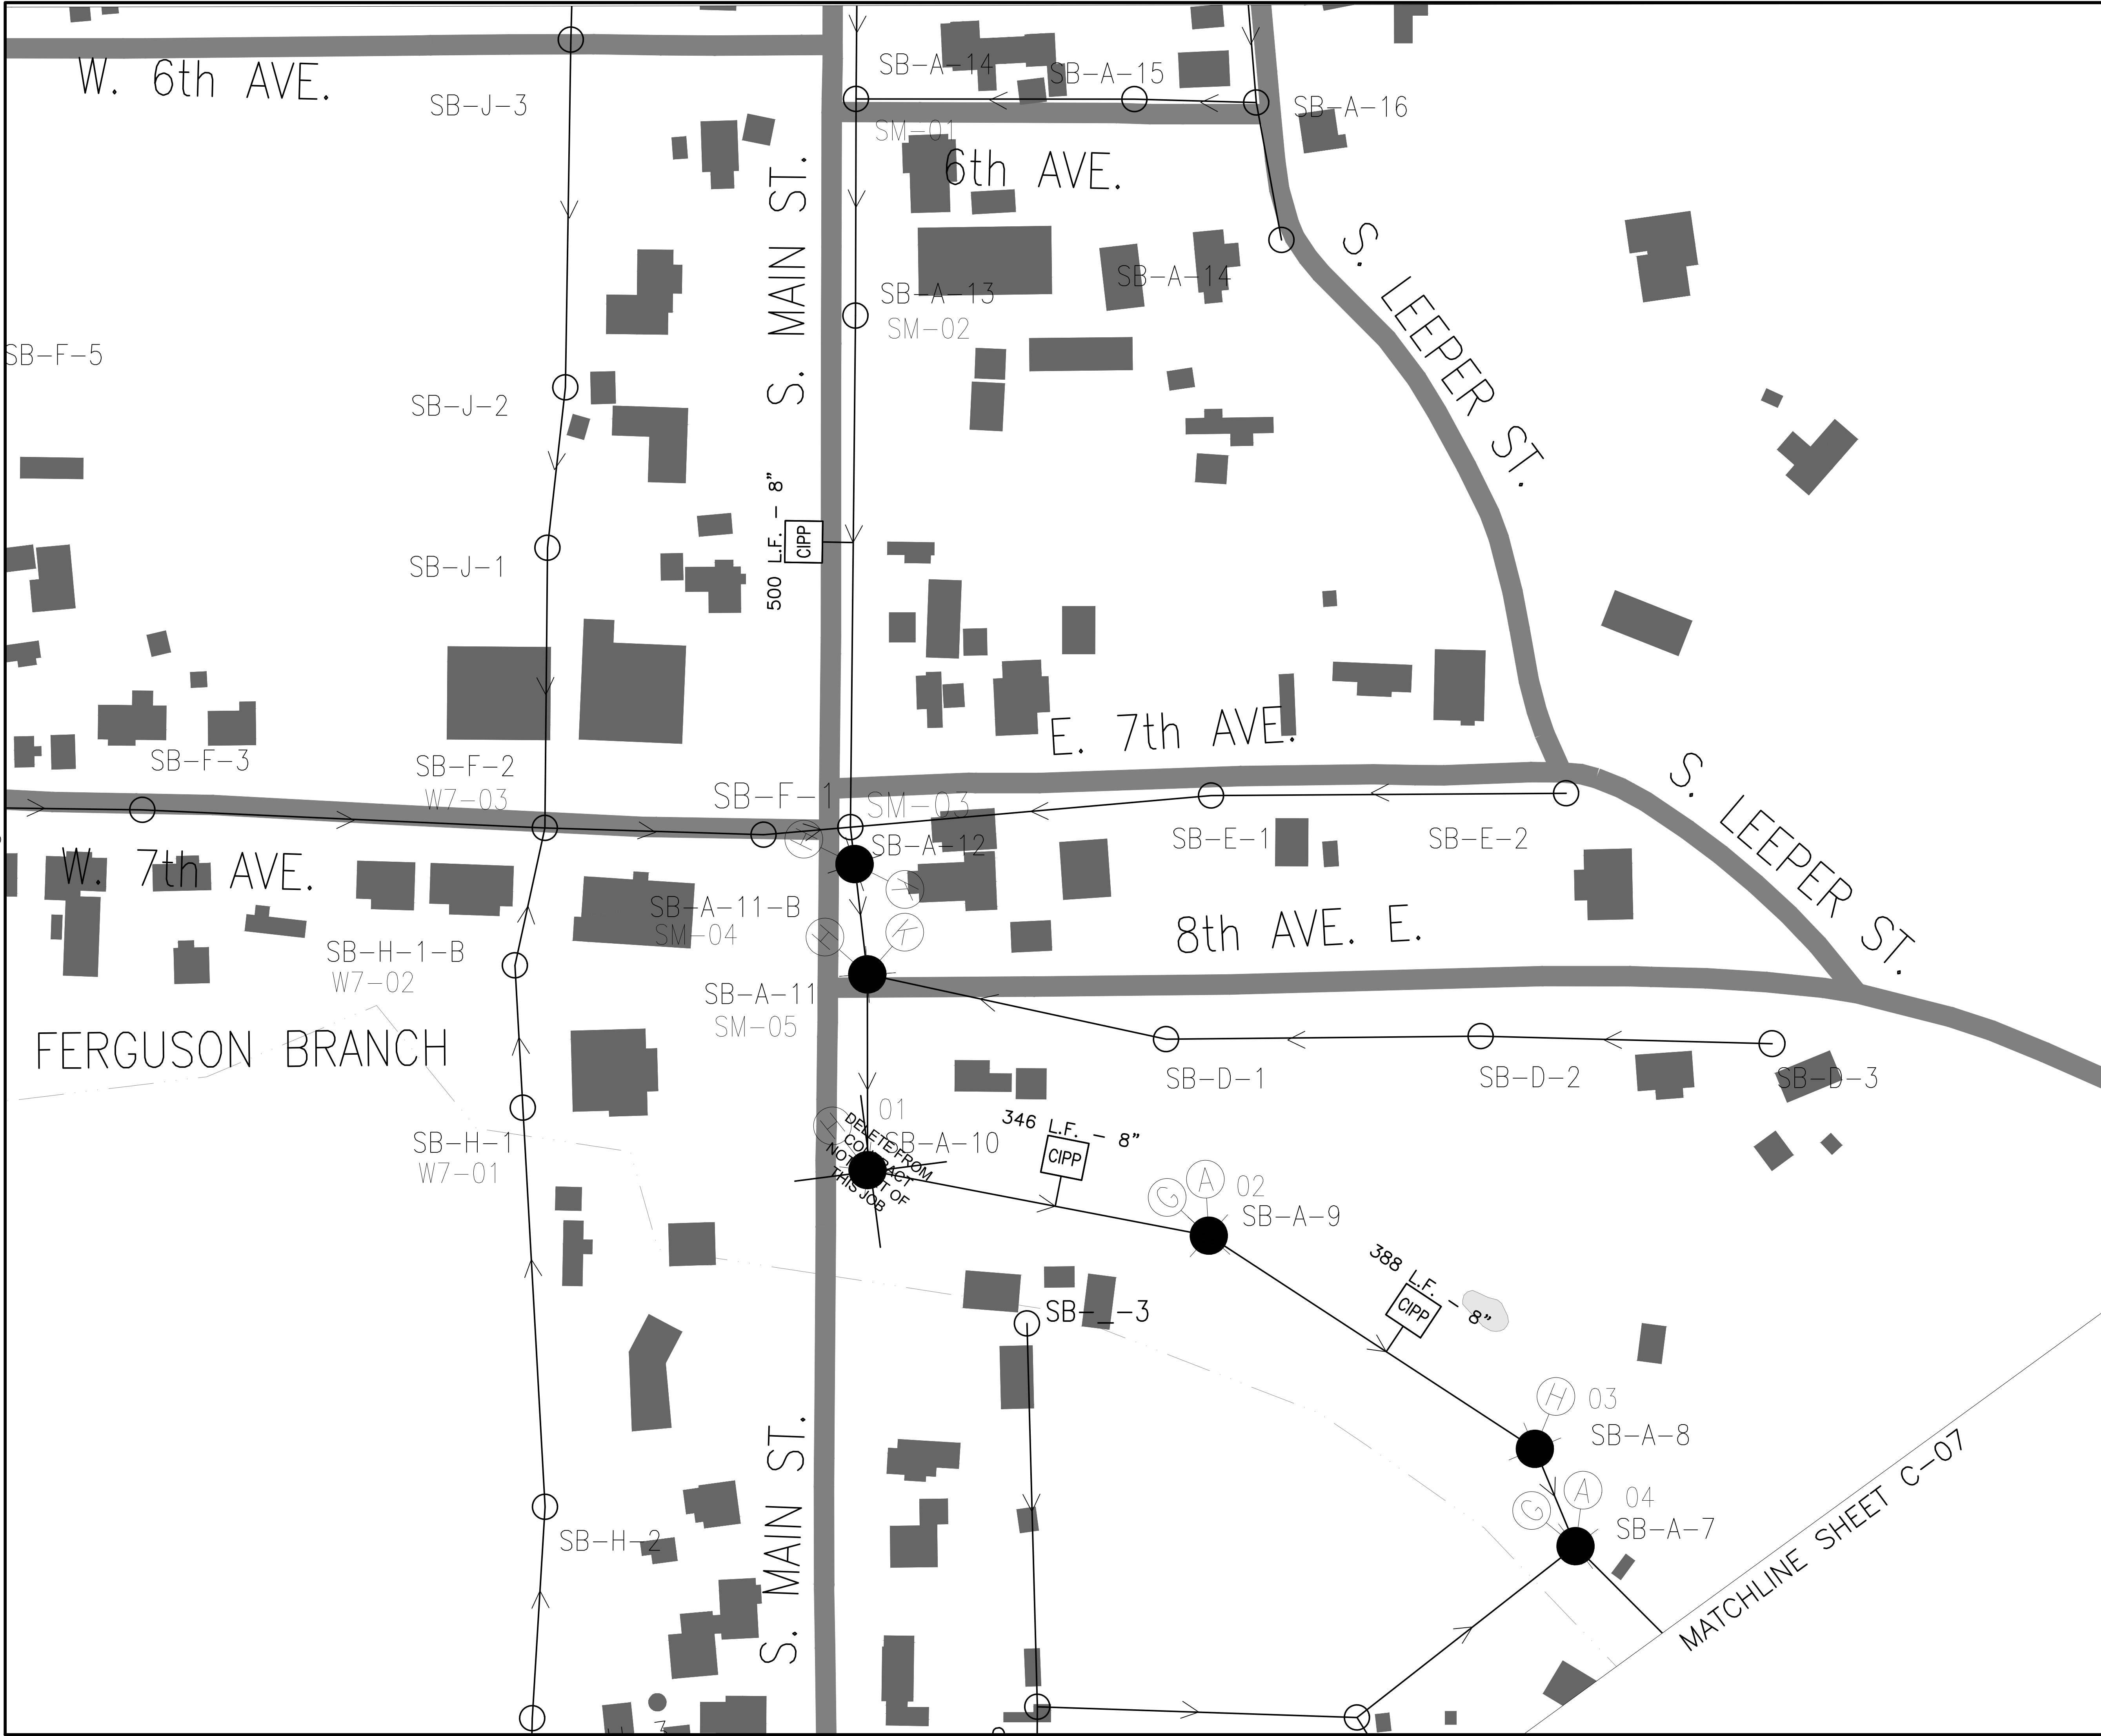

SEWER REHABILITATION  
STANDARD LEGEND

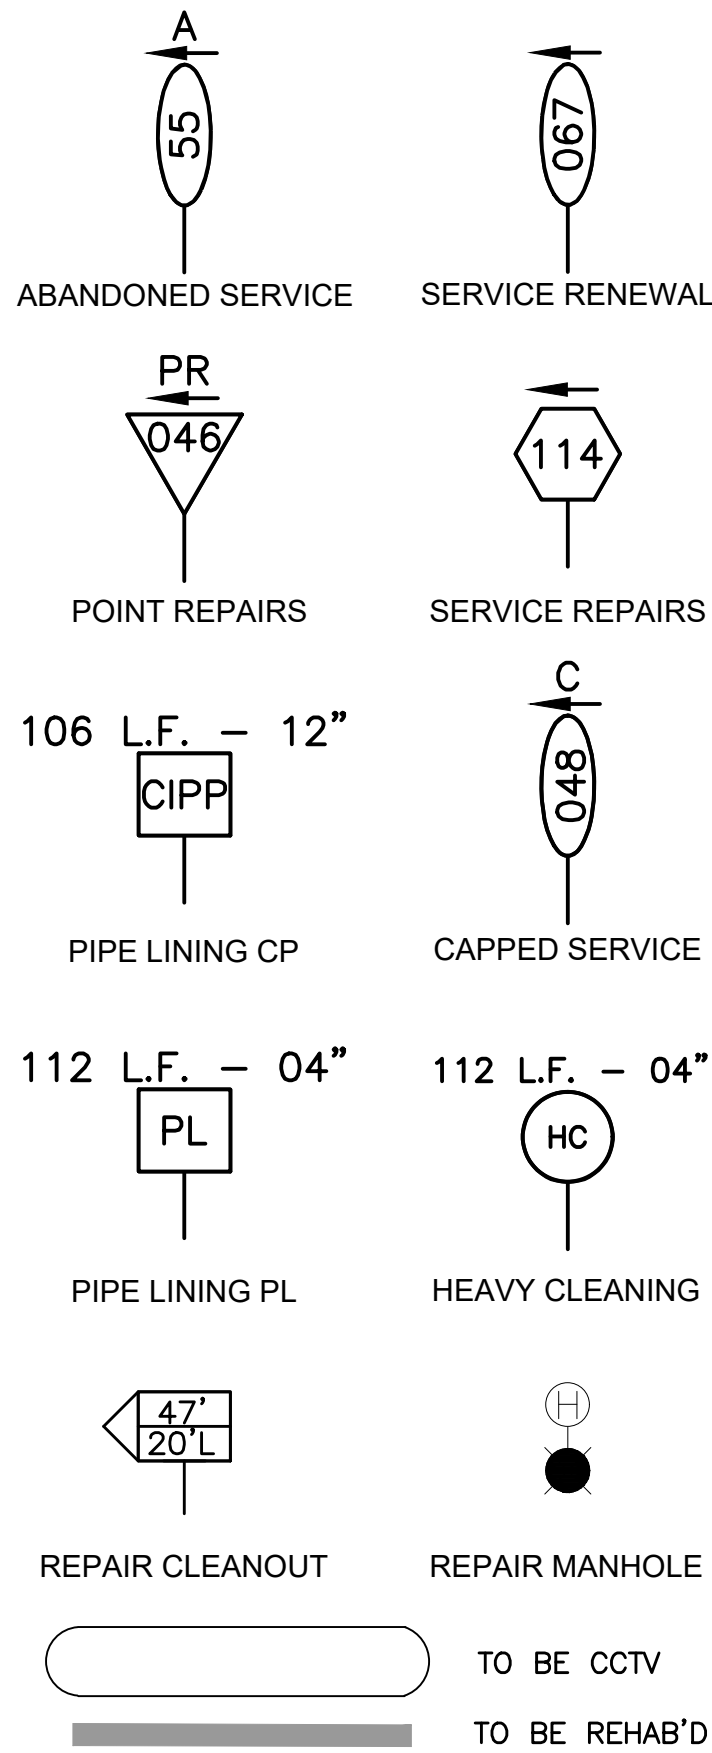

MANHOLE REHABILITATION

MANHOLE EXTRA DEPTH

- 8 6.1 TO 8.0 DEPTH
- 10 8.1 TO 10.0 DEPTH
- 12 10.1 TO 12.0 DEPTH
- 14 12.1 TO 14.0 DEPTH
- 16 14.1 TO 16.0 DEPTH
- 20 18.1 TO 20.0 DEPTH
- NA UNKNOWN DEPTH

MANHOLE REPAIRS

- A LOCATE/UNCOVER
- B NON-ENTRY INSPECTION
- C RESET FRAME
- D REPLACE FRAME/COVER
- E REPLACE COVER
- F REPLACE EXISTING WATERTIGHT FRAME & COVER
- G RAISE CASTING
- H MANHOLE REHABILITATION
- H2 ADD H2S PROTECTION
- I NEW MANHOLE INSTALLATION
- J ADD BENCH TO MANHOLE BOTTOM
- K PLUG & FILL AROUND PIPES
- L REHAB RISERS
- M MISC. SEE NOTE

ABBREVIATIONS

- CCTV - CLEAN AND CCTV LINE
- CO - REPLACE CLEANOUT
- CNL - COULD NOT LOCATE
- CP - CURED-IN-PLACE LINING
- IPR - INTERNAL POINT REPAIR
- C/L - CLEAN AND LINE MANHOLE
- NA - NOT APPLICABLE
- PE - POLYETHYLENE
- PL - PIPE LINING
- PL/B - PIPE BURSTING
- PL/R - REPLACE PIPE
- PP - PRIVATE PROPERTY
- PR - POINT REPAIR
- PVC - POLYVINYL CHLORIDE
- SL - SLIPLINING
- SOS - SERVICES ON SEGMENT
- SR - SERVICE REPAIR



GRW PROJECT NO. 3827-16



SANITARY SEWER REHABILITATION  
SOUTH MAIN STREET  
SANITARY SEWER REHABILITATION  
CITY OF LOBELVILLE, TENNESSEE

| DESIGNED | RGD | BY | DATE | DRAWN | BHH | REVIEWED | RGD | APPROVED | RGD |
|----------|-----|----|------|-------|-----|----------|-----|----------|-----|
|          |     |    |      |       |     |          |     |          |     |
| NO       |     |    |      |       |     |          |     |          |     |

DATE: SEPTEMBER 2024

SCALE: 1:75

SHEET NO.

C-06

CONTRACT DRAWINGS